

DCR PHOENIX HOMES

LOT# 28

WHITE TAIL RIDGE


MODEL - RUTHERFORD (517)

VANITIES & LAUNDRY


MOUNTING HEIGHT - 84

- CANBINETS -
- HARDWARE -
- STANDARD WHITE INTERIOR
- METAL DRAWER BOX
- 4 PCS - 5/8" KICK - FIN. BOTH ENDS
- 5 PCS - FLAT SHOE MOULD


NOTE: ALL VANITIES TO BE APPROX. 18" FROM CENTRE OF TOILET.
ANY ADJUSTMENTS NEEDED TO CABINET LAYOUTS
WILL BE DONE AFTER SITE MEASURE

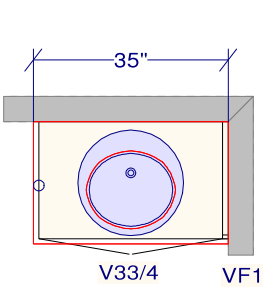


POWDER ROOM

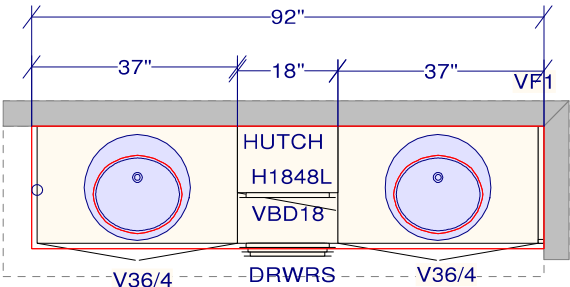

NO HUTCH
ENSUITE 1

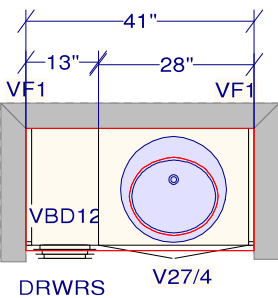


ENSUITE 2

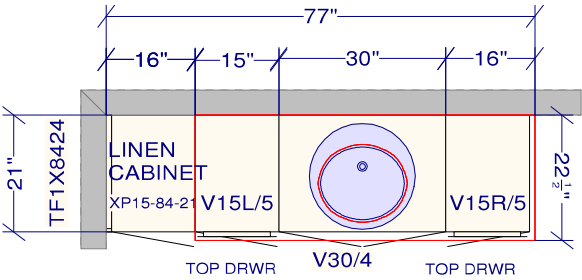

NO LINEN CABINET

MAIN BATH

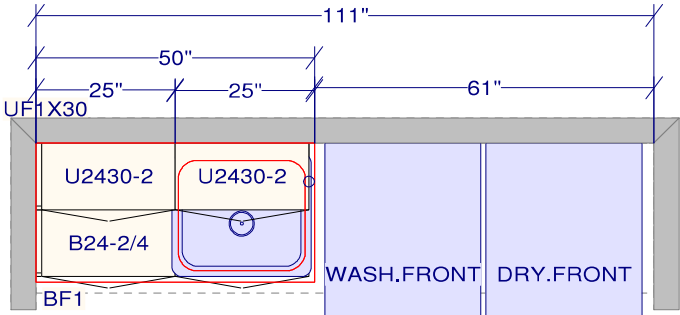

LAUNDRY SINK RELOCATED TO LEFT

LAUNDRY ROOM

CUSTOMER APPROVAL

I have reviewed these drawings and understand the details of the design and the CARTIER KITCHENS specifications.

Signature _____

Date _____

All dimensions ,size designations
given are subject to verification on
job site and adjustment to fit job
conditions.

SPECTRUM KITCHEN and BATH
DESIGN



This is an original design and must
not be released or copied unless
applicable fee has been paid or job
order placed.

DRAWN BY: LORI DISAVERIO, B.I.D


Designed: 2020-12-01
Printed: 2020-12-01

DS
Chad
DS

DCR #28 WTR - Vanities + Laundry.kit

All

Drawing #: 1 No Scale.

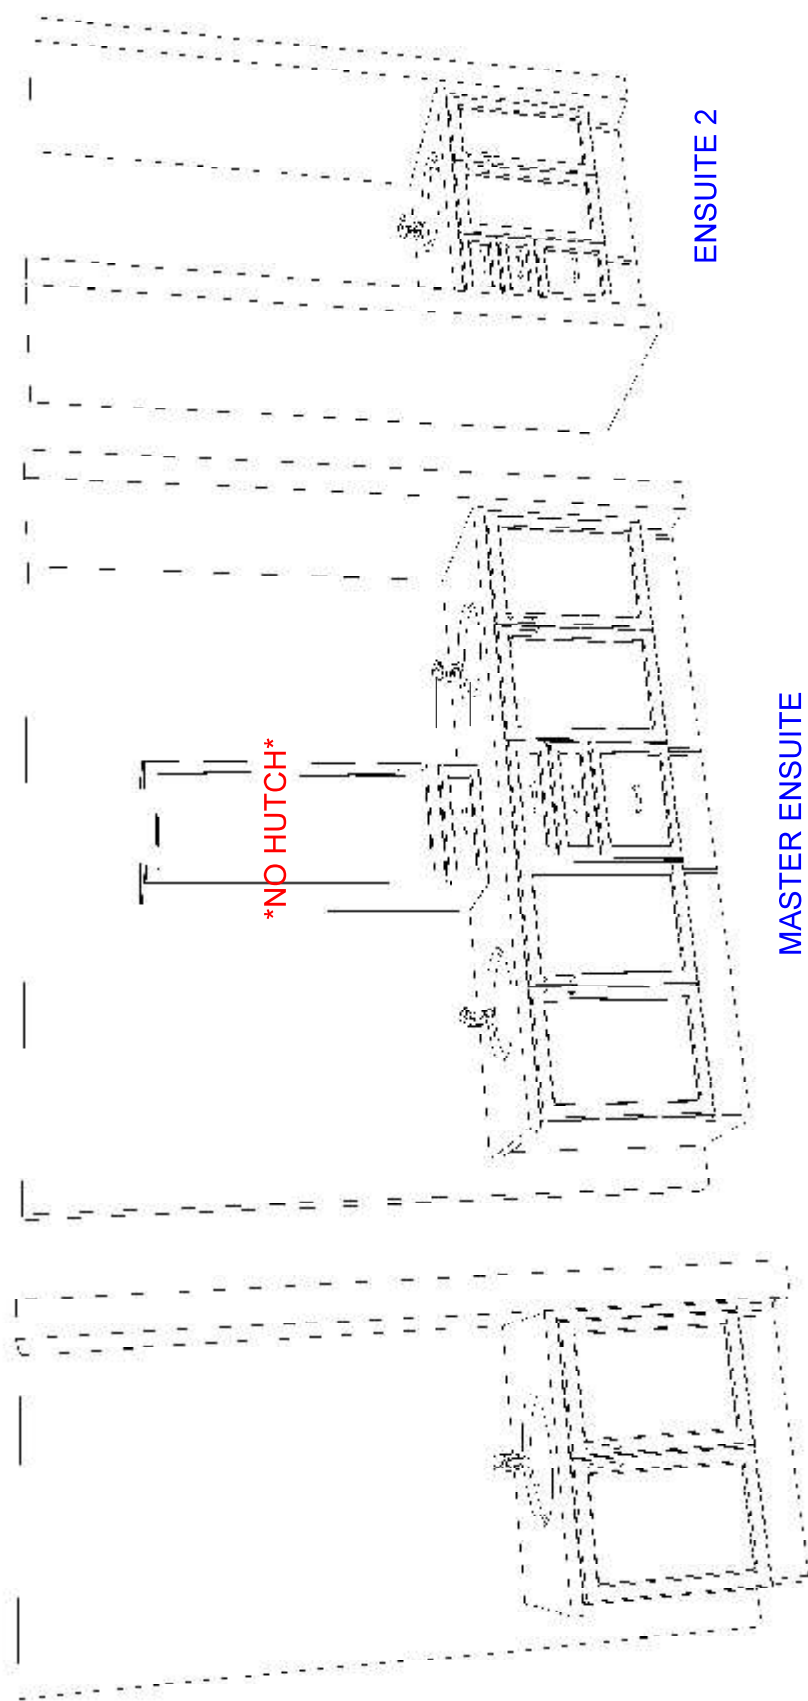

CUSTOMER APPROVAL

I have reviewed these drawings and understand the details of the design and the CARTIER KITCHENS specifications.

Signature _____

Date _____

Note: This drawing is an artistic interpretation of the general appearance of the design. It is not meant to be an exact rendition.

SPECTRUM KITCHEN and BATH DESIGN

DCR #28 WTR - Vanities + Laundry.kit



All

Drawing #: 1

Designed: 2020-12-01
Printed: 2020-12-01

DS DS


Chad [Signature]

DS


Chad

DS

NO LINEN CABINET

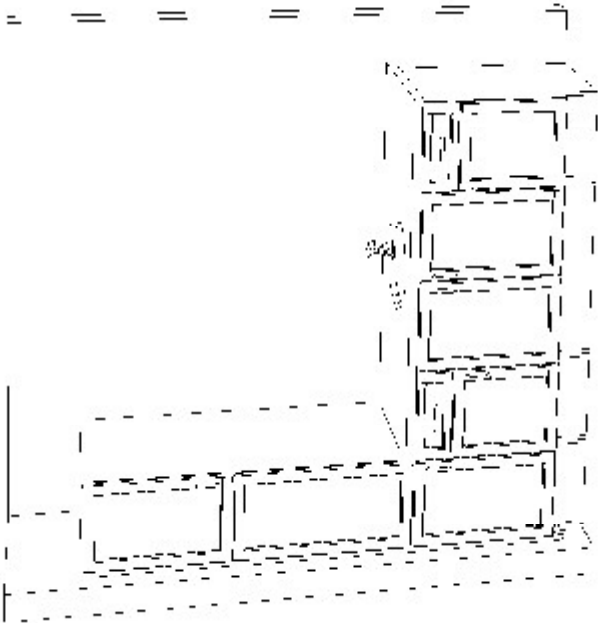

MAIN BATH VANITY

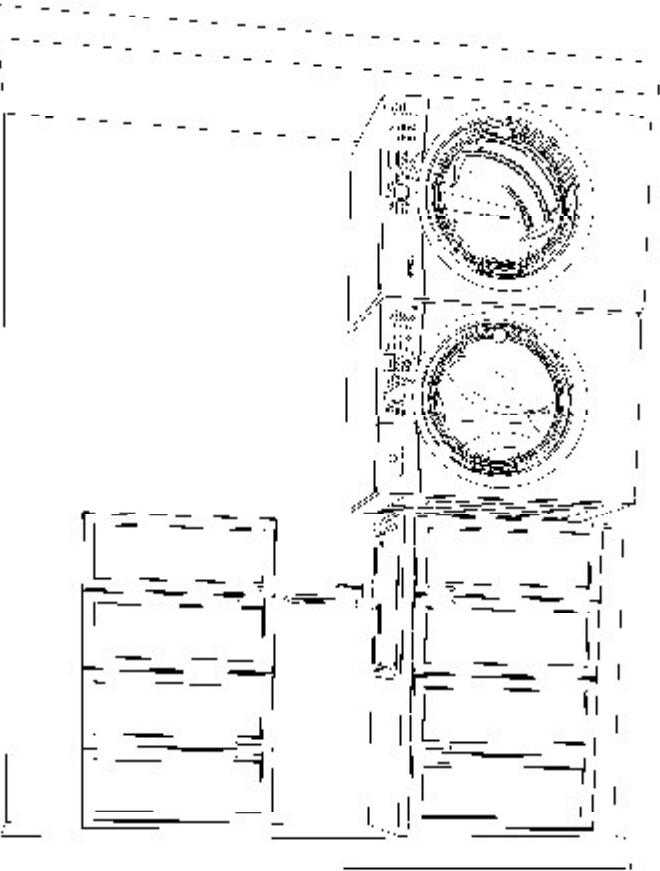

LAUNDRY ROOM CABINETS

LAUNDRY SINK RELOCATED TO LEFT

CUSTOMER APPROVAL

I have reviewed these drawings and understand the details of the design and the CARTIER KITCHENS specifications.

Signature

Date

Note: This drawing is an artistic interpretation of the general appearance of the design. It is not meant to be an exact rendition.		Designed: 2020-12-01 Printed: 2020-12-01	
		Drawing #: 1	
SPECTRUM KITCHEN and BATH DESIGN		All	
DCR #28 WTR - Vanities + Laundry.kit			