

TF7 UNIT 126

DCR PHOENIX HOMES
TERRA FLATS
MODEL - TYPE A (LOWER FLOOR)

KITCHEN / VANITIES

MOUNTING HEIGHT - 84

LINE 1

HARDWARE - U1

STANDARD WHITE INTERIOR

METAL DRAWER BOX


3 PCS - 5/8" KICK - FIN, BOTH ENDS

2 PCS - LOOSE FILLER - 6 x 96

2 PCS - 90 DEG. CORNER MOULD

1 PCS - T-MOULDING

4 PCS - FLAT MOULDING


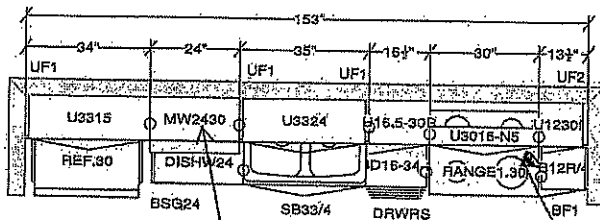


FRIDGE
SPACE:
W: 34"
H: 69"


SPACE FOR MW:
W: 22.5"
H: 13.5"

ADD (2)
DOORS

ACCOMMODATE FOR
OTR MW

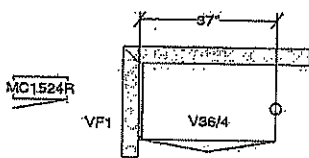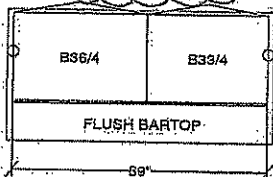

MAIN BATH

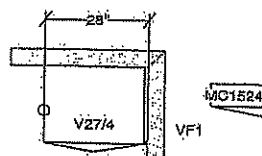

ENSUITE

All dimensions and designations
shown are subject to verification on
job site and adjustment to fit job
conditions.



This is an original design and must
not be released or copied unless
applicable fee has been paid or job
order placed.

Designed: 2017-04-04
Printed: 2017-04-07

TYPE A

All

Drawing #: 1 No Scale.

KK.

AB