

DCR PHOENIX HOMES


MODEL: C10 - ROSEMERE

CHEF'S KITCHEN

MOUNTING HT:84

→ 42" H UPPERS.

- CABINETS -
- HARDWARE -
- STANDARD WHITE INTERIOR
- STANDARD HINGES
- STD METAL DRAWERS
- 1 - PC. 90 DEG. CORNER MOULD.
- 2 - PCS. T-MOULD
- 5/8" OE KICK
- FLAT SHOE MOULDING

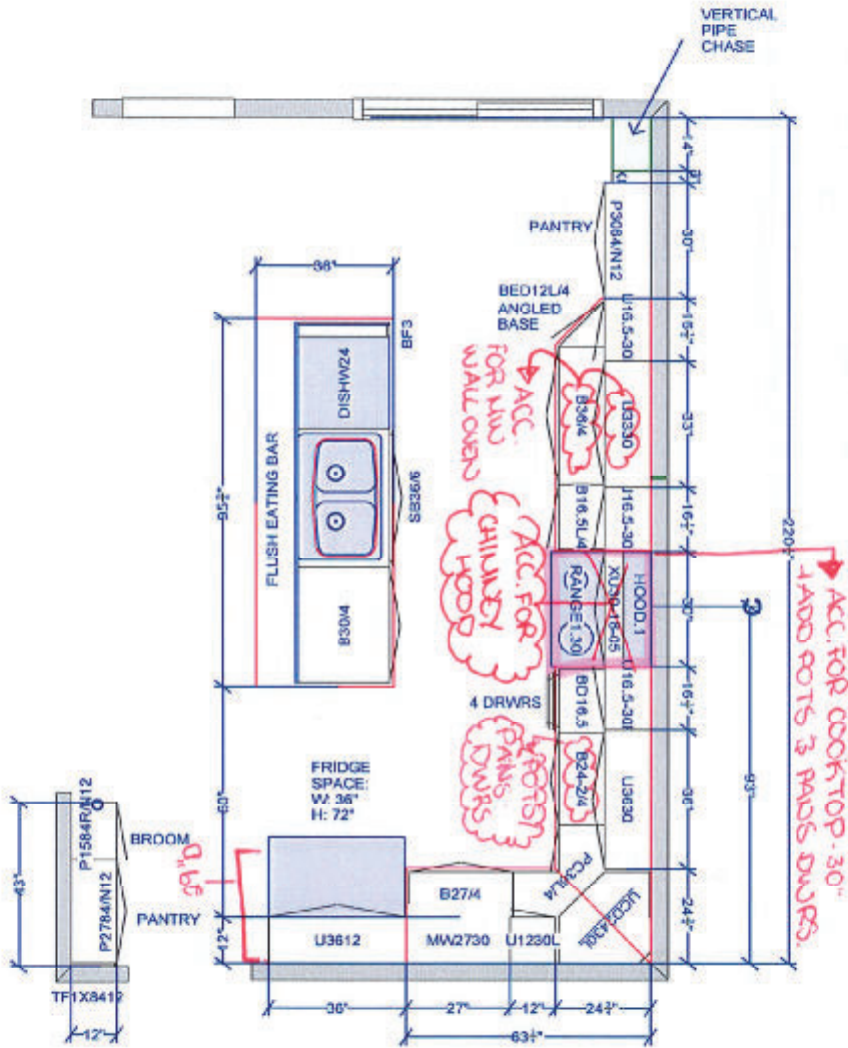

All dimensions size designations given are subject to verification on job site and adjustment to fit job conditions.



This is an original design and must not be released or copied unless applicable fee has been paid or job order placed.

Designed: 10/7/2020
Printed: 10/7/2020


DCR -ROSEMERE - CHEF'S KITCHEN

All

Drawing #: 1 No Scale.


DS

HHF

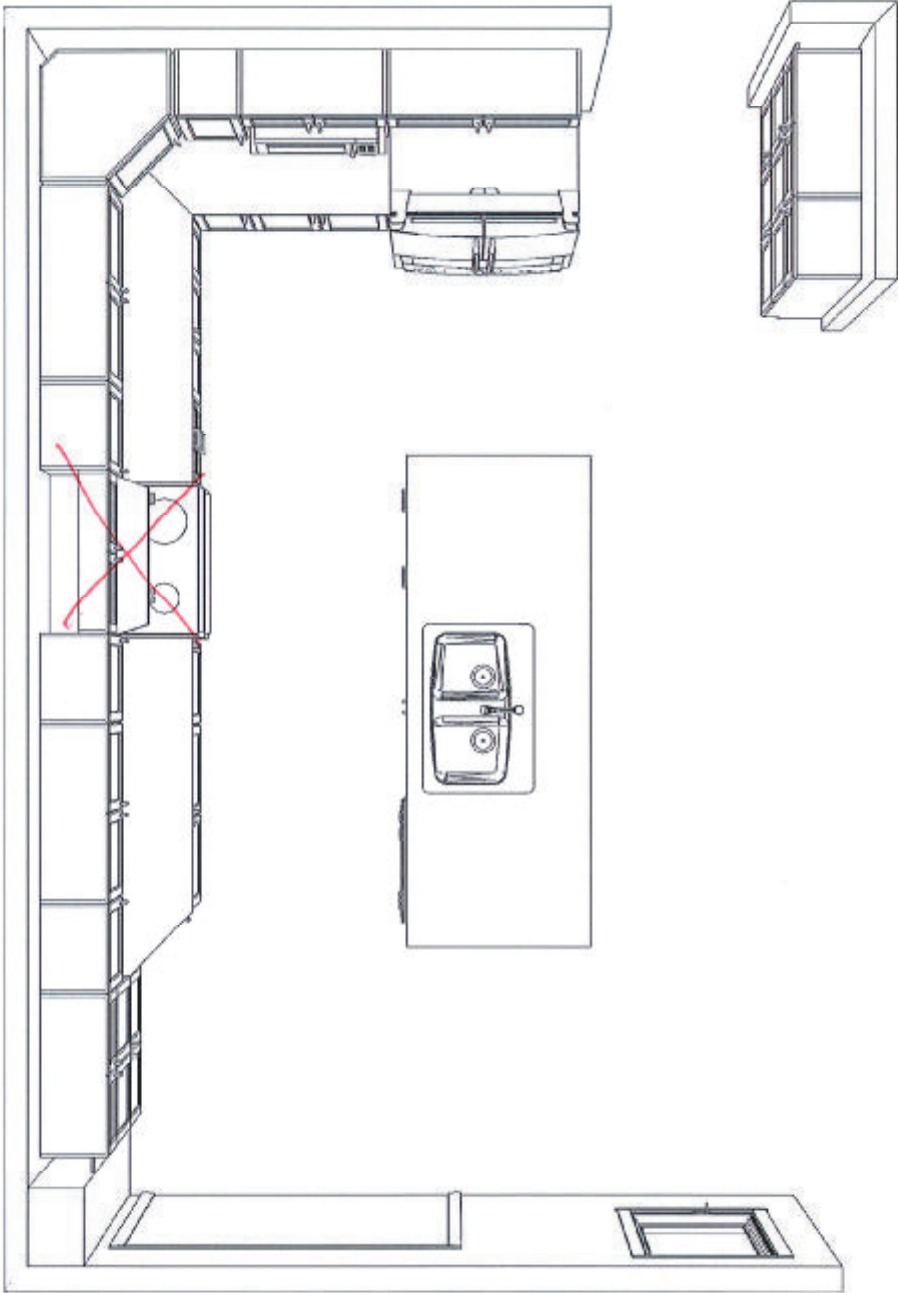

KITCHEN - TOP VIEW

Note: This drawing is an artistic interpretation of the general appearance of the design. It is not meant to be an exact rendition.		Designed: 10/7/2020 Printed: 10/7/2020	
DCR - ROSEMERE - CHEF'S KITCHEN		All	Drawing #: 1

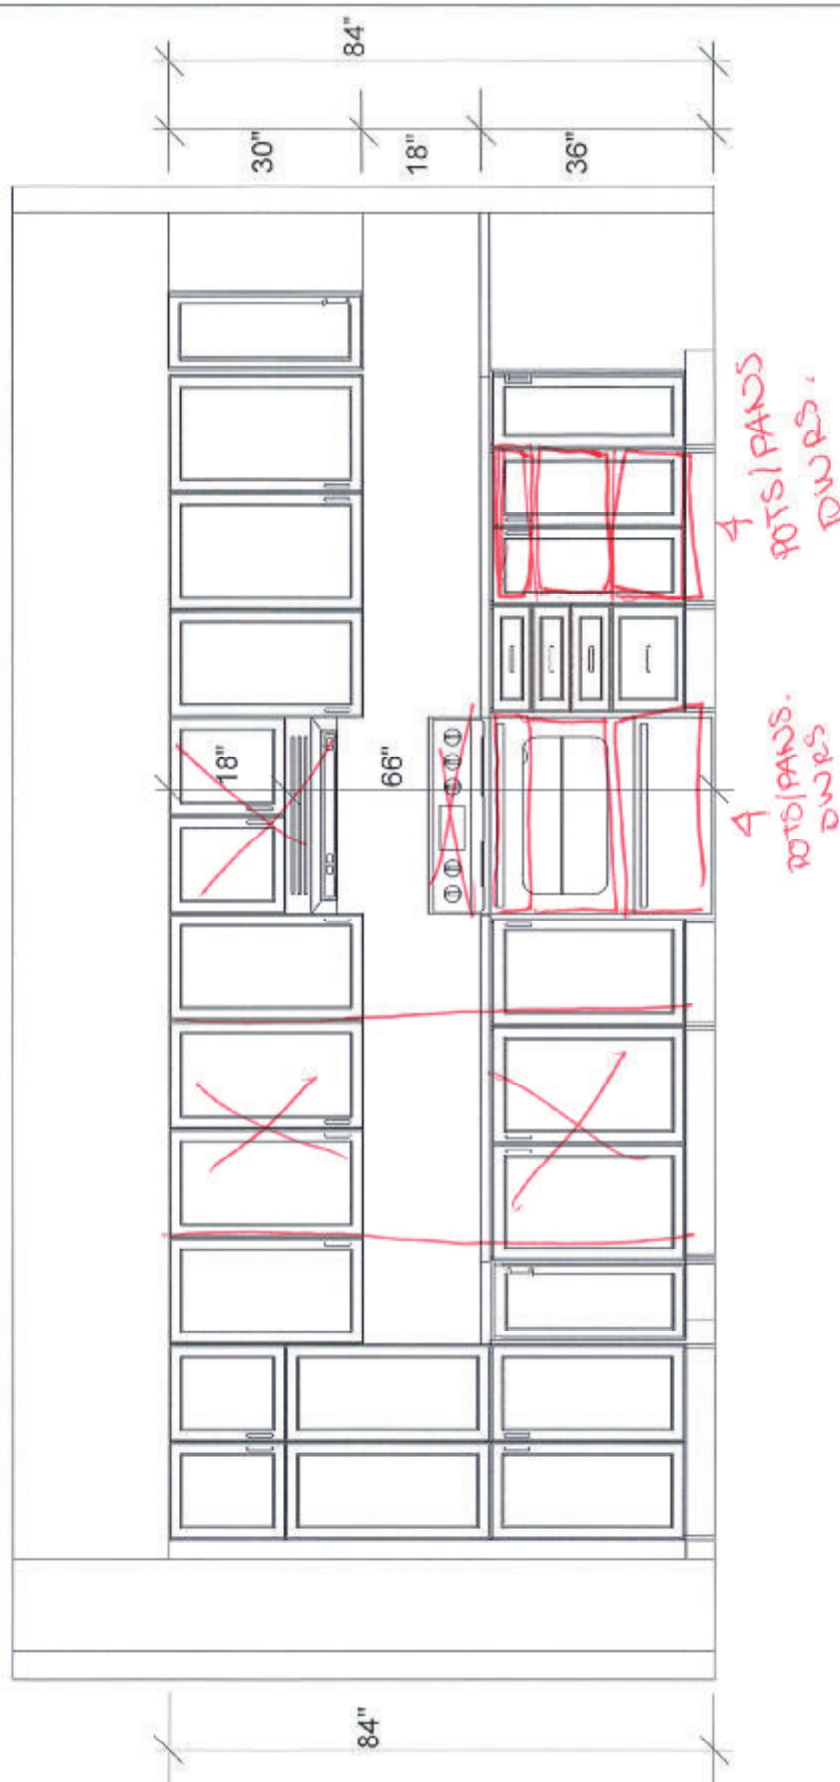

RANGE WALL ELEVATION

Note: This drawing is an artistic interpretation of the general appearance of the design. It is not meant to be an exact rendition.



Designed: 10/7/2020
Printed: 10/7/2020


DCR - ROSEMERIE - CHEF'S KITCHEN

All

Drawing #: 1


—DS

1446

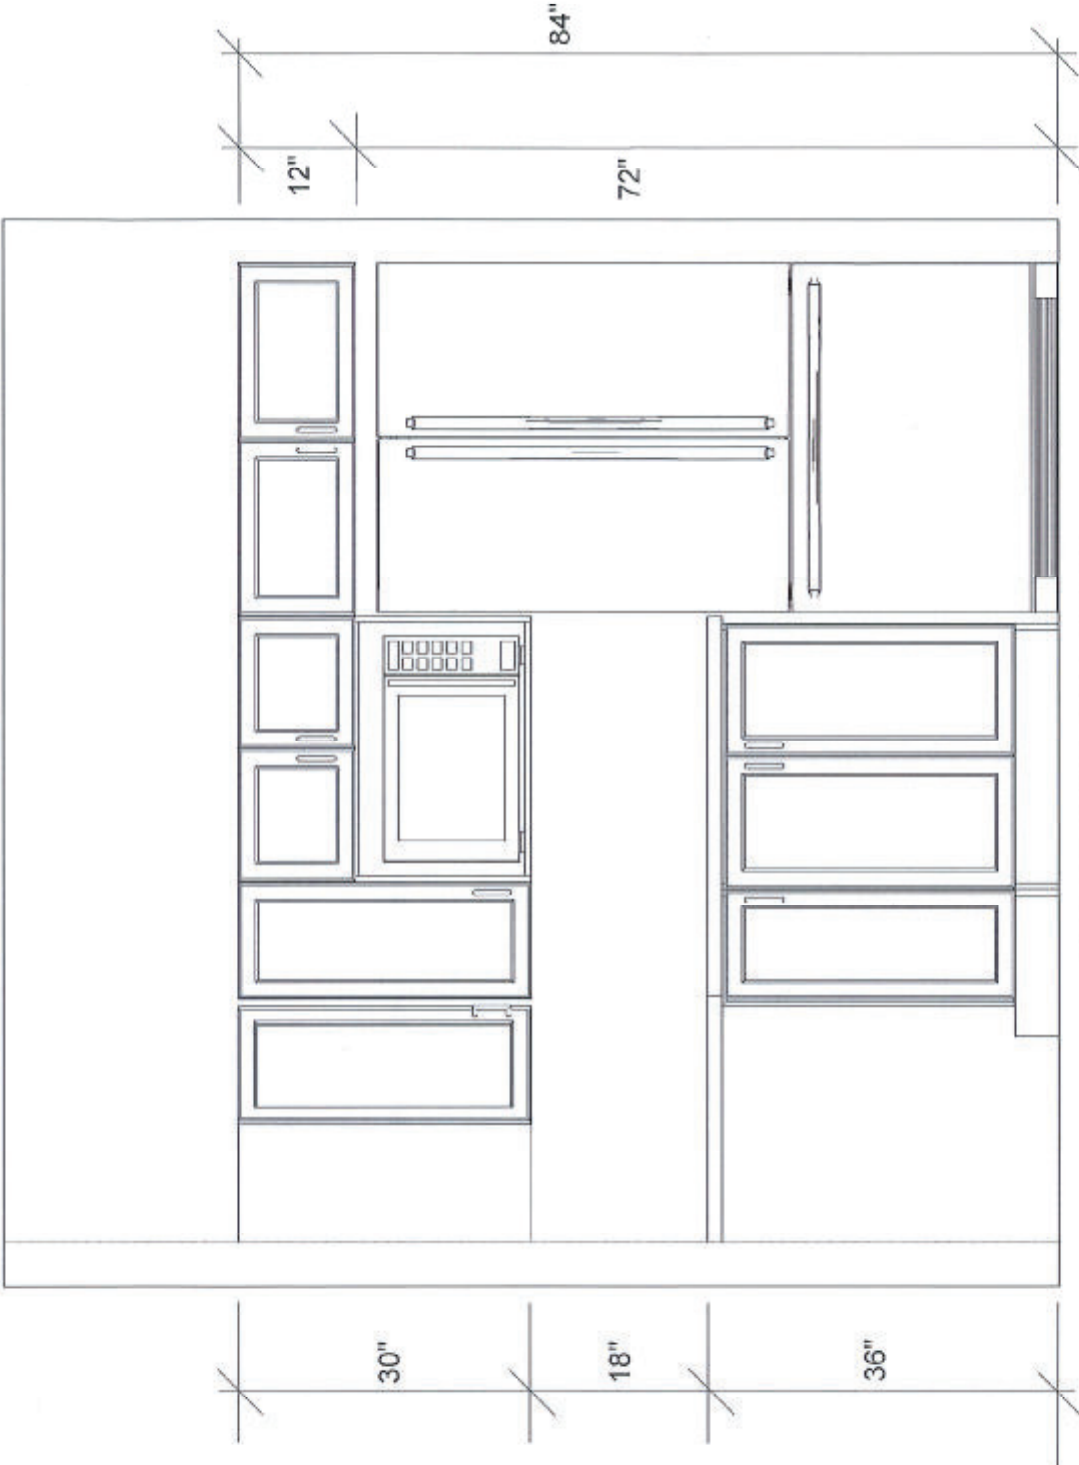


FRIDGE WALL ELEVATION

Note: This drawing is an artistic interpretation of the general appearance of the design. It is not meant to be an exact rendition.		Designed: 10/7/2020 Printed: 10/7/2020	
		DCR - ROSEMERE - CHEF'S KITCHEN	Drawing #: 1

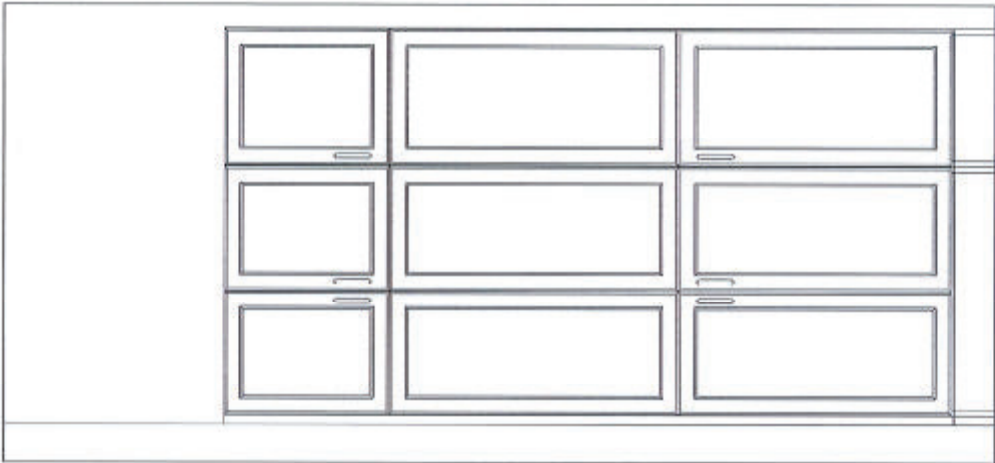


PANTRY WALL ELEVATION

Note: This drawing is an artistic interpretation of the general appearance of the design. It is not meant to be an exact rendition.		Designed: 10/7/2020 Printed: 10/7/2020	
		DCR - ROSEMERE - CHEF'S KITCHEN	Drawing #: 1

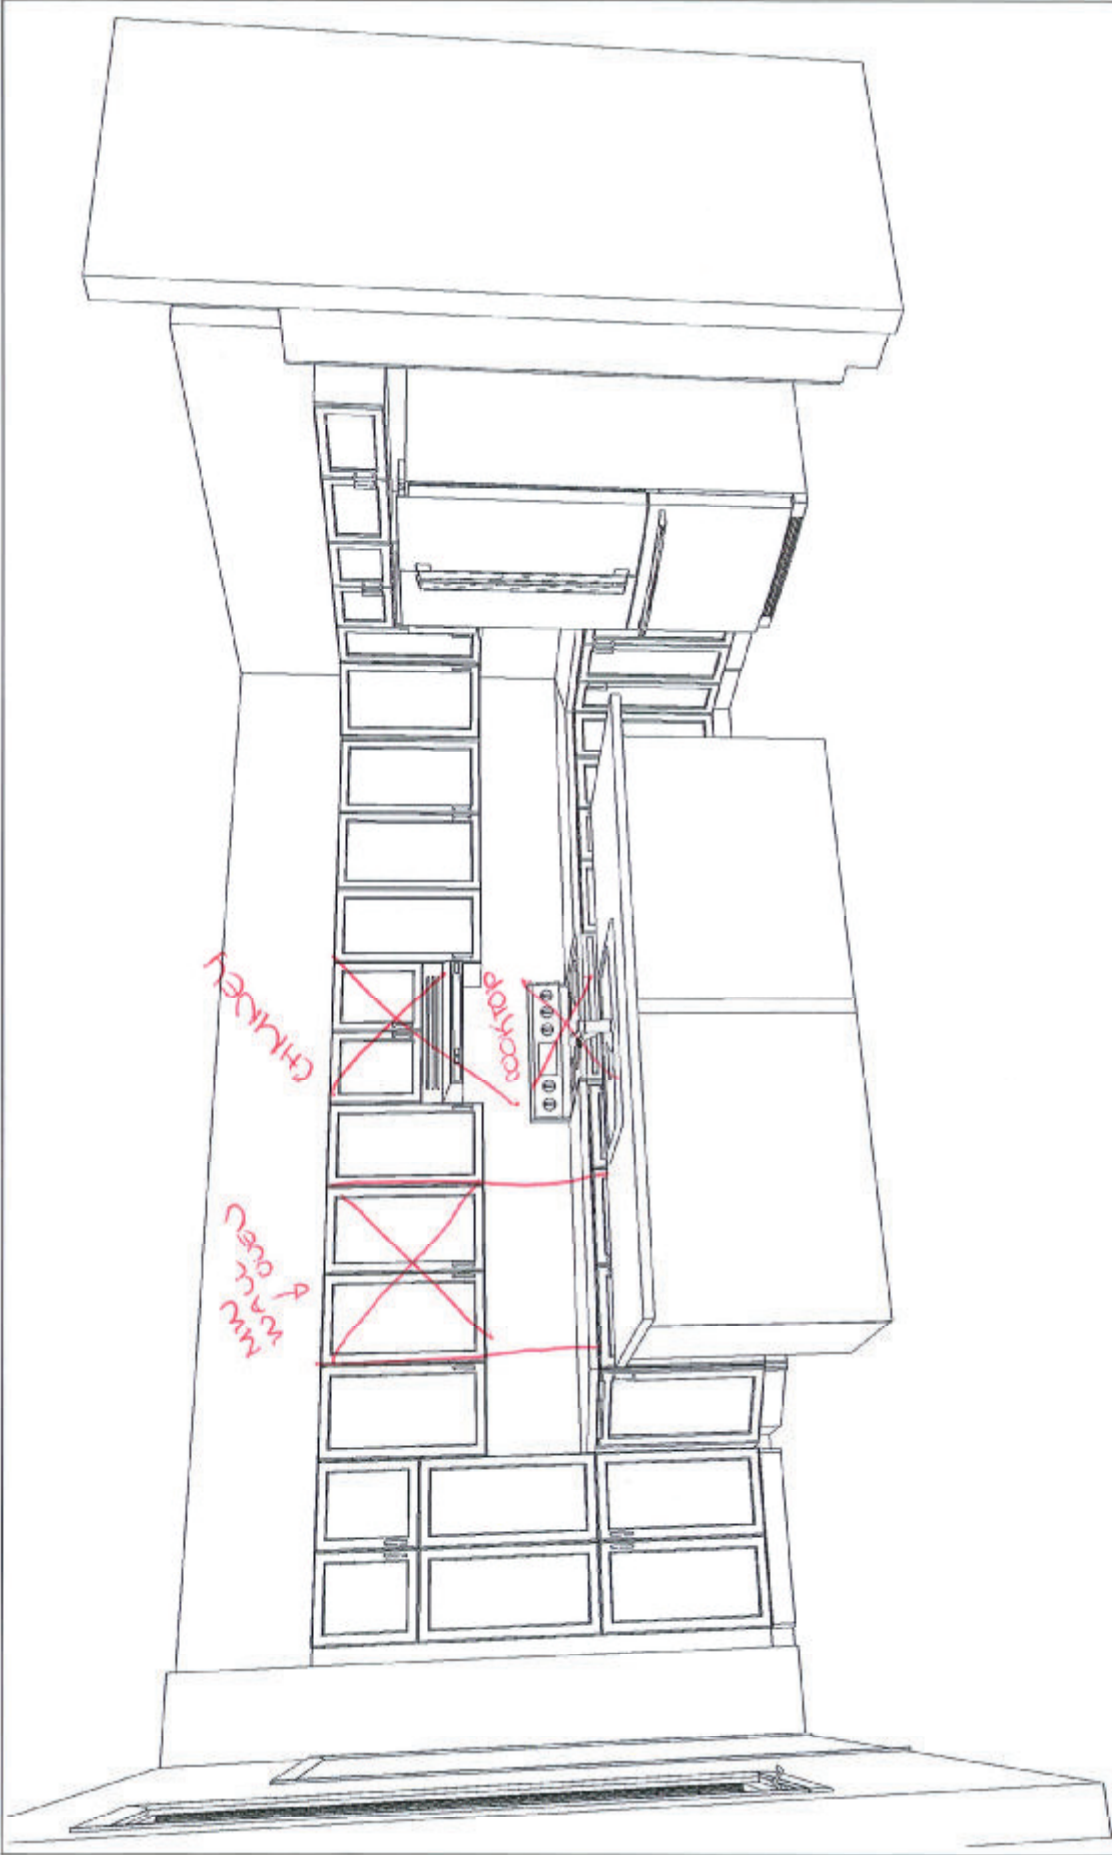

KITCHEN - 3D VIEW #1

Designed: 10/7/2020 Printed: 10/7/2020		Drawing #: 1	
Note: This drawing is an artistic interpretation of the general appearance of the design. It is not meant to be an exact rendition.		All	
DCR - ROSEMERIE - CHEF'S KITCHEN		SPECTRUM INTERIORS & DESIGN	

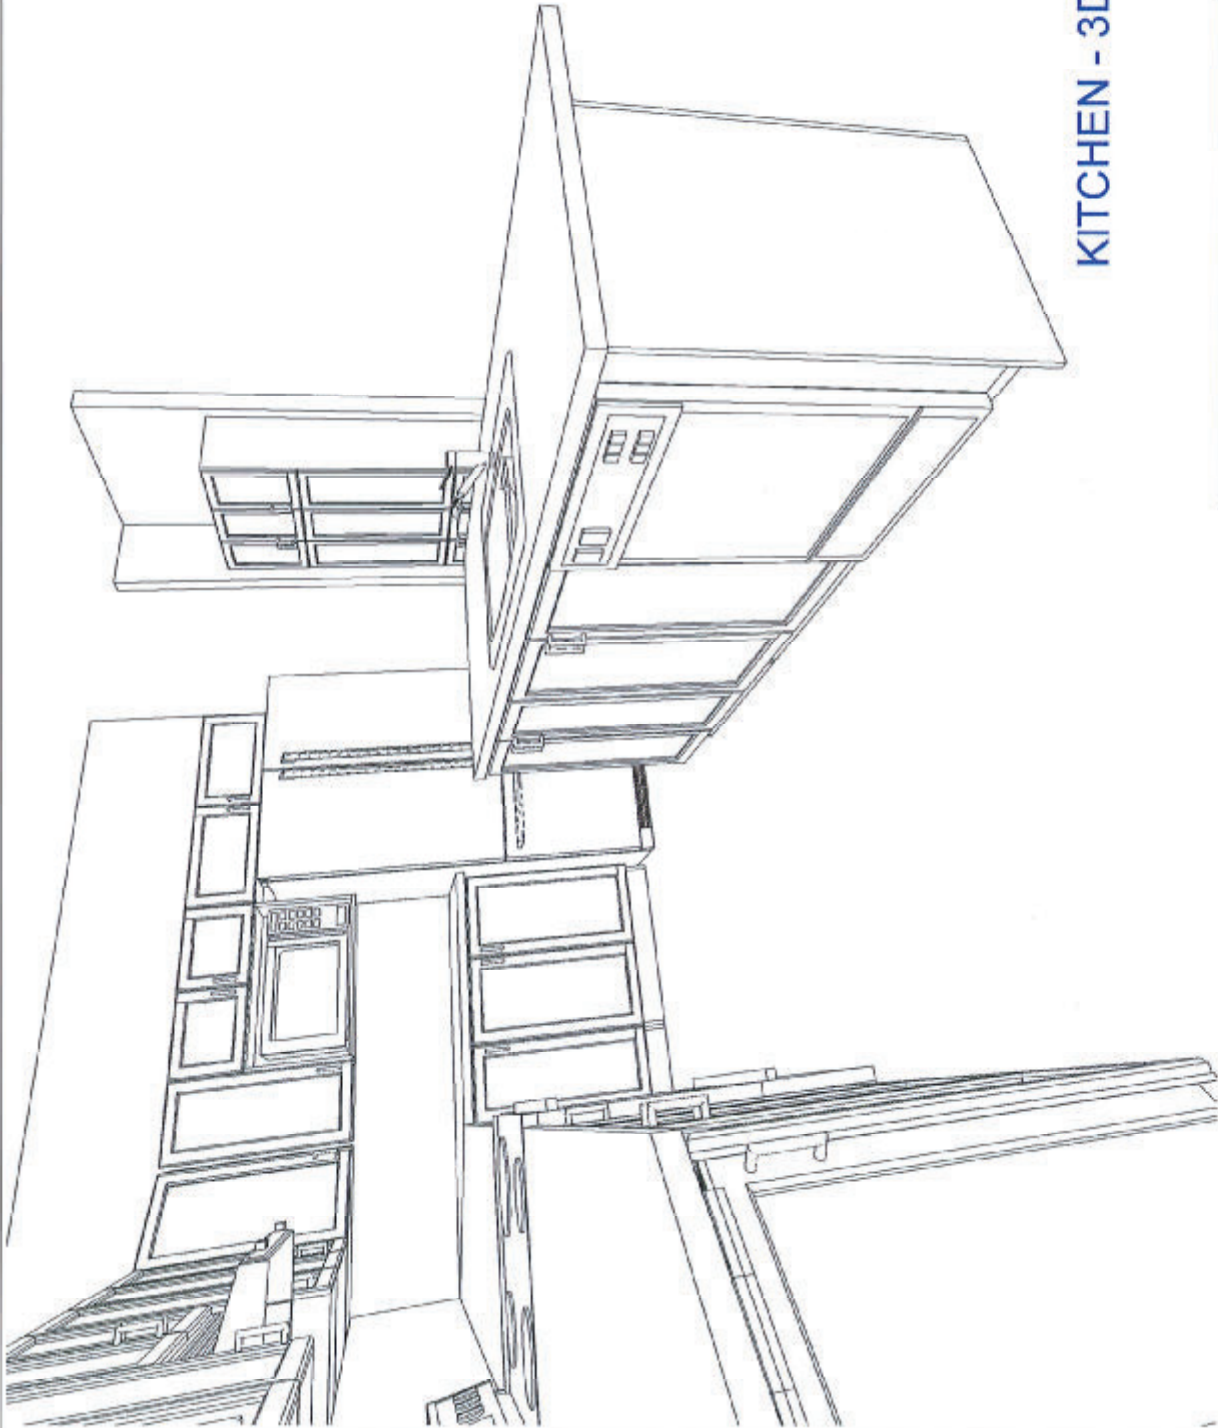

KITCHEN - 3D VIEW #2

Note: This drawing is an artistic interpretation of the general appearance of the design. It is not meant to be an exact rendition.		Designed: 2020-10-06 Printed: 2020-10-09	
		SPECTRUM KITCHEN and BATH DESIGN	DCR - ROSEMERE - CHEF'S KITCHEN.kit