


DCR PHOENIX HOMES

LOT #22  
WHITE TAIL RIDGE 2  
MODEL - OAKSIDE (B-20) WITH LOFT (LEFT)  
KITCHEN  
MOUNTING HEIGHT - 96  
39"H UPPERS INSTALLED @  
21" ABOVE COUNTER  
LIGHT VALANCE

- CABINETS -  
HARDWARE -  
STANDARD WHITE INTERIOR  
METAL DRAWER BOX  
6 PCS - 5/8" KICK - FIN. BOTH ENDS  
2 PCS - LOOSE FILLER - 6 x 96  
1 PCS - 90 DEG. CORNER MOULD  
1 PCS - T-MOULD  
7 PCS - FLAT MOULD

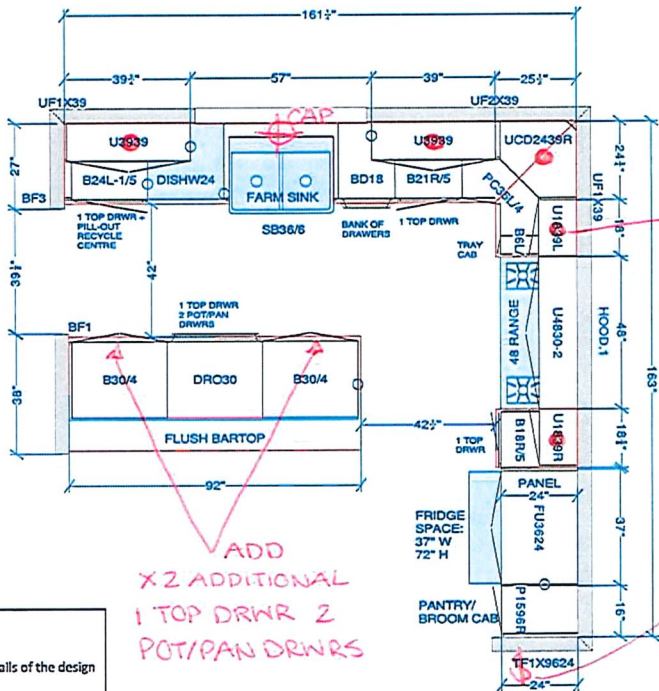


CUSTOMER APPROVAL


I have reviewed these drawings and understand the details of the design and the CARTIER KITCHENS specifications.

Signature \_\_\_\_\_


Date \_\_\_\_\_

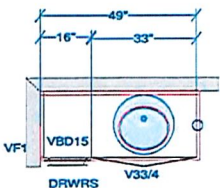


GUEST BATH VANITY

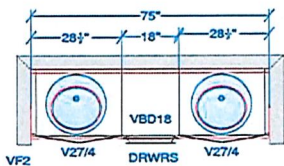

ENSUITE VANITY

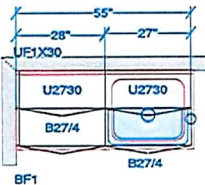

LAUNDRY ROOM  
ADD UPPER CABINETS

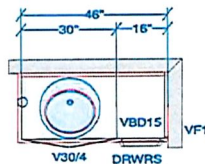

OPTIONAL LOFT  
MAIN BATH VANITY

All dimensions ,size designations given are subject to verification on job site and adjustment to fit job conditions.

SPECTRUM KITCHEN and BATH DESIGN



This is an original design and must not be released or copied unless applicable fee has been paid or job order placed.

DRAWN BY: LORI DISAVERIO, B.I.D


Designed: 2021-03-01  
Printed: 2021-03-01

DCR #22 White Tail Ridge 2 - Oakside (B-20) with Loft -kit

All

Drawing #: 1 No Scale.

DS  
EB  
DS  
M.f

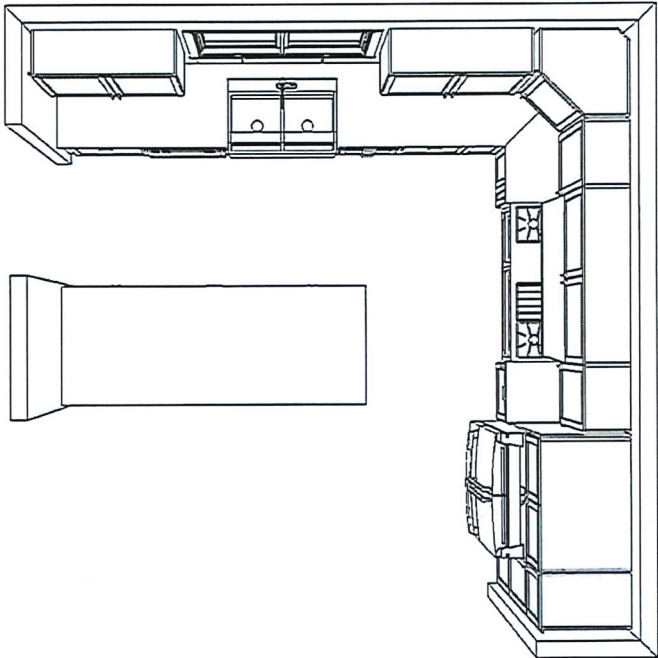

KITCHEN - TOP VIEW

CUSTOMER APPROVAL

I have reviewed these drawings and understand the details of the design and the CARTIER KITCHENS specifications.

Signature\_\_\_\_\_

Date \_\_\_\_\_

Note: This drawing is an artistic interpretation of the general appearance of the design. It is not meant to be an exact rendition.

SPECTRUM KITCHEN and BATH DESIGN




Designed: 2021-03-01  
Printed: 2021-03-01

DCR #22 White Tail Ridge 2 - Oakside (B-20) with

All

Drawing #: 1

X1 CAP LIGHT FOR  
FUTURE SCONCE

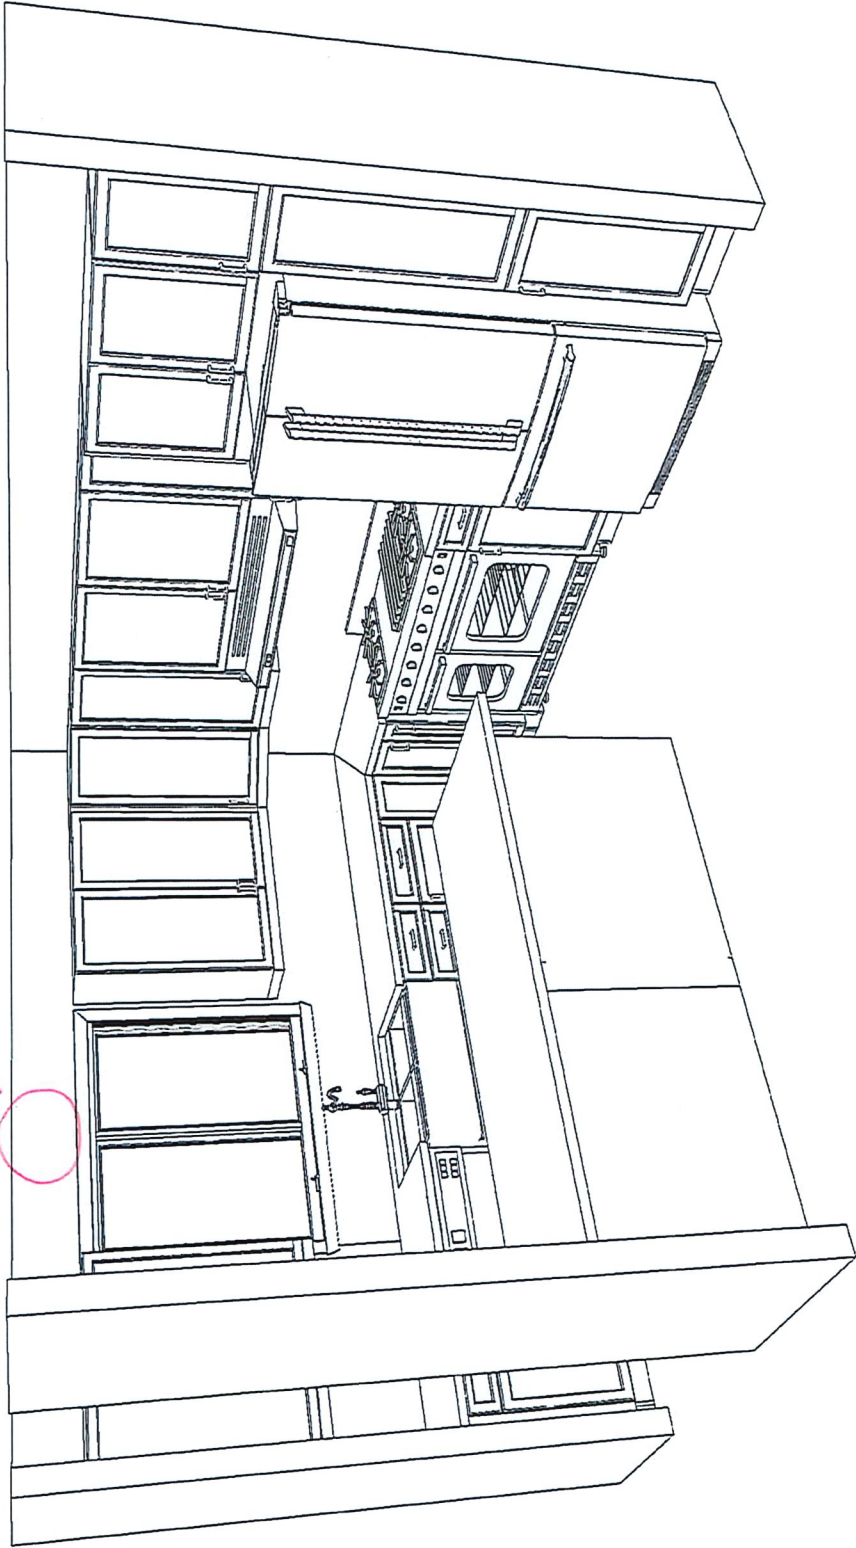

KITCHEN - 3D VIEW #1

CUSTOMER APPROVAL

I have reviewed these drawings and understand the details of the design and the CARTIER KITCHENS specifications.

Signature \_\_\_\_\_

Date \_\_\_\_\_


Note: This drawing is an artistic interpretation of the general appearance of the design. It is not meant to be an exact rendition.

SPECTRUM KITCHEN and BATH DESIGN

DCR #22 White Tail Ridge 2 - Oakside (B-20) with All



Designed: 2021-03-01  
Printed: 2021-03-01

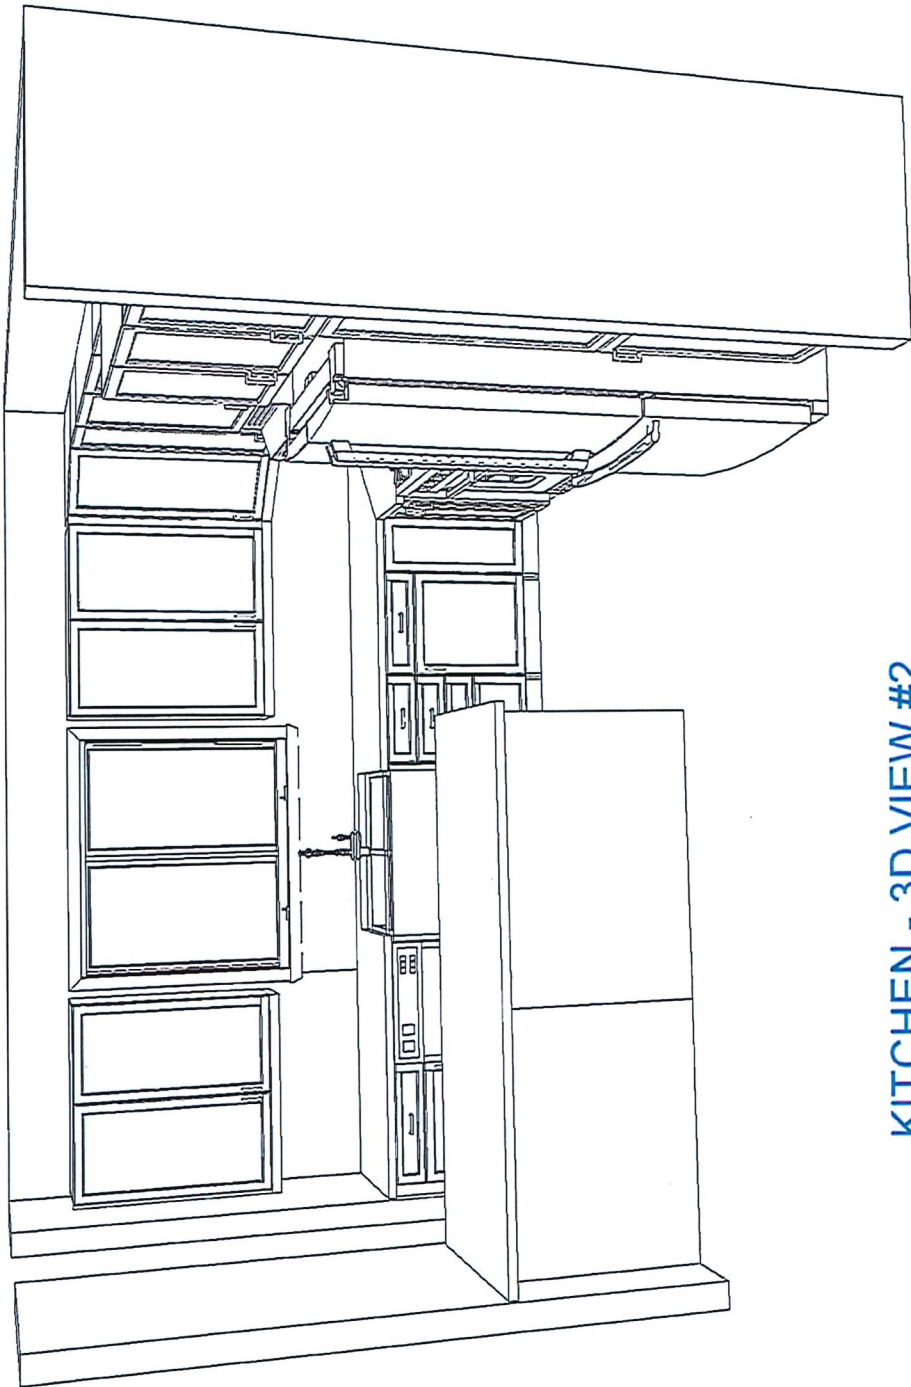

KITCHEN - 3D VIEW #2

CUSTOMER APPROVAL

I have reviewed these drawings and understand the details of the design and the CARTIER KITCHEN'S specifications.

Signature \_\_\_\_\_

Date \_\_\_\_\_

Note: This drawing is an artistic interpretation of the general appearance of the design. It is not meant to be an exact rendition.


SPECTRUM KITCHEN and BATH DESIGN



DCR #22 White Tail Ridge 2 - Oakside (B-20) with All

Designed: 2021-03-01  
Printed: 2021-03-01

Drawing #: 1

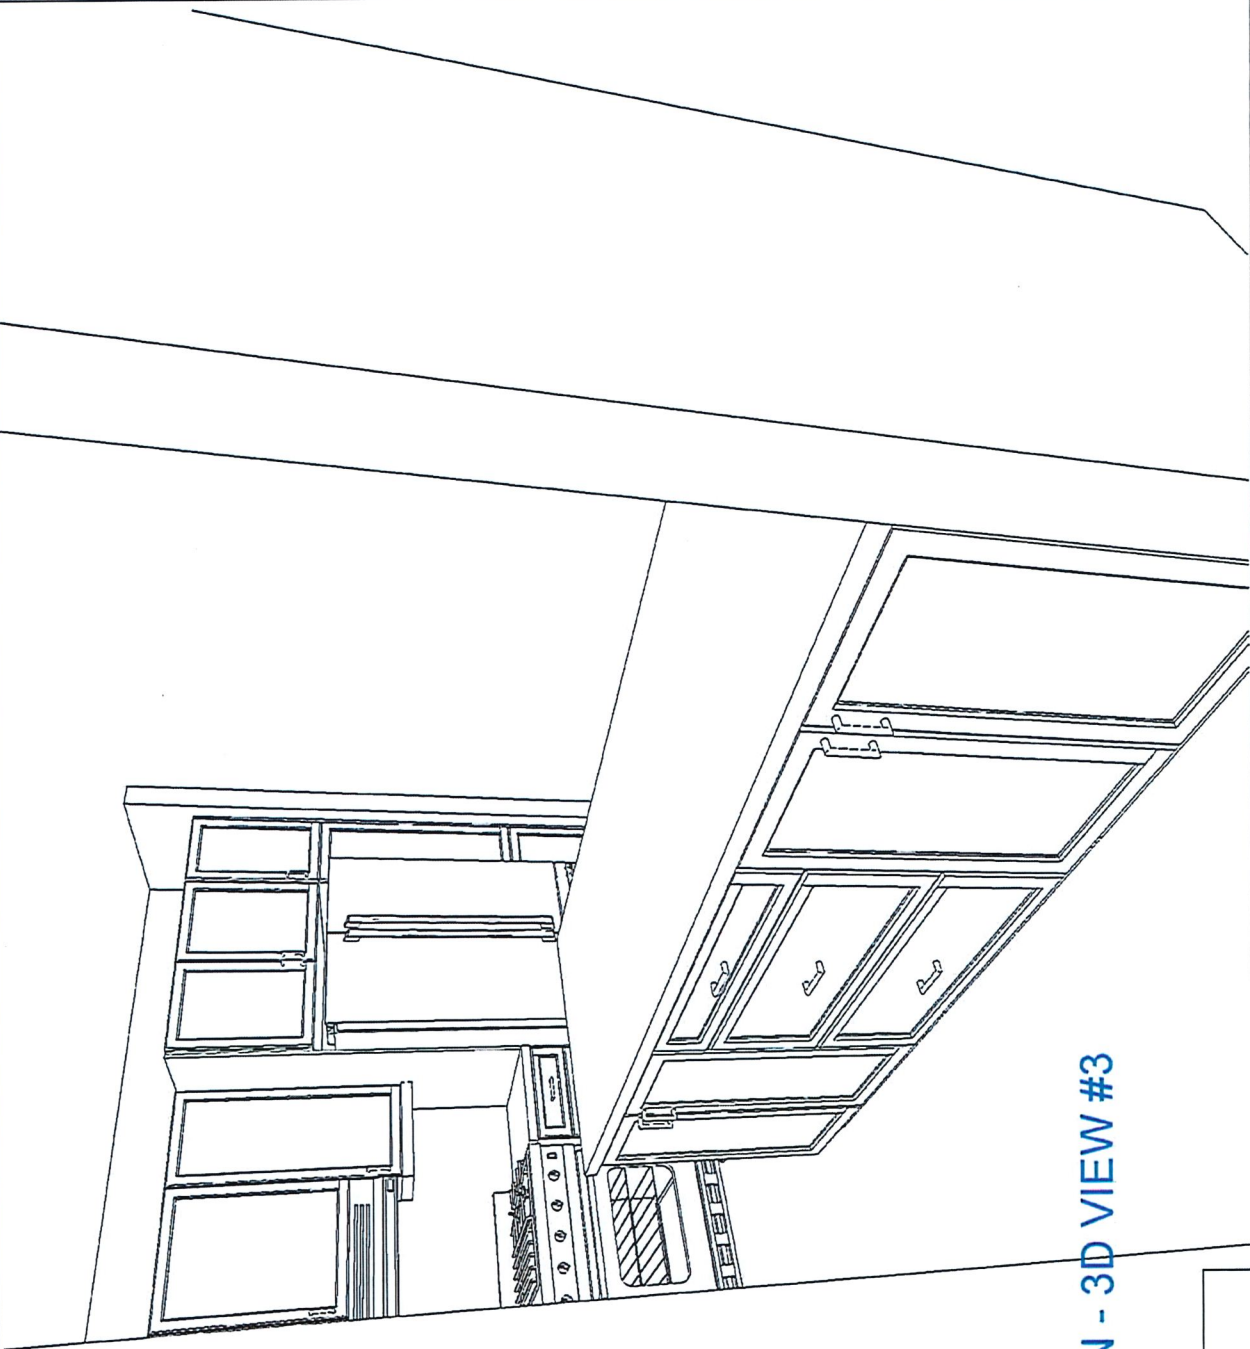

KITCHEN - 3D VIEW #3

CUSTOMER APPROVAL

I have reviewed these drawings and understand the details of the design and the CARTIER KITCHENS specifications.

Signature \_\_\_\_\_

Date \_\_\_\_\_

Note: This drawing is an artistic interpretation of the general appearance of the design. It is not meant to be an exact rendition.




SPECTRUM KITCHEN and BATH DESIGN

DCR #22 White Tail Ridge 2 - Oakside (B-20) with All

Designed: 2021-03-01  
Printed: 2021-03-01

Drawing #: 1

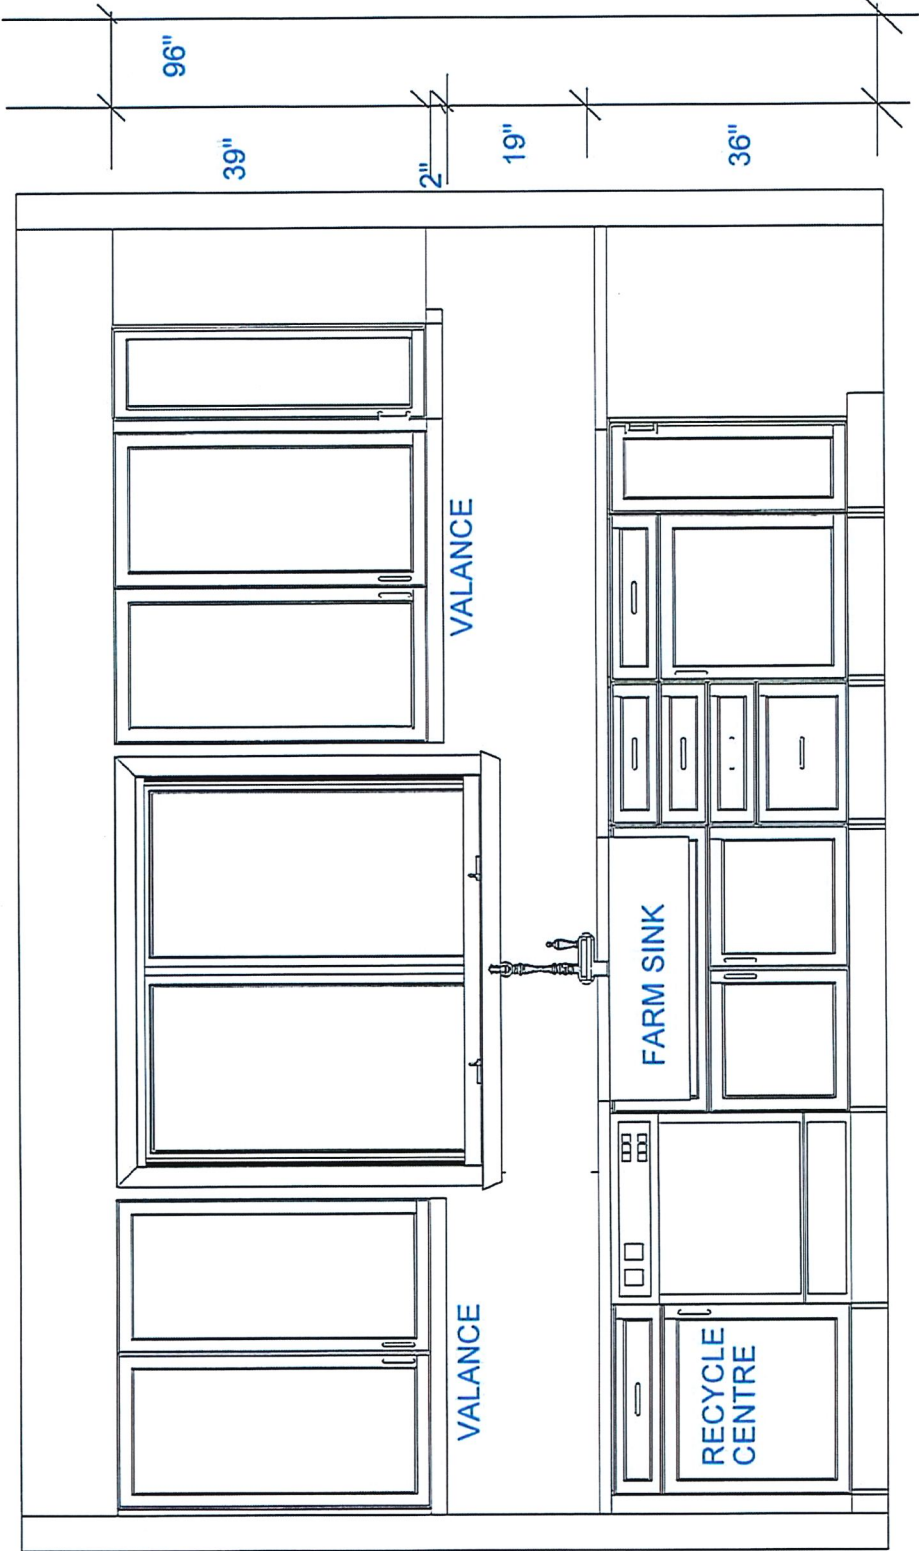

SINK WALL ELEVATION


**CUSTOMER APPROVAL**

I have reviewed these drawings and understand the details of the design and the CARTIER KITCHENS specifications.

Signature \_\_\_\_\_

Date \_\_\_\_\_

|                                                                                                                                     |                                                                                     |                                             |                                                      |
|-------------------------------------------------------------------------------------------------------------------------------------|-------------------------------------------------------------------------------------|---------------------------------------------|------------------------------------------------------|
| Note: This drawing is an artistic interpretation of the general appearance of the design. It is not meant to be an exact rendition. |  | Designed: 2021-03-01<br>Printed: 2021-03-01 |                                                      |
|                                                                                                                                     |                                                                                     | SPECTRUM KITCHEN and BATH DESIGN            | DCR #22 White Tail Ridge 2 - Oakside (B-20) with All |
|                                                                                                                                     |                                                                                     | Drawing #: 1                                |                                                      |

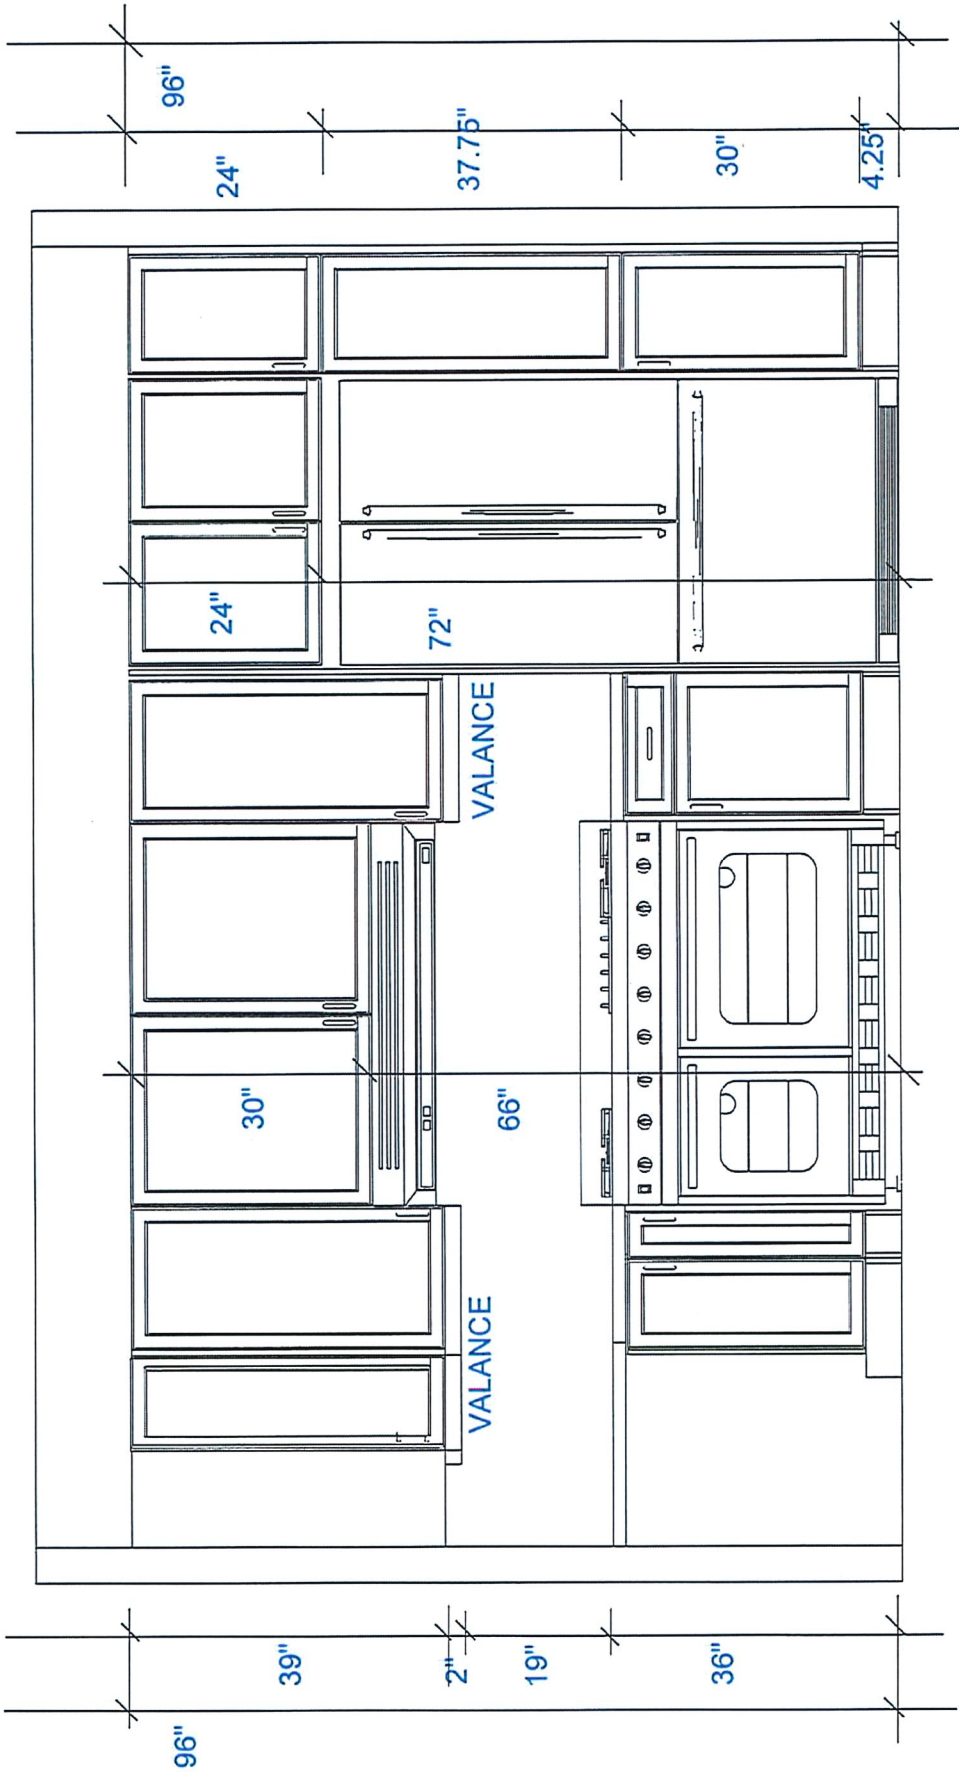

## RANGE / FRIDGE WALL ELEVATION

## CUSTOMER APPROVAL

I have reviewed these drawings and understand the details of the design and the CARTIER KITCHENS specifications.

**Signature**

Date: \_\_\_\_\_

**Note:** This drawing is an artistic interpretation of the general appearance of the design. It is not meant to be an exact rendition.


## SPECTRUM KITCHEN and BATH DESIGN

DCR #22 White Tail Ridge 2 - Oakside (B-20) with




Designed: 2021-03-01  
Printed: 2021-03-01


Drawing #: 1

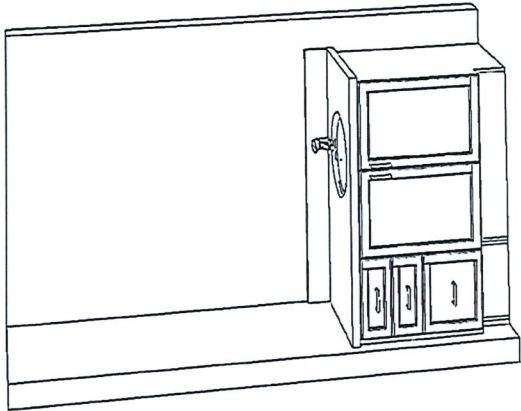


GUEST BATH VANITY

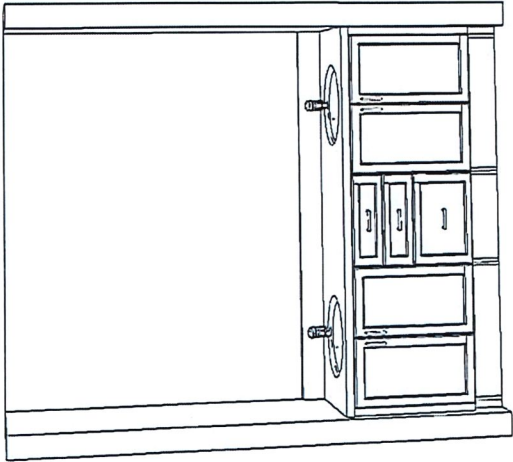

ENSUITE VANITY

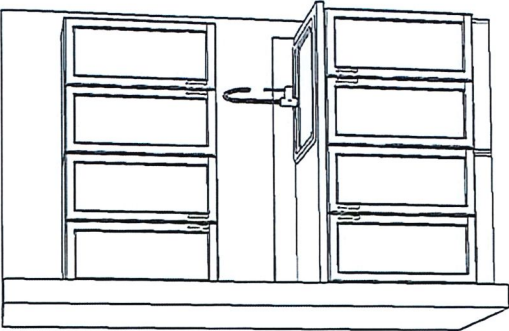

LAUNDRY ROOM

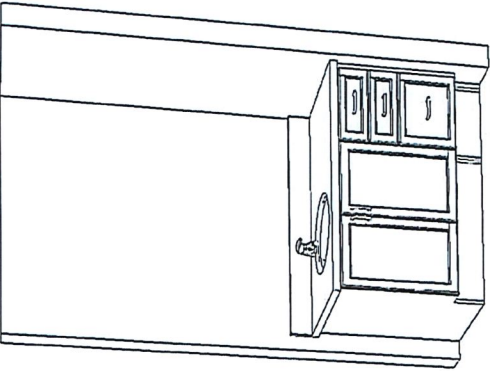

LOFT VANITY

CUSTOMER APPROVAL

I have reviewed these drawings and understand the details of the design and the CARTIER KITCHENS specifications.

Signature \_\_\_\_\_

Date \_\_\_\_\_

|                                                                                                                                     |  |                                                                                     |                                             |  |
|-------------------------------------------------------------------------------------------------------------------------------------|--|-------------------------------------------------------------------------------------|---------------------------------------------|--|
| Note: This drawing is an artistic interpretation of the general appearance of the design. It is not meant to be an exact rendition. |  |  | Designed: 2021-03-01<br>Printed: 2021-03-01 |  |
| SPECTRUM KITCHEN and BATH DESIGN                                                                                                    |  |                                                                                     |                                             |  |
| DCR #22 White Tail Ridge 2 - Oakside (B-20) with                                                                                    |  | All                                                                                 | Drawing #: 1                                |  |