



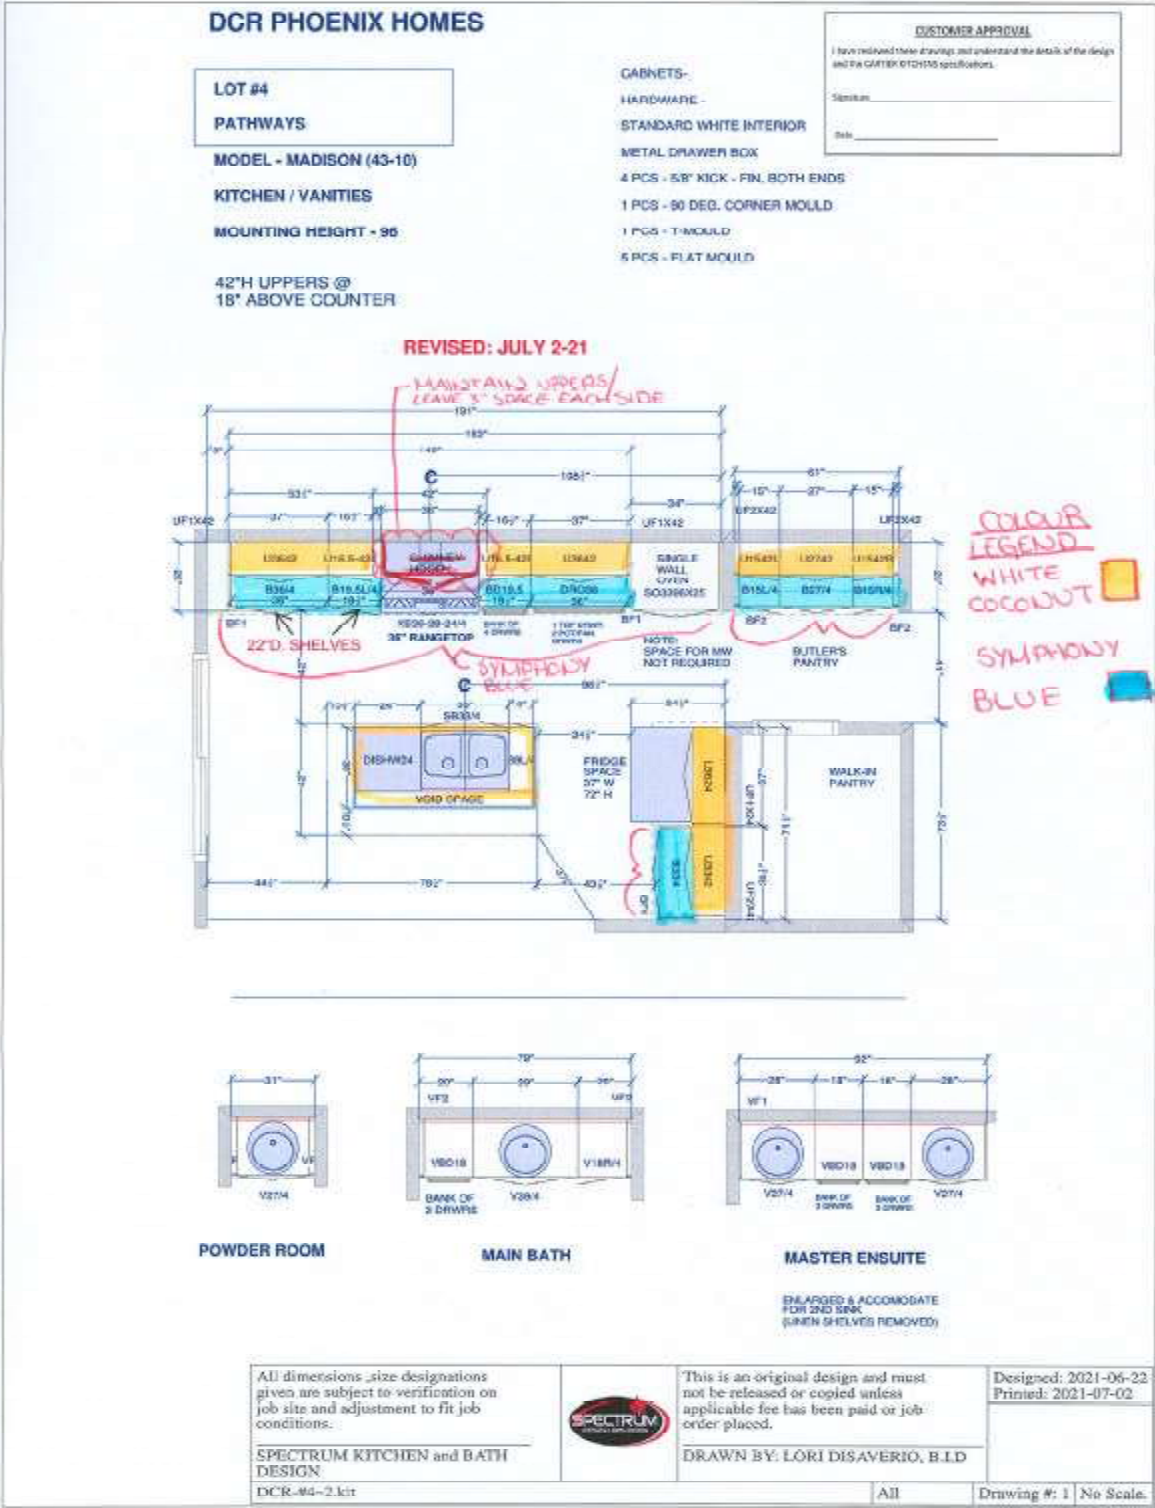

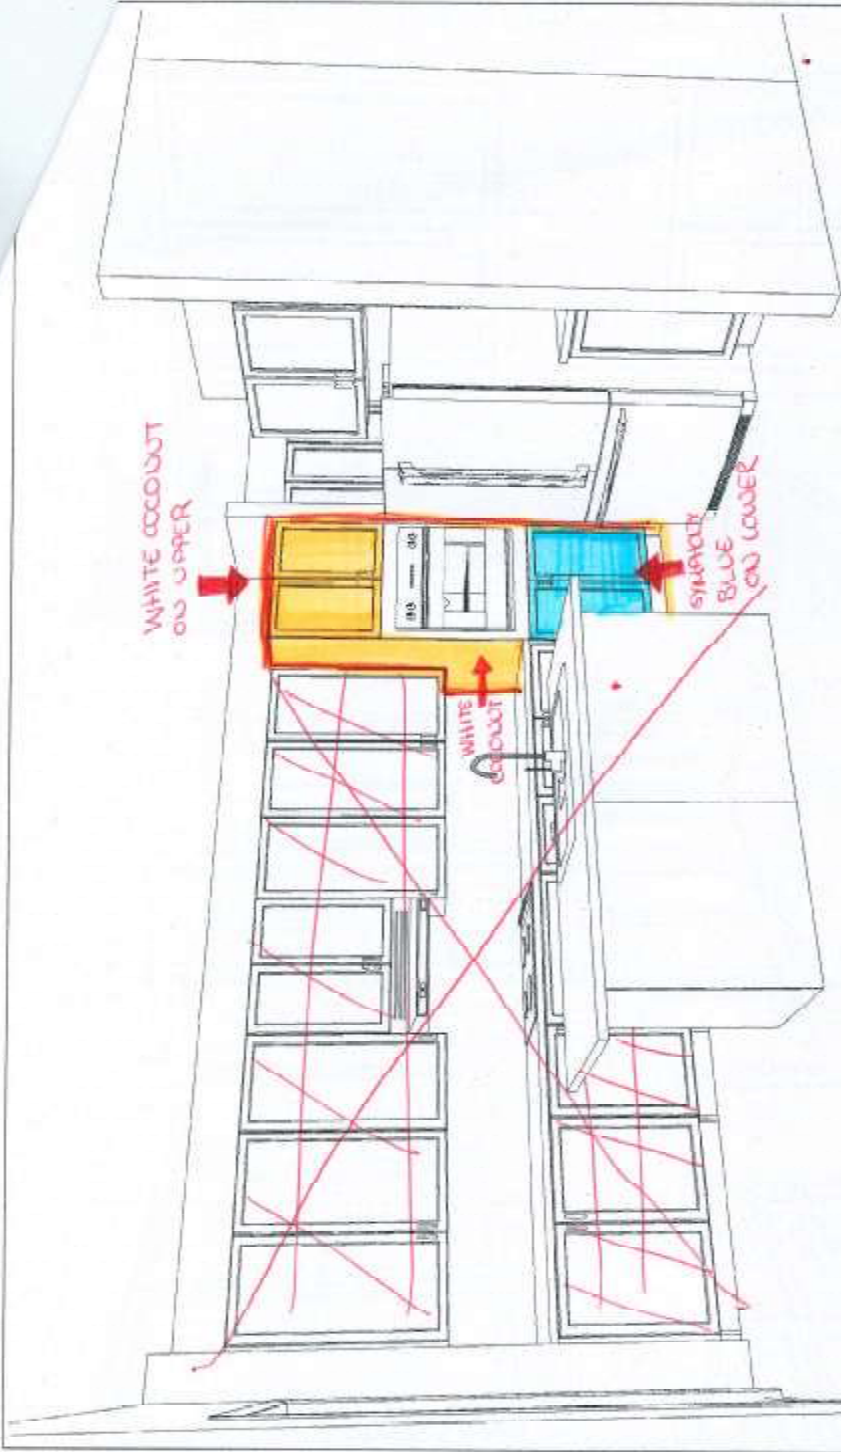

KITCHEN - 3D VIEW #1

CUSTOMER APPROVAL

I have reviewed (these drawings) and understand the details of the design and the Contractor's specifications.

Signature _____

Date _____

	All	DCR - #4 Pathways - Madison (43-10)	Designed: 11/23/2020
			Printed: 11/24/2020
Note: This drawing is an artistic interpretation of the general appearance of the design. It is not meant to be an exact rendition.			Drawing #: 1