

CUSTOMER APPROVAL

I have reviewed these drawings and understand the details of the design and the CARTIER KITCHENS specifications.


Signature_____

Date_____


DCR PHOENIX HOMES

LOT #7
PATHWAYS
MODEL - ANNAPOLIS (509)
VANITIES

CABINETS -
HARDWARE -
STANDARD WHITE INTERIOR
METAL DRAWER BOX
5/8" TOE KICK
FLAT SHOE MOULDING

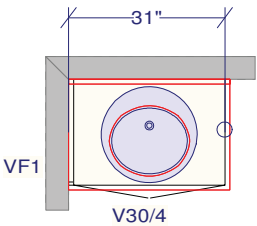


POWDER

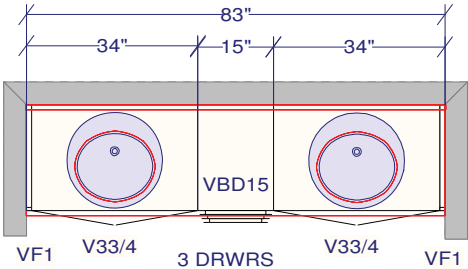


SHARED BATH
BDRM 3 & 4

NOTE: VANITY ENLARGED
TO ACCOMODATE 2 SINKS
(TOILET MOVED)

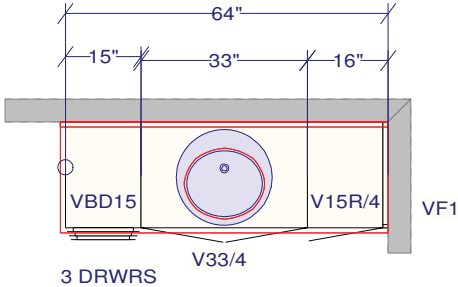

ENSUITE #2

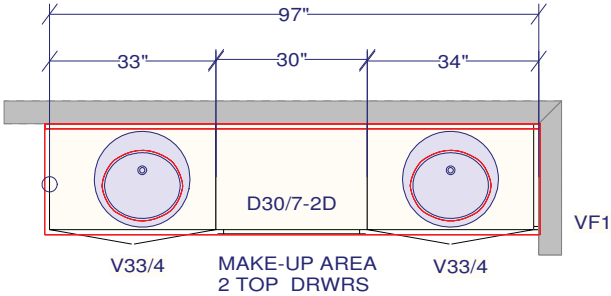

MASTER ENSUITE

All dimensions _size designations given are subject to verification on job site and adjustment to fit job conditions.

SPECTRUM KITCHEN and BATH DESIGN




This is an original design and must not be released or copied unless applicable fee has been paid or job order placed.


DRAWN BY: LORI DISAVERIO, B.I.D

Designed: 2020-09-10
Printed: 2020-09-10




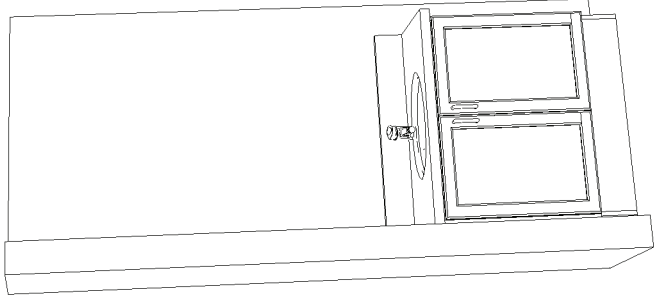


POWDER ROOM

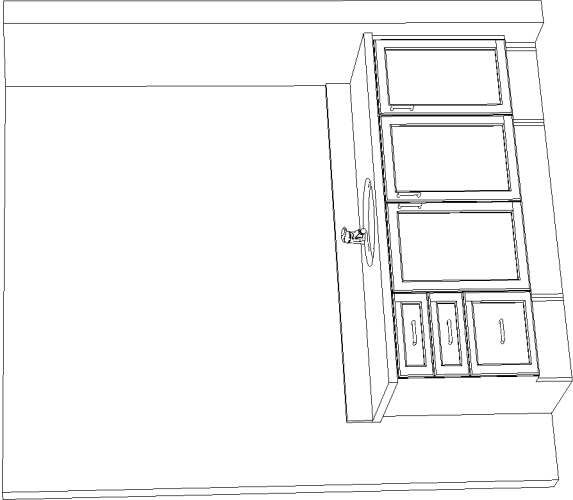

ENSUITE #2

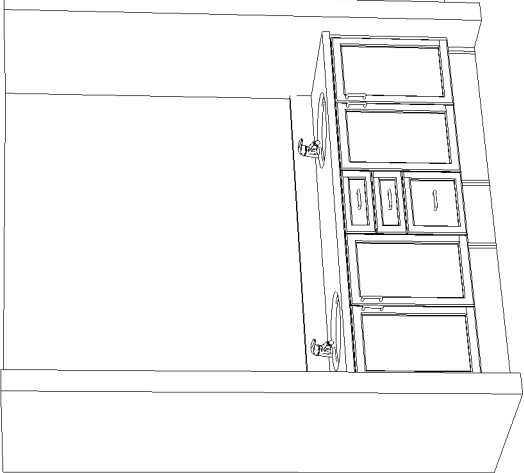

MAIN BATH (SHARED)

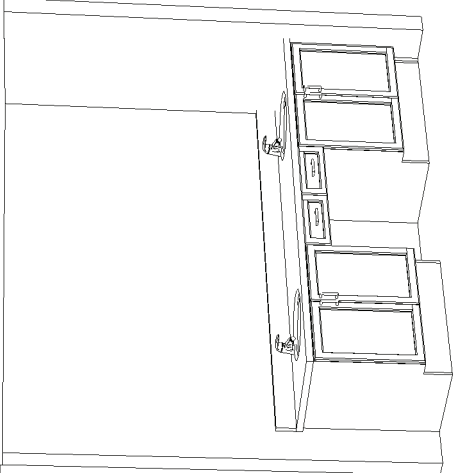

MASTER ENSUITE

VANITIES - 3D VIEWS

CUSTOMER APPROVAL

I have reviewed these drawings and understand the details of the design and the CARTIER KITCHENS specifications.

Signature_____

Date_____

Note: This drawing is an artistic interpretation of the general appearance of the design. It is not meant to be an exact rendition. SPECTRUM KITCHEN and BATH DESIGN DCR #7 PWYS - Annapolis Vanities.kit		Designed: 2020-09-10 Printed: 2020-09-10	
			
		All	Drawing #: 1

DCR PHOENIX HOMES

LOT #7
PATHWAYS
MODEL - ANNAPOLIS (509)
KITCHEN


MOUNTING HEIGHT -96

42"H UPPERS @ 18"
ABOVE COUNTER

FILL TO CEILING WITH 1" MOULDING,
FURRING PANEL & CEILING CROWN


LIGHT VALANCE

- CABINETS -
HARDWARE -
STANDARD WHITE INTERIOR
METAL DRAWER BOX
4 PCS - 5/8" KICK - FIN. BOTH ENDS
2 PCS - LOOSE FILLER - 6 x 96
2 PCS - 90 DEG. CORNER MOULD
1 PCS - T-MOULD

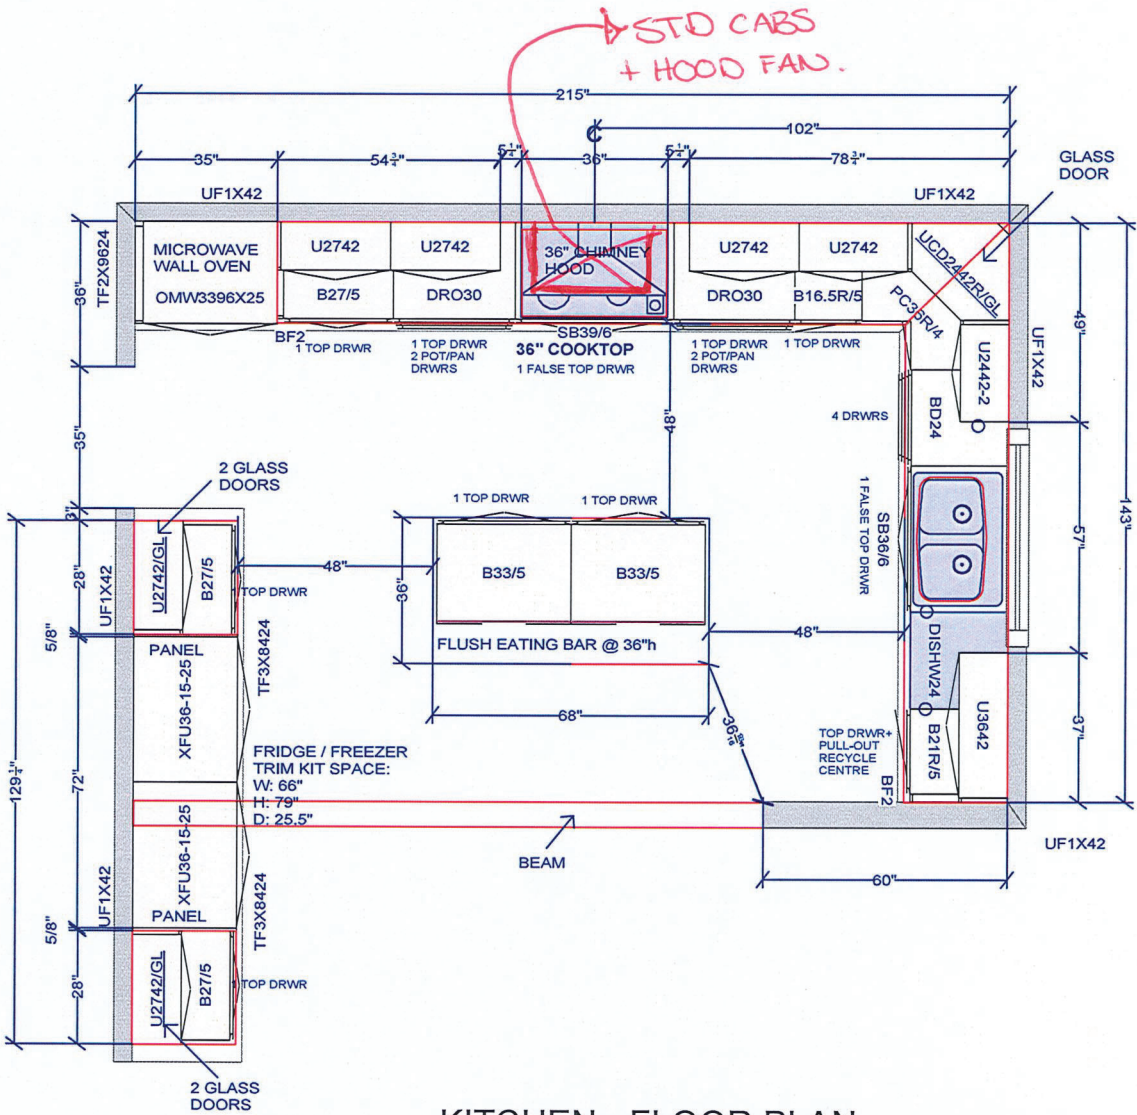

KITCHEN - FLOOR PLAN

CUSTOMER APPROVAL I have reviewed these drawings and understand the details of the design and the Cartier Kitchens specifications Signature _____ Date _____	All dimensions _size designations given are subject to verification on job site and adjustment to fit job conditions.	This is an original design and must not be released or copied unless applicable fee has been paid or job order placed.	Designed: 9/10/2020		
			Printed: 9/10/2020		
			DS TS	DS RS	
DCR #7 Pathways- Annapolis KITCHEN -			All	Drawing #: 1	No Scale.

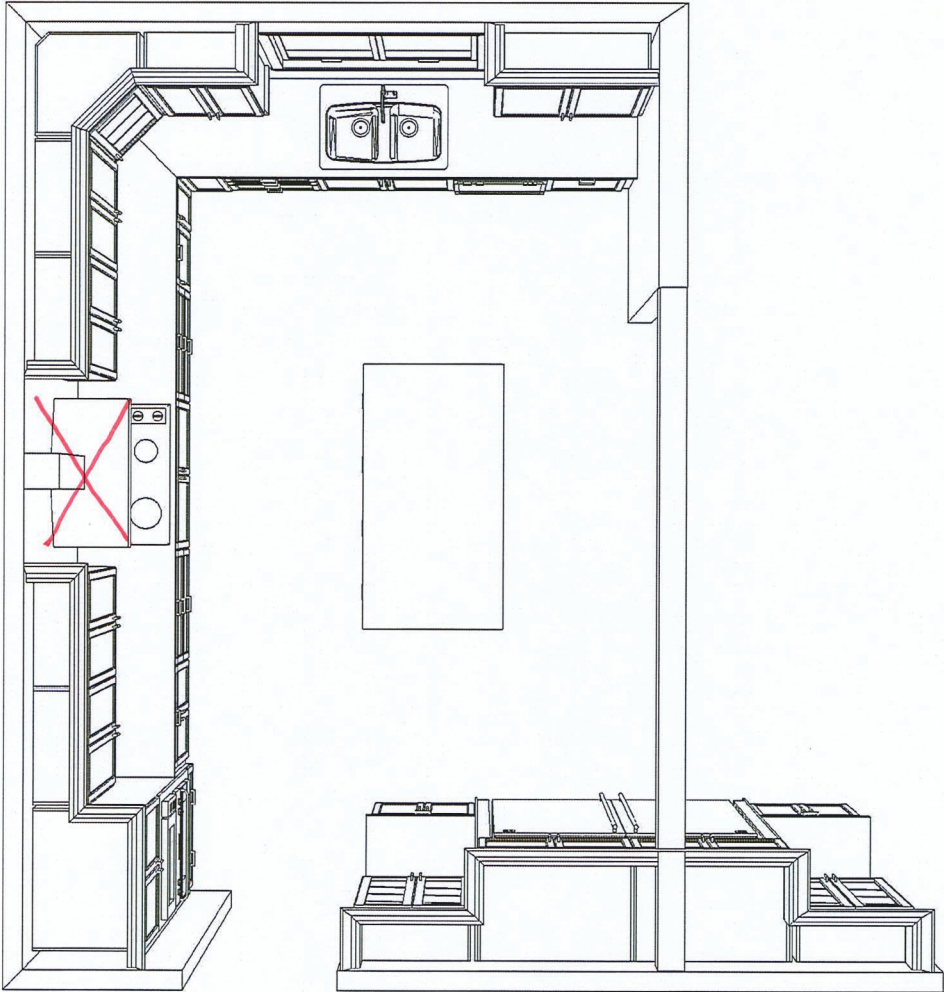

KITCHEN - TOP VIEW

Note: This drawing is an artistic interpretation of the general appearance of the design. It is not meant to be an exact rendition.		Designed: 9/10/2020 Printed: 9/10/2020
		DCR #7 Pathways- Annapolis KITCHEN - All Drawing #: 1


CUSTOMER APPROVAL

I have reviewed these drawings and understand the details of the design and the Cartier Kitchens specifications

Signature _____
Date _____

DS
TS

DS
RS

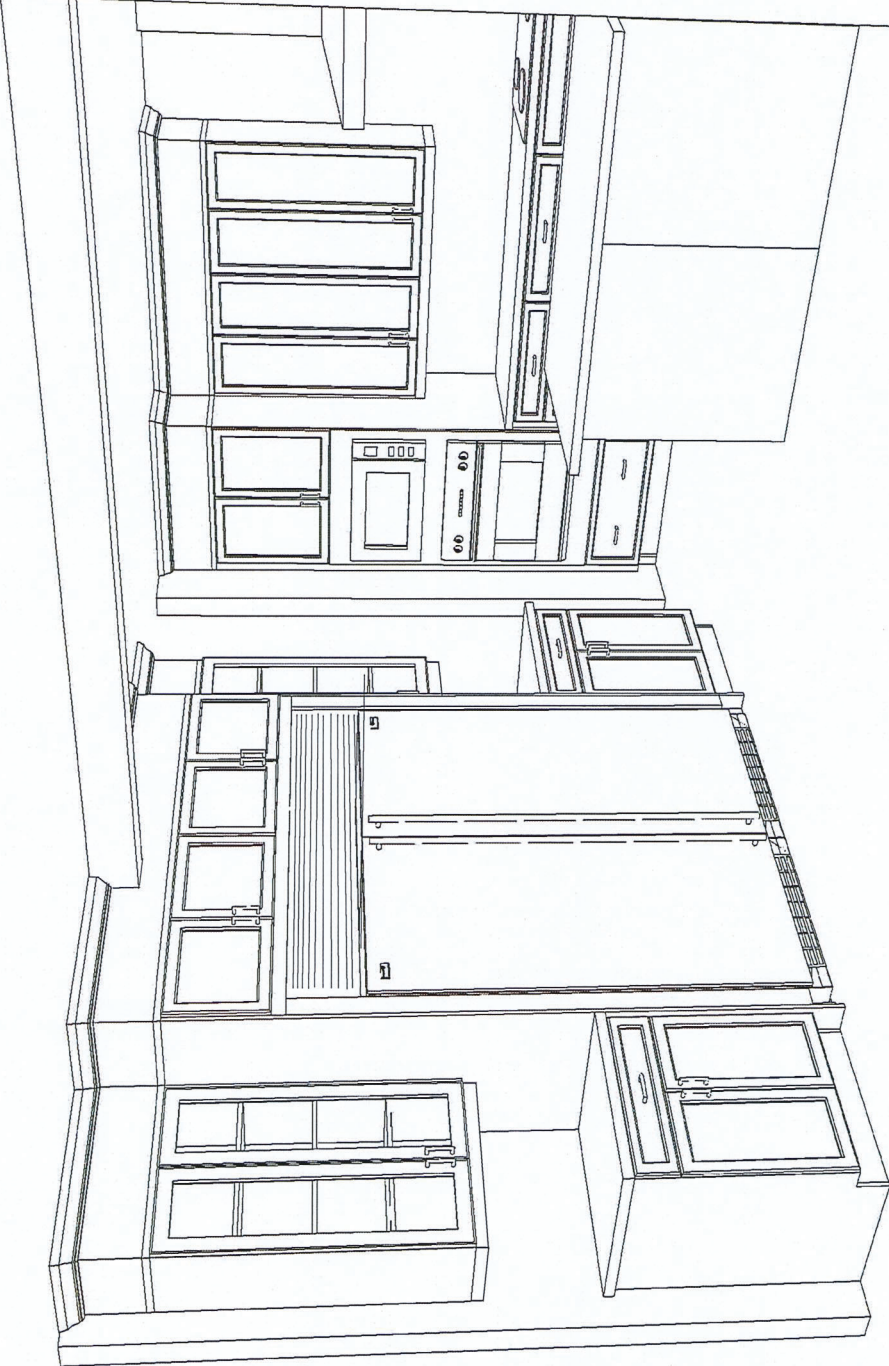

KITCHEN - 3D VIEW #1

Note: This drawing is an artistic interpretation of the general appearance of the design. It is not meant to be an exact rendition.		Designed: 9/10/2020 Printed: 9/10/2020	
DCR #7 Pathways- Annapolis KITCHEN -	All	Drawing #: 1	

CUSTOMER APPROVAL


I have reviewed these drawings and understand the details of the design and the Cartier Kitchens specifications

Signature _____

Date _____

DS
TS

DS
KS

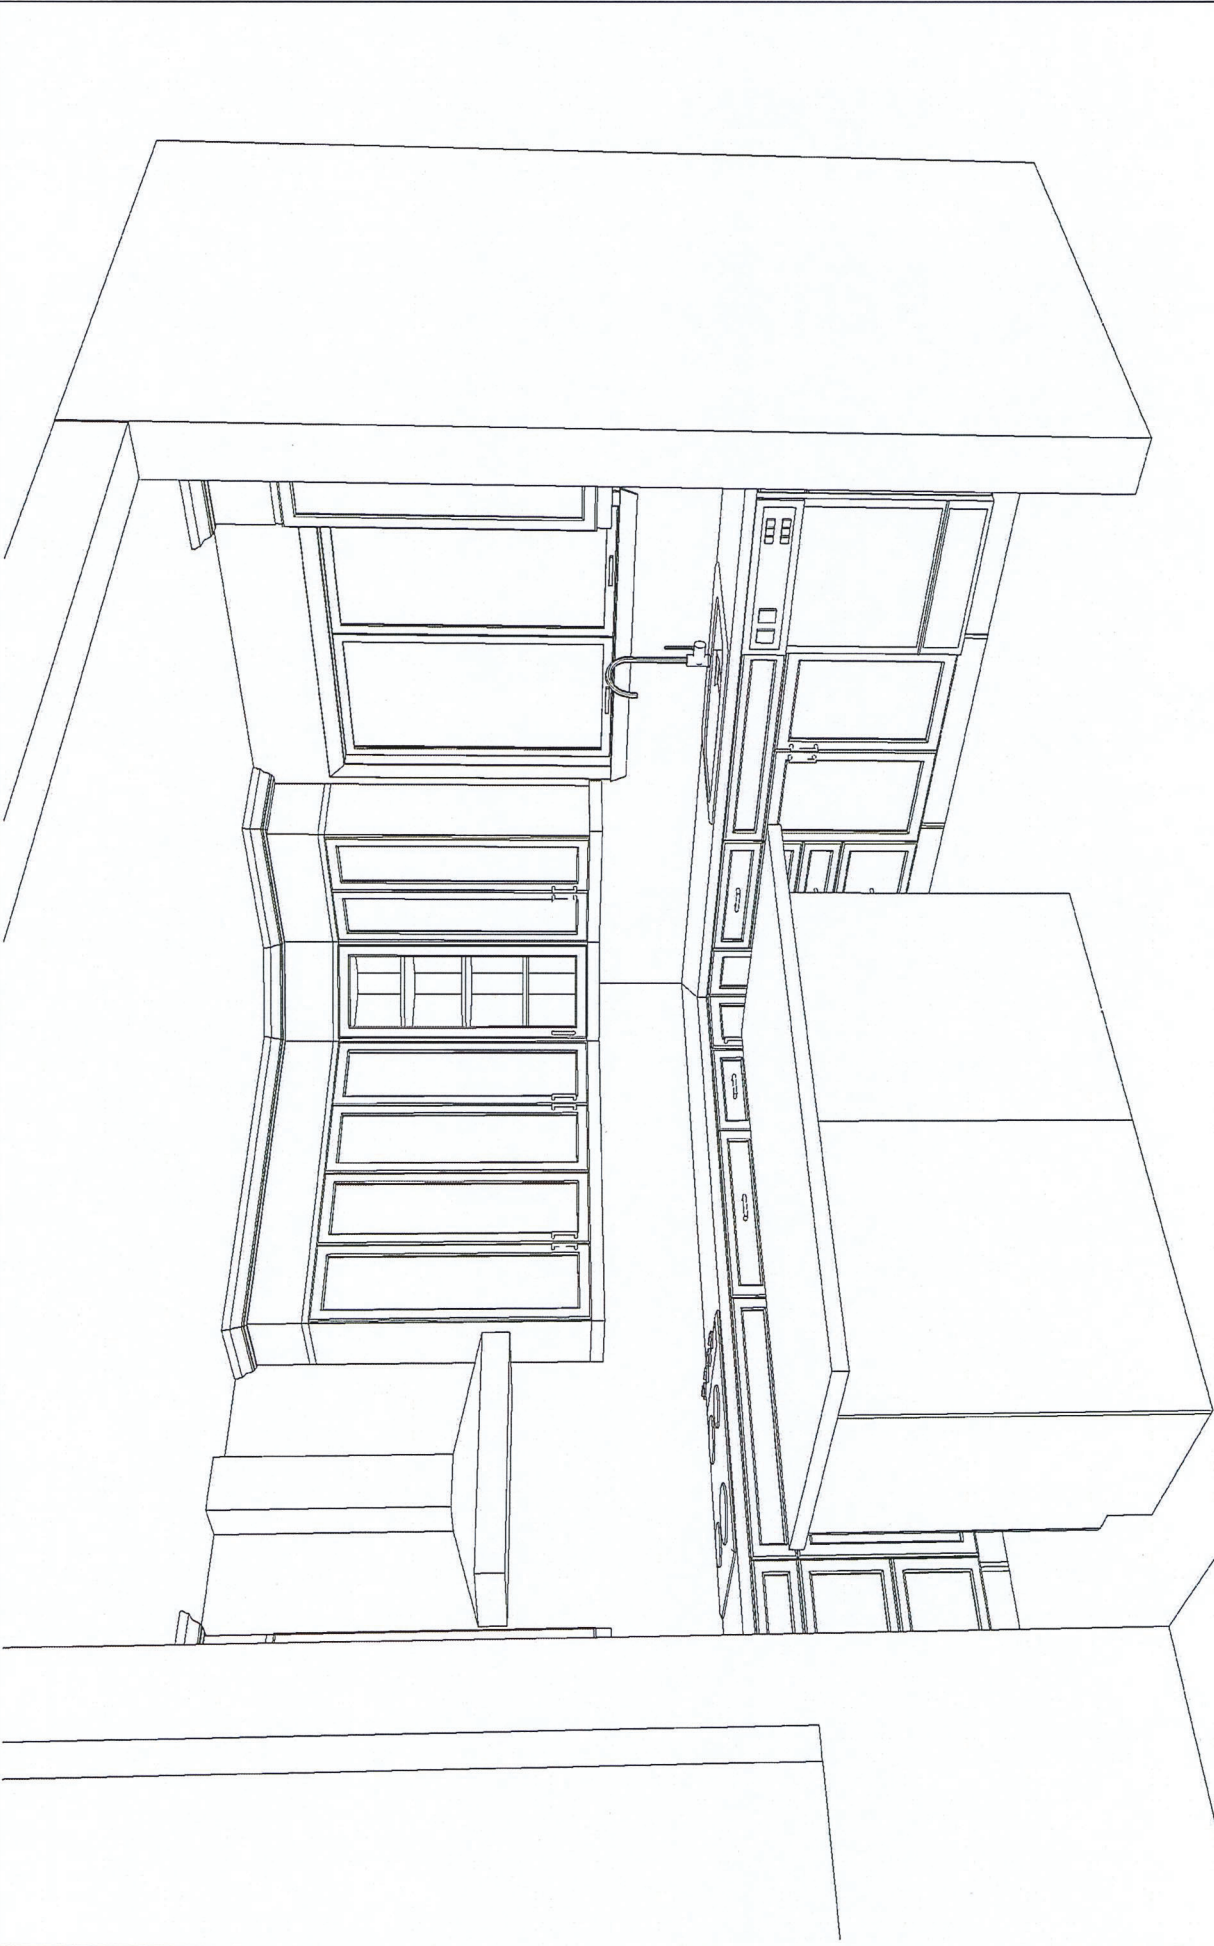

KITCHEN - 3D VIEW #2

Note: This drawing is an artistic interpretation of the general appearance of the design. It is not meant to be an exact rendition.		Designed: 9/10/2020 Printed: 9/10/2020
		DCR #7 Pathways- Annapolis KITCHEN - All Drawing #: 1

CUSTOMER APPROVAL


I have reviewed these drawings and understand the details of the design and the Cartier Kitchens specifications

Signature _____

Date _____

DS
TS

DS
RS

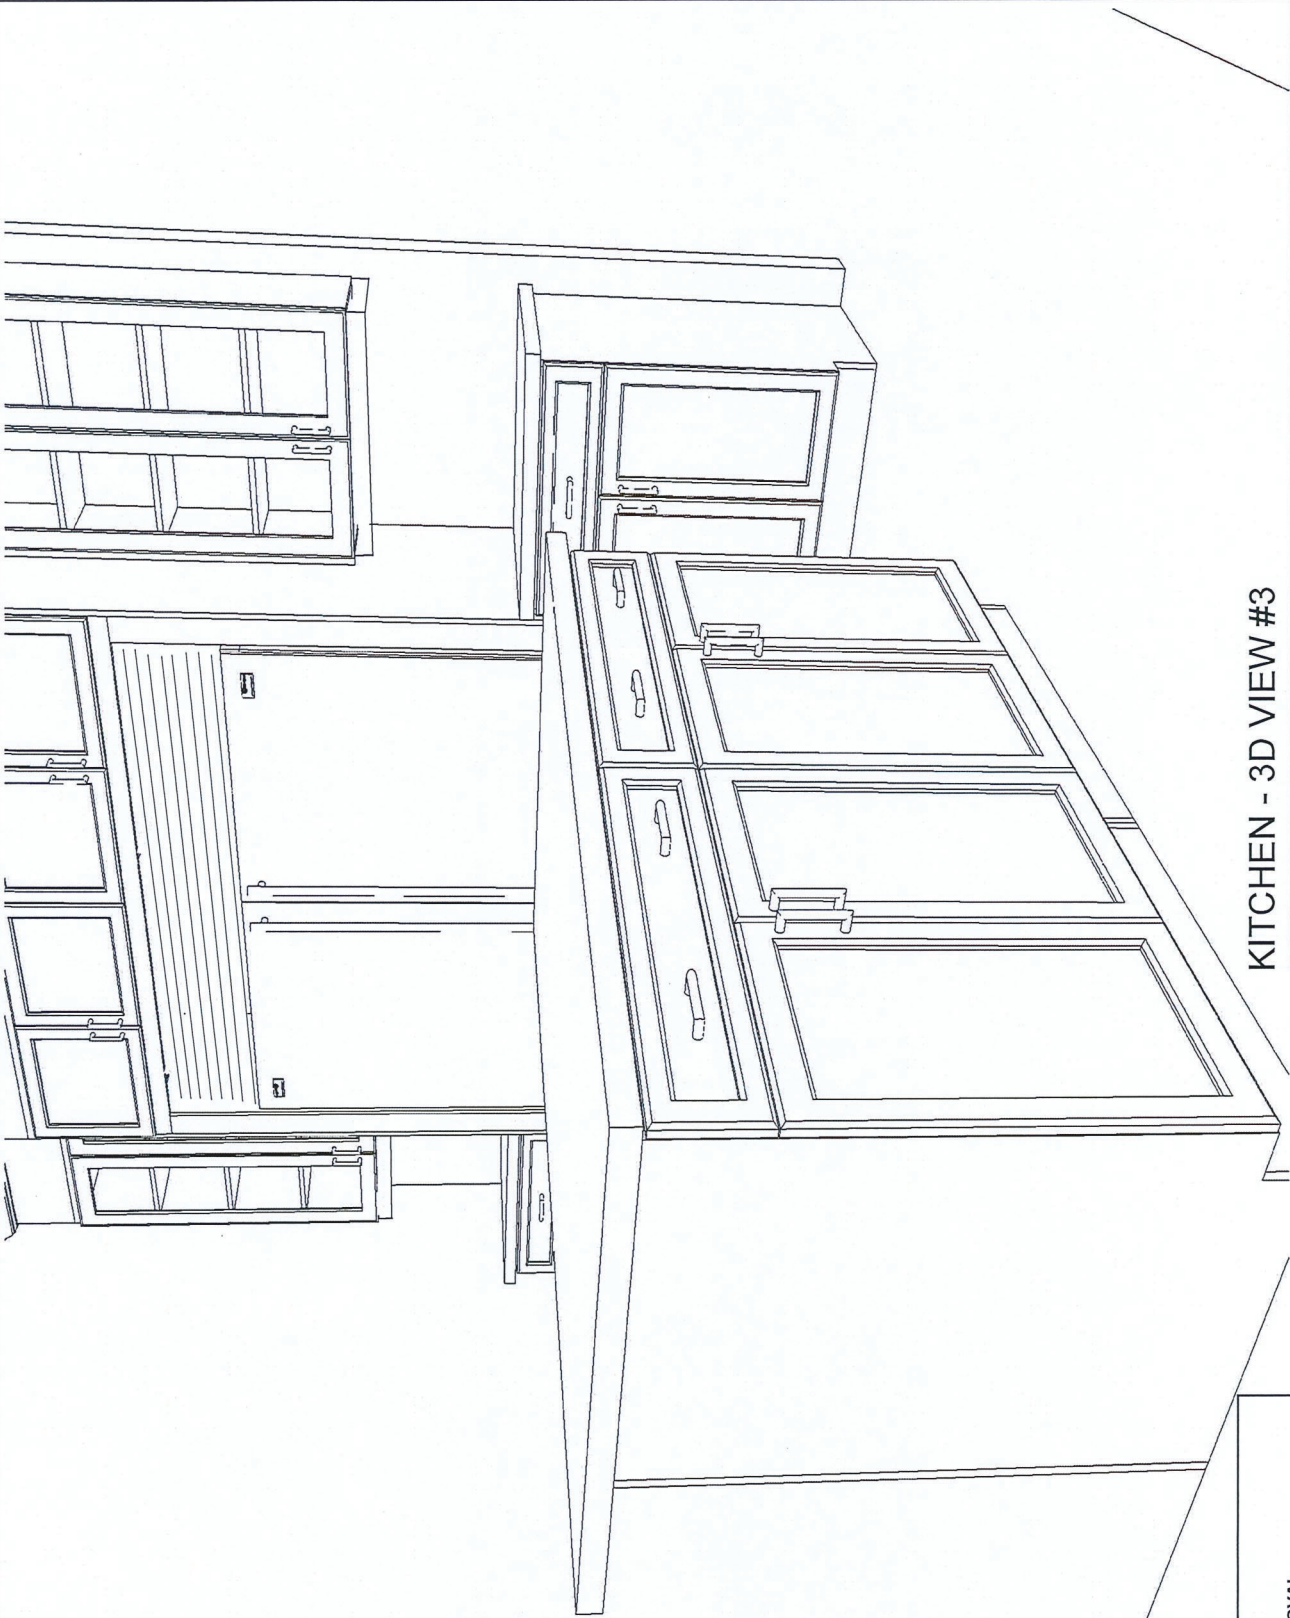

KITCHEN - 3D VIEW #3

	Designed: 9/10/2020 Printed: 9/10/2020	
	Drawing #: 1	
DCR #7 Pathways- Annapolis KITCHEN -		All

Note: This drawing is an artistic interpretation of the general appearance of the design. It is not meant to be an exact rendition.

CUSTOMER APPROVAL


I have reviewed these drawings and understand the details of the design and the Cartier Kitchens specifications

Signature _____

Date _____

DS
TS

DS
RS

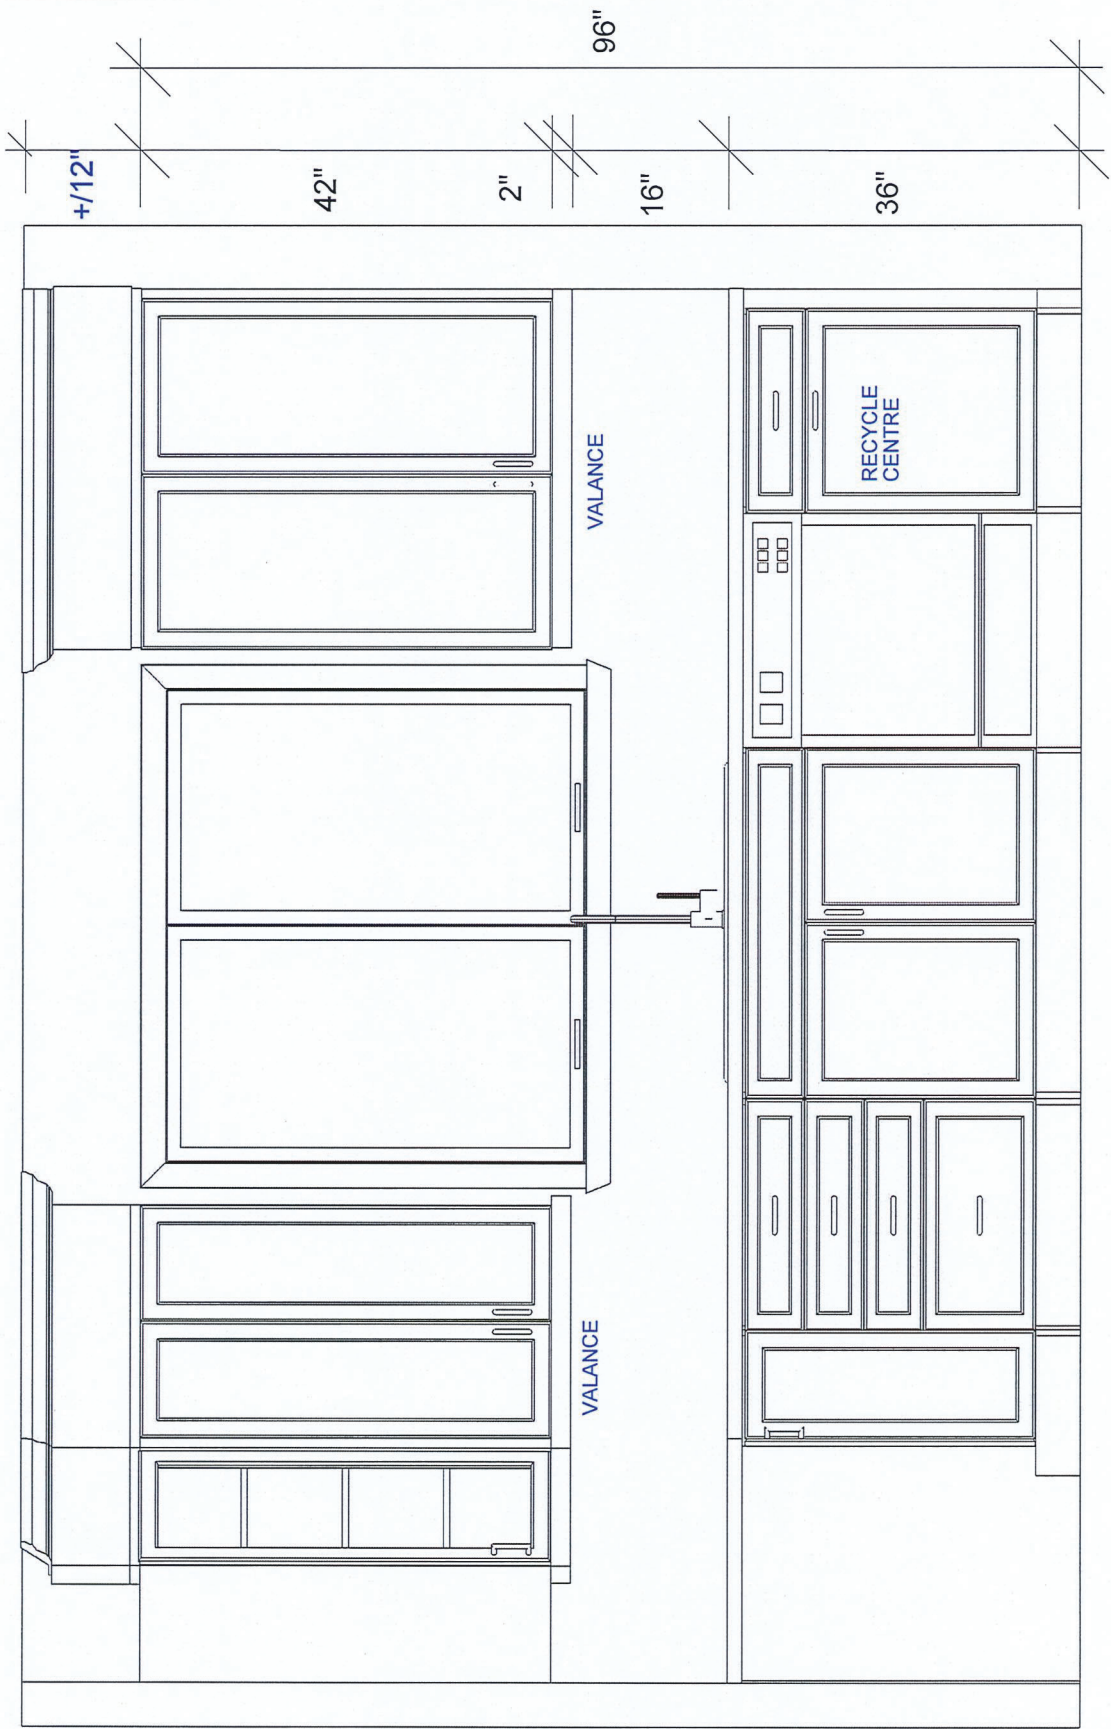

SINK WALL ELEVATION

CUSTOMER APPROVAL

I have reviewed these drawings and understand the details of the design and the Cartier Kitchens specifications

Signature _____

Date _____

Note: This drawing is an artistic interpretation of the general appearance of the design. It is not meant to be an exact rendition.




Designed: 9/10/2020
Printed: 9/10/2020

DCR #7 Pathways- Annapolis KITCHEN - _

All

Drawing #: 1



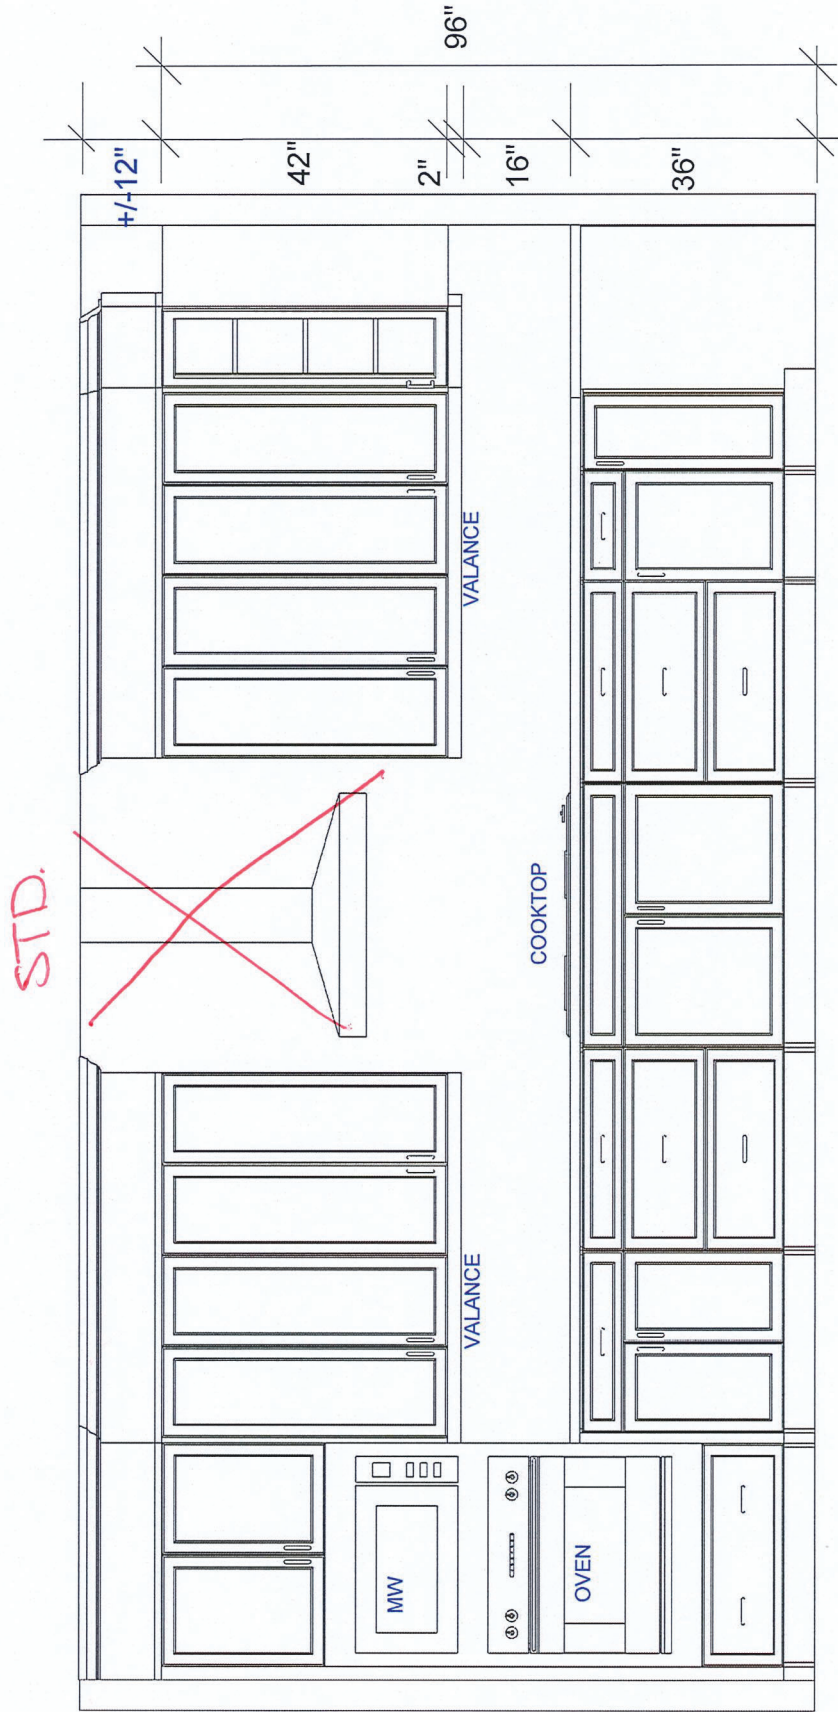

COOKTOP / WALL OVEN ELEVATION

CUSTOMER APPROVAL

I have reviewed these drawings and understand the details of the design and the Cartier Kitchens specifications

Signature _____
Date _____

Note: This drawing is an artistic interpretation of the general appearance of the design. It is not meant to be an exact rendition.




Designed: 9/10/2020
Printed: 9/10/2020

DCR #7 Pathways- Annapolis KITCHEN - _

All

Drawing #: 1



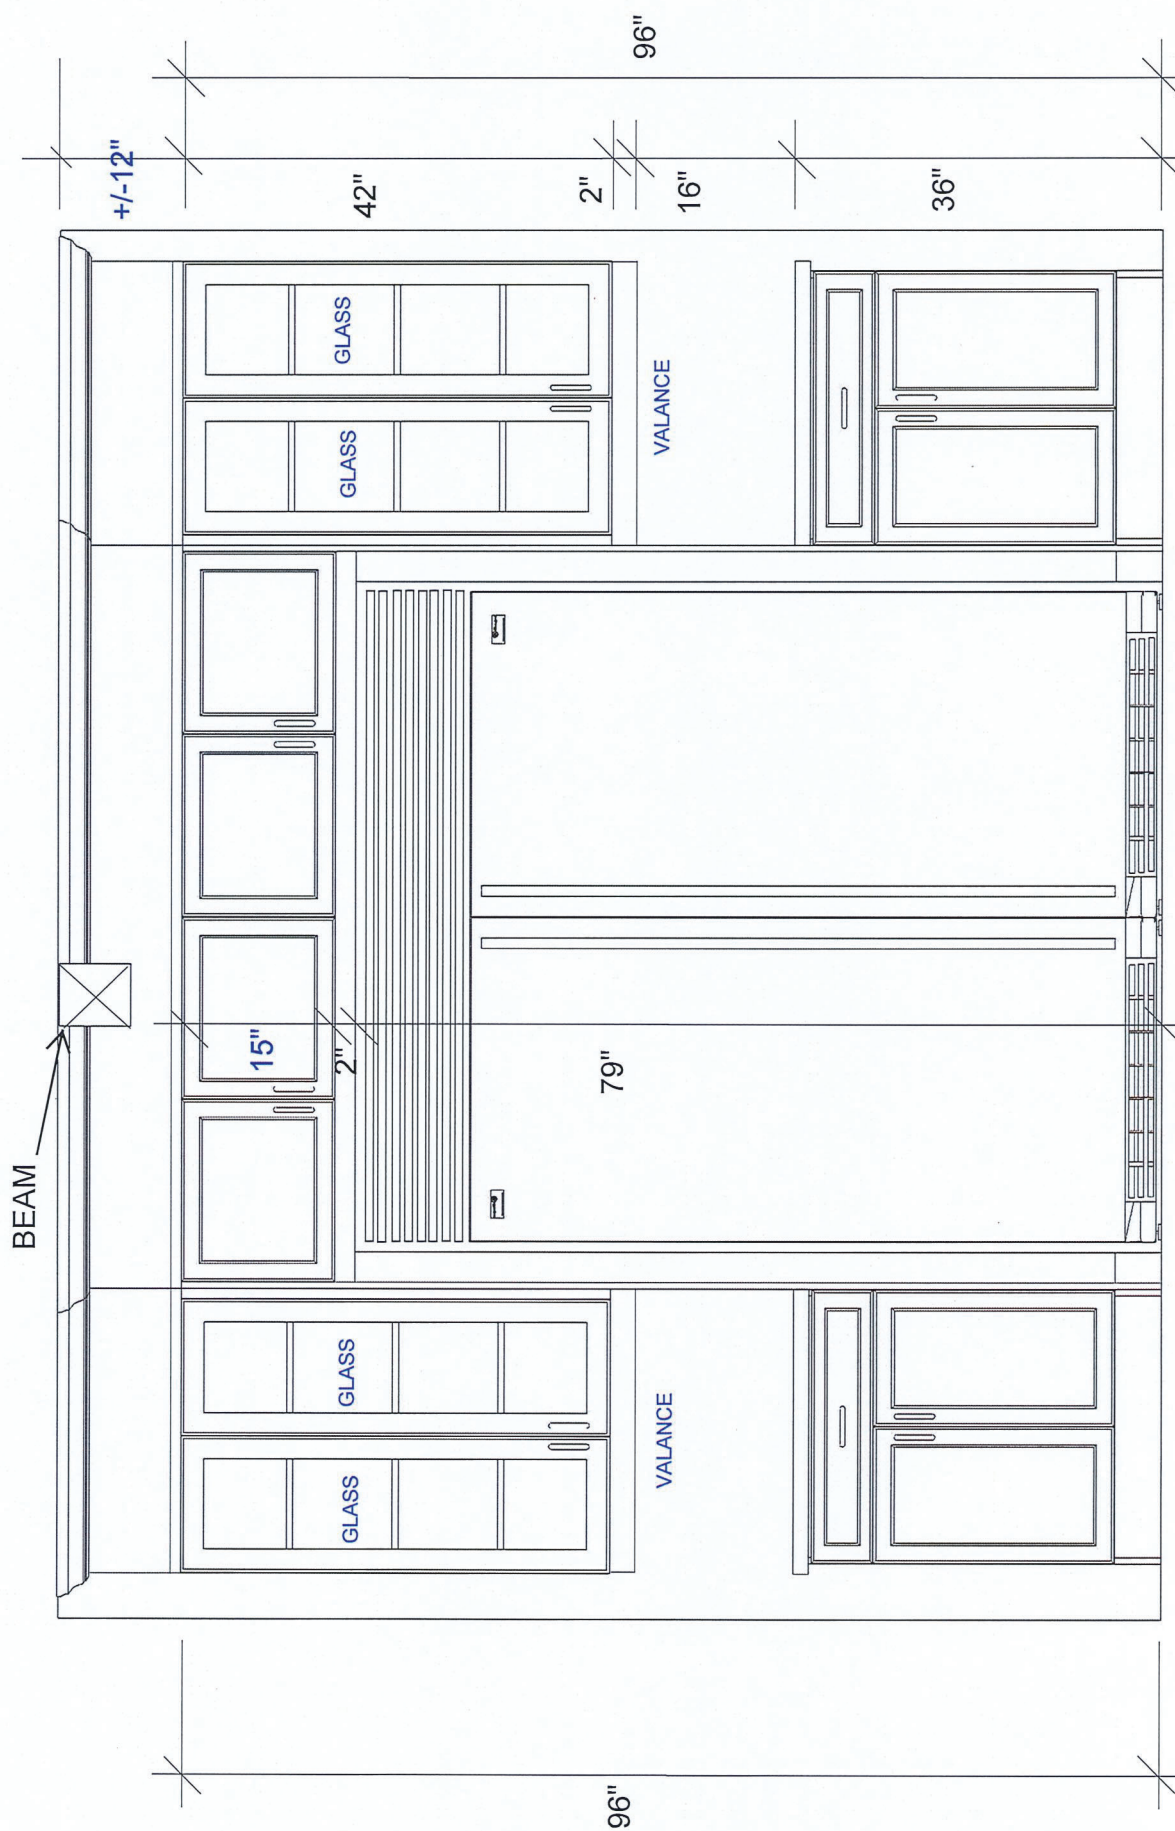

FRIDGE WALL ELEVATION

CUSTOMER APPROVAL

I have reviewed these drawings and understand the details of the design and the Cartier Kitchens specifications

Signature _____

Date _____

Designed: 9/10/2020
Printed: 9/10/2020



Note: This drawing is an artistic interpretation of the general appearance of the design. It is not meant to be an exact rendition.

DCR #7 Pathways- Annapolis KITCHEN -	All
--------------------------------------	-----

Drawing #: 1

DS
ts

DS
RS