



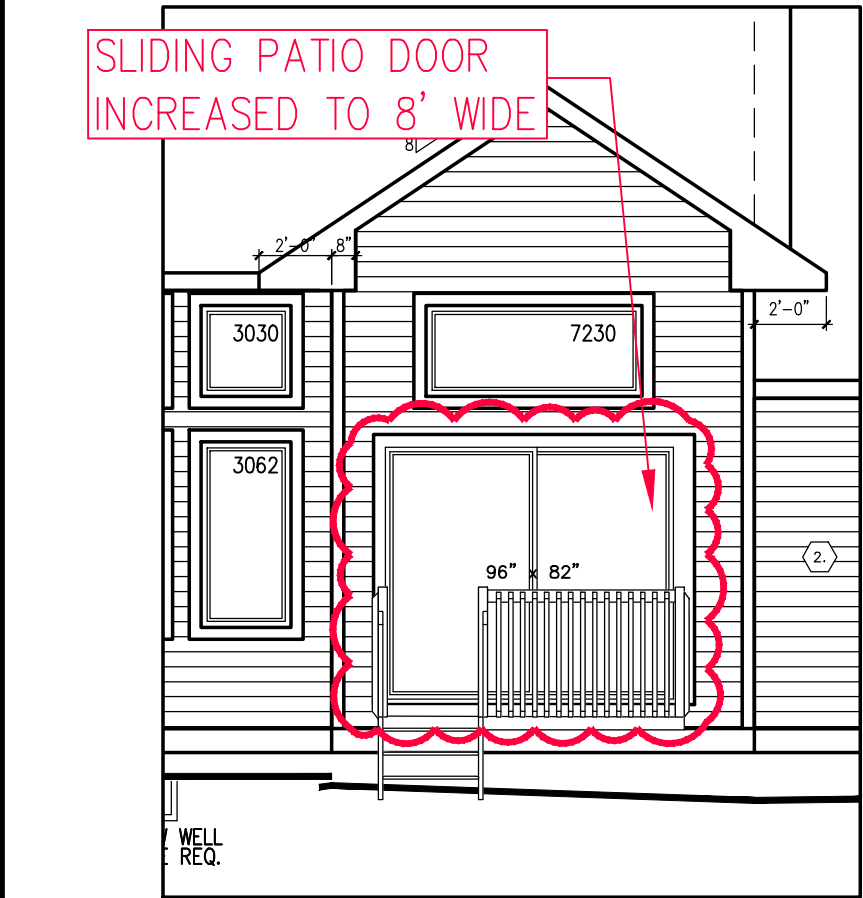

PARTIAL REAR ELEVATION

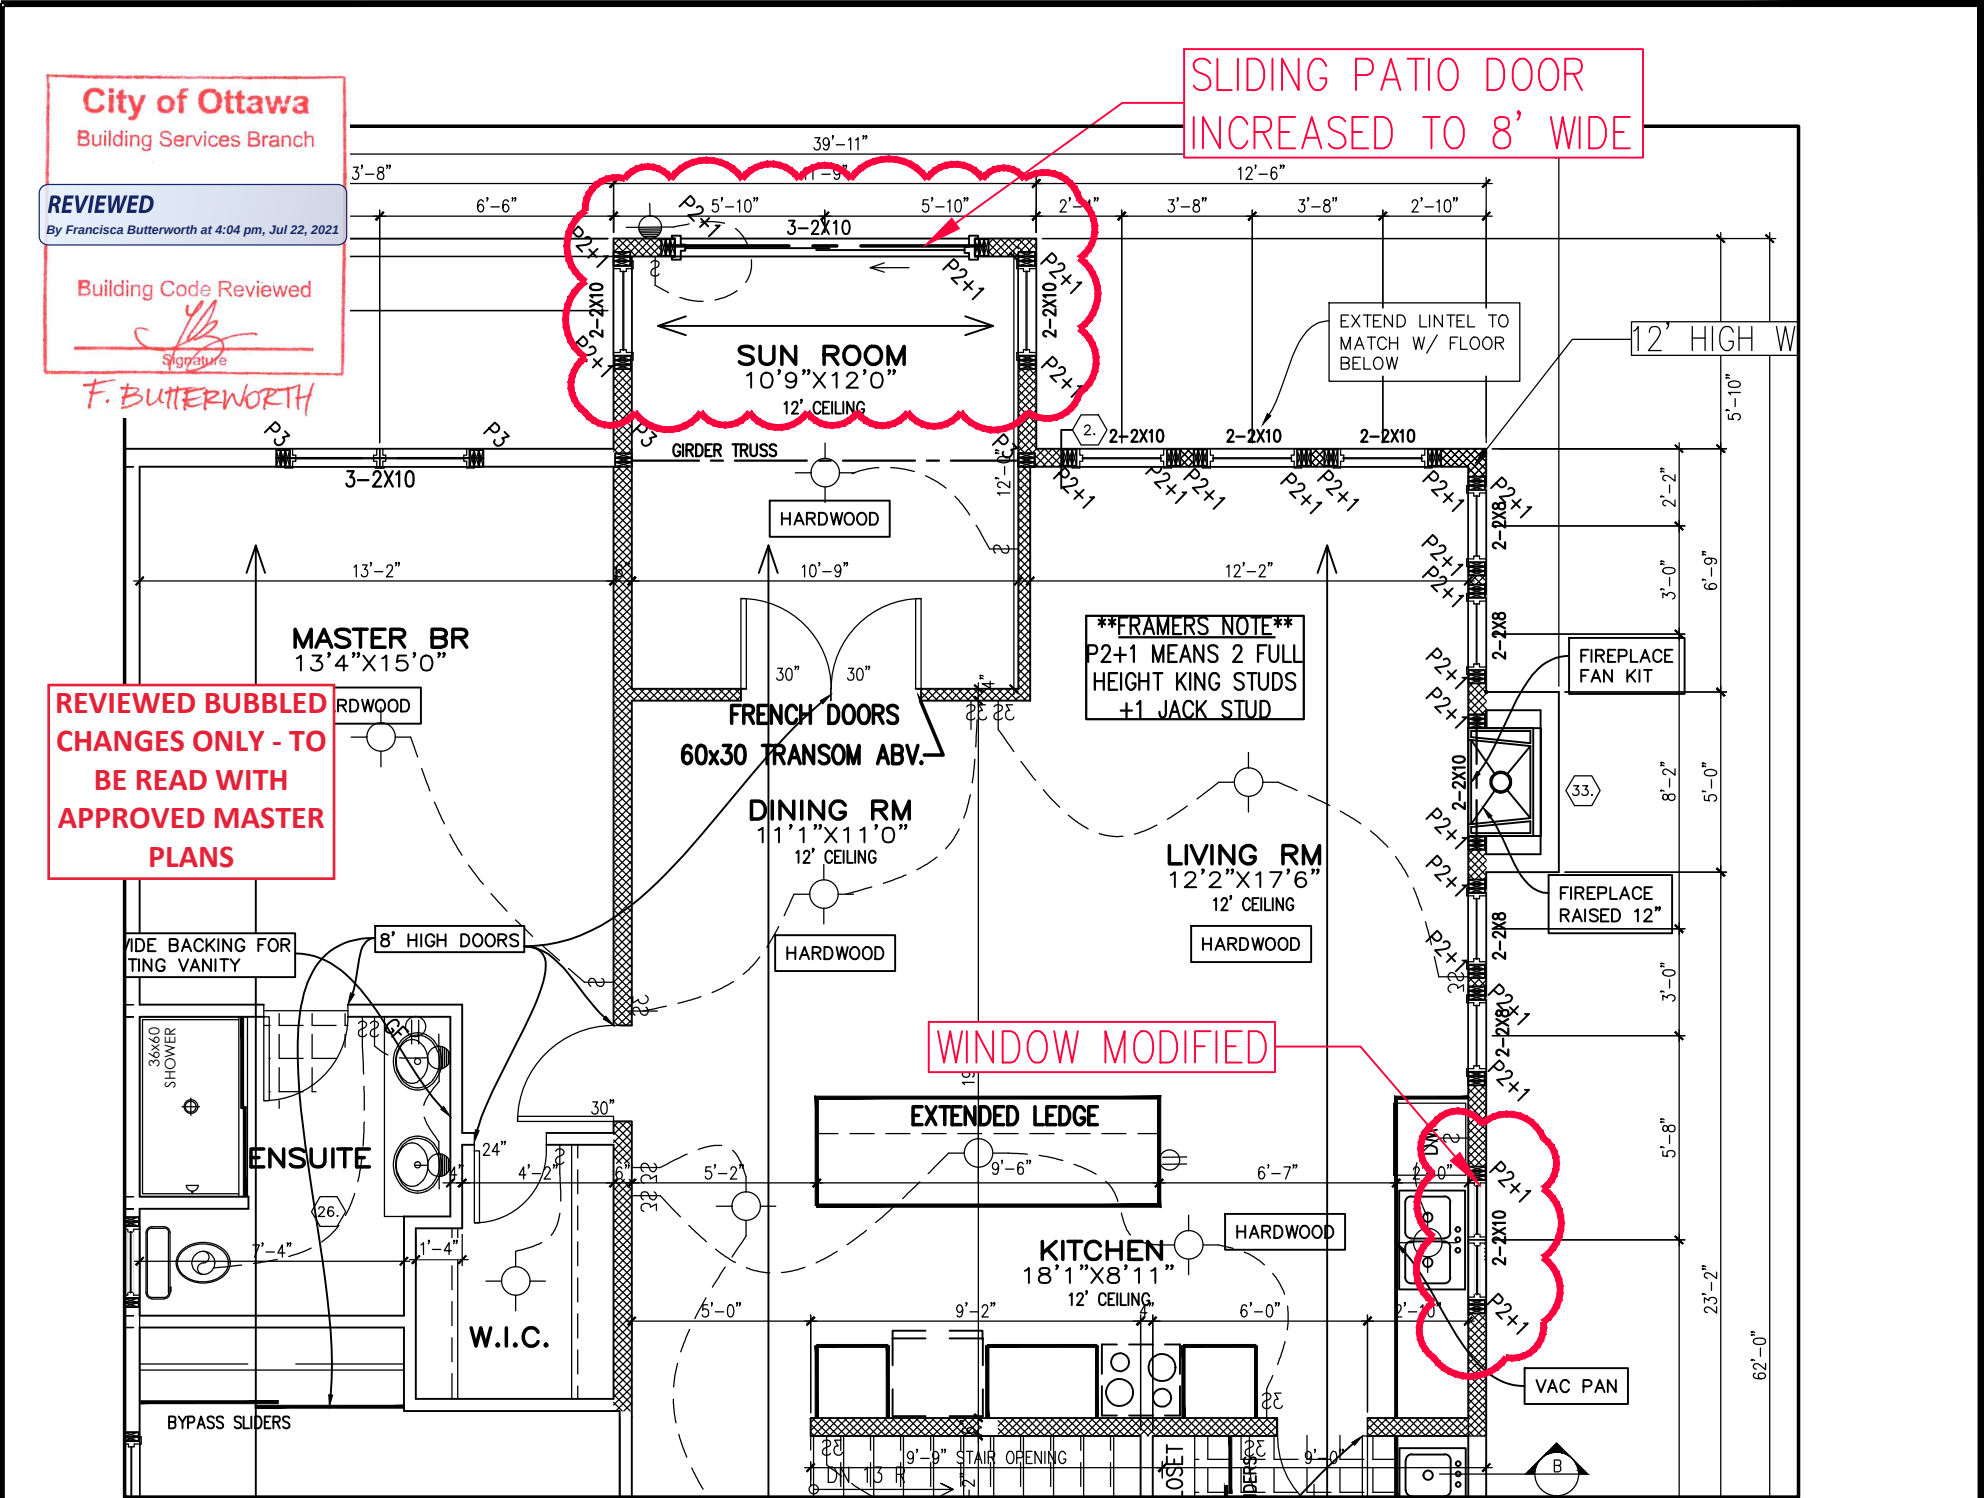

PARTIAL RIGHT SIDE ELEVATION

MODIFICATIONS FROM STANDARD SPRINGFIELD PLAN

PHOENIX HOMES

SPRINGFIELD – 2018

SITE: DIAMONDVIEW ESTATES

LOT NUMBER: 2-7

CIVIC ADDRESS: 1927 CESSNA PVT

5	BEP BLACKLINES	14/05/21	SP
4	STRUCTURAL REVIEW	22/02/18	SP
3	STRUCTURAL REVIEW	28/04/16	SP
2	STRUCTURAL RECONFIGURATION	29/03/16	SP
1	PRELIMINARY – FOR PRICING & LAYOUTS	29/02/16	SP
No.	Description	dd/mm/yy	By
REVISIONS			

footprint: B-24

drawn by: SD

date: SEP/12

scale: 3/16"=1'-0"

sheet no: D.C.L.-194