



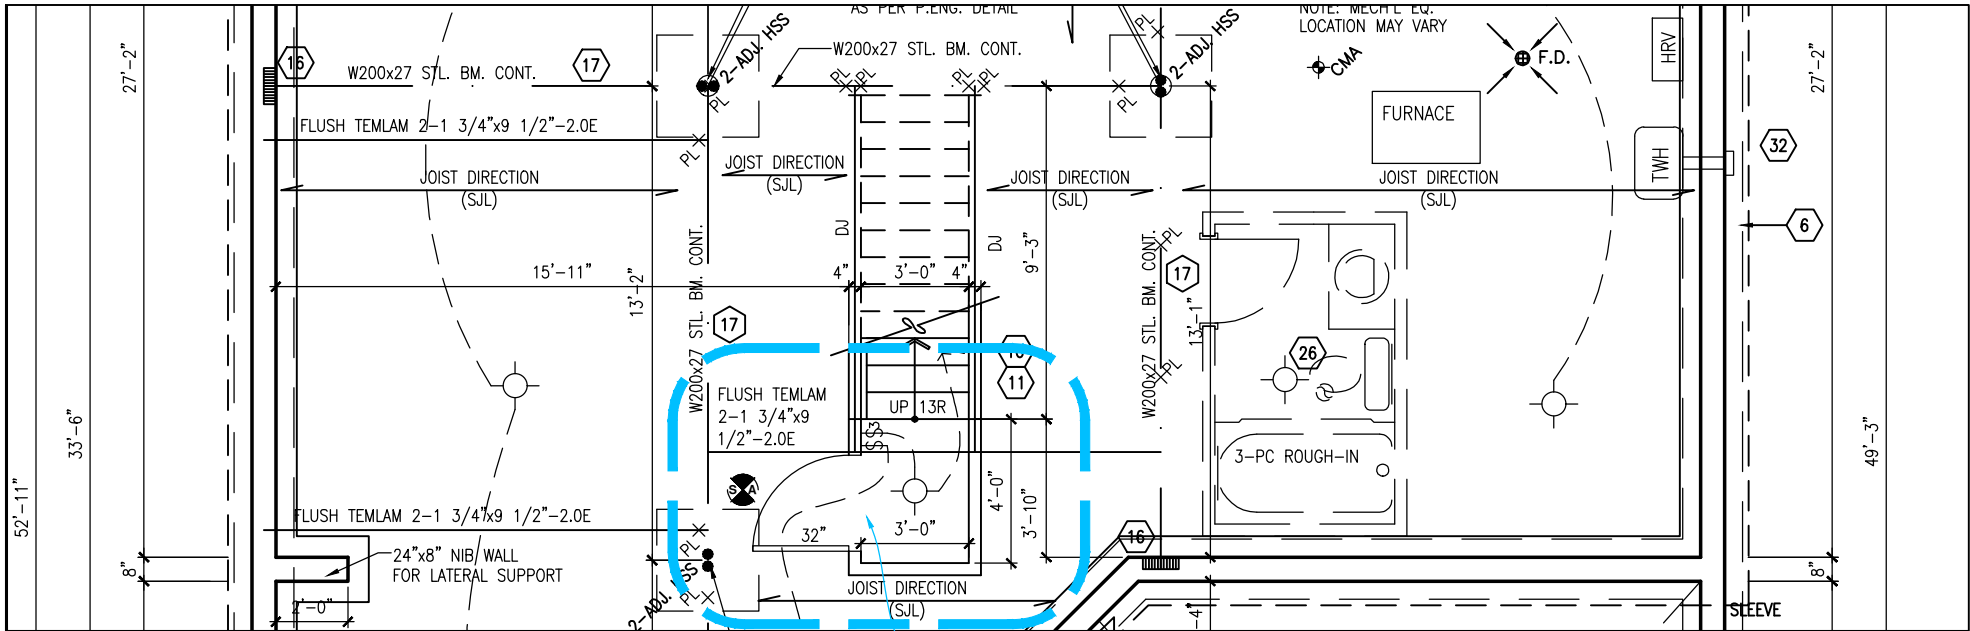

1 PARTIAL FOUNDATION PLAN
1 scale: 3/16"=1'-0"

-DOOR RELOCATED TO
BOTTOM OF BASEMENT STAIRS
-FINISHED LANDING ADDED

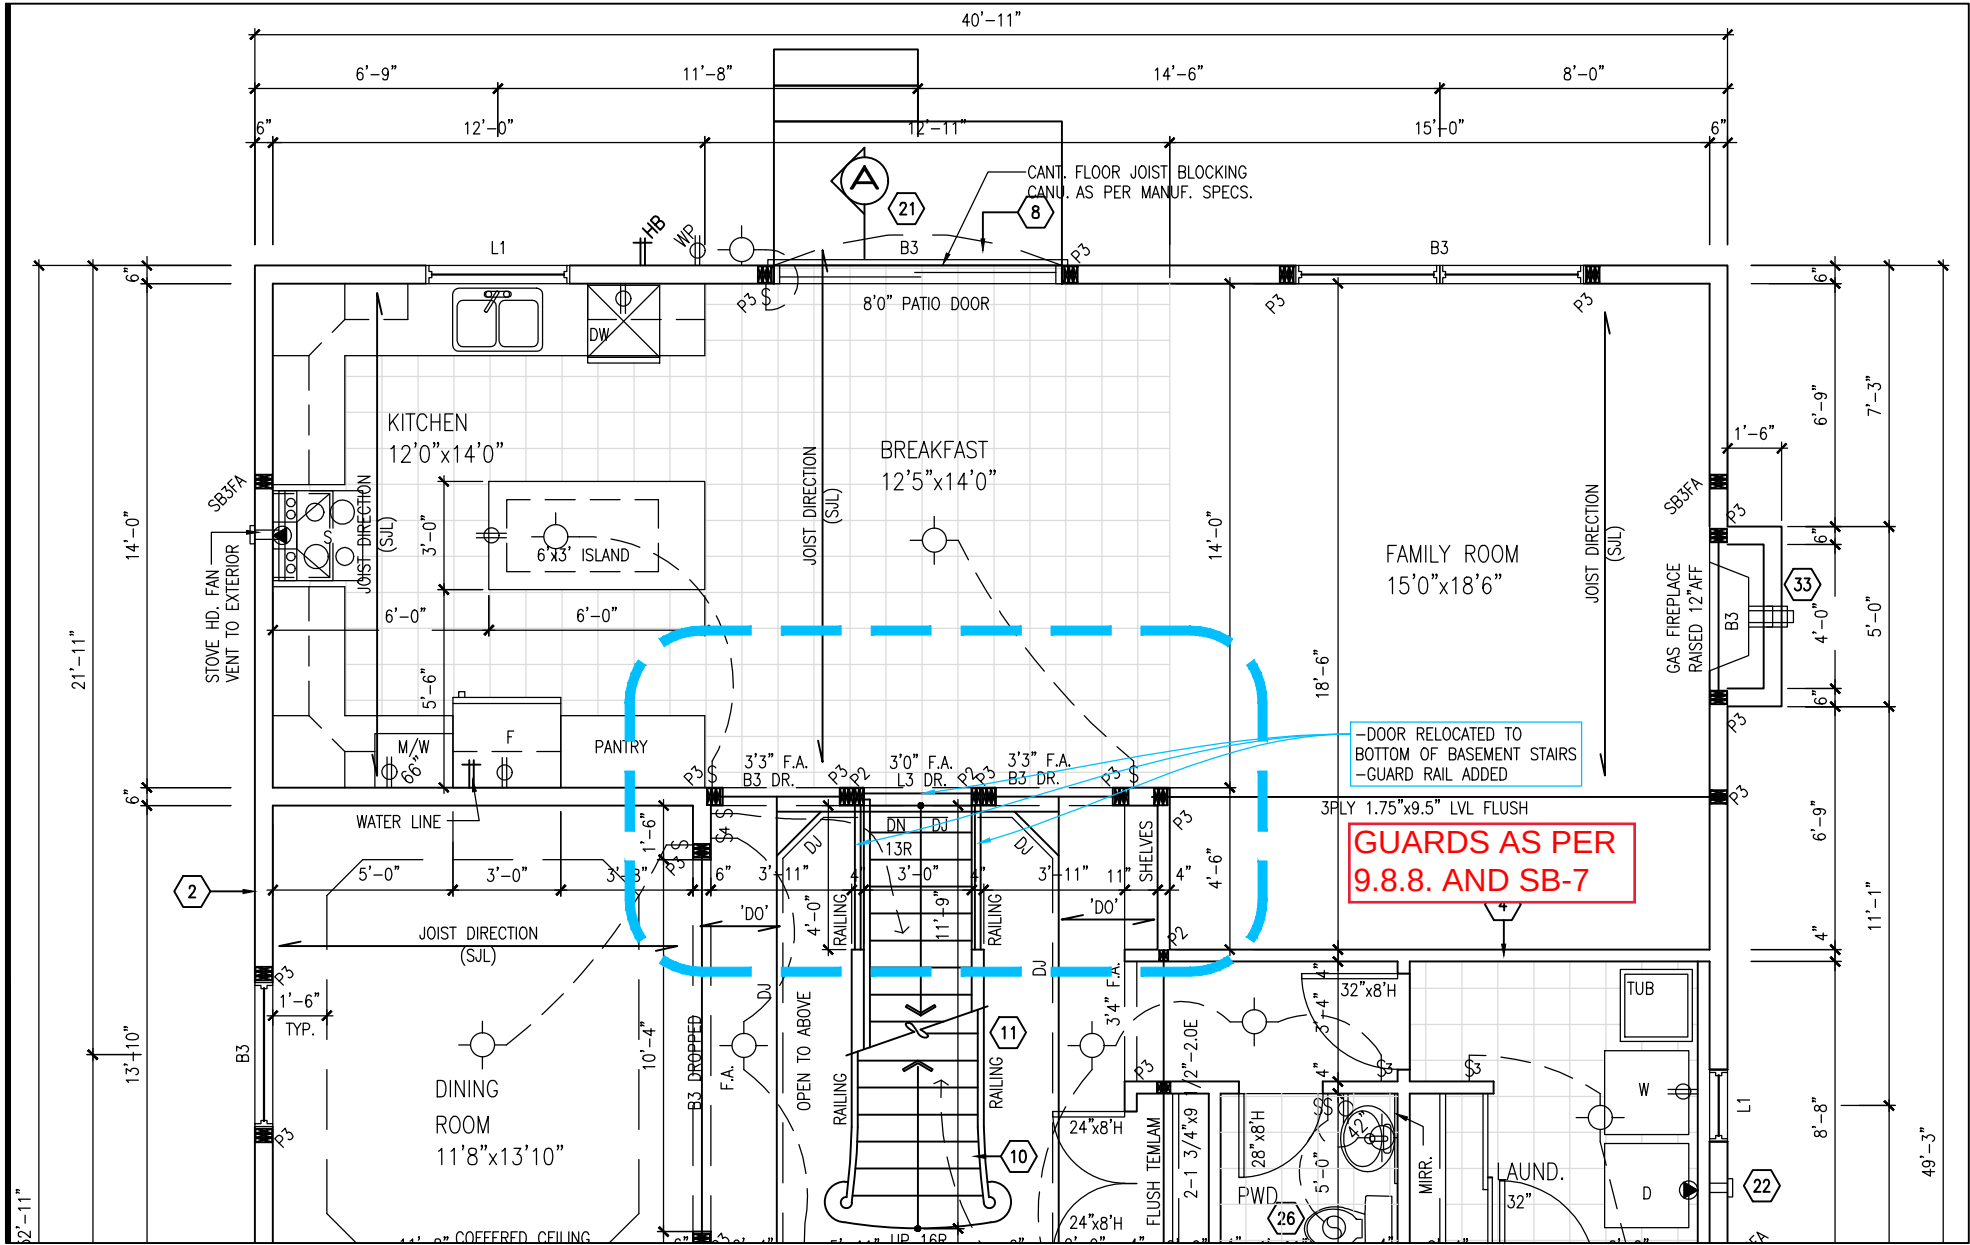

2 PARTIAL GROUND FLOOR PLAN
1 scale: 3/16"=1'-0"

-DOOR RELOCATED TO
BOTTOM OF BASEMENT STAIRS
-GUARD RAIL ADDED
**GUARDS AS PER
9.8.8. AND SB-7**

REVIEWED FOR MARKED CHANGE ONLY

TO BE READ IN CONJUNCTION WITH MASTER FOOTPRINTED PLANS

City of Ottawa
Building Services Branch

REVIEWED
By Nicholas Winn at 10:37 am, Jul 21, 2021

Building Code Reviewed
Signature

PHOENIX HOMES

PLATINA-2007

SITE:DIAMONDVIEW ESTATES

LOT NUMBER: 2-40

CIVIC ADDRESS:
1958 CESSNA PRIVATE

No.	Description	dd/mm/yy	By
2	XX	XX/XX/XX	CB
1	DEVELOPED BASEMENT STAIRS	07/06/21	CB
REVISIONS			

footprint: 512

drawn by: 1V

date: JULY 2007

scale: 3/16"=1'-0"

sheet no: 1