

DCR PHOENIX HOMES

LOT #168

PATHWAYS

STRATHMORE (35-10)

KITCHEN / VANITIES

MOUNTING HEIGHT - 96

42" H. UPPERS @ 18" ABOVE COUNTER

CROWN MOULDING

CABINETS -

HARDWARE -

STANDARD WHITE INTERIOR

STANDARD METAL DRAWERS

STANDARD HINGES

4 PCS - 5/8" KICK - FIN. BOTH ENDS



1 PCS - 90 DEG. CORNER MOULD

1 PCS - T-MOULD


4 PCS - FLAT MOULD

REVISED: MARCH 26-21


STANDARD HOODFAN + UPPER  
(NO SPACE BESIDE)

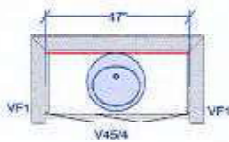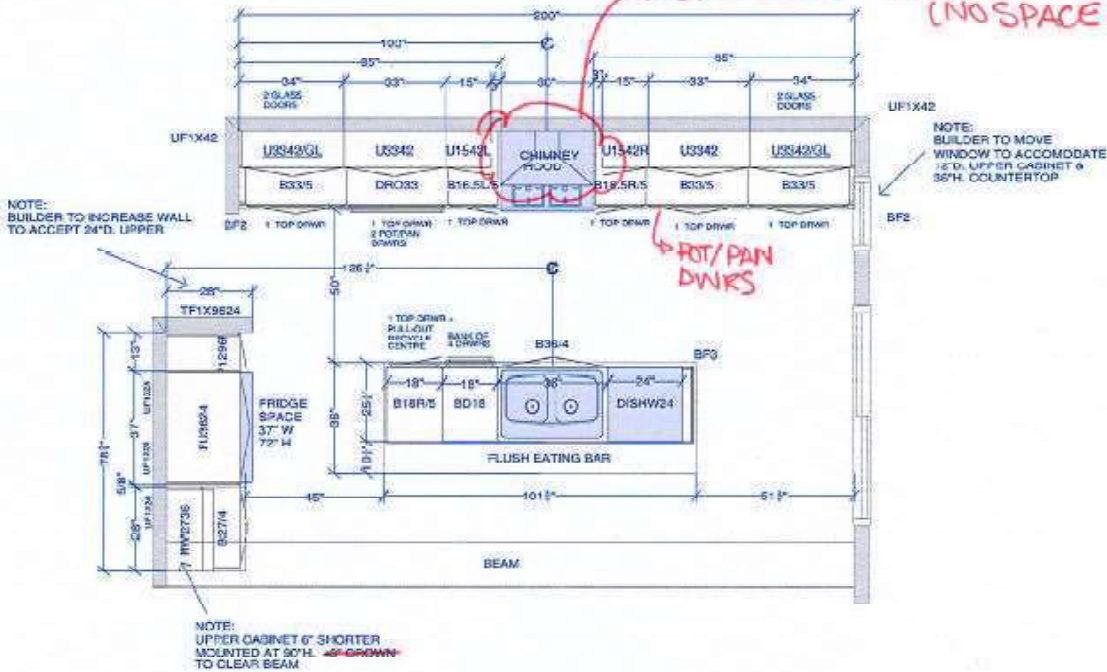

POWDER ROOM

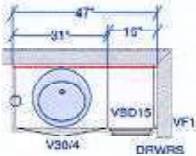

MAIN BATH

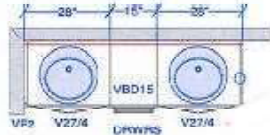

ENSUITE

CUSTOMER APPROVAL

I have reviewed these drawings and understand the details of the design and the OFFER (170264) specifications.

Signature: \_\_\_\_\_

Date: \_\_\_\_\_

All dimensions / size designations given are subject to verification on job site and adjustment to fit job conditions.

SPECTRUM KITCHEN and BATH DESIGN



This is an original design and must not be released or copied unless applicable fee has been paid or job order placed.

DRAWN BY: LORI DISAVERIO, B.I.D

Designed: 2021-03-26  
Printed: 2021-03-26

DS  
[Signature]

DCR #168 PWYS - REVISED (Strathmore).kit

All

Drawing #: 1 | No Scale.



KITCHEN - 3D VIEW #1

\* NO CROWN

REVISED: MARCH 26-21

& STANDARD HOODTAN & CABINET

CUSTOMER APPROVAL

I have reviewed these drawings and understand the details of the design and the CARTIER KITCHENS specifications.

Signature \_\_\_\_\_

Date \_\_\_\_\_

Note: This drawing is an artistic interpretation of the general appearance of the design. It is not meant to be an exact rendition.



SPECTRUM KITCHEN and BATH  
DESIGN

DCR #168 PWYS - REVISED (Strathmore).kit

All

Drawing #: 1

Designed: 2021-03-26  
Printed: 2021-03-26

DS



KITCHEN - 3D VIEW #2  
REVISED: MARCH 26-21

CUSTOMER APPROVAL

I have reviewed these drawings and understand the details of this design and the CARTIER KITCHENS specifications.

Signature \_\_\_\_\_

Date \_\_\_\_\_

Note: This drawing is an artistic interpretation of the general appearance of the design. It is not meant to be an exact rendition.

SPECTRUM KITCHEN and BATH DESIGN

DCR #168 PWYS - REVISED (Straffmore).kit

All

DS

Designed: 2021-03-26  
Printed: 2021-03-26

Drawing #: 1



KITCHEN - 3D VIEW #3  
REVISED: MARCH 26-21

CUSTOMER APPROVAL

I have reviewed these drawings and understand the details of the design and the CARTER KITCHENS' specifications.

Signature \_\_\_\_\_

Date \_\_\_\_\_

Note: This drawing is an artistic interpretation of the general appearance of the design. It is not meant to be an exact rendition.




SPECTRUM KITCHEN and BATH DESIGN  
DCR #168 PWYS - REVISED (Strathmore).kit

Designed: 2021-03-26  
Printed: 2021-03-26

  
DS

Drawing #: 1

All

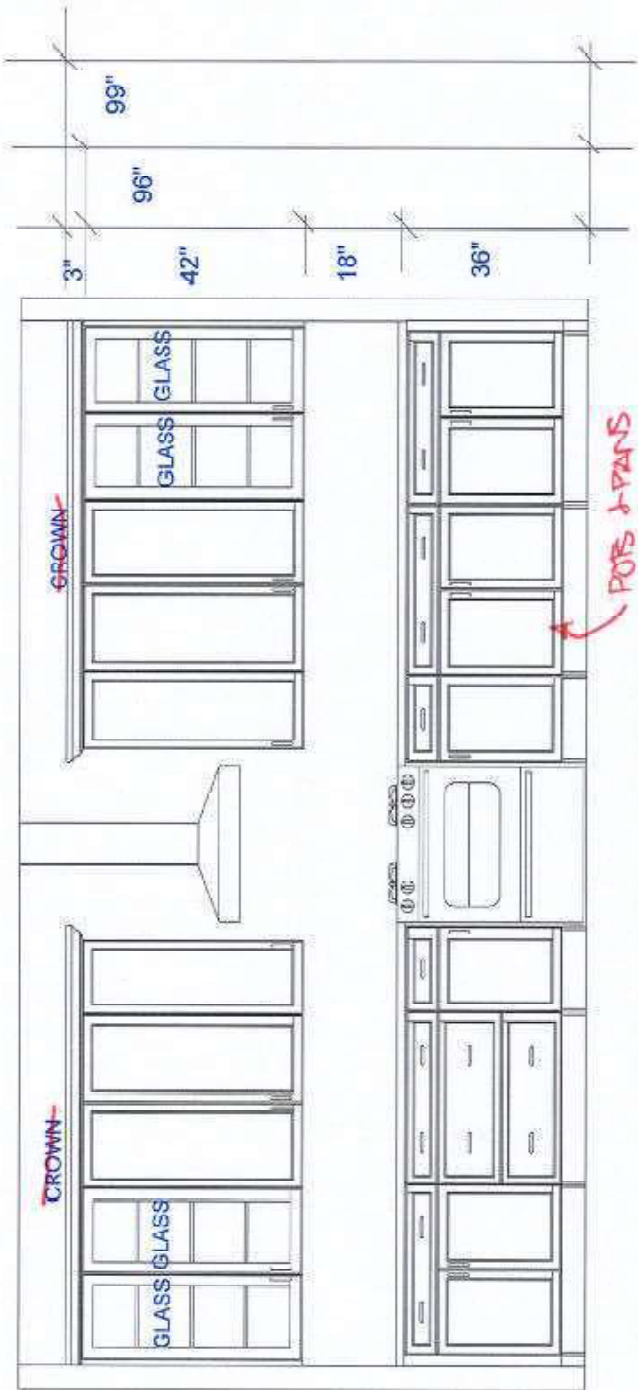

RANGE WALL ELEVATION

REVISED: MARCH 26-21

CUSTOMER APPROVAL

I have reviewed these drawings and understand the details of the design and the CARTIER KITCHENS specifications.

Signature

Date

Note: This drawing is an artistic interpretation of the general appearance of the design. It is not meant to be an exact rendition.

SPECTRUM KITCHEN and BATH DESIGN

DCR #168 PWYS - REVISED (Strathmore).kit


All

Drawing #: 1



Designed: 2021-03-26  
Printed: 2021-03-26

DS

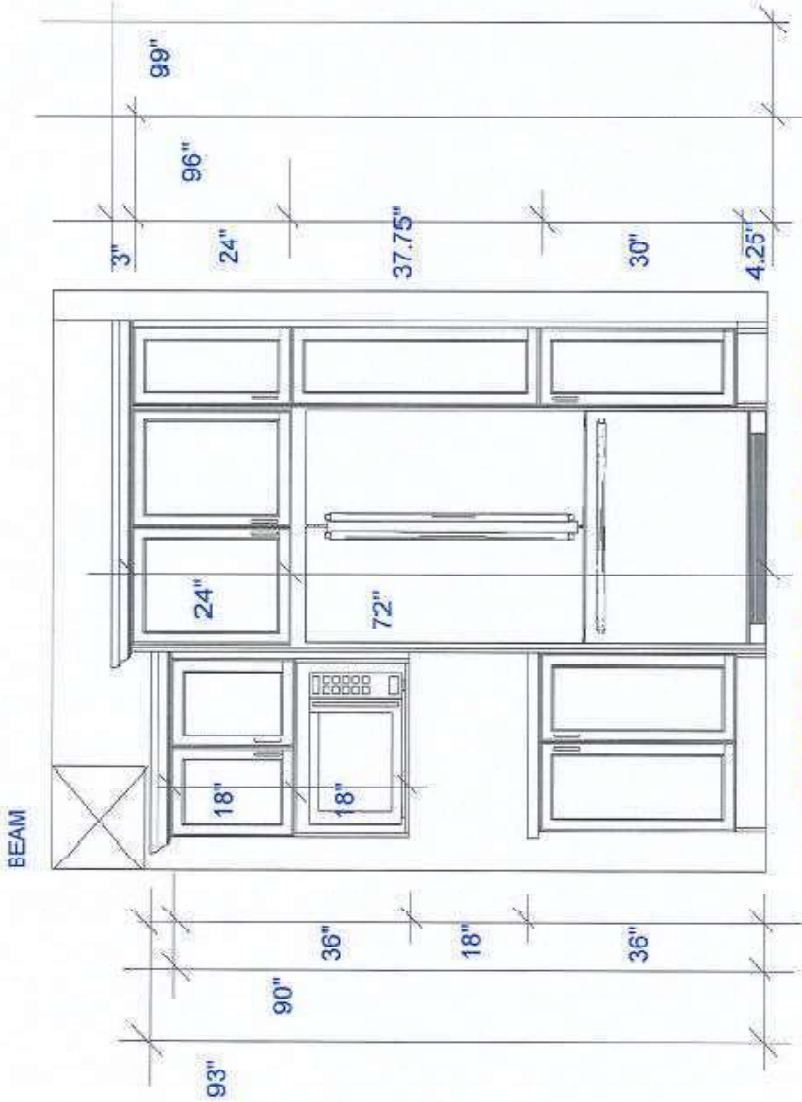

FRIDGE WALL ELEVATION

REVISED: MARCH 26 - 21

CUSTOMER APPROVAL

I have reviewed these drawings and understand the details of the design and the CARTIER KITCHENS specifications.

Signature

Date

Note: This drawing is an artistic interpretation of the general appearance of the design. It is not meant to be an exact rendition.

SPECTRUM KITCHEN and BATH DESIGN

DCR #168 PWYS - REVISED (Stratmore).kit






All

Designed: 2021-03-26  
Printed: 2021-03-26

DS

Drawing #: 1
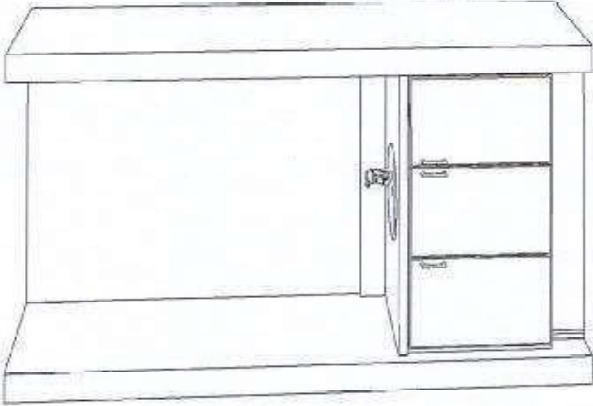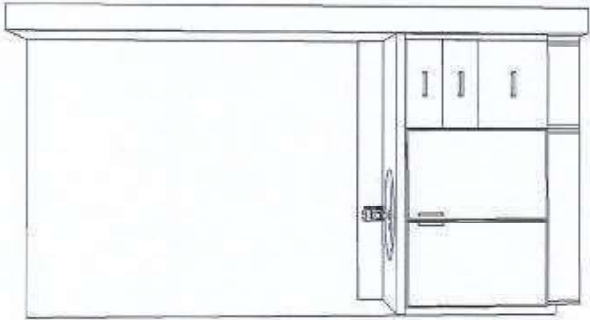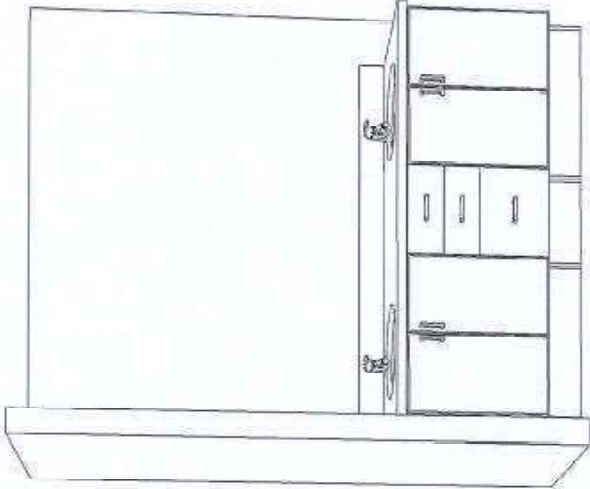
|                                                                                                                                                                                                      |                                                                                     |                                                                                                                                                                                                                                          |                                                                                                                                                                                                                                               |
|------------------------------------------------------------------------------------------------------------------------------------------------------------------------------------------------------|-------------------------------------------------------------------------------------|------------------------------------------------------------------------------------------------------------------------------------------------------------------------------------------------------------------------------------------|-----------------------------------------------------------------------------------------------------------------------------------------------------------------------------------------------------------------------------------------------|
|                                                                                                                   |  |                                                                                                                                                        | <p>POWDER ROOM</p> <p>MAIN BATH</p> <p>ENSUITE</p>                                                                                                                                                                                            |
| <div><p><b>CUSTOMER APPROVAL</b></p><p>I have reviewed these drawings and understand the details of the design and the Contractor's specifications.</p><p>Signature _____</p><p>Date _____</p></div> |                                                                                     | <div><p>Note: This drawing is an artistic interpretation of the general appearance of the design. It is not meant to be an exact rendition.</p></div> | <div><p>Designed: 1/15/2021<br/>Printed: 1/15/2021</p><div><br/>DS</div></div> <div><p>DCR #158 PWYS - (Strathmore)</p><p>All</p><p>Drawing #: 1</p></div> |