


****NOTE****
ALL WINDOW LINTELS TO BE 2-2X10 W/ P2 POSTS ON EACH SIDE
U.N.O.



NEW WINDOW
ADDED

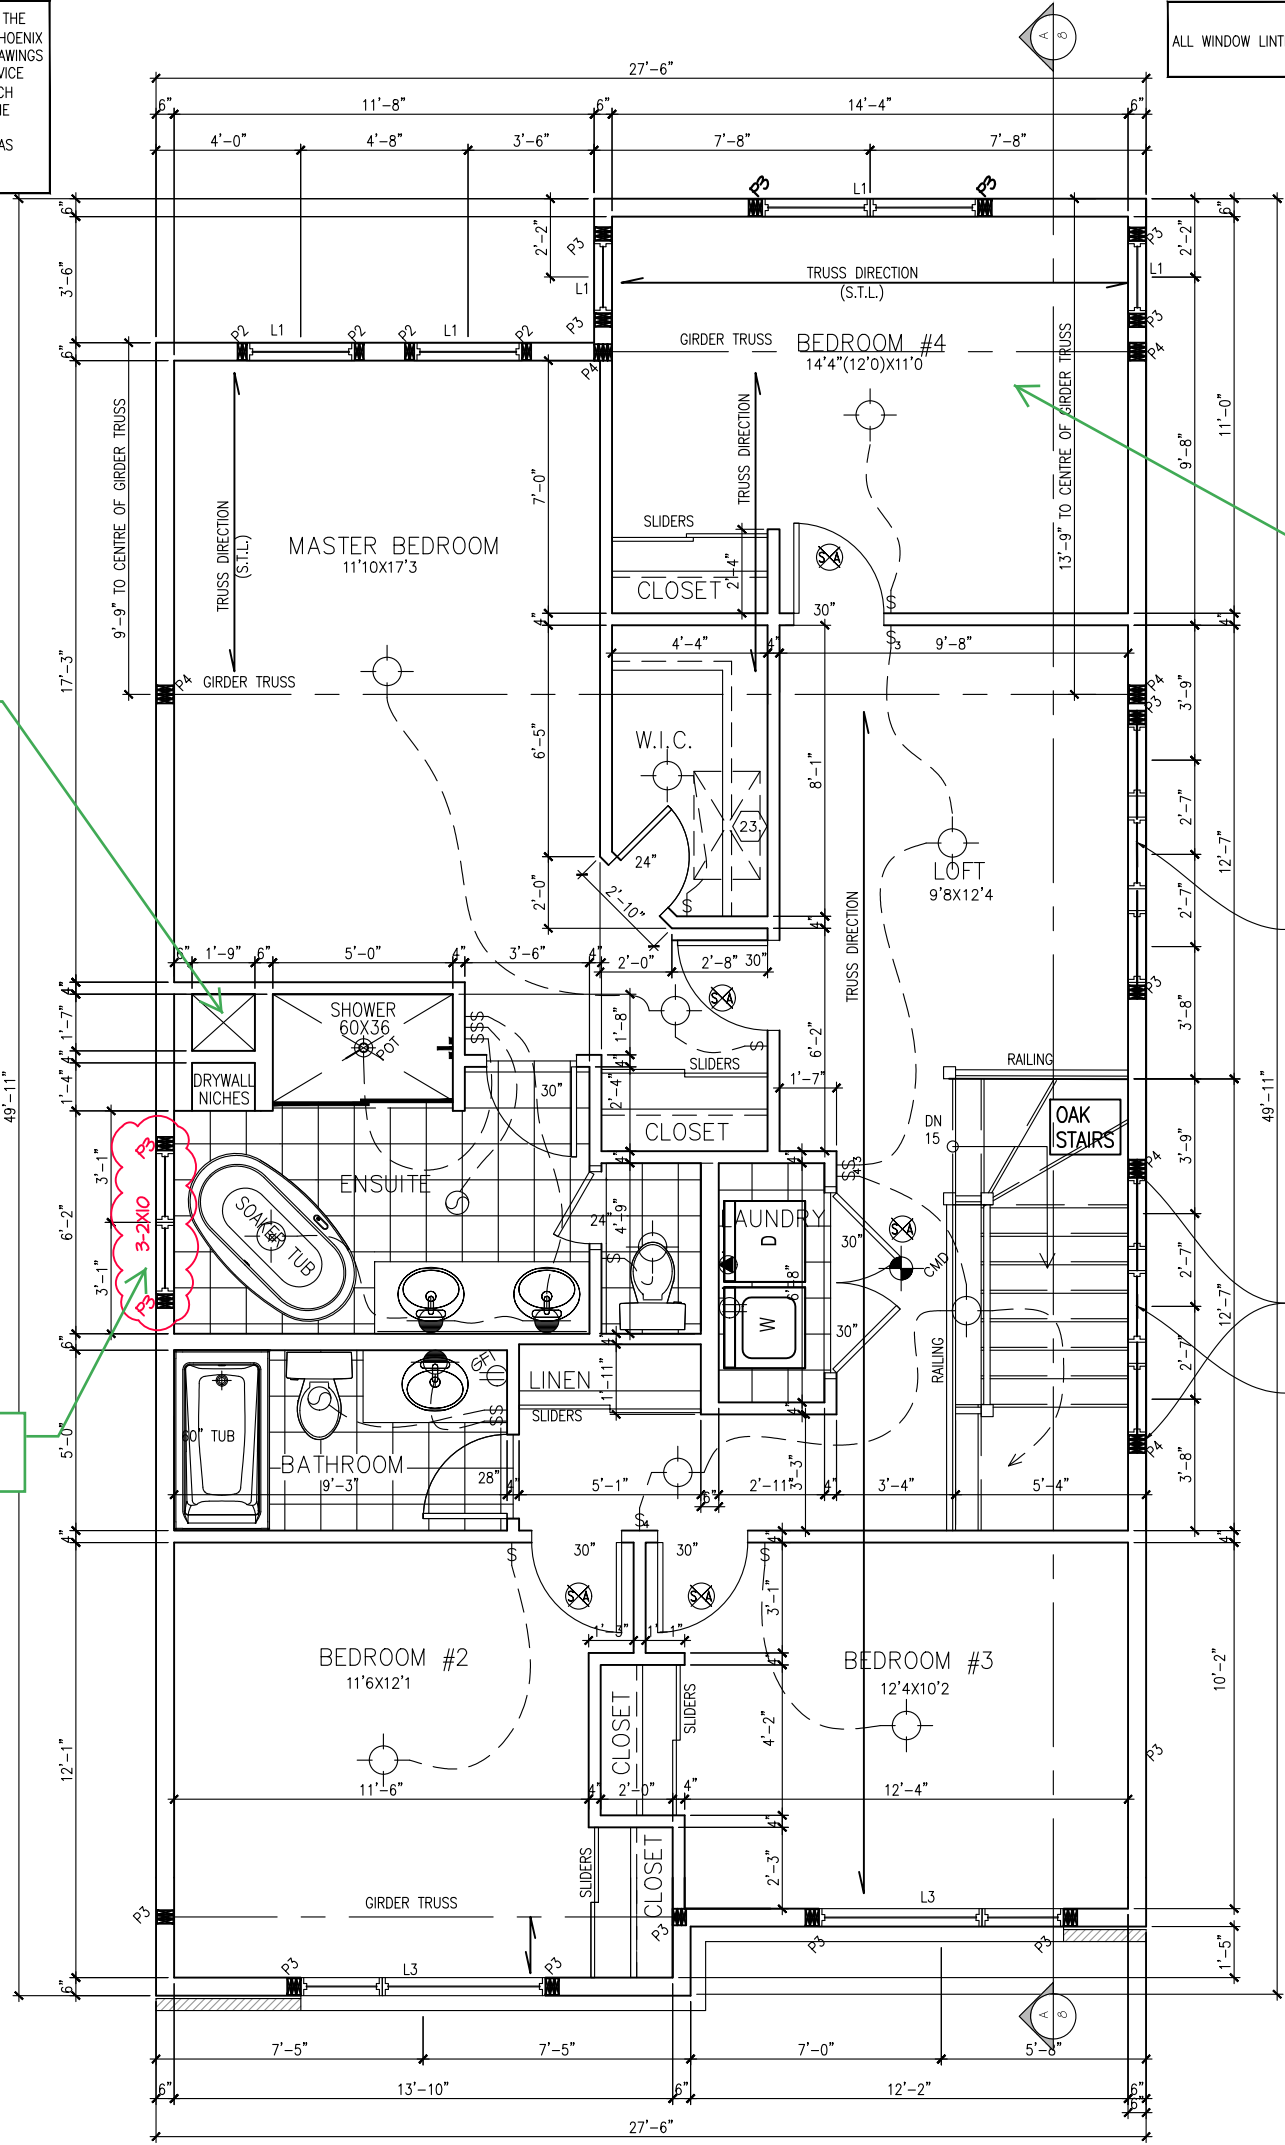

OPTIONAL
4TH
BEDROOM
SELECTED

3-2X10 CONTINUOUS
OVER 3 WINDOWS

2 FULL HEIGHT STUDS &
2 FULL HEIGHT JACK
STUDS TO CONC. WALL

3-2X10 CONTINUOUS
OVER 3 WINDOWS

ANGELO SARRAZIN

City of Ottawa
Building Services Branch


REVIEWED

By sarrazinan at 3:47 pm, Jun 09, 2021

Building Code Reviewed

ELEVATION M
1033 SQ. FT.

SECOND FLOOR PLAN

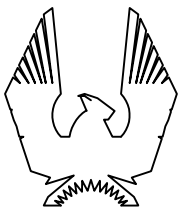

PHOENIX HOMES

35-10 STRATHMORE/2019

SITE: PATHWAYS

LOT NUMBER:


CIVIC ADDRESS:
142 MINIKAN STREET

168

9	WINDOW ADDED TO ENSUITE	21/04/21	SP
8	BEP BLACKLINES	16/03/21	SP
7	2020 DRAWING UPDATE	10/07/20	LM
No.	Description	dd/mm/yy	By
REVISIONS			


footprint:	35-10
drawn by:	SP
date:	FEB 12/16
scale:	3/16"=1'-0"
sheet no:	
D.C.L.-193	

CONTRACTOR MUST VERIFY ALL DIMENSIONS ON THE JOB AND REPORT ANY DISCREPANCY TO DCR/PHOENIX BEFORE PROCEEDING WITH THE WORK. ALL DRAWINGS AND SPECIFICATIONS ARE INSTRUMENTS OF SERVICE AND THE PROPERTY OF THE DCR/PHOENIX WHICH MUST BE RETURNED AT THE COMPLETION OF THE WORK. ALL DRAWINGS TO BE USED FOR CONSTRUCTION ONLY AFTER BUILDING PERMIT HAS BEEN ISSUED. DO NOT SCALE DRAWINGS, USE DIMENSIONS PROVIDED.

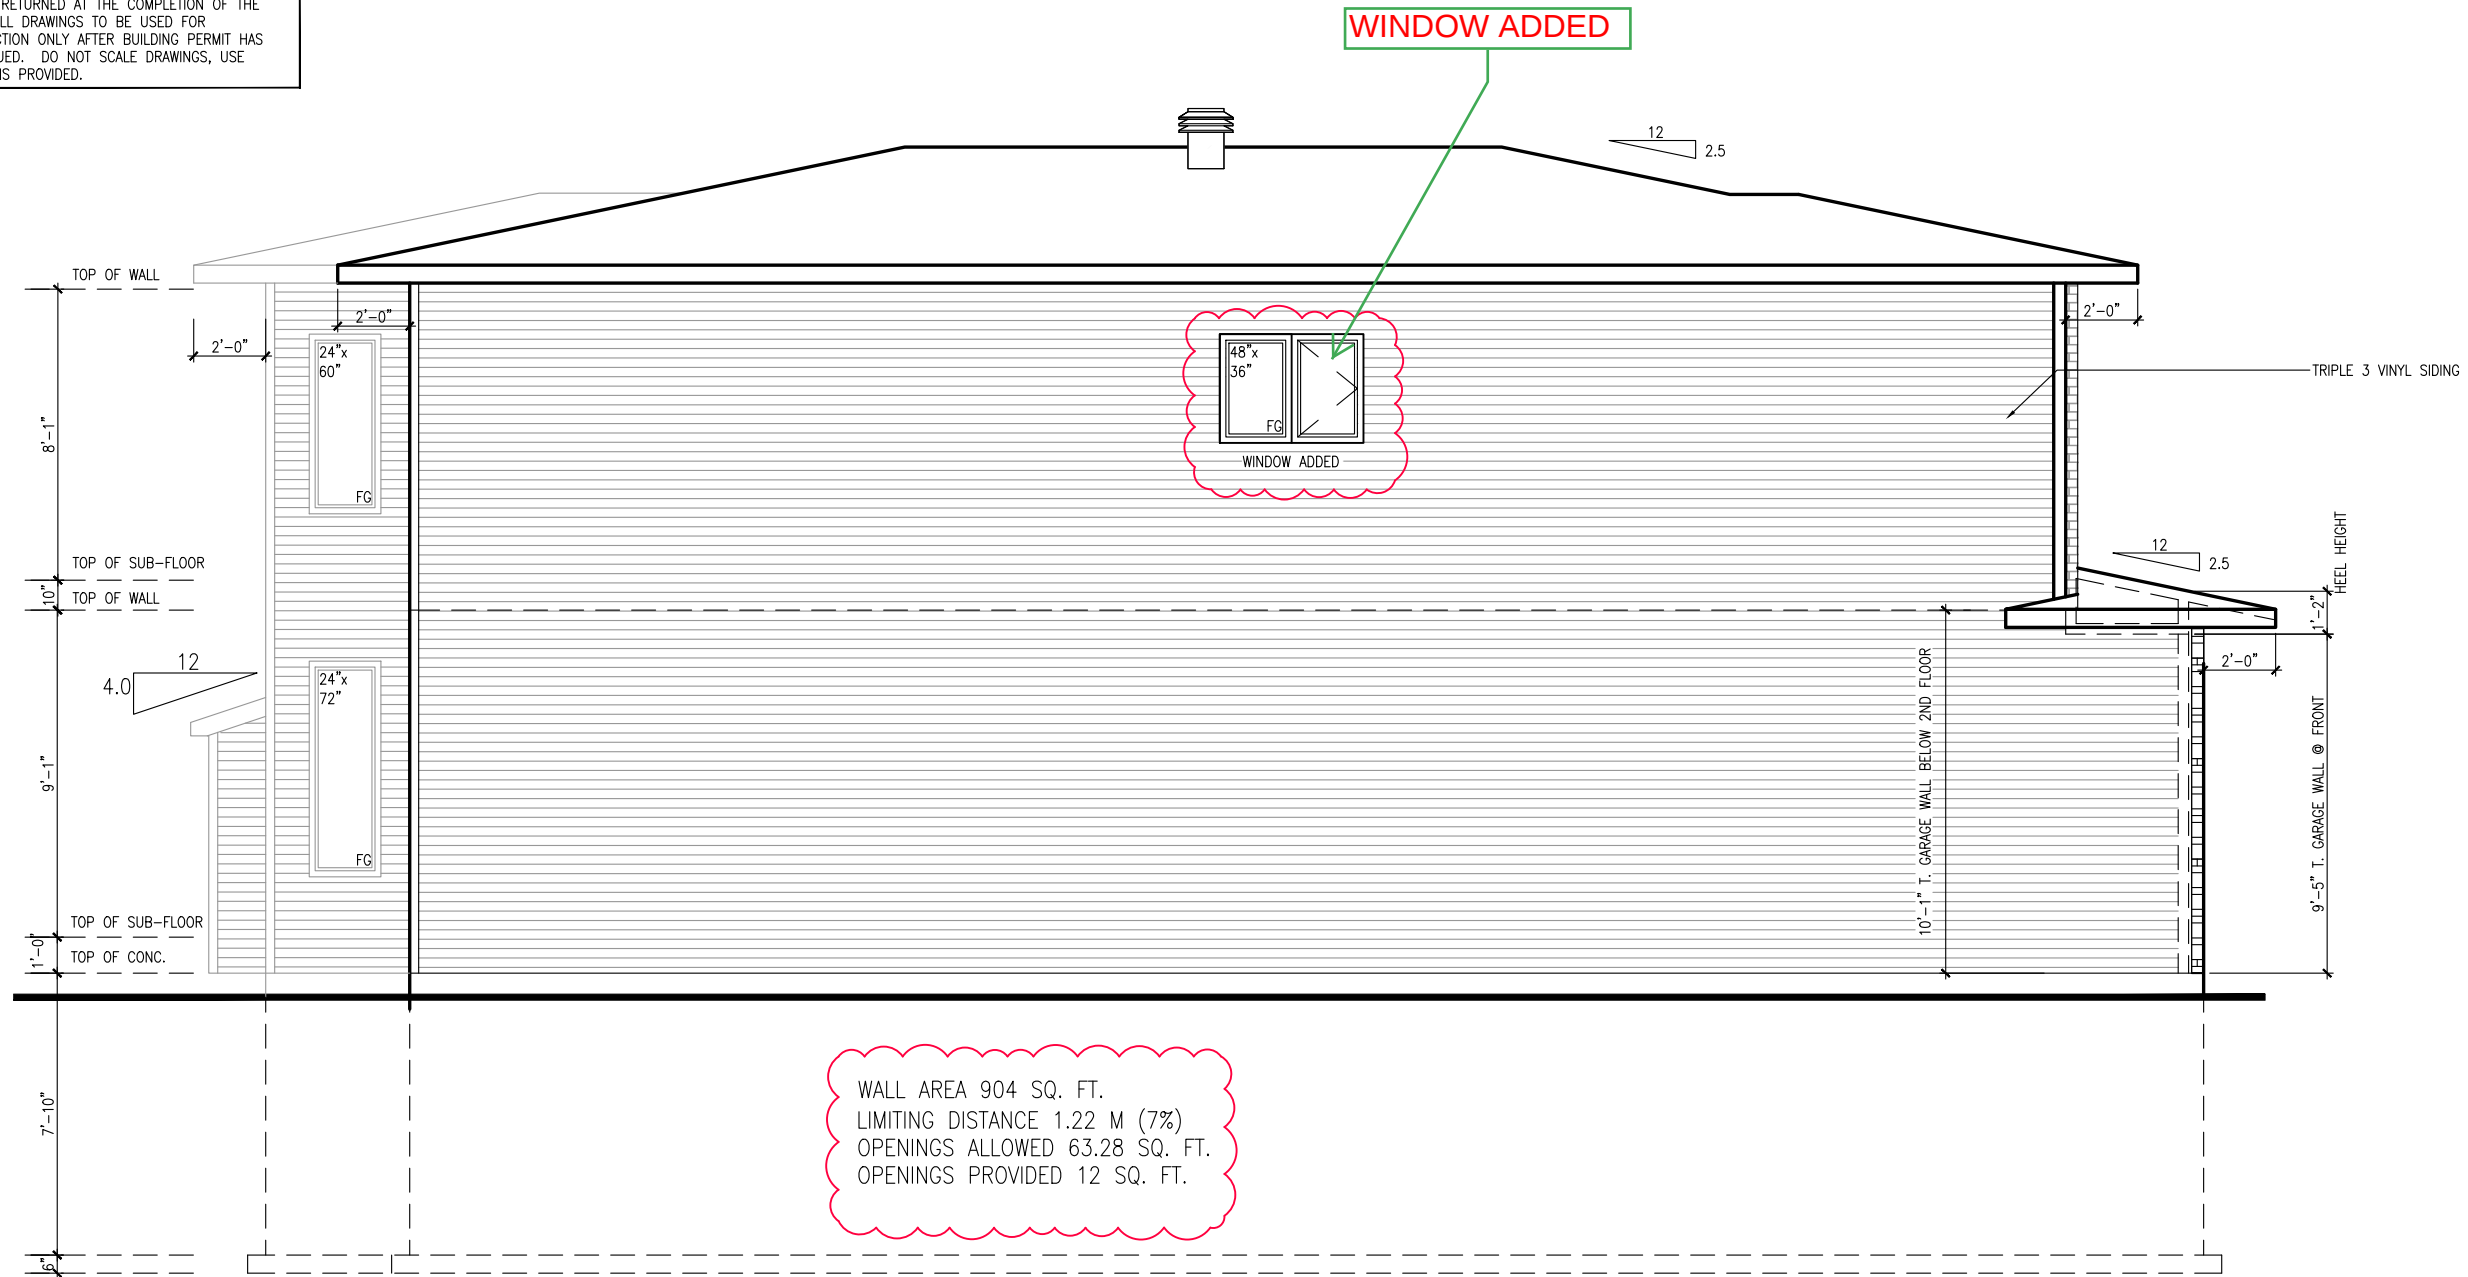

LEFT SIDE ELEVATION
ELEVATION M

****ATTENTION SIDING CREW****
DO NOT INSTALL
DECORATIVE TRIM AROUND
WINDOWS

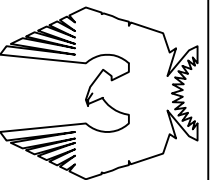

PHOENIX HOMES

35-10 STRATHMORE/2019

SITE: PATHWAYS

LOT NUMBER:

CIVIC ADDRESS:
142 MINIKAN STREET



9	WINDOW ADDED TO ENSUITE		21/04/21	SP	
8	BEP BLACKLINES		16/03/21	SP	
7	2020 DRAWING UPDATE		10/07/20	LM	
No.	Description		dd/mm/yy	By	
REVISIONS					

footprint:	35" x 10"
drawn by:	SP
date:	FEB 12/16
scale:	3/16" = 1' - 0"
sheet no:	
D.C.L.-193	