


DCR PHOENIX HOMES

LOT #111
WHITE TAIL RIDGE 2

MODEL - RUTHERFORD (517)
ALTERNATE KITCHEN (MODIFIED)
MOUNTING HEIGHT - 96

- CABINETS-
HARDWARE -
STANDARD WHITE INTERIOR
METAL DRAWER BOX
4 PCS - 5/8" KICK - FIN. BOTH ENDS
1 PCS - 90 DEG. CORNER MOULD
1 PCS - T-MOULD
5 PCS - FLAT MOULD

42"H. UPPERS @ 18" ABOVE COUNTER

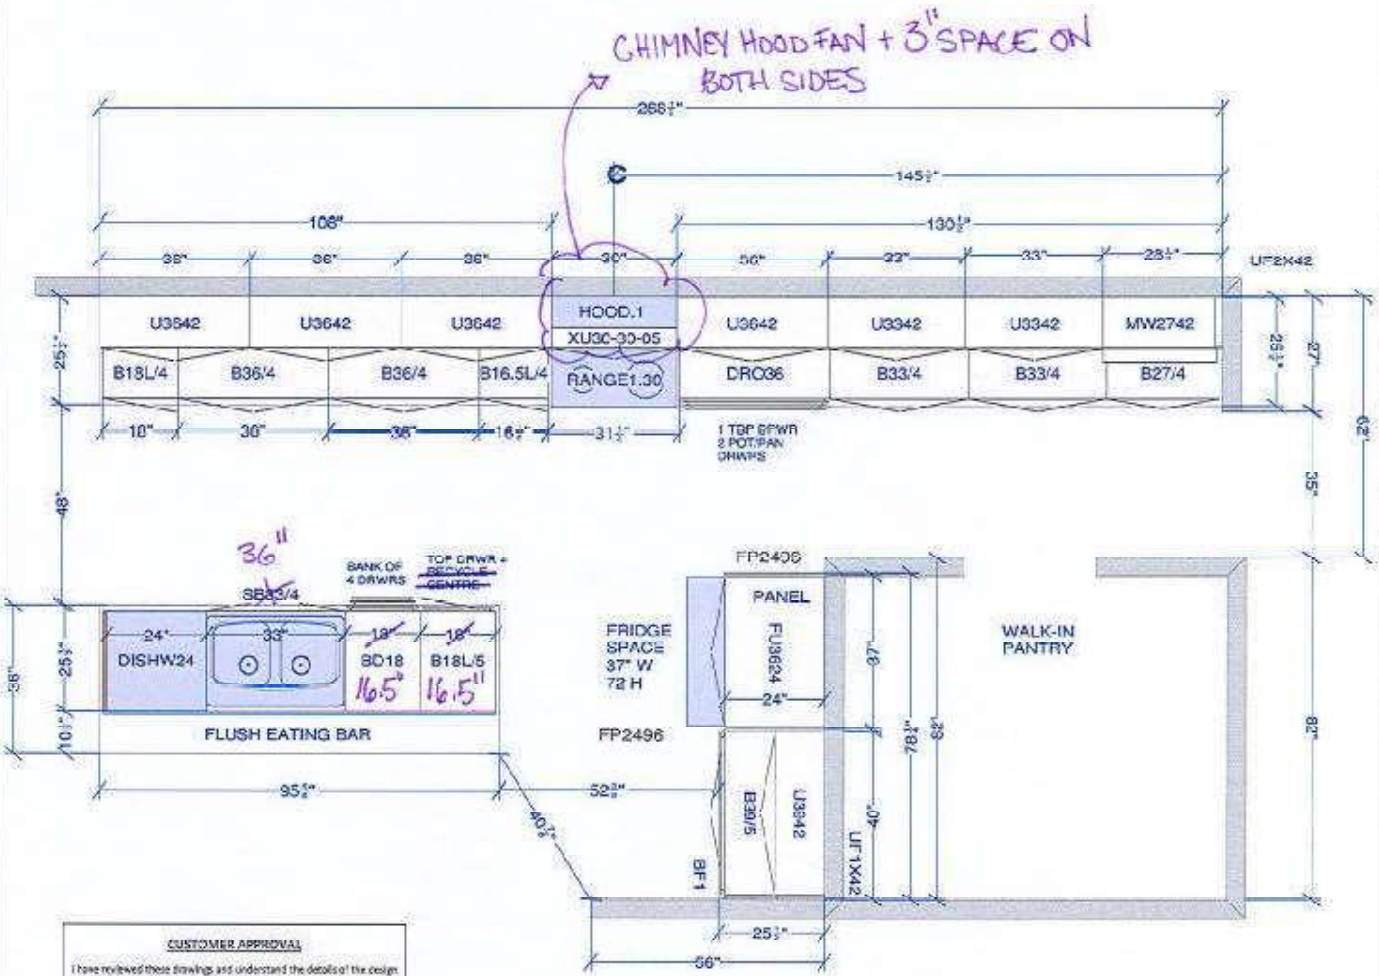

CUSTOMER APPROVAL

I have reviewed these drawings and understand the details of the design and the PARTIAL KITCHEN specifications.

Signature: _____

Date: _____

All dimensions, size designations given are subject to verification on job site and adjustment to fit job conditions.

SPECTRUM KITCHEN and BATH DESIGN

DCR #111 WTR2 - Rutherford ALT Kitchen - LEFT.kit



This is an original design and must not be released or copied unless applicable fee has been paid or job order placed.

DRAWN BY: LORI DISAVERIO, B.I.D.

Designed: 2021-03-11
Printed: 2021-03-12


DS
ST

DS
ST

Drawing #: 1 No Scale.

DS
ST

DS
ST

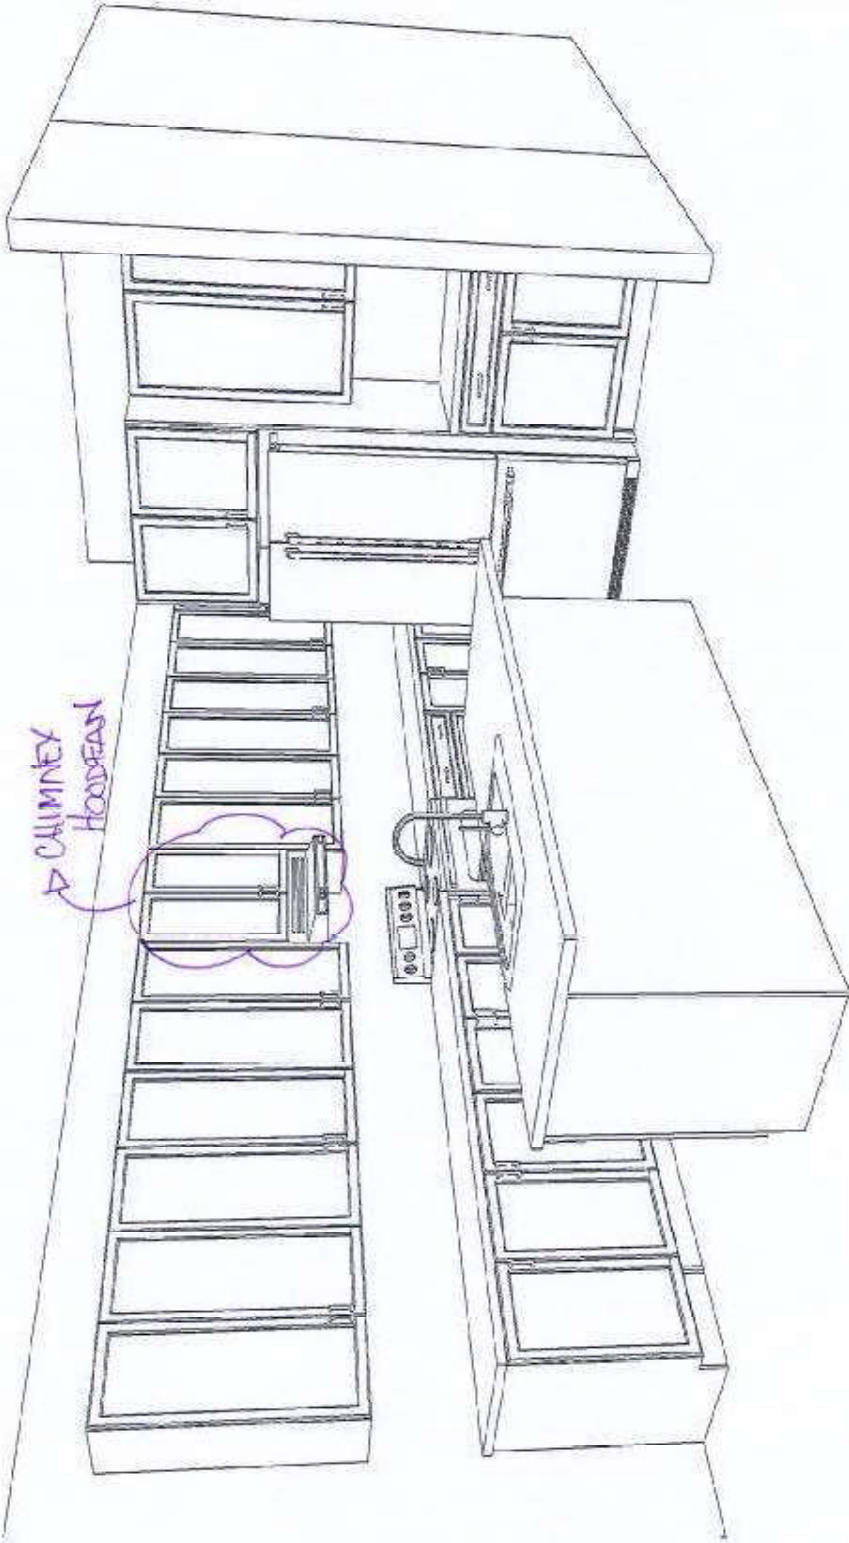

KITCHEN - 3D VIEW #1

CUSTOMER APPROVAL

I have reviewed these drawings and understand the details of the design and the CARTIER KITCHENS specifications.


Signature _____

Date _____

Note: This drawing is an artistic interpretation of the general appearance of the design. It is not meant to be an exact rendition.		All	Drawing #: 1
SPECTRUM KITCHEN and BATH DESIGN			
DCR #111 WTR2 - Rutherford A1T Kitchen -			
Designed: 2021-03-11 Printed: 2021-03-12			

DS
ST

DS
ST

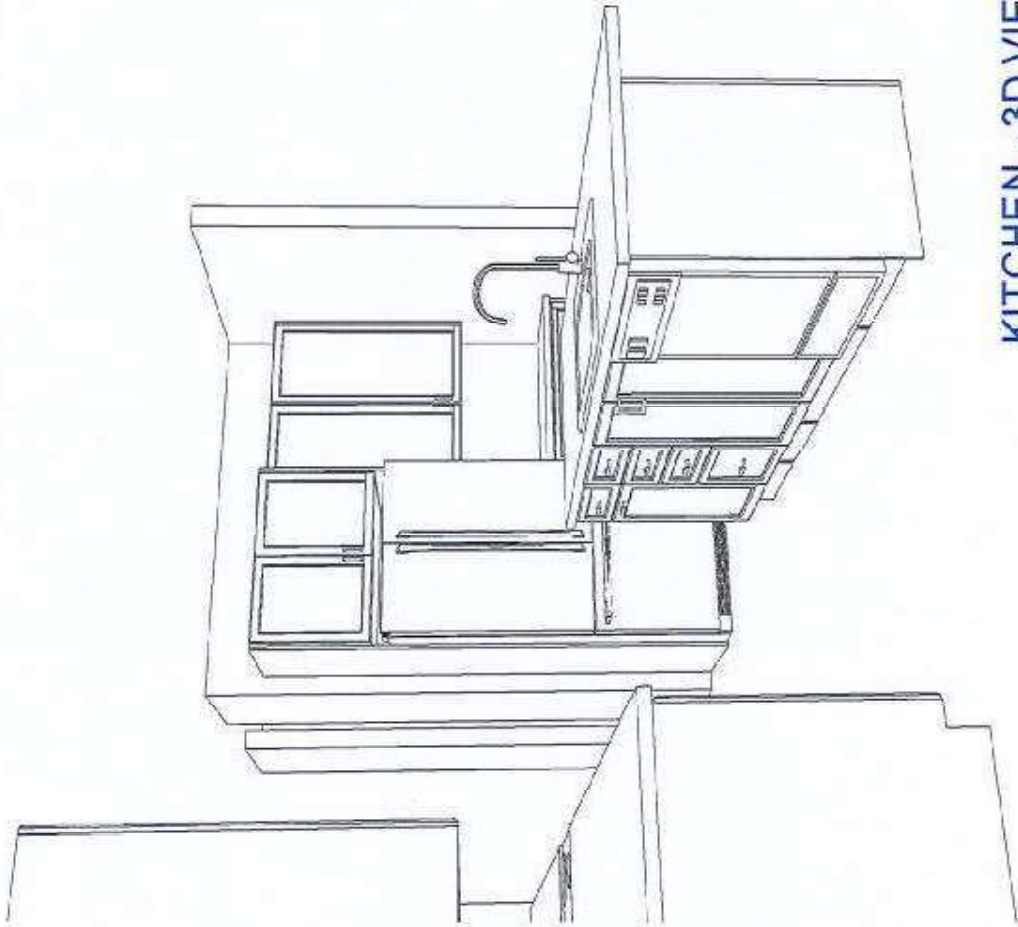

KITCHEN - 3D VIEW #2

CUSTOMER APPROVAL

I have reviewed these drawings and understand the details of the design and the CARTIER KITCHENS specifications.


Signature _____

Date _____

Note: This drawing is an artistic interpretation of the general appearance of the design. It is not meant to be an exact rendition.		Designed: 2021-03-11 Printed: 2021-03-12	
SPECTRUM KITCHEN and BATH DESIGN		All	Drawing #: 1
DCR #111 WTR2 - Rutherford ALT Kitchen -			

DS
ST

DS
ST

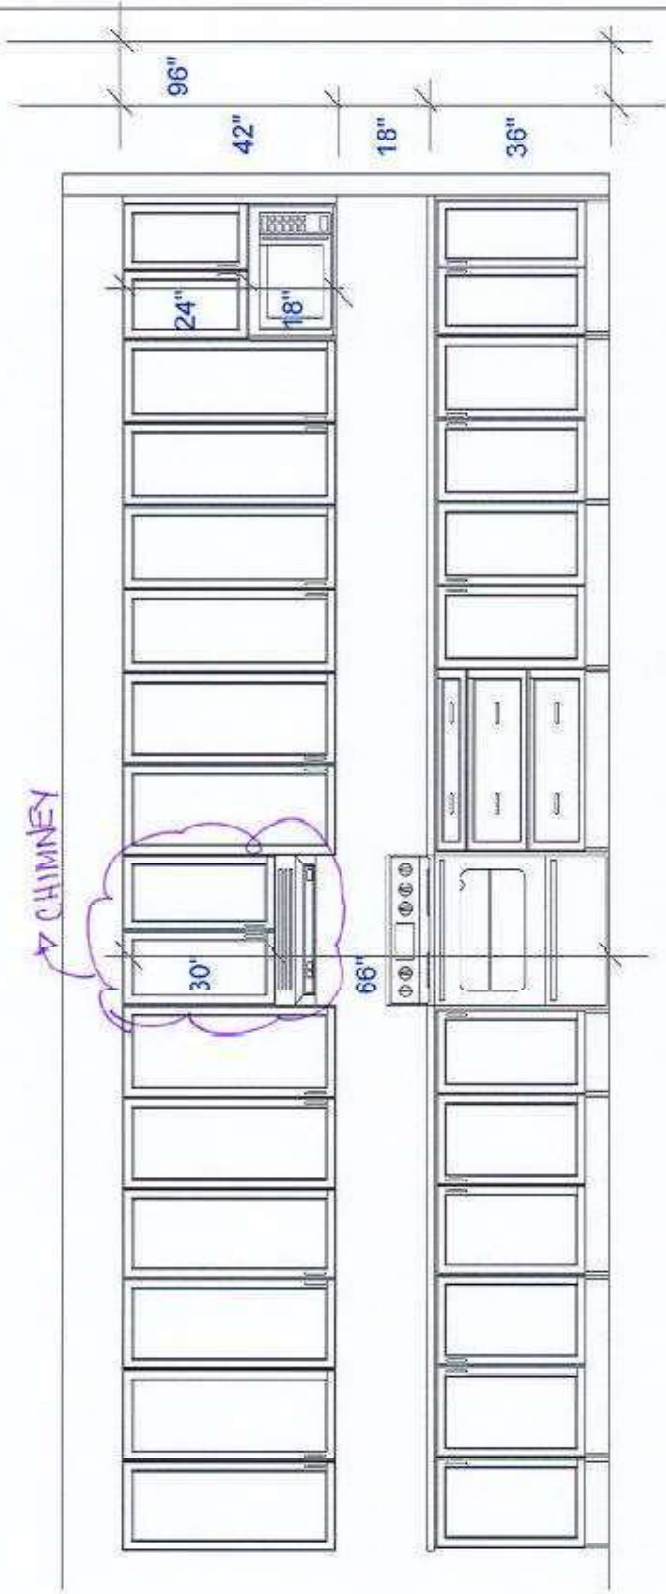

RANGE WALL ELEVATION


CUSTOMER APPROVAL

I have reviewed these drawings and understand the details of the design and the CARTIER KITCHENS specifications.

Signature _____

Date _____

	Designed: 2021-03-11	Drawing #: 1
	Printed: 2021-03-12	
Note: This drawing is an artistic interpretation of the general appearance of the design. It is not meant to be an exact rendition.		
SPECTRUM KITCHEN and BATH DESIGN		
DCR #111 WTR2 - Rutherford ALT Kitchen -		
All		

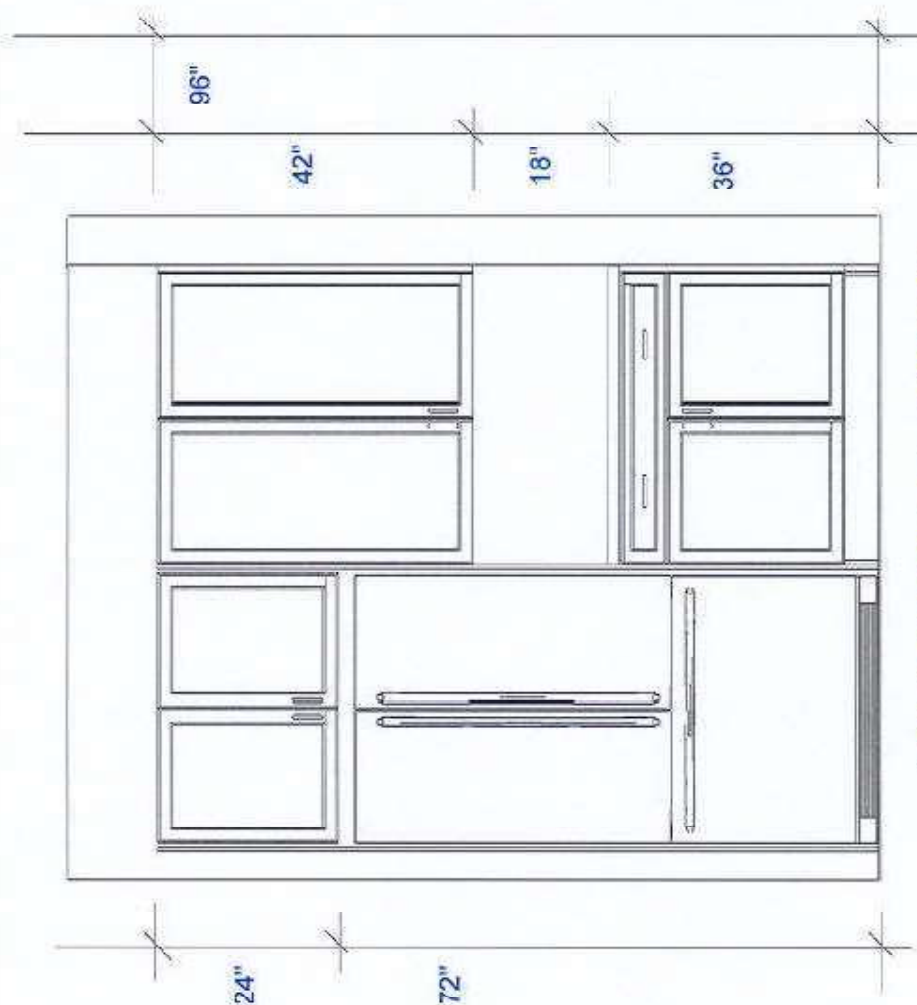

FRIDGE WALL ELEVATION

CUSTOMER APPROVAL

I have reviewed these drawings and understand the details of the design and the CARTER KITCHENS specifications.

Signature _____

Date _____

Note: This crawling is an artistic interpretation of the general appearance of the design. It is not meant to be an exact rendition.

SPECTRUM KITCHEN and BATH
DESIGN

DCR #111 WTR2 - Rutherford ALT Kitchen -




Designed: 2021-03-11
Printed: 2021-03-12

Drawing #: 1

DS
ST

DS
ST

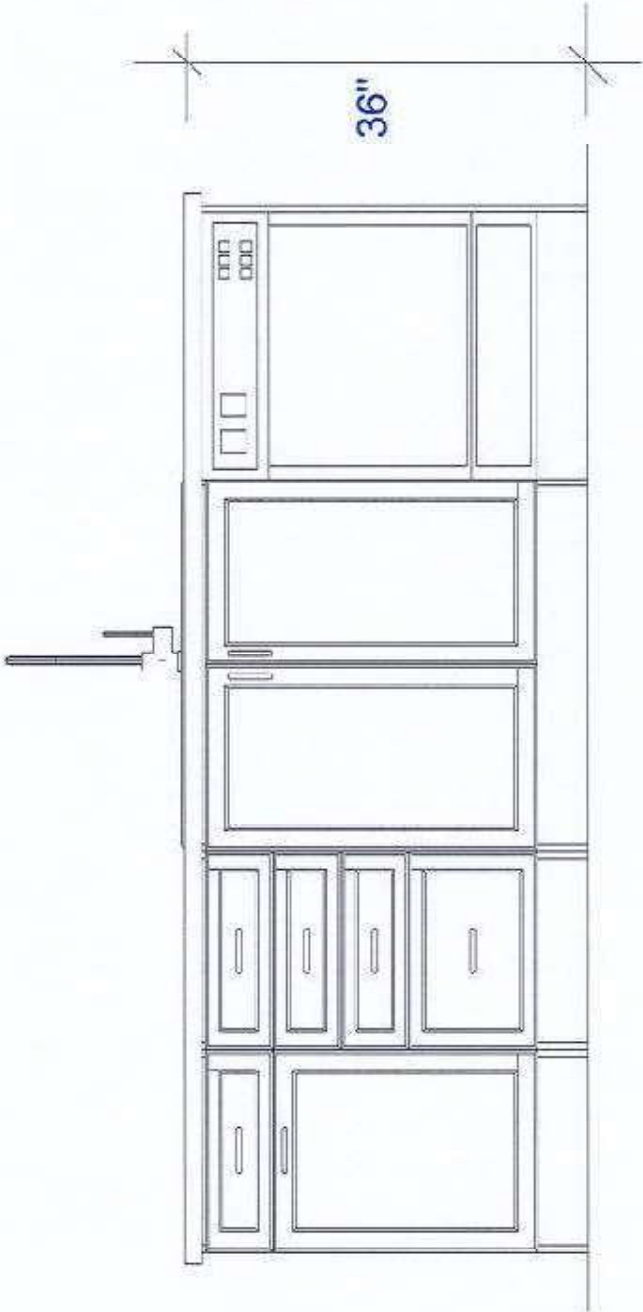

ISLAND ELEVATION

CUSTOMER APPROVAL

I have reviewed these drawings and understand the details of the design and the CARTIER KITCHENS specifications.

Signature: _____

Date: _____

Note: This drawing is an artistic interpretation of the general appearance of the design. It is not meant to be an exact rendition.



SPECTRUM KITCHEN and BATH DESIGN

DCR #111 WTR2 - Rutherford A.L.T Kitchen -

All


Designed: 2021-03-11
Printed: 2021-03-12

Drawing #: 1


DCR PHOENIX HOMES

LOT #111
WHITE TAIL RIDGE
MODEL - RUTHERFORD (517)
VANITIES & LAUNDRY
MOUNTING HEIGHT - 84


CABINETS -
HARDWARE -
STANDARD WHITE INTERIOR
METAL DRAWER BOX
4 PCS - 5/8" KICK - FIN. BOTH ENDS
5 PCS - FLAT SHOE MOULD

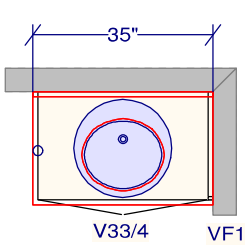


POWDER ROOM

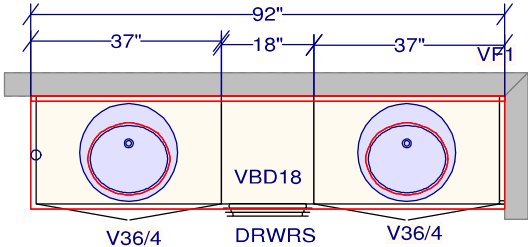


ENSUITE 1 (MASTER)

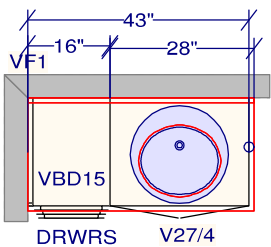

ENSUITE 2

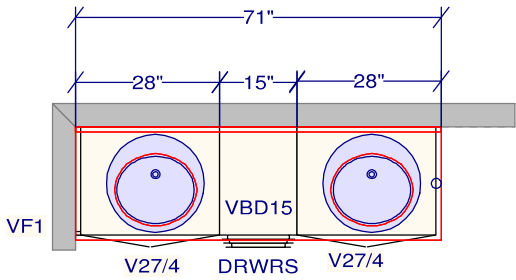

MAIN BATH

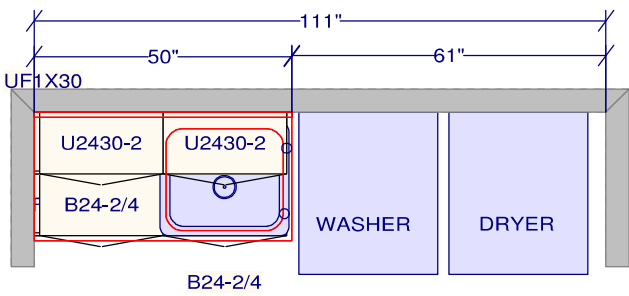

LAUNDRY ROOM

CUSTOMER APPROVAL
I have reviewed these drawings and understand the details of the design and the CABINET/KITCHEN specifications.
Signature _____
Date _____

All dimensions _size designations given are subject to verification on job site and adjustment to fit job conditions.
SPECTRUM KITCHEN and BATH DESIGN
DCR #111 WTR2 - Vanities + Laundry.kit



This is an original design and must not be released or copied unless applicable fee has been paid or job order placed.
DRAWN BY: LORI DISAVERIO, B.I.D

Dsigned: 2021-03-12
Printed: 2021-03-12
DS
ST
DS
ST
Drawing #: 1 No Scale.