

DCR PHOENIX HOMES

LOT #33

WHITE TAIL RIDGE 2

MODEL - CARTESIAN (B4)

KITCHEN / VANITIES

MOUNTING HEIGHT = 86

30"H UPPERS @ 20" ABOVE COUNTER

CROWN MOULDING - 3" MEDIUM TRADITIONAL STYLE

LIGHT VALANCE - 2"H. RECESSED STYLE

CABINETS -

HARDWARE -


STANDARD WHITE INTERIOR

METAL DRAWER BOX

4 PCS - KICK

6 PCS - FLAT MOULDING

REVISED: MARCH 10-21

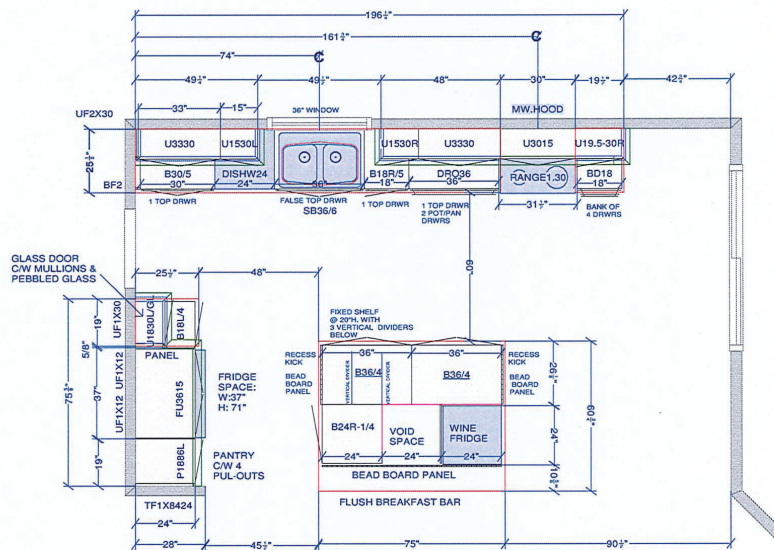


CUSTOMER APPROVAL


I have reviewed these drawings and understand the details of the design and the CARTIER KITCHENS specifications.

Signature _____

Date _____

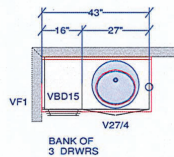

MAIN BATH

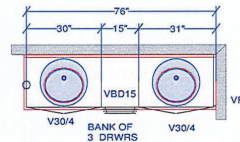

ENSUITE

All dimensions, size designations given are subject to verification on job site and adjustment to fit job conditions.

SPECTRUM KITCHEN and BATH DESIGN

DCR#33-1.kit



This is an original design and must not be released or copied unless applicable fee has been paid or job order placed.


DRAWN BY: LORI DISAVERIO, B.I.D

Designed: 2021-02-23
Printed: 2021-03-10

[Handwritten initials]

All

Drawing #: 1 No Scale.

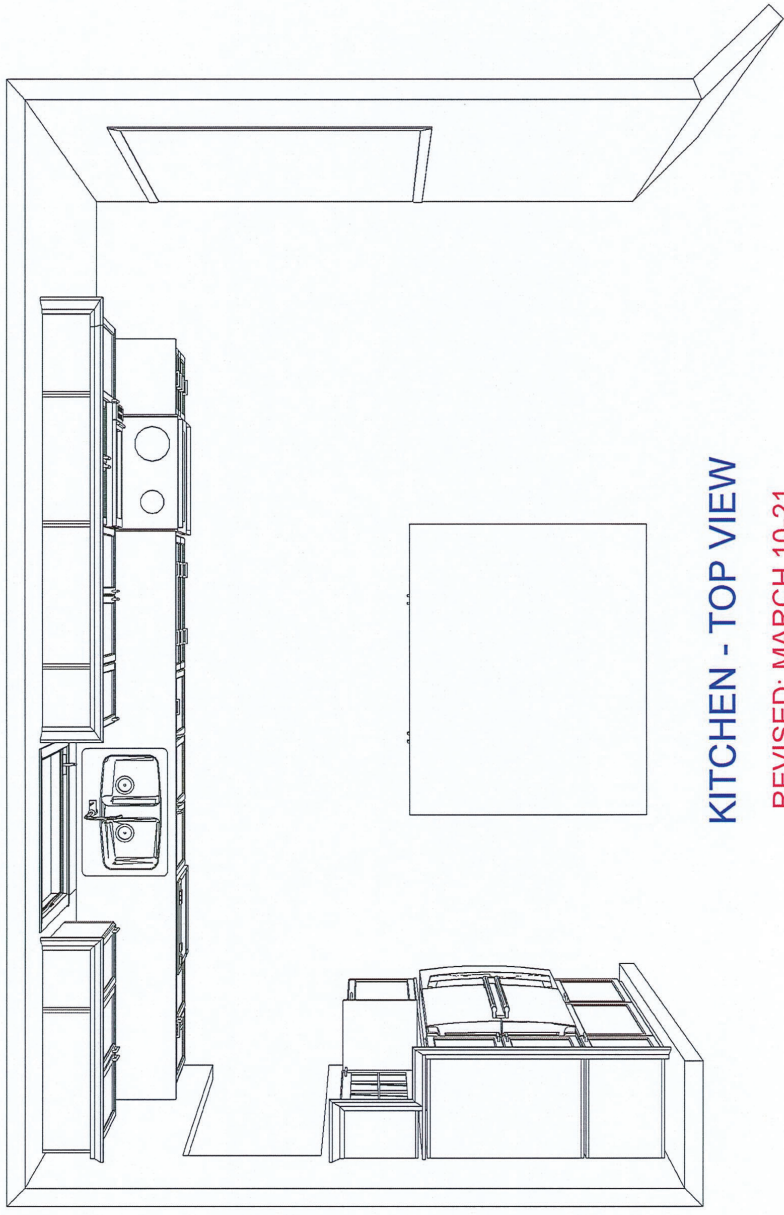

KITCHEN - TOP VIEW

REVISED: MARCH 10-21

CUSTOMER APPROVAL

I have reviewed these drawings and understand the details of the design and the CARTIER KITCHENS specifications.

Signature _____

Date _____

Note: This drawing is an artistic interpretation of the general appearance of the design. It is not meant to be an exact rendition. SPECTRUM KITCHEN and BATH DESIGN DCR#33~1.kit		Designed: 2021-02-23 Printed: 2021-03-10	 	Drawing #: 1
		All		



BEAD BOARD
PANEL

BEAD BOARD PANEL

KITCHEN - 3D VIEW #1

REVISED: MARCH 10-21

CUSTOMER APPROVAL

I have reviewed these drawings and understand the details of the design and the CARTIER KITCHENS specifications.

Signature _____

Date _____

Note: This drawing is an artistic interpretation of the general appearance of the design. It is not meant to be an exact rendition.




SPECTRUM KITCHEN and BATH
DESIGN
DCR#33~1 kit

Designed: 2021-02-23
Printed: 2021-03-10



All

Drawing #: 1

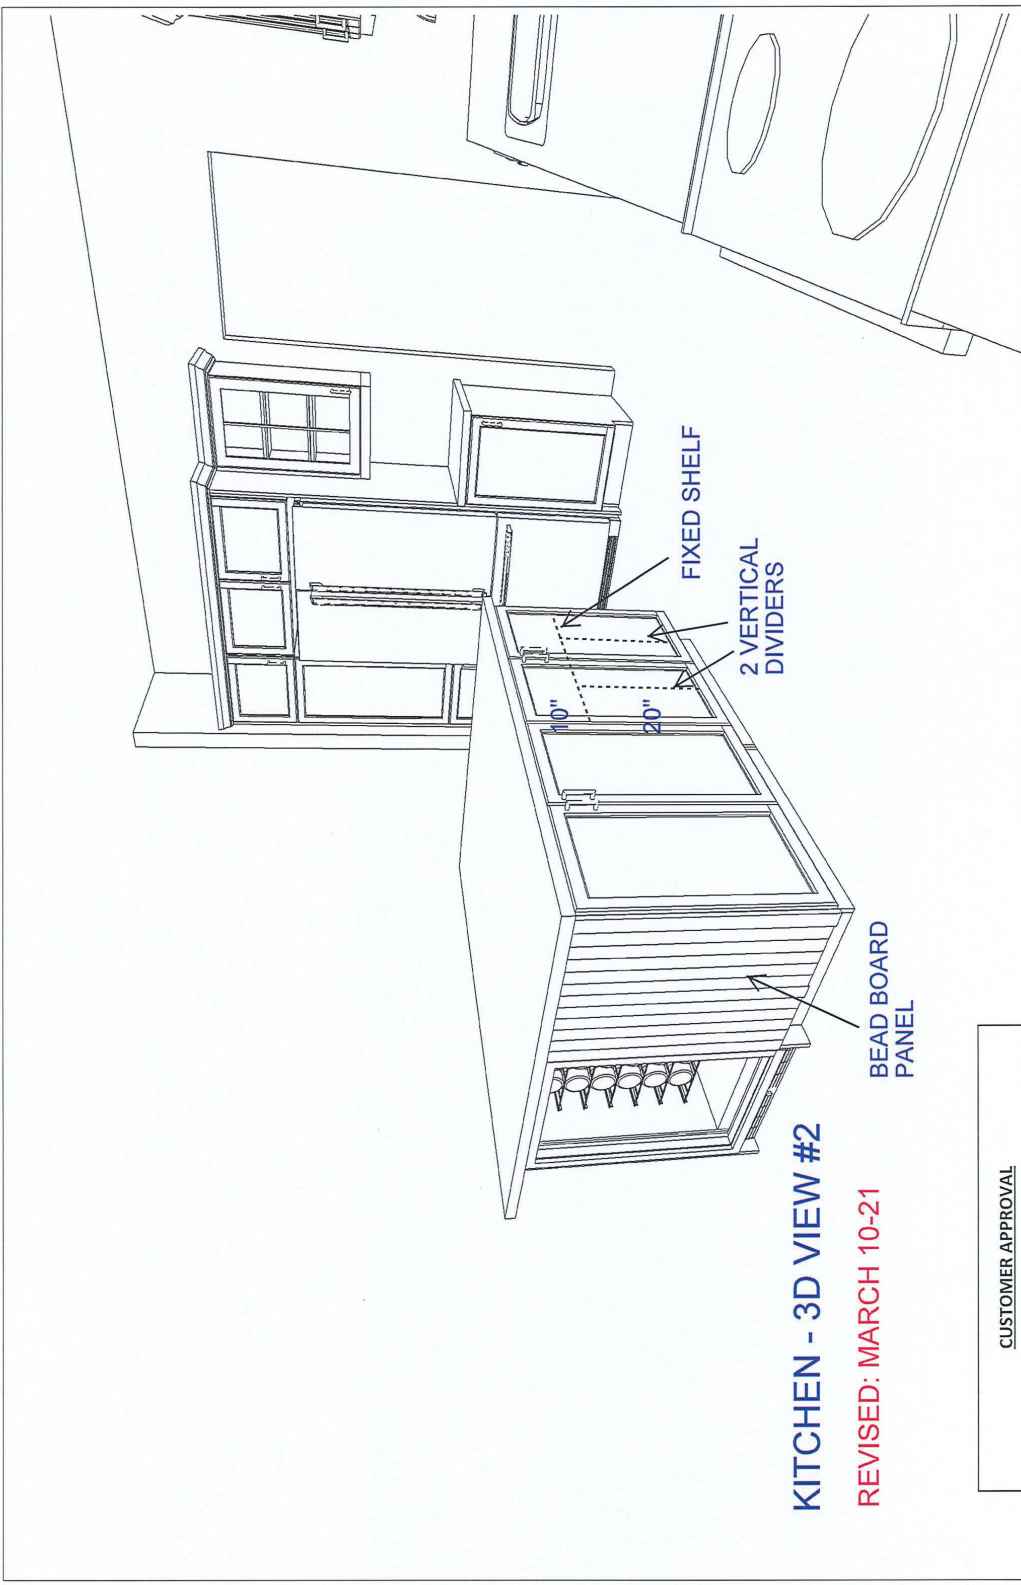

KITCHEN - 3D VIEW #2

REVISED: MARCH 10-21


CUSTOMER APPROVAL

I have reviewed these drawings and understand the details of the design and the CARTIER KITCHENS specifications.

Signature _____

Date _____

Note: This drawing is an artistic interpretation of the general appearance of the design. It is not meant to be an exact rendition. SPECTRUM KITCHEN and BATH DESIGN DCR#33~1 kit		Designed: 2021-02-23 Printed: 2021-03-10		Drawing #: 1
			All	

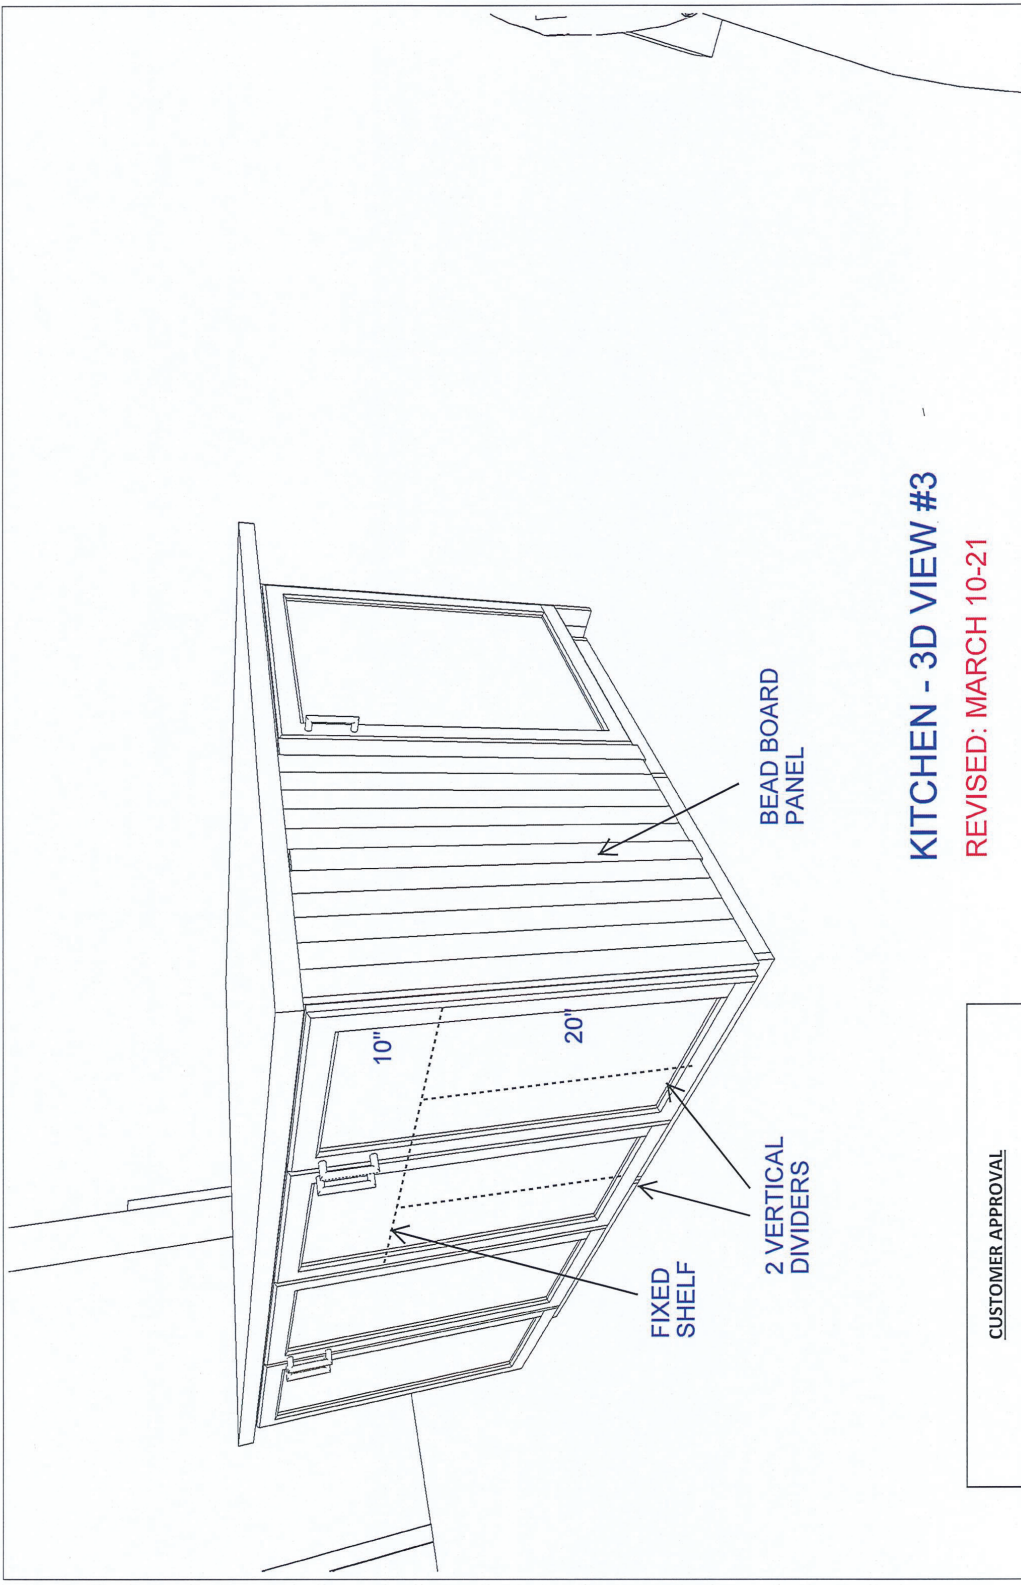

KITCHEN - 3D VIEW #3

REVISED: MARCH 10-21


CUSTOMER APPROVAL

I have reviewed these drawings and understand the details of the design and the CARTIER KITCHENS specifications.

Signature _____

Date _____

	Designed: 2021-02-23 Printed: 2021-03-10	
	Drawing #: 1	
SPECTRUM KITCHEN and BATH DESIGN DCR#33~1 kit		All

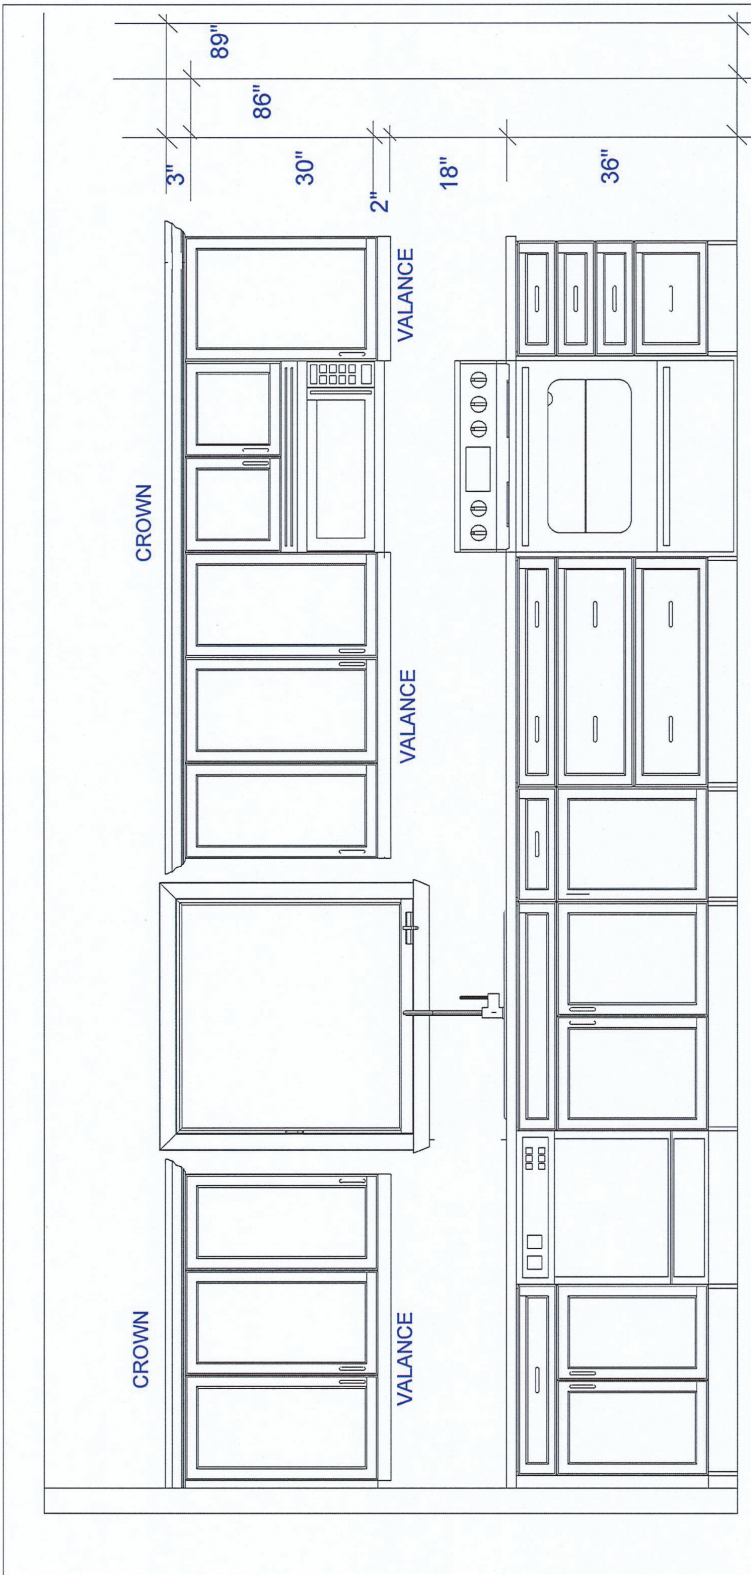

SINK / RANGE WALL ELEVATION

REVISED: MARCH 10-21

CUSTOMER APPROVAL

I have reviewed these drawings and understand the details of the design and the CARTIER KITCHENS specifications.

Signature _____


Date _____

Note: This drawing is an artistic interpretation of the general appearance of the design. It is not meant to be an exact rendition. SPECTRUM KITCHEN and BATH DESIGN DCR #33 White Tail Ridge 2 - CARTESIAN B4.kit		Designed: 2021-02-23 Printed: 2021-02-23	Drawing #: 1
		All	




Date _____

Drawing #: 1

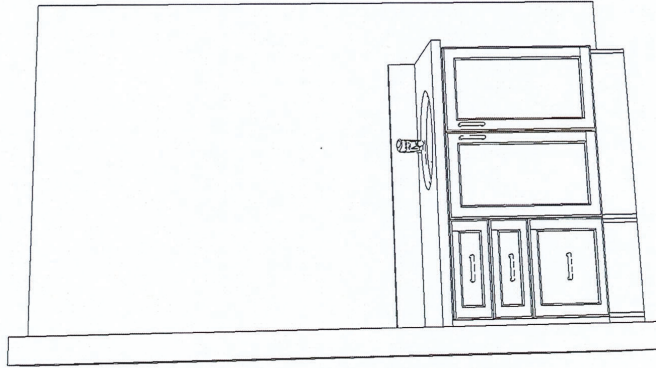

MAIN BATH VANITY

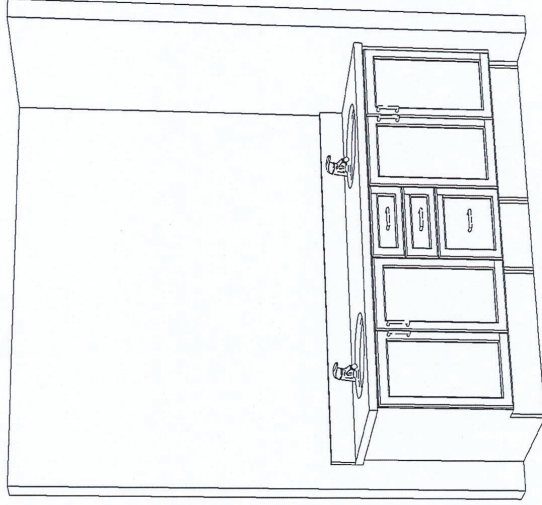

ENSUITE BATH VANITY

CUSTOMER APPROVAL

I have reviewed these drawings and understand the details of the design and the CARTIER KITCHENS specifications.

Signature _____

Date _____

Designed: 2021-02-23
Printed: 2021-02-23



SPECTRUM KITCHEN and BATH
DESIGN

DCR #33 White Tail Ridge 2 - CARTESIAN B4.kit

All

Drawing #: 1