

DCR PHOENIX HOMES

LOT #7

DIAMONDVIEW ESTATES 2

MODEL TYPE - SPRINGFIELD (Right)

KITCHEN/VANITIES

MOUNTING HEIGHT - 115"

STACKED UPPERS - 42" + 18"
CROWN MOULDING - SHAKER STYLE (3")

DUMMY DOORS ON ALL EXPOSED SIDES
OF UPPER AND BASE CABINETS
FLUSH KICK ON BACK
AND SIDES OF ISLAND


- KITCHEN
- CABINETS -
 - HARDWARE -
 - STANDARD WHITE INTERIOR
 - STANDARD HINGES
 - STANDARD METAL DRAWER BOXES
 - 5 PCS - 58" KICK - FIN. BOTH ENDS
 - 2 PCS - 90 DEG. CORNER MOULD
 - 2 PCS - T-MOULD
 - 7 PCS - FLAT MOULDING
 - 3 PCS - FLUSH KICK - ISLAND
 - 2 PCS - FLUSH KICK - TO BE INSTALLED BETWEEN STACKED UPPERS

CUSTOMER APPROVAL



I have reviewed these drawings and understand the details of the design and the CARTIER KITCHENS specifications.

Signature _____

Date _____

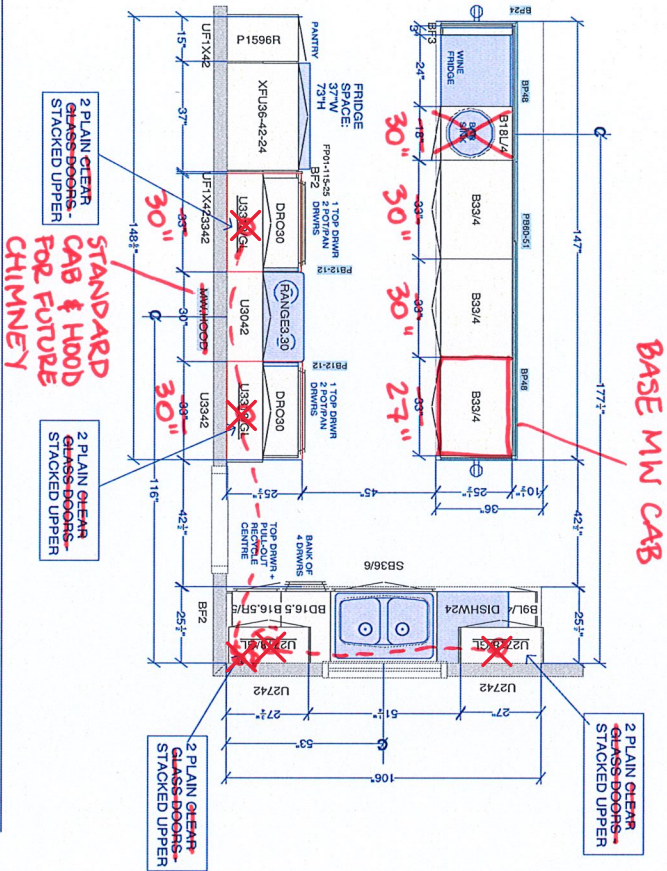

VANITIES

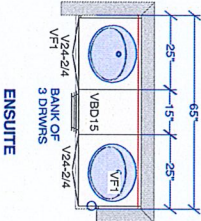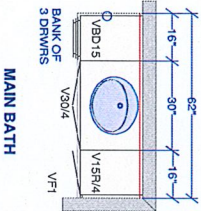

All dimensions, size designations given are subject to verification on job site and adjustment to fit job conditions.

SPECTRUM KITCHEN and BATH DESIGN

DCR #7 Diamondview Estates 2-.kit




This is an original design and must not be released or copied unless applicable fee has been paid or job order placed.

DRAWN BY: LORI DISAVERIO, B.I.D

All

Drawing #: 1 No Scale.

Designed: 2021-05-26
Printed: 2021-05-26

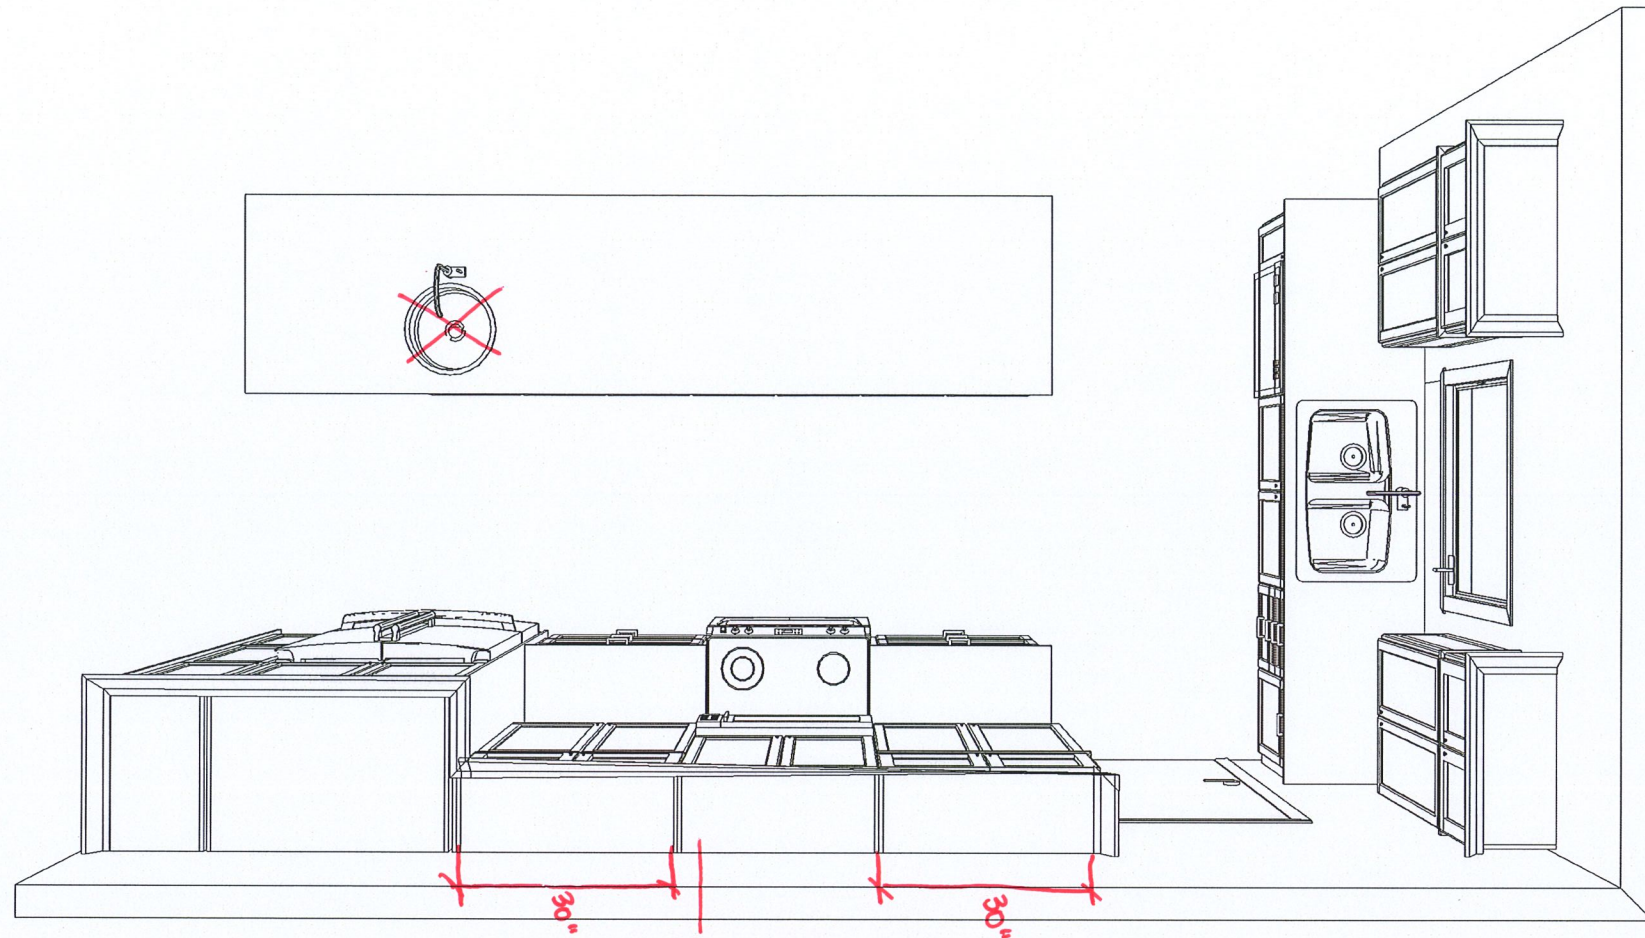

STANDARD UPPER & HOOD
KITCHEN-TOP VIEW

CUSTOMER APPROVAL

I have reviewed these drawings and understand the details of the design and the CARTIER KITCHENS specifications.

Signature _____

Date _____

Note: This drawing is an artistic interpretation of the general appearance of the design. It is not meant to be an exact rendition.

SPECTRUM KITCHEN and BATH
DESIGN


DCR #7 Diamndview Estates 2- .kit



Designed: 2021-05-26
Printed: 2021-05-26

All

Drawing #: 1

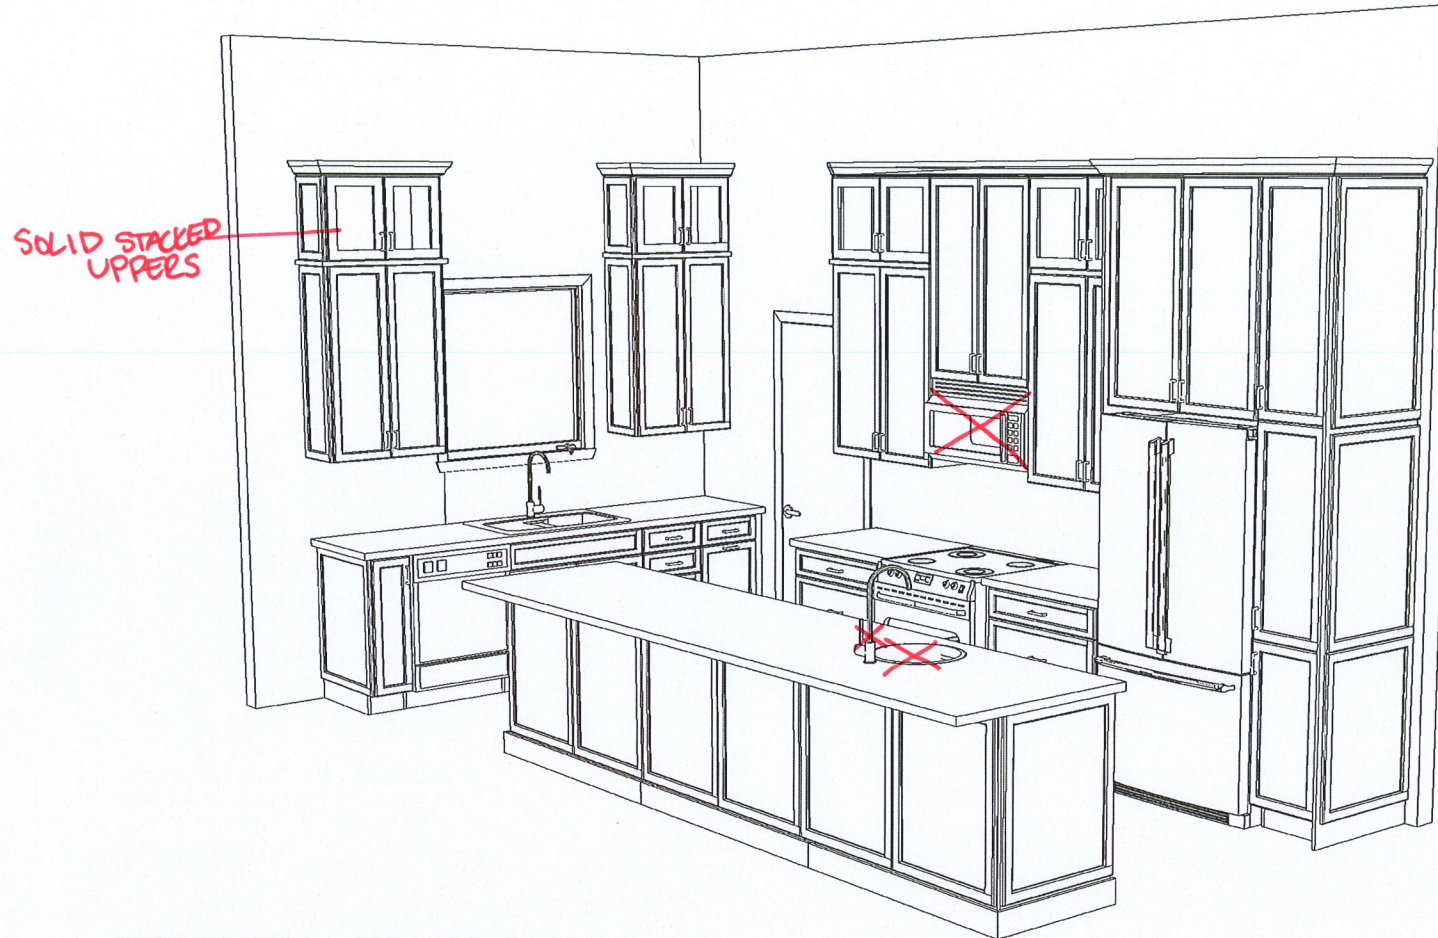

KITCHEN -3D VIEW #1

CUSTOMER APPROVAL

I have reviewed these drawings and understand the details of the design and the CARTIER KITCHENS specifications.

Signature _____

Date _____

Note: This drawing is an artistic interpretation of the general appearance of the design. It is not meant to be an exact rendition.

SPECTRUM KITCHEN and BATH
DESIGN


DCR #7 Diamndview Estates 2- .kit



Designed: 2021-05-26
Printed: 2021-05-26

All

Drawing #: 1

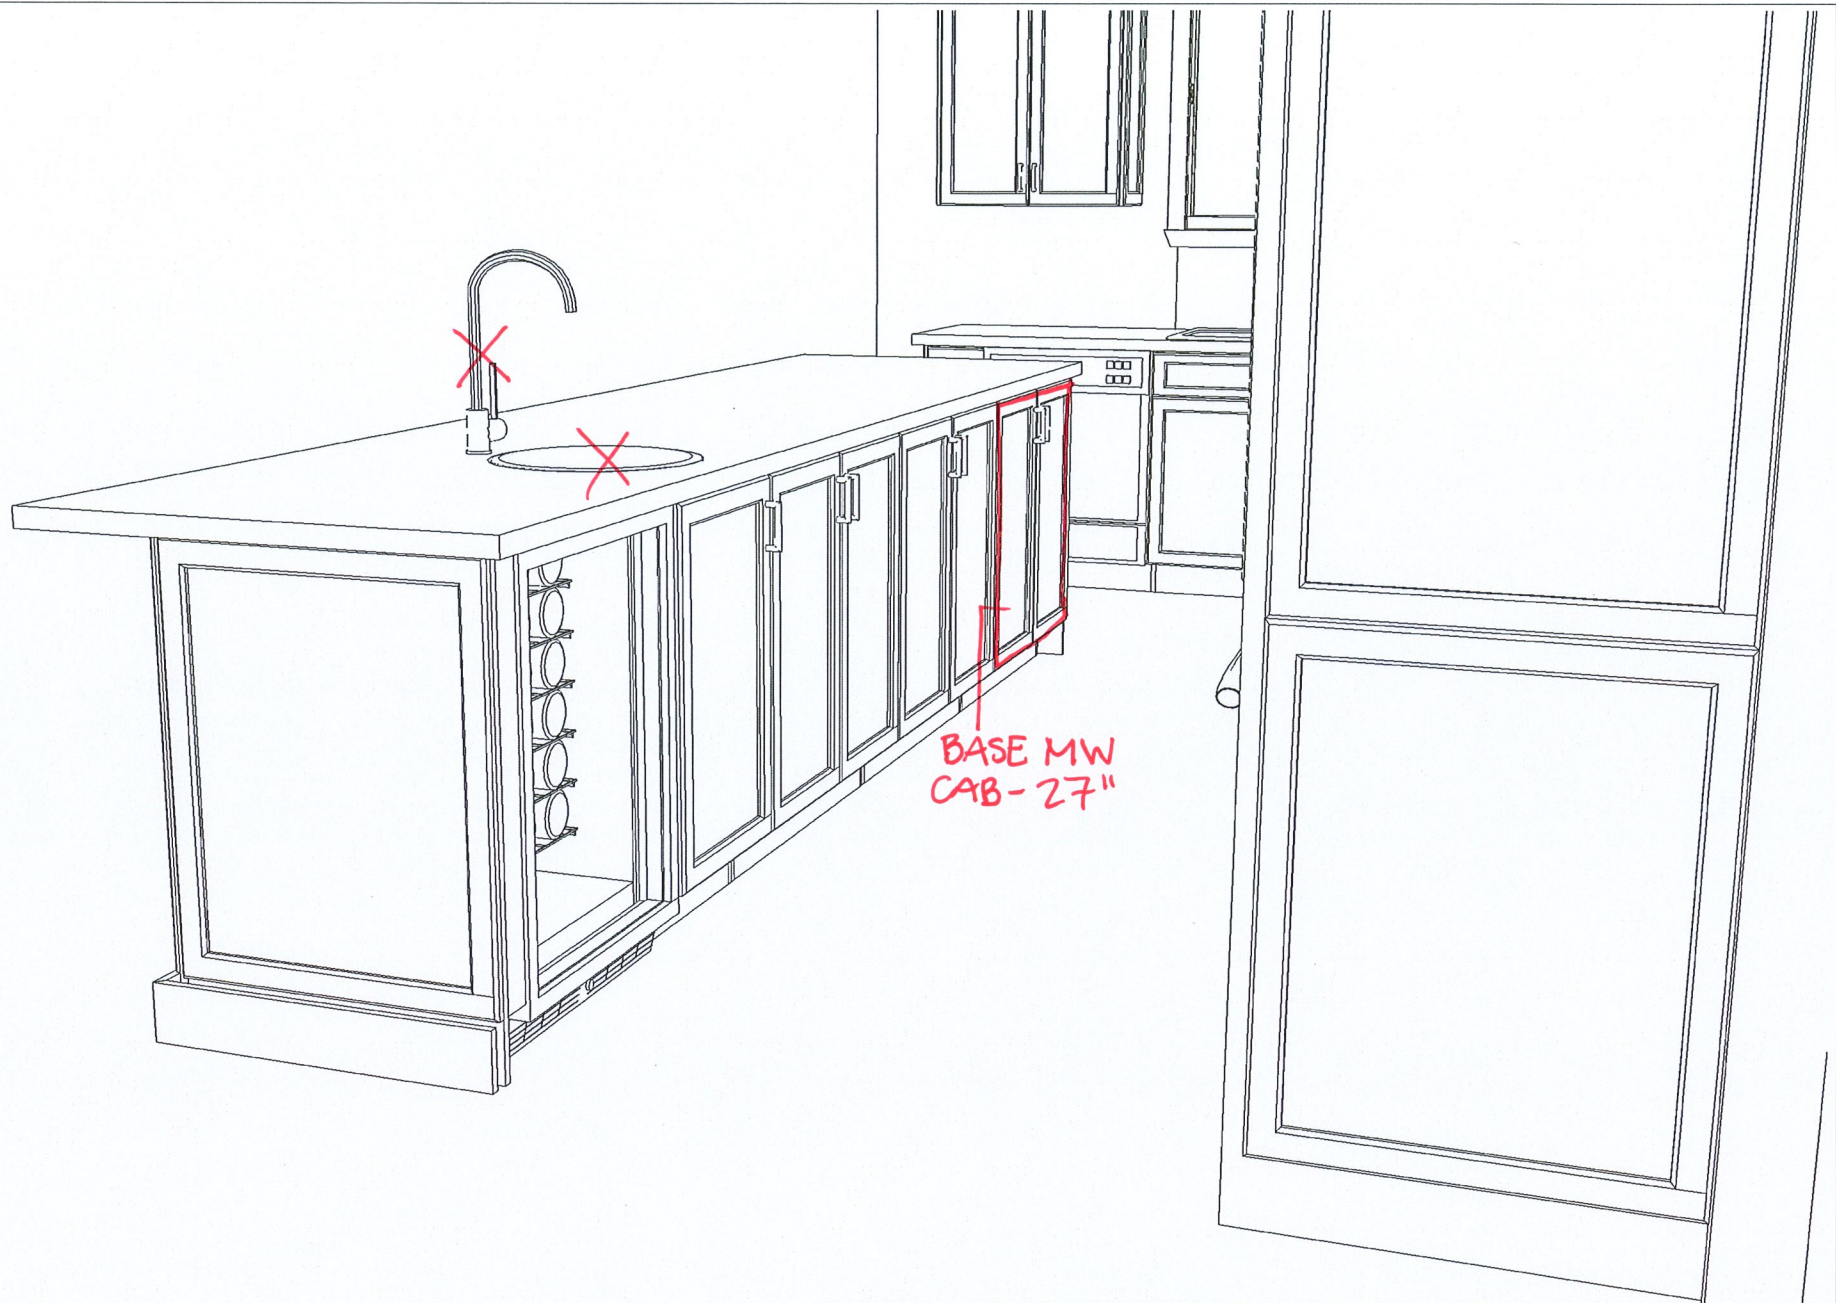

Note: This drawing is an artistic interpretation of the general appearance of the design. It is not meant to be an exact rendition.

SPECTRUM KITCHEN and BATH
DESIGN


DCR #7 Diamnondview Estates 2- .kit



Designed: 2021-05-26
Printed: 2021-05-26

All

Drawing #: 1

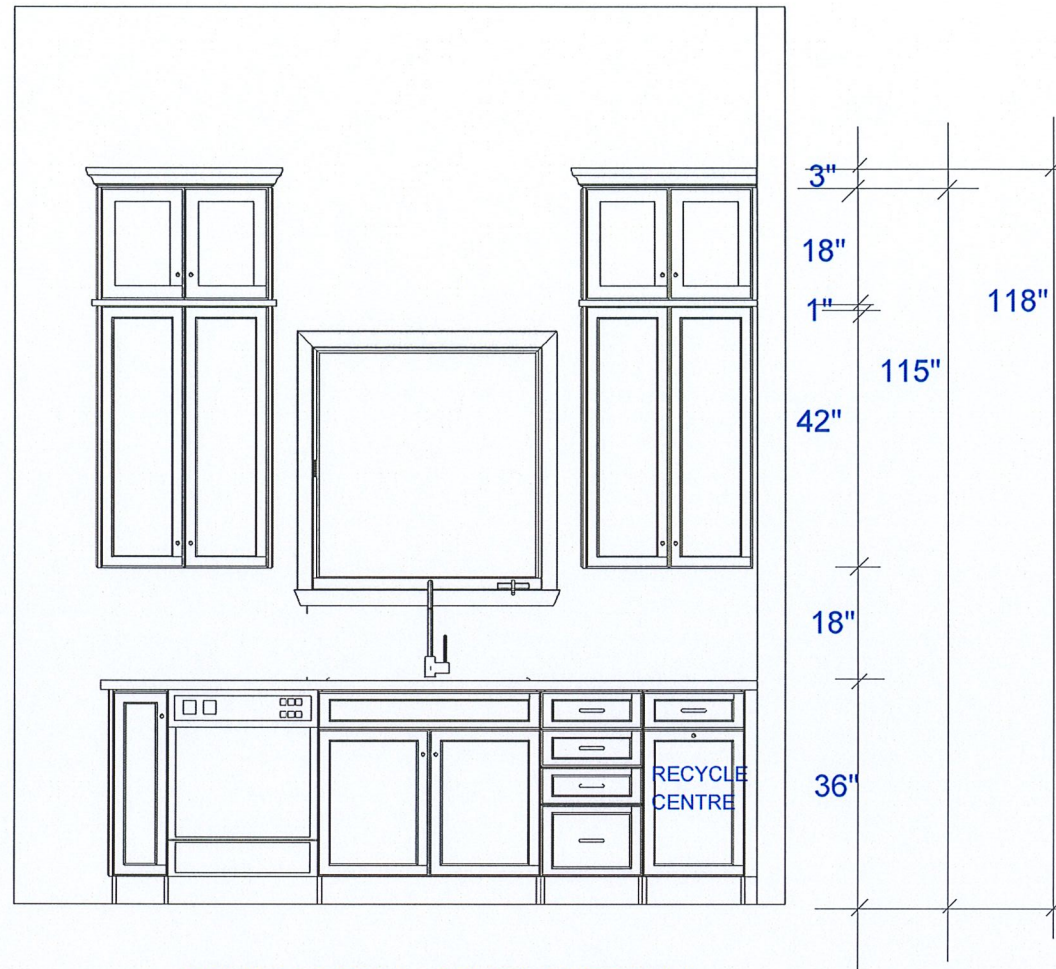

SINK WALL ELEVATION

CUSTOMER APPROVAL

I have reviewed these drawings and understand the details of the design and the CARTIER KITCHENS specifications.

Signature _____

Date _____

Note: This drawing is an artistic interpretation of the general appearance of the design. It is not meant to be an exact rendition.

SPECTRUM KITCHEN and BATH DESIGN


DCR #7 Diamnondview Estates 2- .kit



Designed: 2021-05-26
Printed: 2021-05-26

All

Drawing #: 1

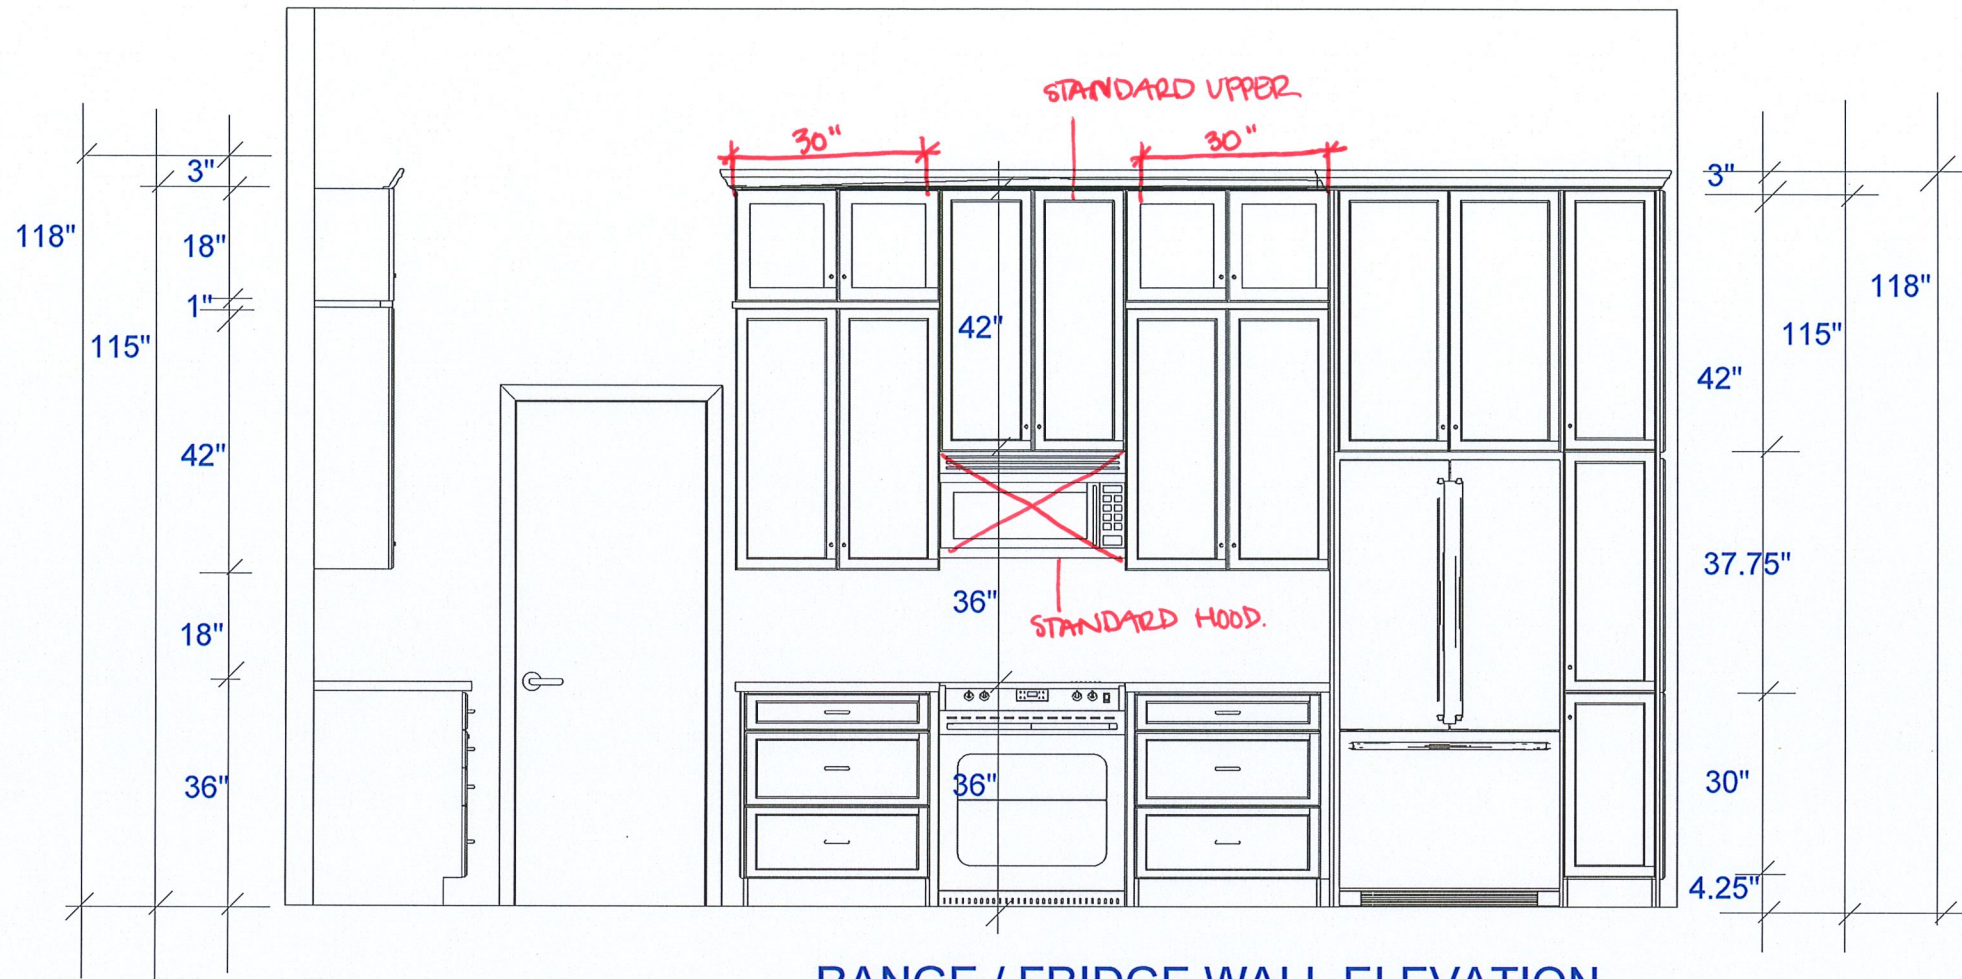

RANGE / FRIDGE WALL ELEVATION

CUSTOMER APPROVAL

I have reviewed these drawings and understand the details of the design and the CARTIER KITCHENS specifications.

Signature _____

Date _____

Note: This drawing is an artistic interpretation of the general appearance of the design. It is not meant to be an exact rendition.

SPECTRUM KITCHEN and BATH DESIGN

DCR #7 Diamnondview Estates 2- .kit




Designed: 2021-05-26
Printed: 2021-05-26


All

Drawing #: 1

VANITIES

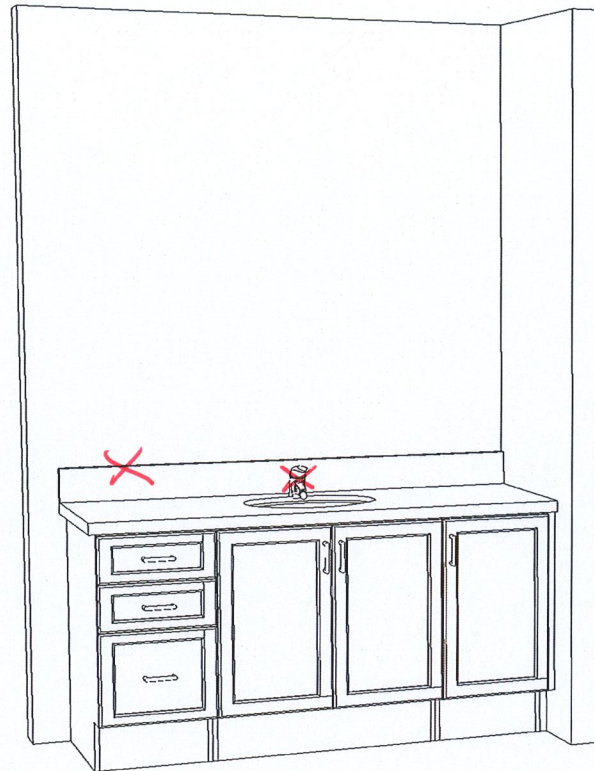

MAIN BATH VANITY

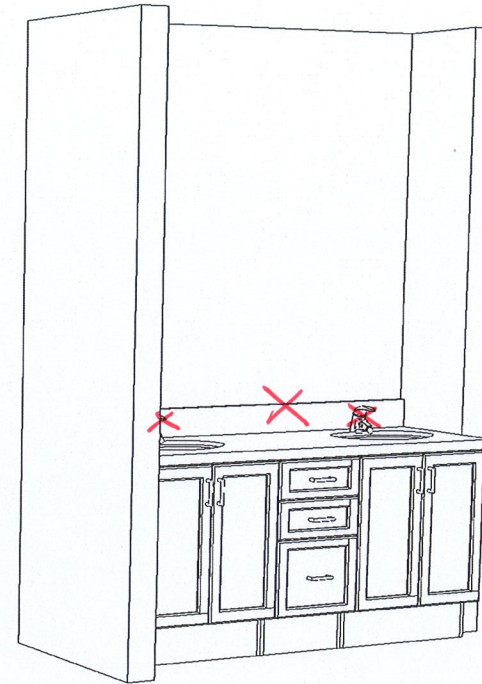

MASTER ENSUITE VANITY

CUSTOMER APPROVAL

I have reviewed these drawings and understand the details of the design and the CARTIER KITCHENS specifications.

Signature _____

Date _____

Note: This drawing is an artistic interpretation of the general appearance of the design. It is not meant to be an exact rendition.

SPECTRUM KITCHEN and BATH
DESIGN

DCR #7 Diamnondview Estates 2- .kit



Designed: 2021-05-26
Printed: 2021-05-26

All

Drawing #: 1