


ENSUITE LAYOUT
REVISED AND WINDOW
REDUCED IN SIZE

BEDROOM 2
WINDOWS REVISED




Structural Review Only.

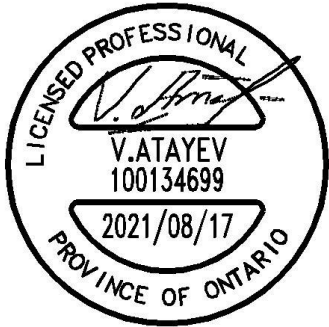

1 PARTIAL GROUND FLOOR PLAN
1 scale: 3/16"=1'-0"

TO BE READ IN CONJUNCTION WITH MASTER FOOTPRINTED PLANS
REVIEWED FOR MARKED CHANGE ONLY

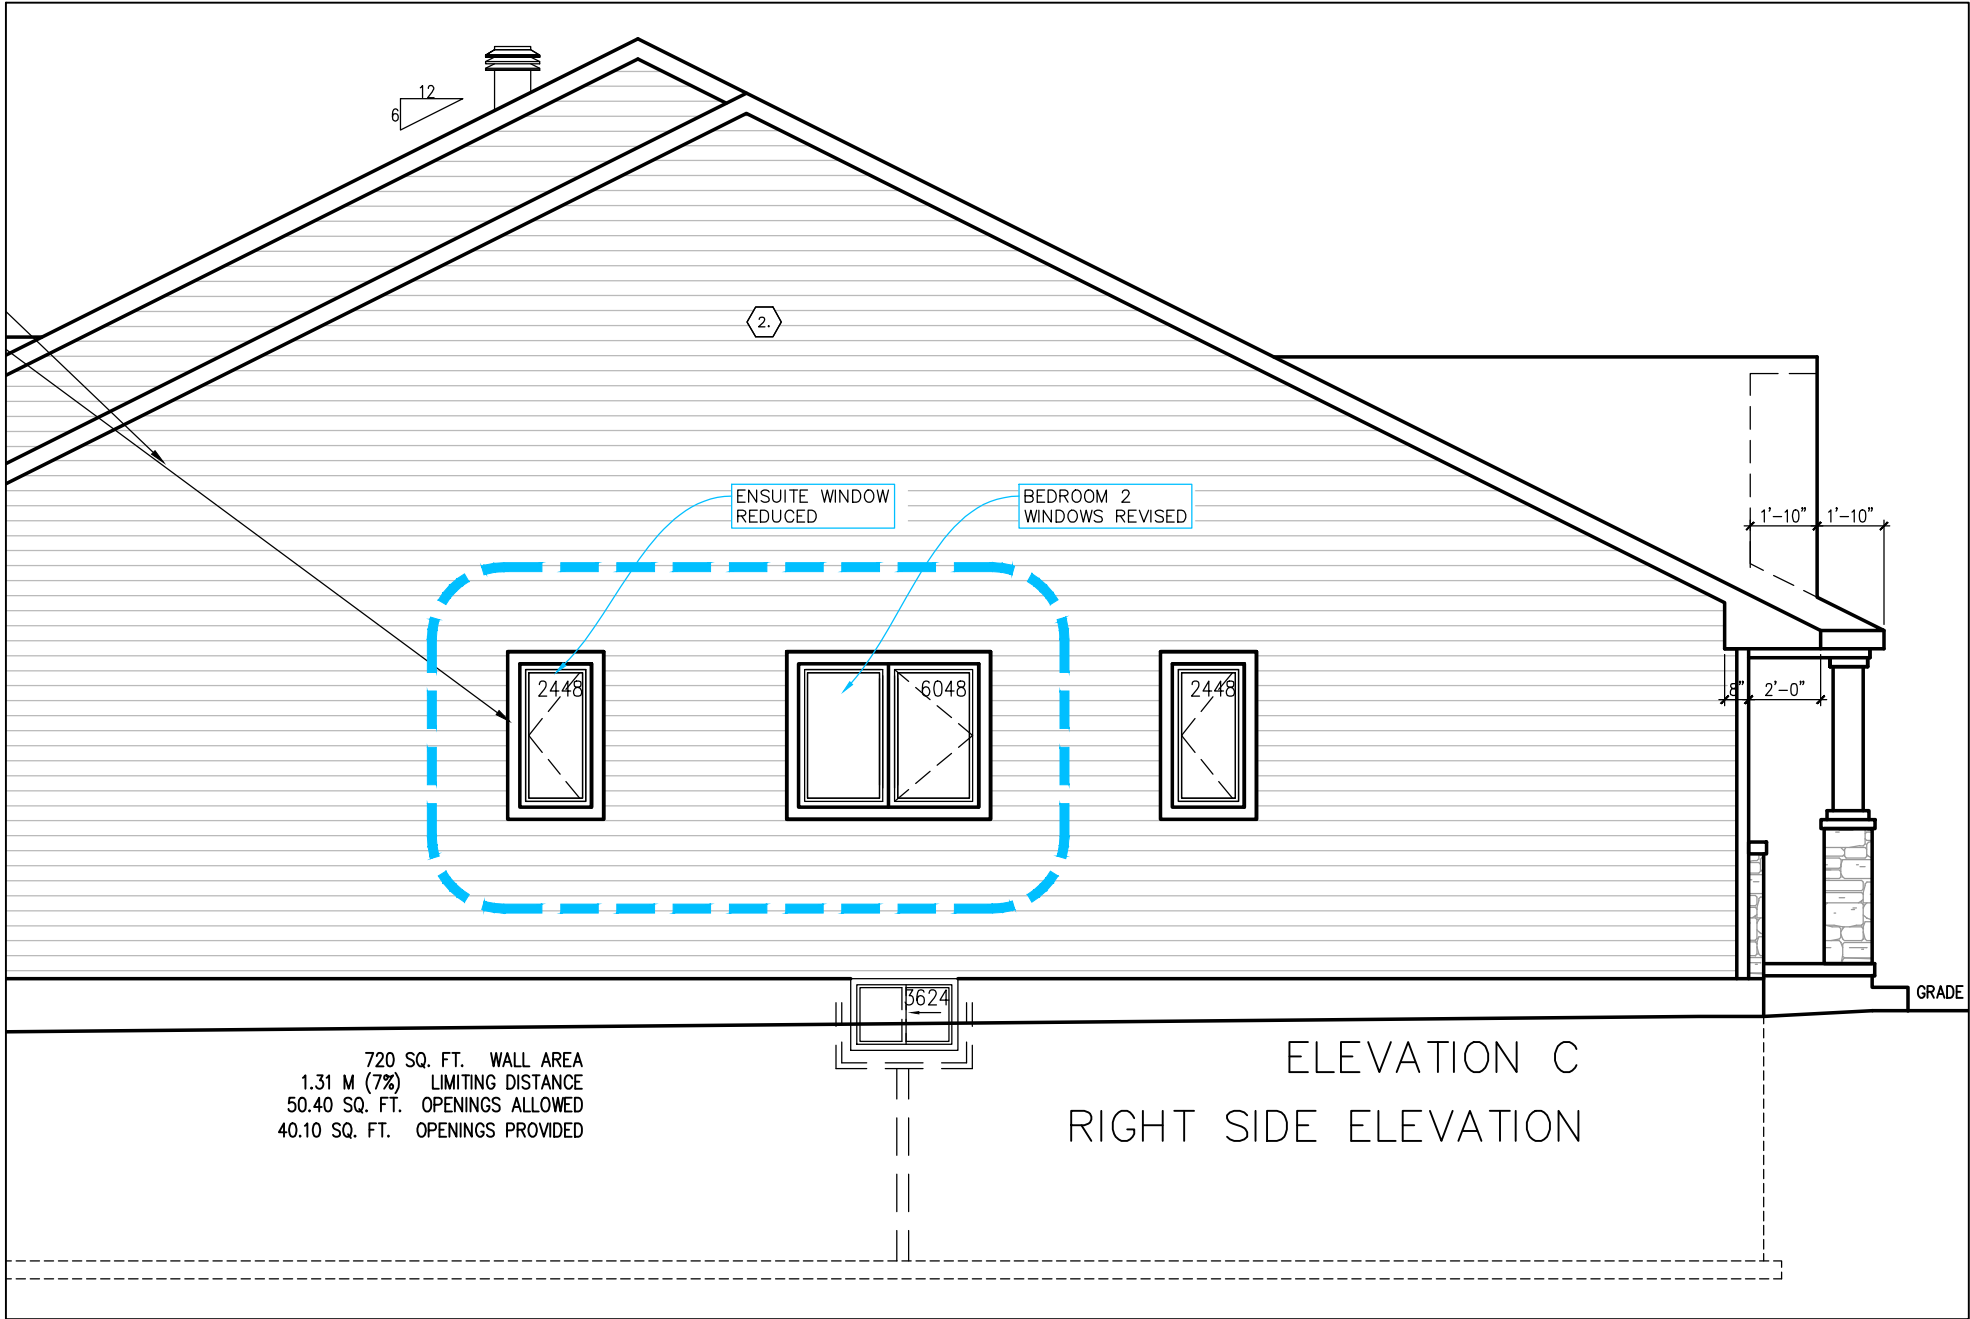

720 SQ. FT. WALL AREA
1.31 M (7%) LIMITING DISTANCE
50.40 SQ. FT. OPENINGS ALLOWED
40.10 SQ. FT. OPENINGS PROVIDED

ELEVATION C
RIGHT SIDE ELEVATION

2 PARTIAL SIDE ELEVATION
1 scale: 3/16"=1'-0"



ELD - 2018
NEW ESTATES PH2
LOT NUMBER: 14
CIVIC ADDRESS:
1955 CESSNA PRIVATE

2	ENGINEER MARKUPS APPLIED	XX/XX/XX	CB
1	REVISED WINDOWS ENSUITE, KITCHEN, BEDROOM 2	12/08/21	CB
No.	Description	dd/mm/yy	By
REVISIONS			

footprint:	B-24
drawn by:	SD
date:	SEP/12
scale:	3/16"=1'-0"
sheet no:	1
	1