

Furn GMEC961004CNA
x5 12"x23 1/2" CAE & 63" Plenum

Linda Mcparlan
24379

Date	Description
200603.1AR Annapolis 509 S2 Lot 1-35 DV	
APL-1-35-@-4021 - Phoenix DiamondView 2020	
2020 Rudy AsPerLot	

City of Ottawa
Building Services Branch

REVIEWED
By rossgr1 at 12:37 pm, Sep 02, 2021

Building Code Reviewed
[Signature]
Signature

WINDOW SIZE
INCREASE

NOTE:
ALL LVL'S SUPPORTING FLOOR LOADS ARE FLUSH,
UNLESS NOTED OTHERWISE AND TO BE SPECIFIED
BY THE FLOOR TRUSS MANUFACTURER, SEE
MANUF. LAYOUT.

**REQUIRED FOR WINDOWS OVER 48" WID.
ADD 2-15M BAR AT EACH FACE, AT 3"
BELOW WINDOW SILL AND EXTEND BAR
2'-0" BEYOND WINDOW OPENING EACH SIDE
& 2-15M VERTICAL BARS EACH SIDE

3"x3"x0.188" HSS (C/W WEB
STIFFENERS IN BEAM ABOVE)
OVER 48x48x12" POURING
CONC. FTG. C/W 5-15M B.E.W.

**REQUIRED FOR BASEMENT WINDOWS
OVER 48" WIDE**
ADD 2-15M BAR AT EACH FACE, AT 3"
BELOW WINDOW SILL AND EXTEND B.
2'-0" BEYOND WINDOW OPENING EACH
SIDE & 2-15M VERTICAL BARS EACH SIDE

CHECK TO 4" BELOW FIN. GR.
@ DOORS FOR FLOOR
JOG REMOVED FROM
FRONT WALL

BASEMENT FLOOR PLAN EL. A.

ANNAPOLIS-2019-A.B.E.F

200603.1AR June 2020 HRV Simp Annapolis 509 Phoenix Basement

1.64= 1"

1"= 49.1723169

Furn GMEC961004CNA
x5 12"x23 1/4" CAE & 63" Plenum

Linda Mcpartlen
24379


Date	Description
200603.1AR	Annapolis 509 S2 Lot 1-35 DV
APL-1-35-@-4021	- Phoenix DiamondView 2020
2020	Rudy AsPerLot

City of Ottawa
Building Services Branch

REVIEWED
By rossgr1 at 12:37 pm, Sep 02, 2021

Building Code Reviewed

Signature

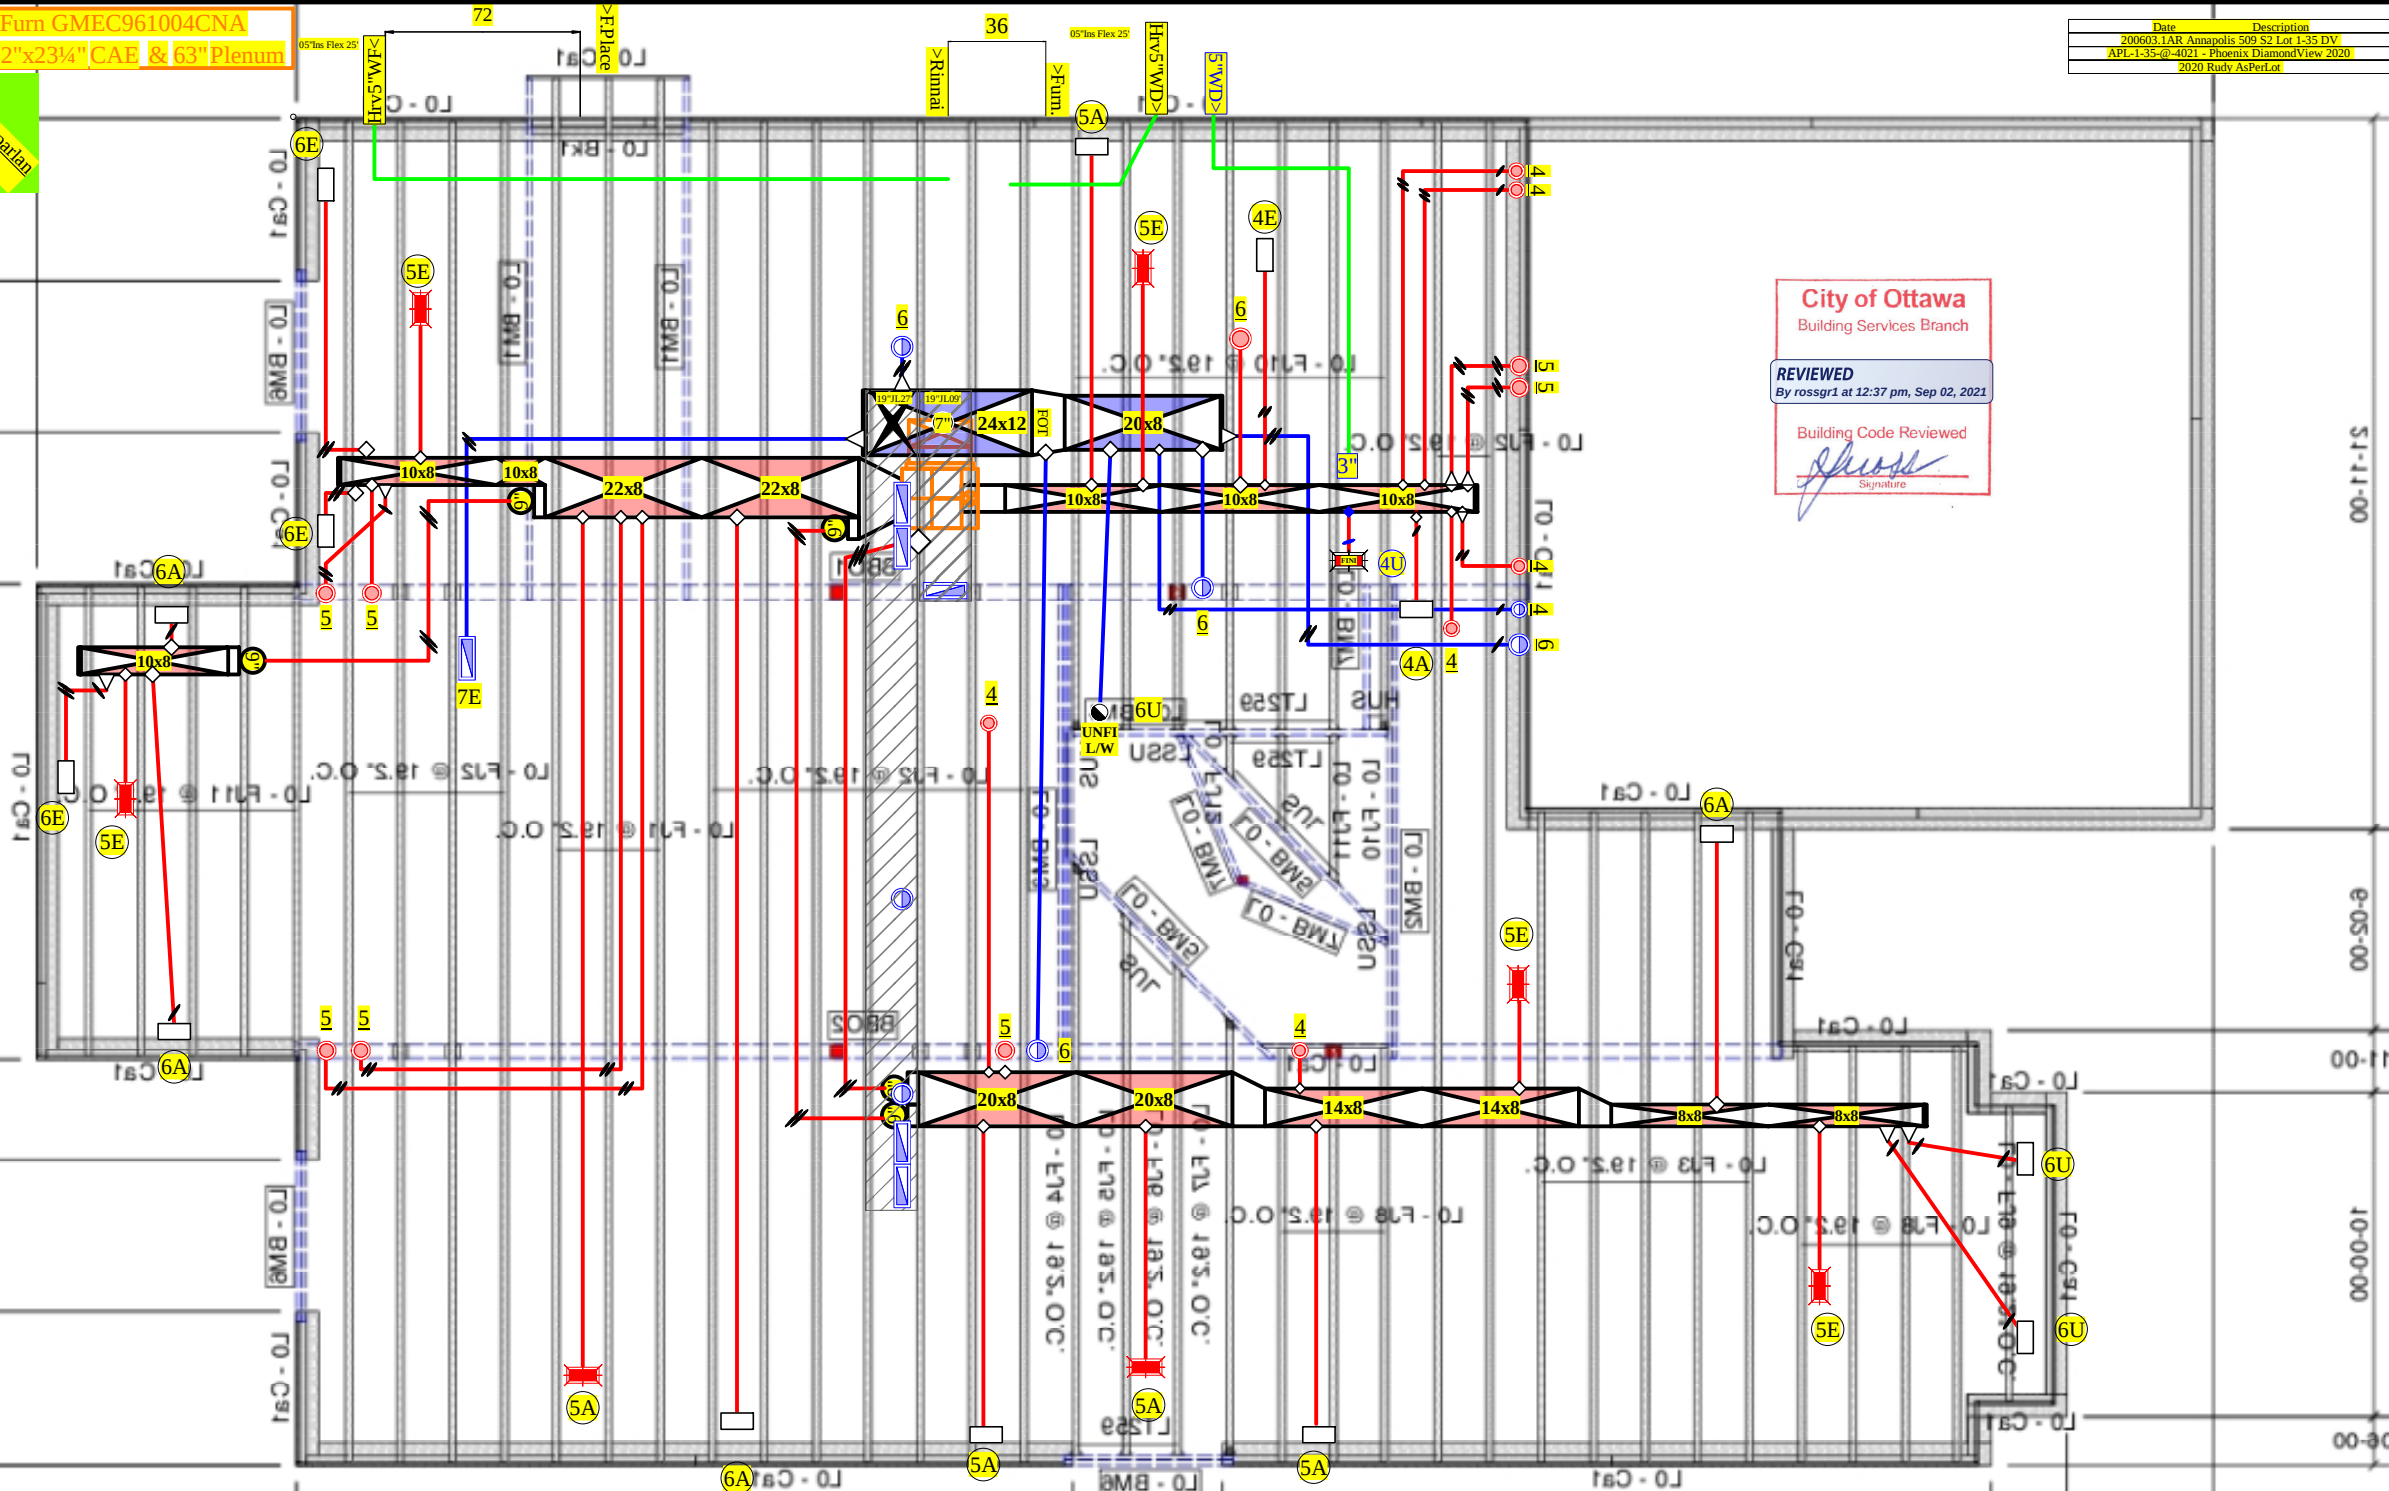


200603.1AR

 $1'' = 49.1723169$

Linda Mcparlan
24379

Date	Description
200603.1AR Annapolis 509 S2 Lot 1-35 DV	
APL-1-35-@-4021 - Phoenix DiamondView 2020	
2020 Rudy AsPerLot	

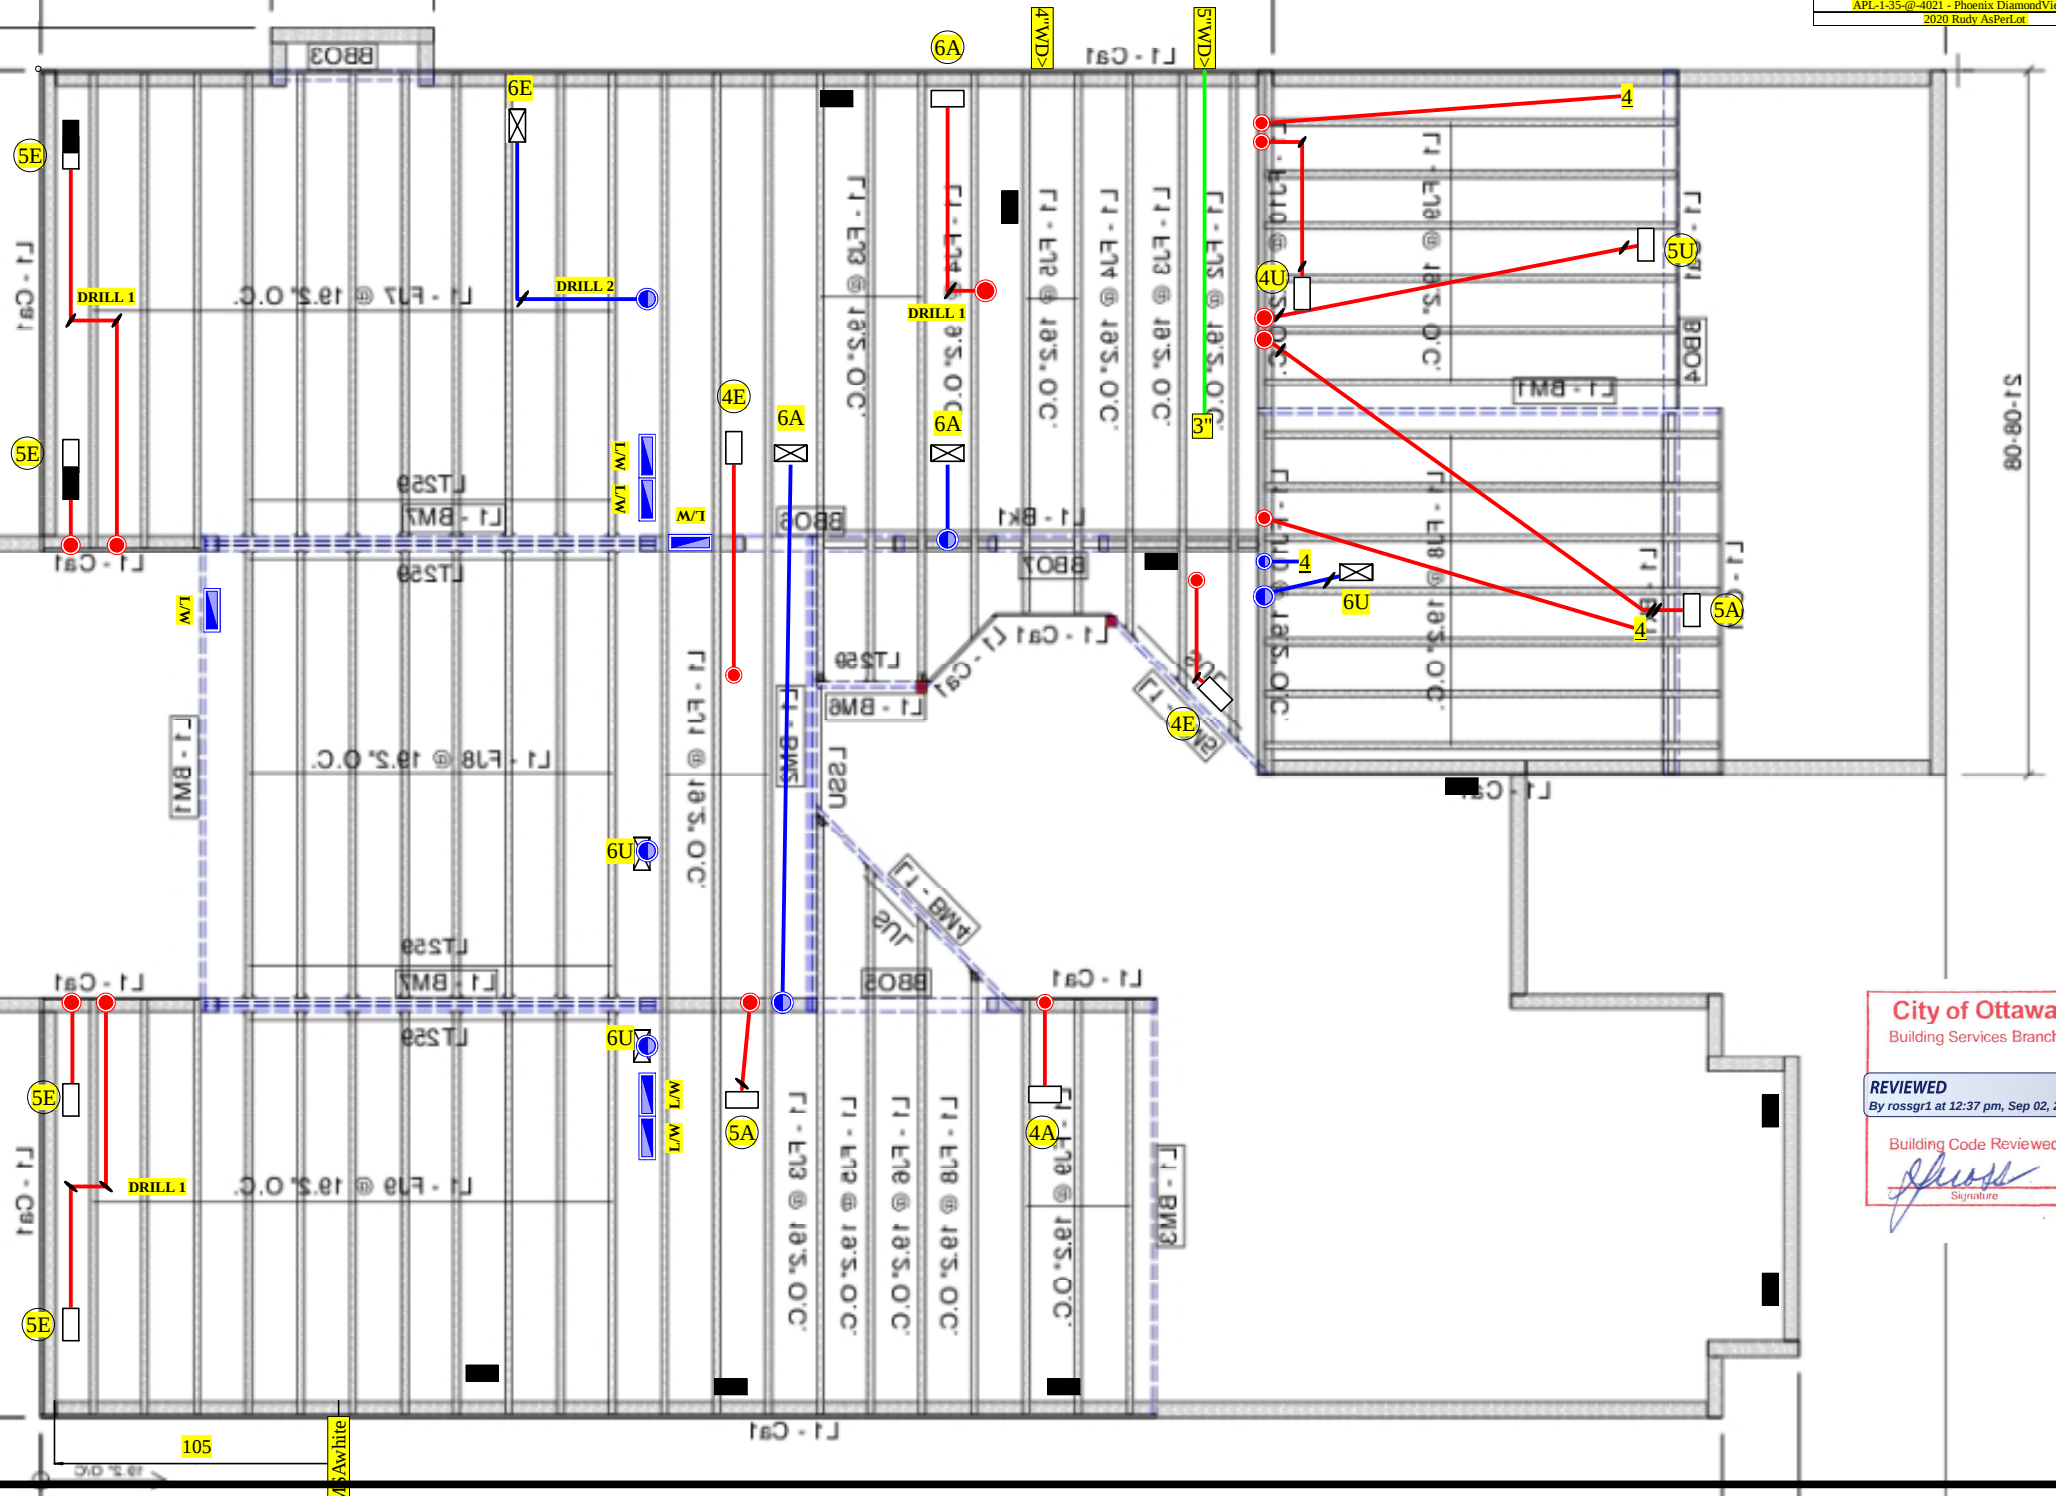


City of Ottawa
Building Services Branch

REVIEWED
By rossgr1 at 12:37 pm, Sep 02, 2021

Building Code Reviewed


Signature

Linda Mcparlan
24379

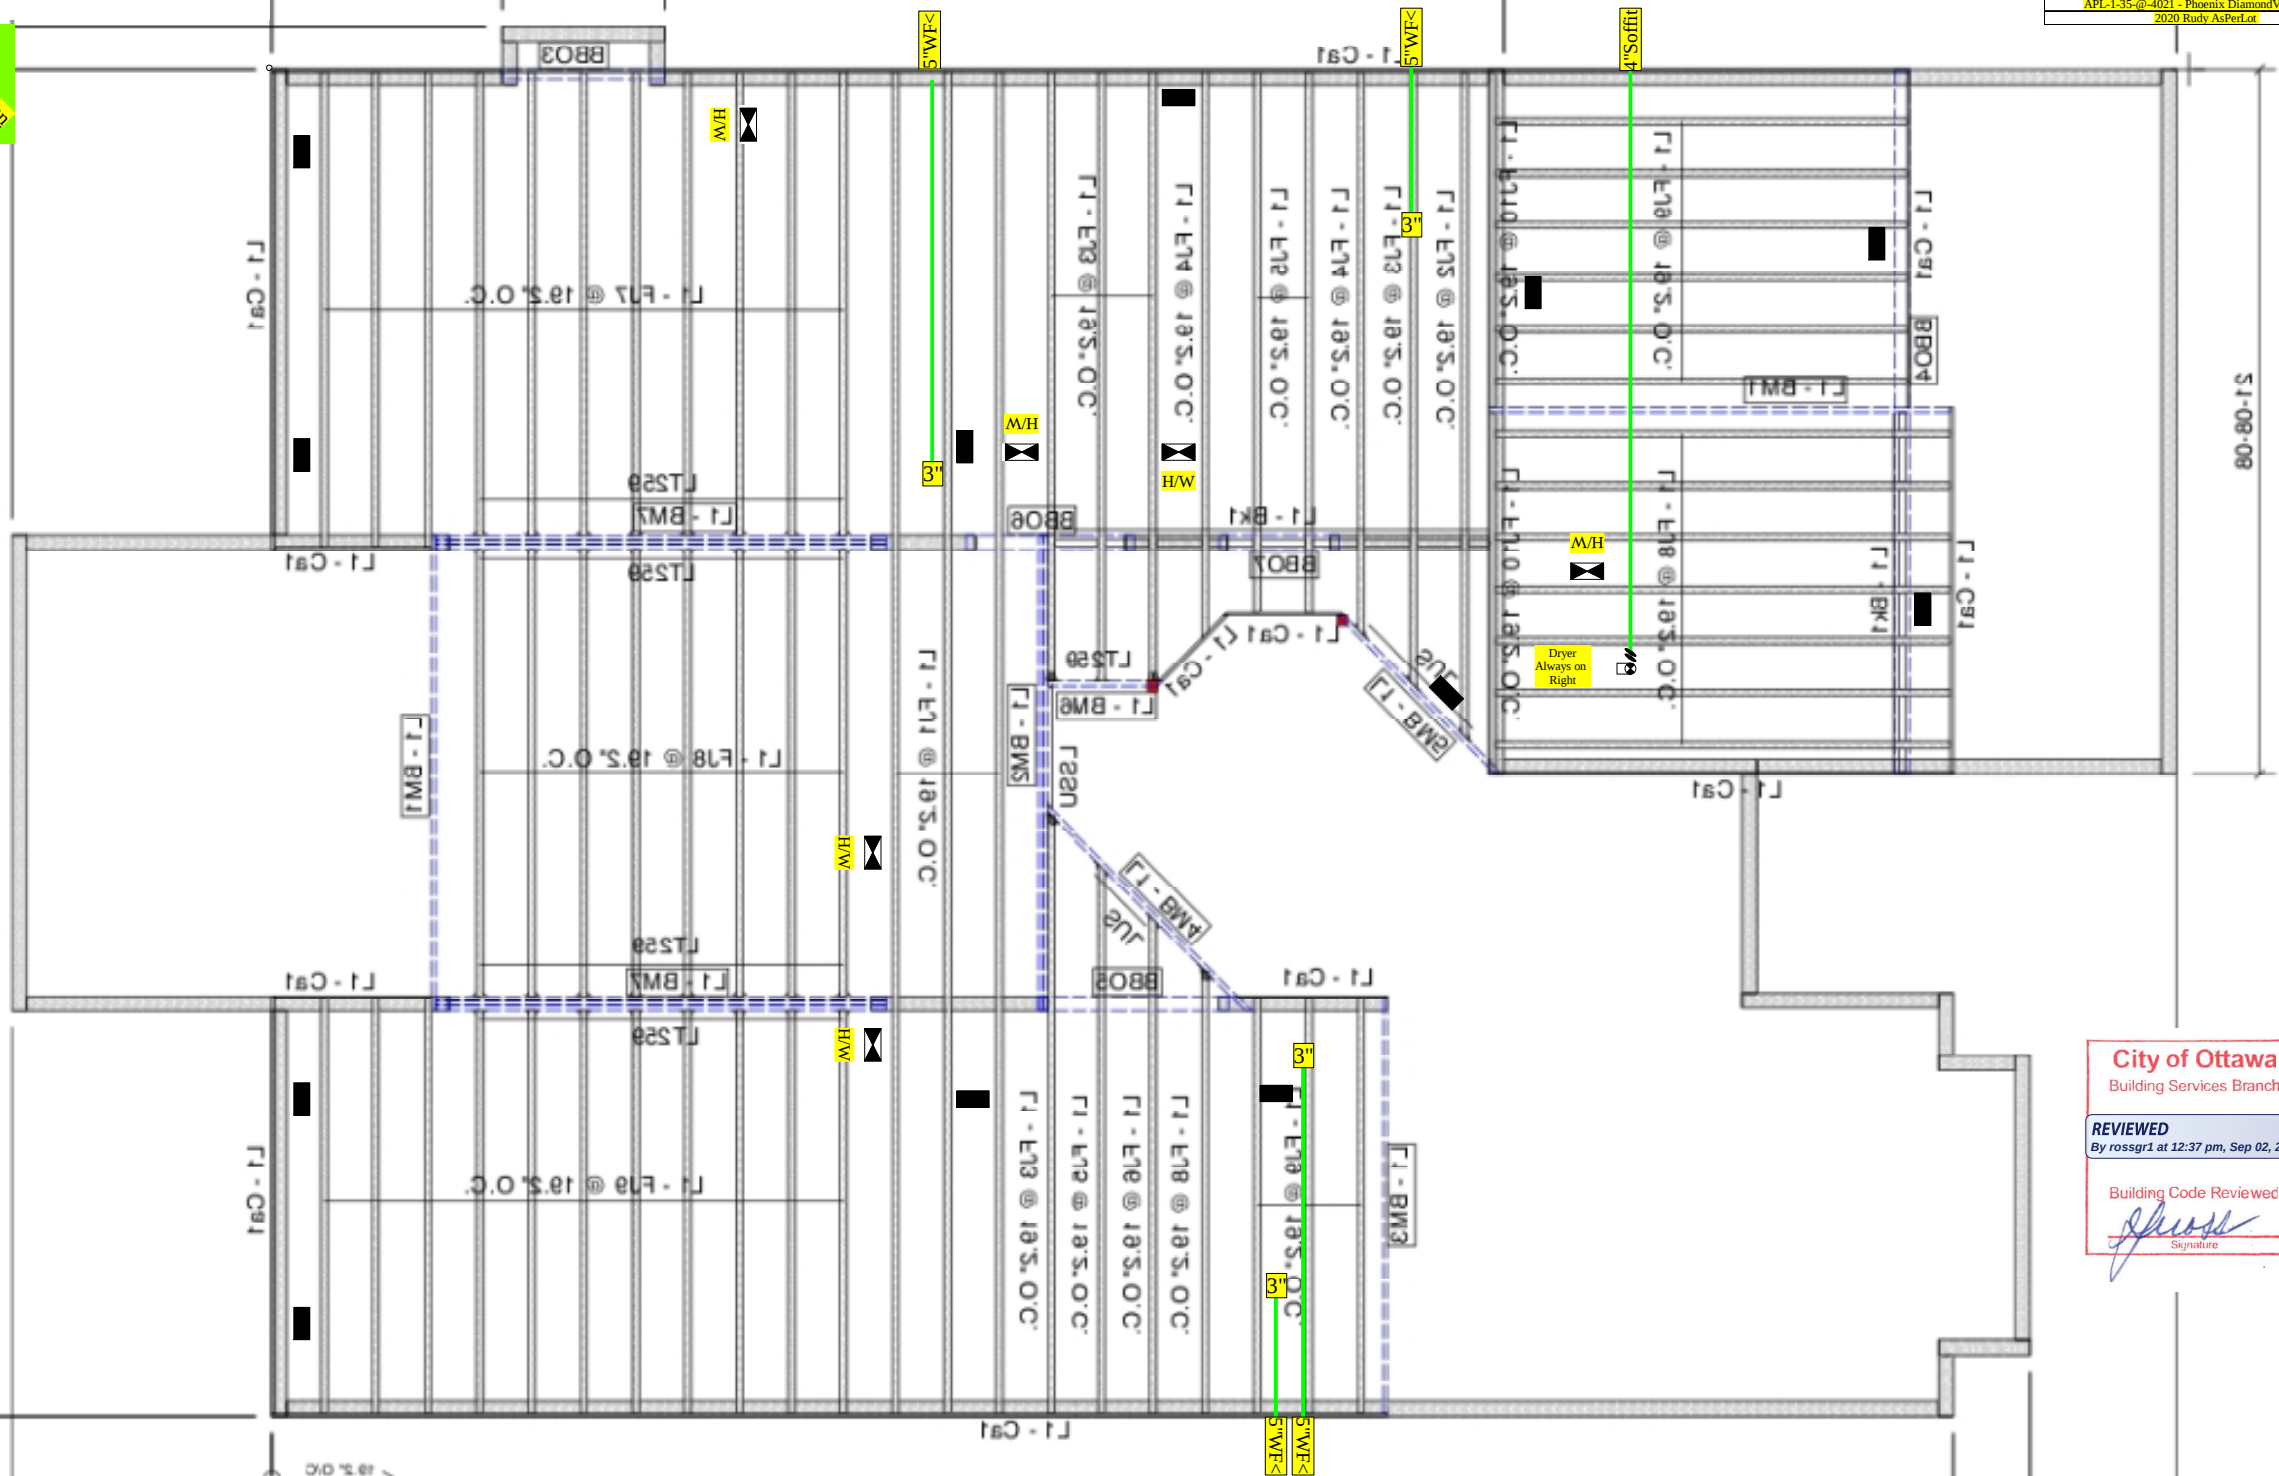


City of Ottawa
Building Services Branch

REVIEWED
By rossgr1 at 12:37 pm, Sep 02, 2021

Building Code Reviewed

Signature

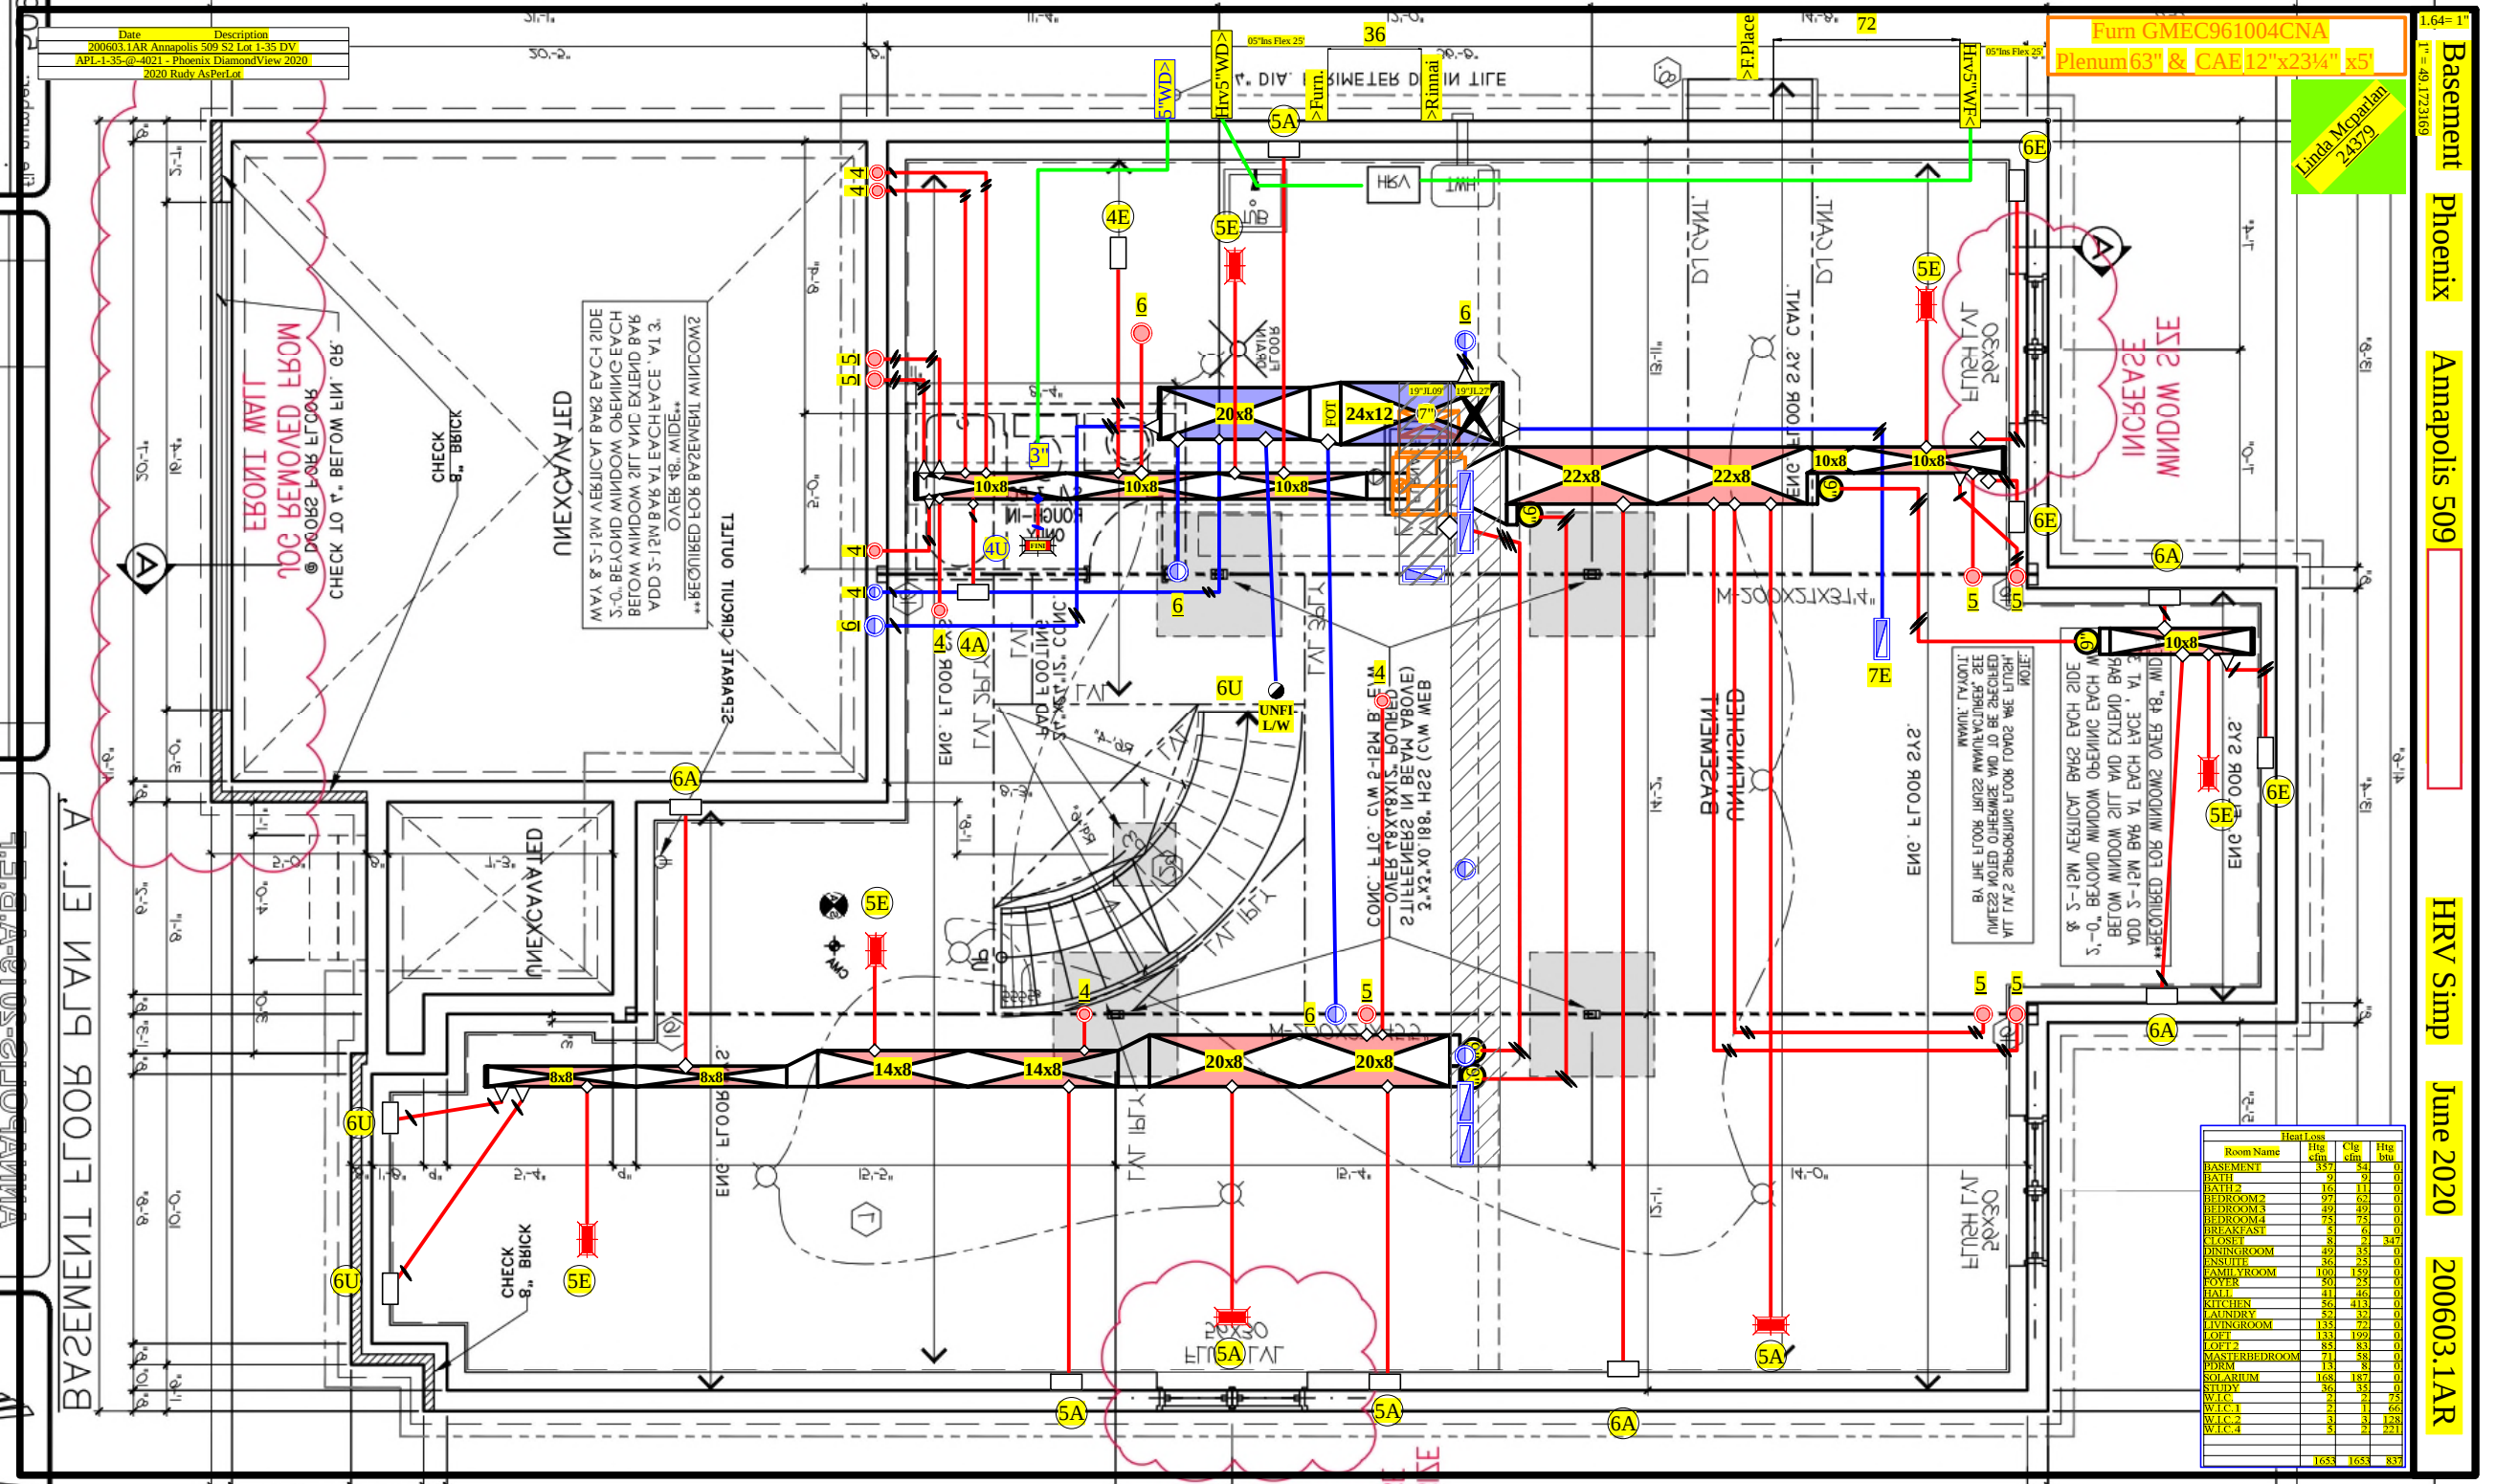


Date: 200603.1AR Annapolis 509 S2 Lot 1-35 DV
Description: APL-1-35-@-4021 - Phoenix DiamondView 2020
2020 Rudy AsperLot


Furn GMEC961004CNA
Plenum 63" & CAE 12"x23 3/4" x5

Linda Mcpartian
24379

Room Name	Heat Loss		Ctg	Htg
	Htg	Loss		
BASMENT	457	9	9	9
BATH	9	9	9	9
BATH2	9	9	9	9
BEDROOM2	297	60	60	60
BEDROOM3	49	49	49	49
BEDROOM4	75	75	75	75
BLK/CLASH	133	133	133	133
CLOSET	133	133	133	133
DININGROOM	159	23	23	23
ENTR	159	23	23	23
FAMILY ROOM	109	159	159	159
FOYER	50	50	50	50
HALL	133	133	133	133
KITCHEN	56	413	413	413
LAUNDRY	52	33	33	33
LIVINGROOM	133	75	75	75
LOFT	133	199	199	199
LOFT2	85	83	83	83
EASTERBEDROOM	12	8	8	8
PORCH	12	8	8	8
SOLARIUM	168	187	187	187
STUDY	46	45	45	45
W.C.1	46	45	45	45
W.C.2	46	45	45	45
W.C.3	46	45	45	45
W.C.4	46	45	45	45
	1653	1653	83	83

ЭЛПИСЬ ОН
ТУОНУОНТ
ЭОМЛИЦ ТАЛТ

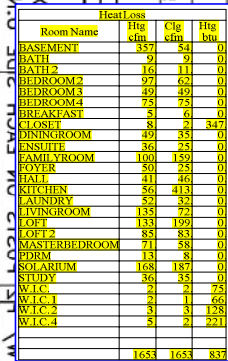

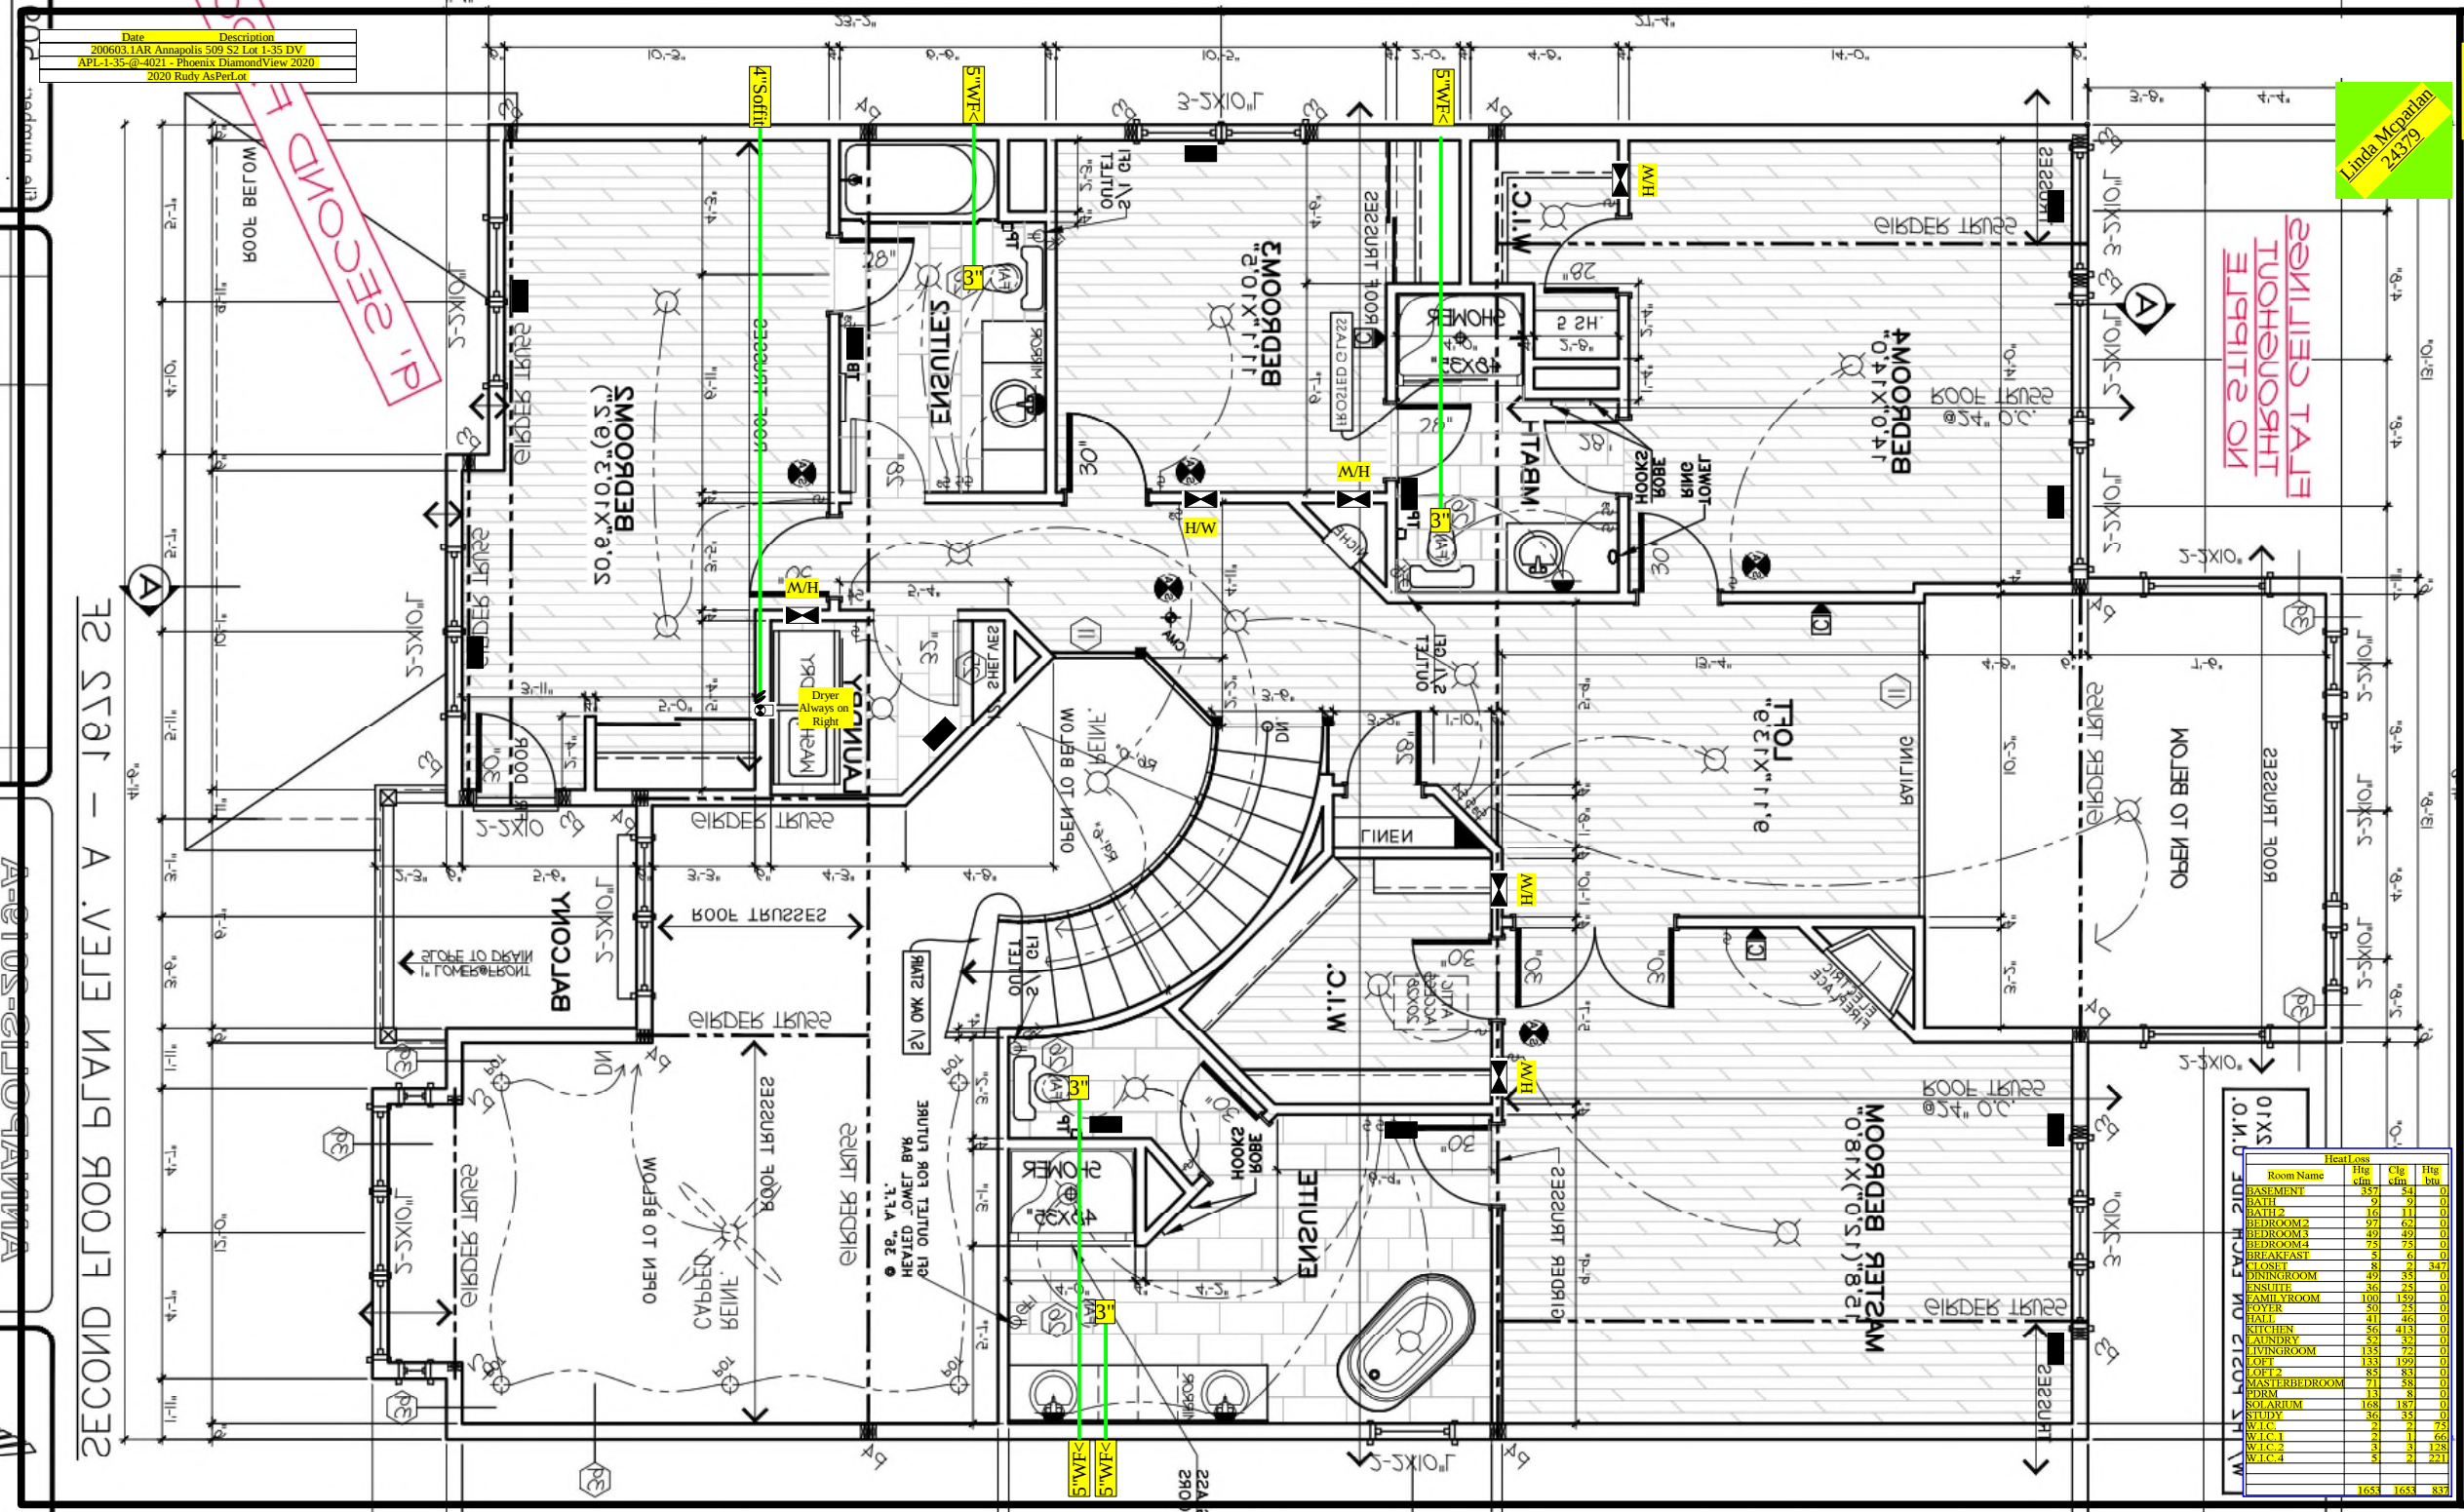


Date	Description
200603.1AR	Annapolis 509 S2 Lot 1-35 DV
APL-1-35-@-4021	- Phoenix DiamondView 2020
2020	Rudy AsPerLot

Linda McPartlan
24379

PHENIX TALK
TWOHOUR
APRIL 2011

Room Name	Heat Loss	Heat Gain
BASMENT	185	185
BATH	185	185
BATH2	185	185
BEDROOM1	185	185
BEDROOM2	185	185
BEDROOM3	185	185
BEDROOM100	185	185

Date	Description
200603.1AR Annapolis 509 S2 Lot 1-35 DV	
APL-1-35-@-4021 - Phoenix DiamondView 2020	
2020 Rudy AsPerLot	

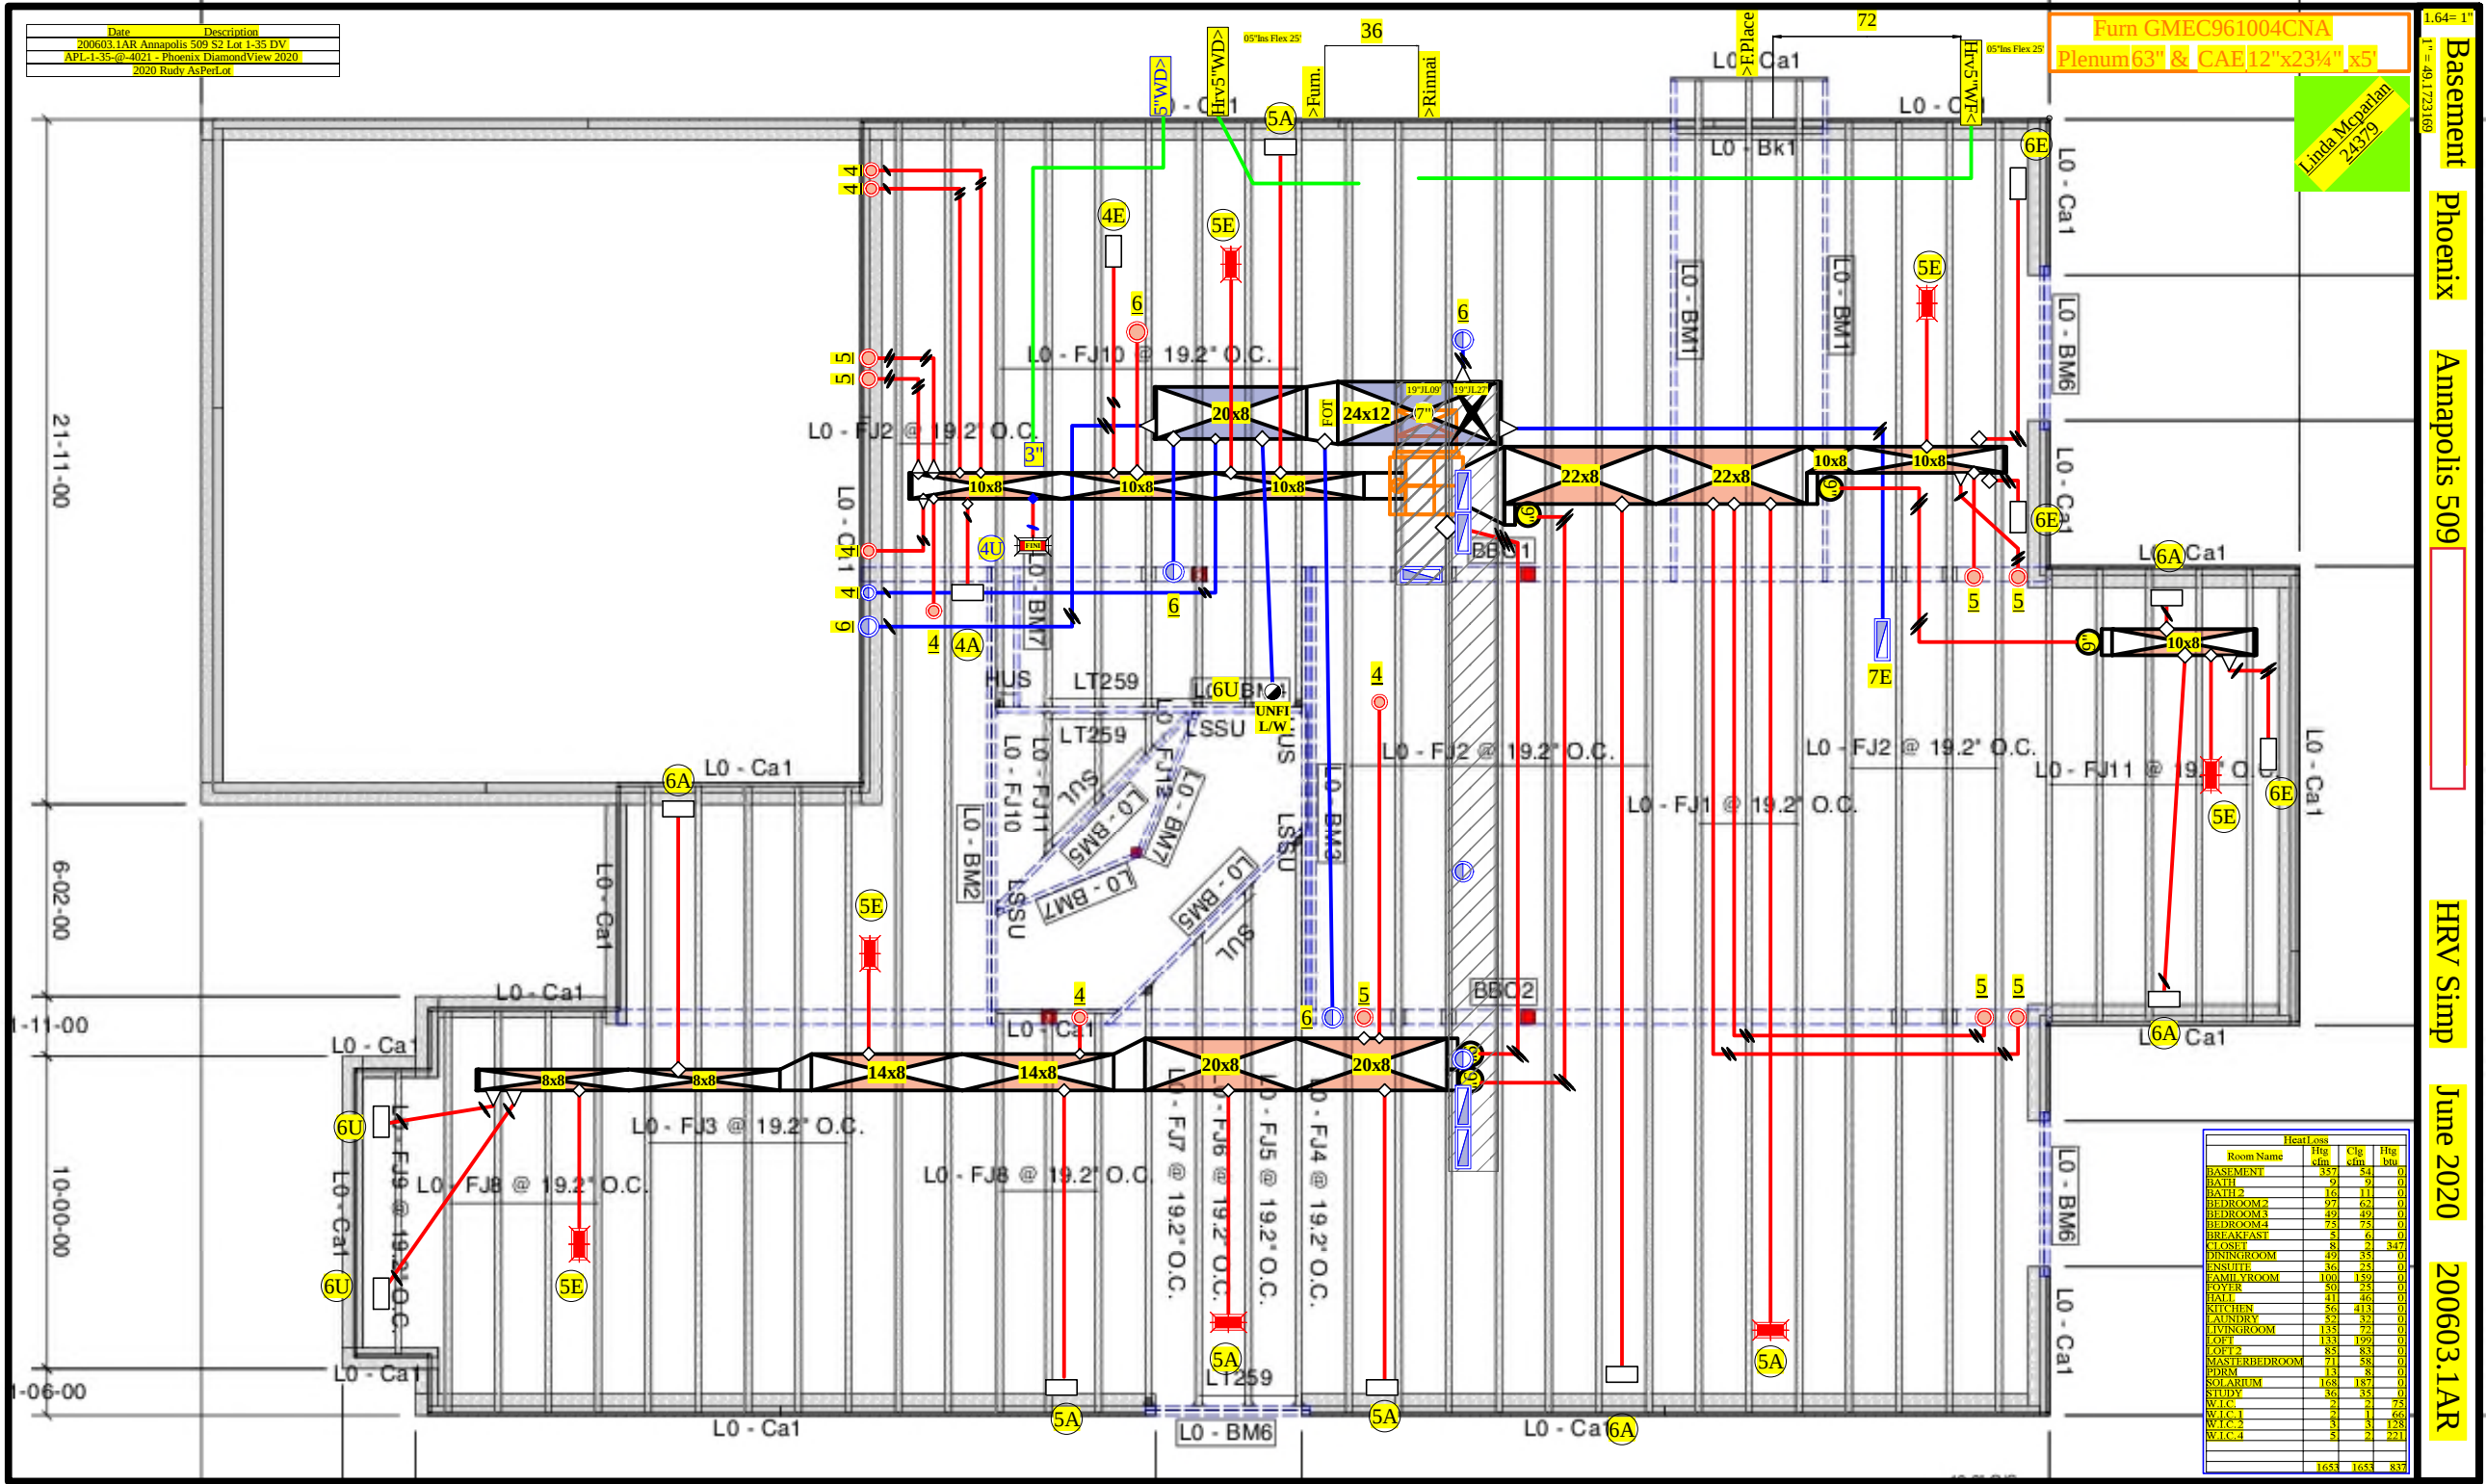

Furn GMEC961004CNA
Plenum 63\" & CAE 12"x23 1/4\" k5

Linda McParlan
24379

Room Name	Heat Loss		
	Htg sq ft	Ctg sq ft	Htg sq ft
BASMENT	157	9	9
BATH	9	9	9
BATH2	16	11	11
BEDROOM2	97	62	62
BEDROOM3	49	49	49
BEDROOM4	75	75	75
BREAKFAST	5	5	5
CLOSET	8	8	8
DININGROOM	49	35	35
ENSUITE	36	23	23
FAMILYROOM	100	159	159
FOYER	50	28	28
HALL	41	46	46
KITCHEN	26	413	413
LAUNDRY	52	32	32
LIVINGROOM	133	72	72
LOFT	133	199	199
LOFT2	85	83	83
MASTERBEDROOM	71	58	58
PORCH	13	8	8
SOLARIUM	168	187	187
STUDY	86	35	35
TALC	2	2	2
W.C.1	3	3	3
W.C.2	3	3	3
W.C.3	3	3	3
W.C.4	3	3	3
	1655	1655	83

Date	Description
200603.1AR	Annapolis 509 S2 Lot 1-35 DV
APL-1-35-@-4021 -	Phoenix DiamondView 2020
2020	Rudv AsPerLot

2nd Floor
1" = 49.1723169
1.64= 1"

Phoenix


Annapolis 509

HRV Simp

June 2020

200603.1AR

Linda Mcparlan
24379

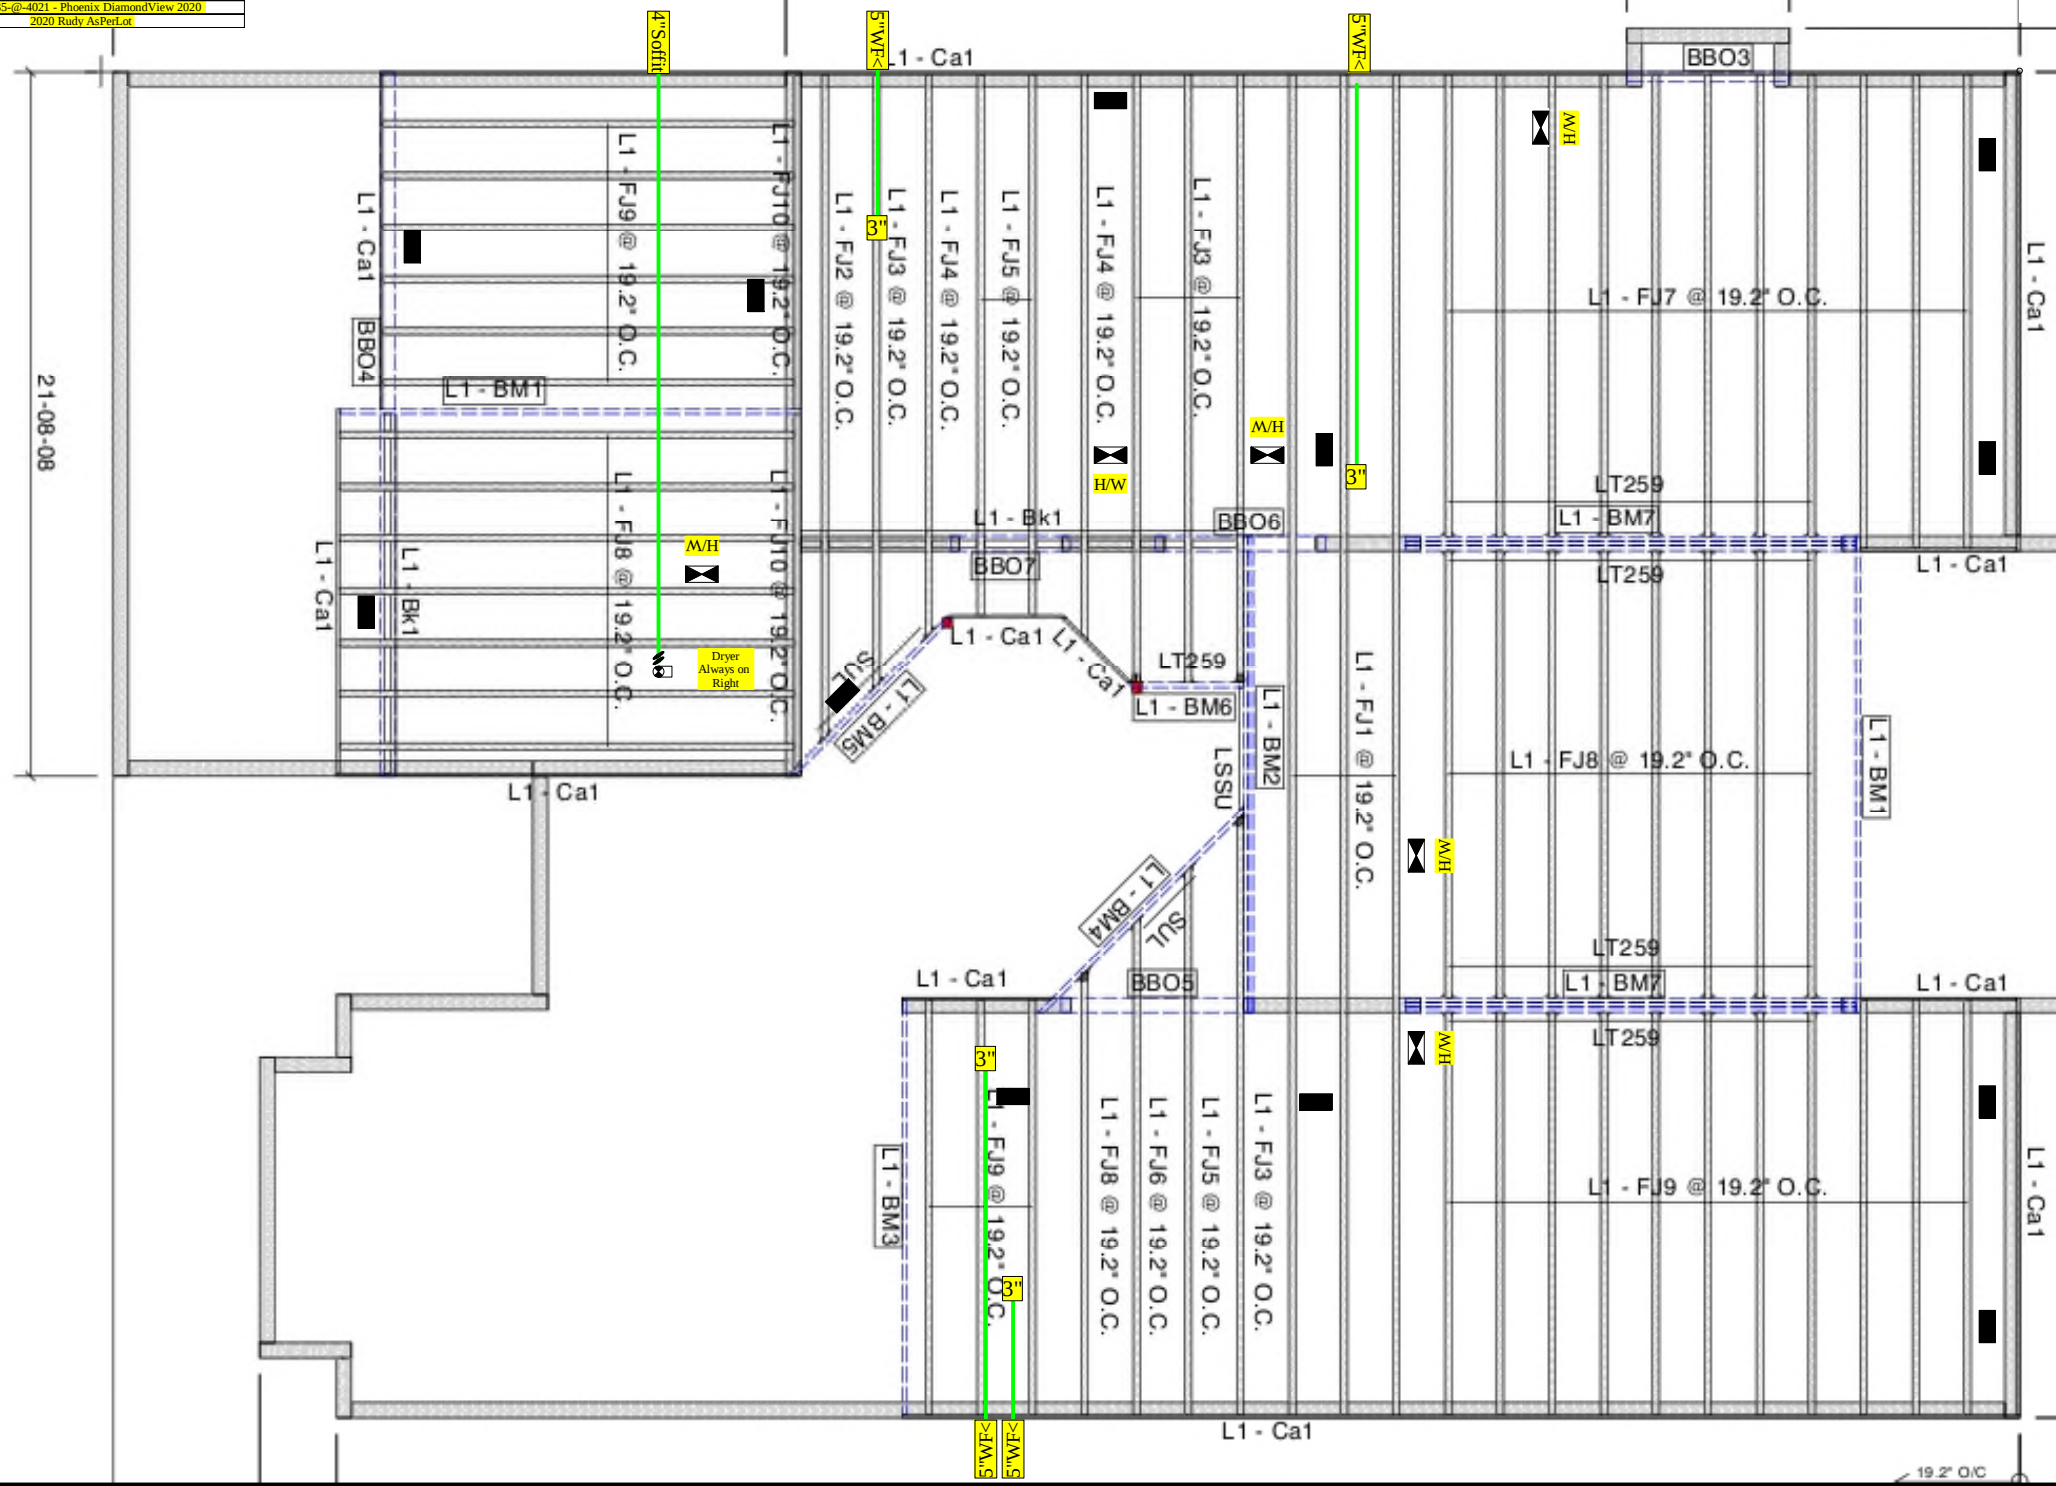

Room Name	Heat loss			
	Hea k(W)	Cla k(W)	Hig bitu	
BASMENT	357	84	0	
BATH-1	16	11	0	
BEDROOM-2	97	62	0	
BEDROOM-3	69	49	0	
BEDROOM-4	74	75	0	
BREAKFAST	8	6	0	
CLOSET	8	3	0	
DININGROOM	49	45	0	
ENTRANCE	366	129	0	
FAMILY ROOM	100	189	0	
KITCHEN	50	25	0	
LIVING	44	46	0	
LIVING-2	84	113	0	
LAUNDRY	52	32	0	
LIVINGROOM	139	72	0	
LIVING-2	131	199	0	
LOFT-1	85	83	0	
LOFT-2	7	88	0	
MASTER BEDROOM	113	8	0	
MECHANICAL	168	187	0	
STUDY	86	85	0	
STUDY-2	10	2	75	
W.C. 1	2	1	66	
W.C. 2	2	1	128	
W.C. 3	2	1	221	
TOTAL	1654	1663	837	