


DCR - PHOENIX HOMES

LOT #45
DIAMONDVIEW ESTATES 2
NEWINGTON - 5 BDRM
STANDARD KITCHEN

MOUNTING HEIGHT : 96

42" H. UPPER @ 18" ABOVE COUNTER
CROWN MOULDING
LIGHT VALANCE

- KITCHEN
CABINETS -
HARDWARE -
STANDARD WHITE INTERIOR
METAL DRAWER BOX
4 PCS - 5/8" KICK - FIN. BOTH ENDS
2 PCS - 90 DEG. CORNER MOULD
1 PCS - T-MOULD
5 PCS - FLAT MOULDING

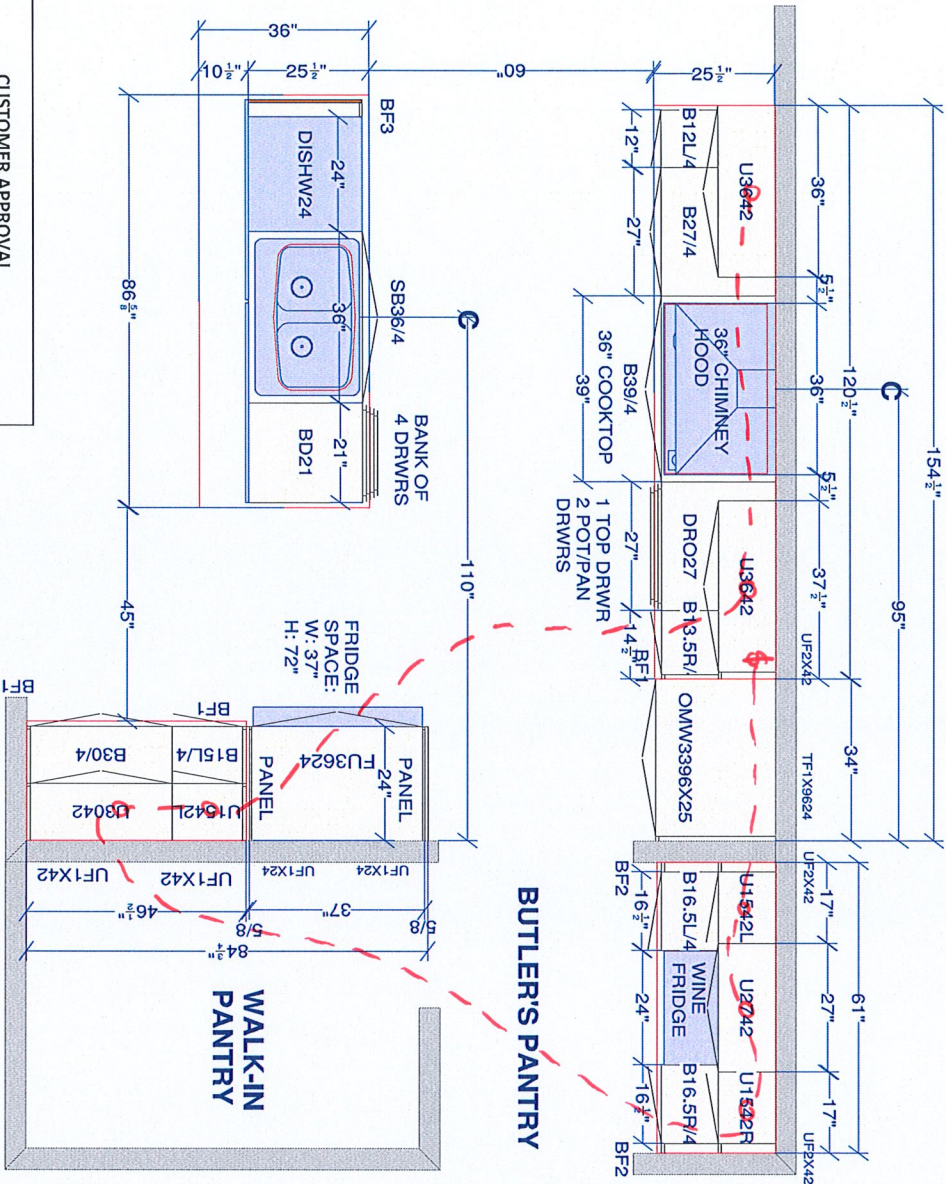

CUSTOMER APPROVAL

I have reviewed these drawings and understand the details of the design and the CARTIER KITCHENS specifications.

Signature _____

Date _____

All dimensions, size designations given are subject to verification on job site and adjustment to fit job conditions.



This is an original design and must not be released or copied unless applicable fee has been paid or job order placed.

SPECTRUM KITCHEN and BATH DESIGN




DRAWN BY: LORI DISAVERIO, B.I.D

DCR #45 - Diamondview Estates 2 - NEWINGTON - STD KITCHEN.kit

ALL

Drawing #: 1 | No Scale.

Designed: 2021-05-20
Printed: 2021-05-20

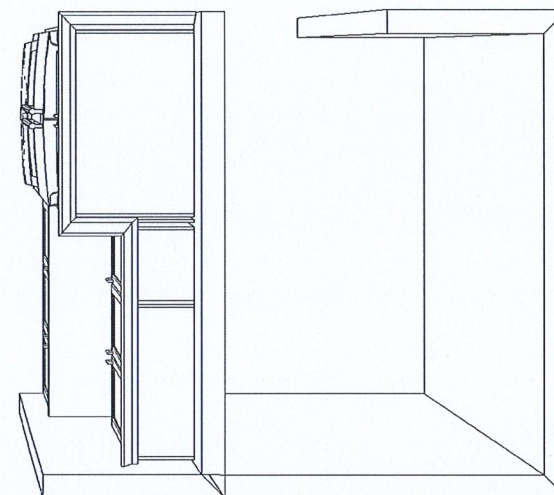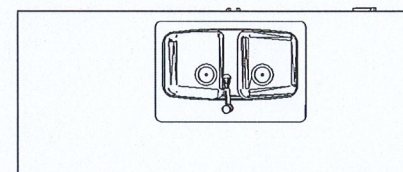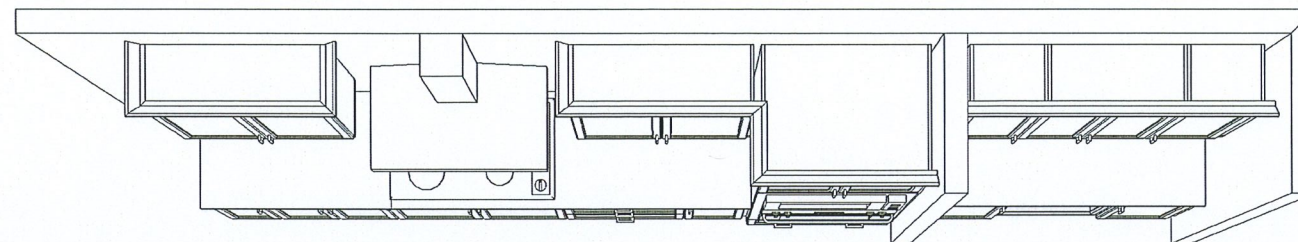

KITCHEN - TOP VIEW

CUSTOMER APPROVAL

I have reviewed these drawings and understand the details of the design and the CARTIER KITCHENS specifications.

Signature _____

Date _____

Note: This drawing is an artistic interpretation of the general appearance of the design. It is not meant to be an exact rendition.

SPECTRUM KITCHEN and BATH
DESIGN



Designed: 2021-05-20
Printed: 2021-05-20

DCR #45 - Diamondview Estates 2 - NEWINGTON -

All

Drawing #: 1

DELETE
ALL CAB
VALENCES



KITCHEN - 3D VIEW #1

CUSTOMER APPROVAL

I have reviewed these drawings and understand the details of the design and the CARTIER KITCHENS specifications.

Signature _____

Date _____

Note: This drawing is an artistic interpretation of the general appearance of the design. It is not meant to be an exact rendition.

SPECTRUM KITCHEN and BATH
DESIGN



Designed: 2021-05-20
Printed: 2021-05-20

DCR #45 - Diamondview Estates 2 - NEWINGTON -

All

Drawing #: 1



KITCHEN - 3D VIEW #2

CUSTOMER APPROVAL

I have reviewed these drawings and understand the details of the design and the CARTIER KITCHENS specifications.

Signature _____


Date _____

Note: This drawing is an artistic interpretation of the general appearance of the design. It is not meant to be an exact rendition.

SPECTRUM KITCHEN and BATH DESIGN



Designed: 2021-05-20
Printed: 2021-05-20

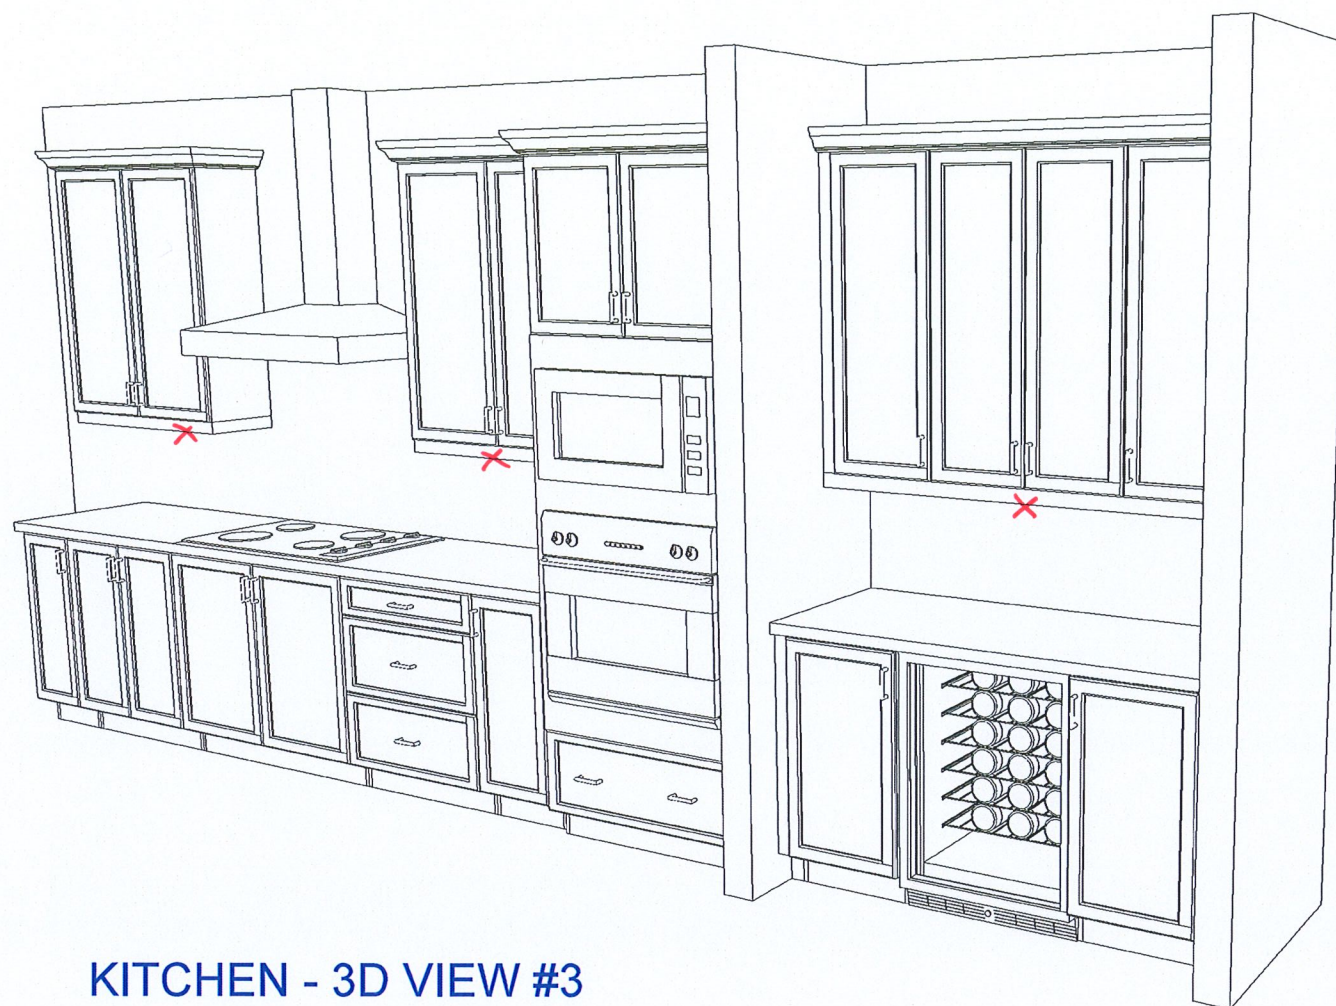

KITCHEN - 3D VIEW #3

CUSTOMER APPROVAL

I have reviewed these drawings and understand the details of the design and the CARTIER KITCHENS specifications.

Signature _____

Date _____

Note: This drawing is an artistic interpretation of the general appearance of the design. It is not meant to be an exact rendition.

SPECTRUM KITCHEN and BATH
DESIGN




Designed: 2021-05-20
Printed: 2021-05-20

DCR #45 - Diamondview Estates 2 - NEWINGTON -

All

Drawing #: 1

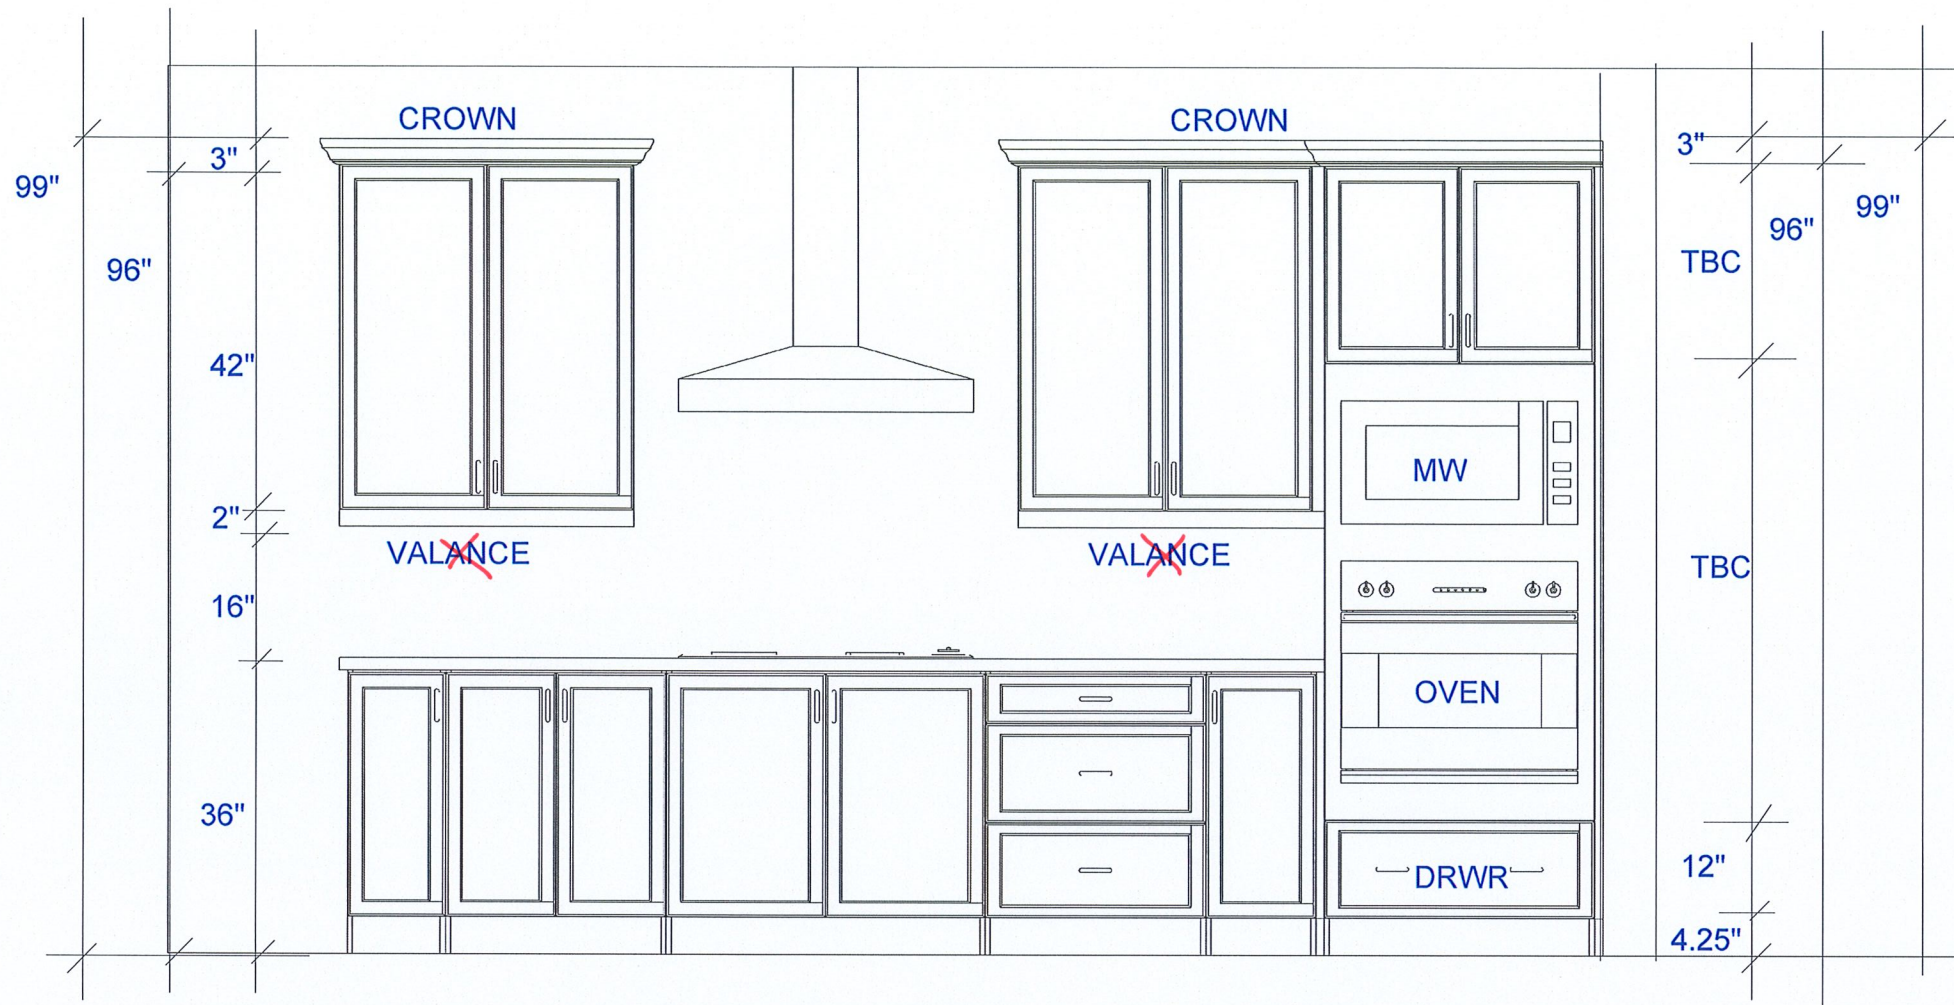

COOKTOP / OVEN WALL ELEVATION

CUSTOMER APPROVAL

I have reviewed these drawings and understand the details of the design and the CARTIER KITCHENS specifications.

Signature _____

Date _____

Note: This drawing is an artistic interpretation of the general appearance of the design. It is not meant to be an exact rendition.

SPECTRUM KITCHEN and BATH DESIGN



Designed: 2021-05-20
Printed: 2021-05-20

DCR #45 - Diamondview Estates 2 - NEWINGTON -

All

Drawing #: 1



BUTLER'S PANTRY ELEVATION

CUSTOMER APPROVAL

I have reviewed these drawings and understand the details of the design and the CARTIER KITCHENS specifications.

Signature _____

Date _____

Note: This drawing is an artistic interpretation of the general appearance of the design. It is not meant to be an exact rendition.

SPECTRUM KITCHEN and BATH DESIGN




Designed: 2021-05-20
Printed: 2021-05-20

DCR #45 - Diamondview Estates 2 - NEWINGTON -

All

Drawing #: 1

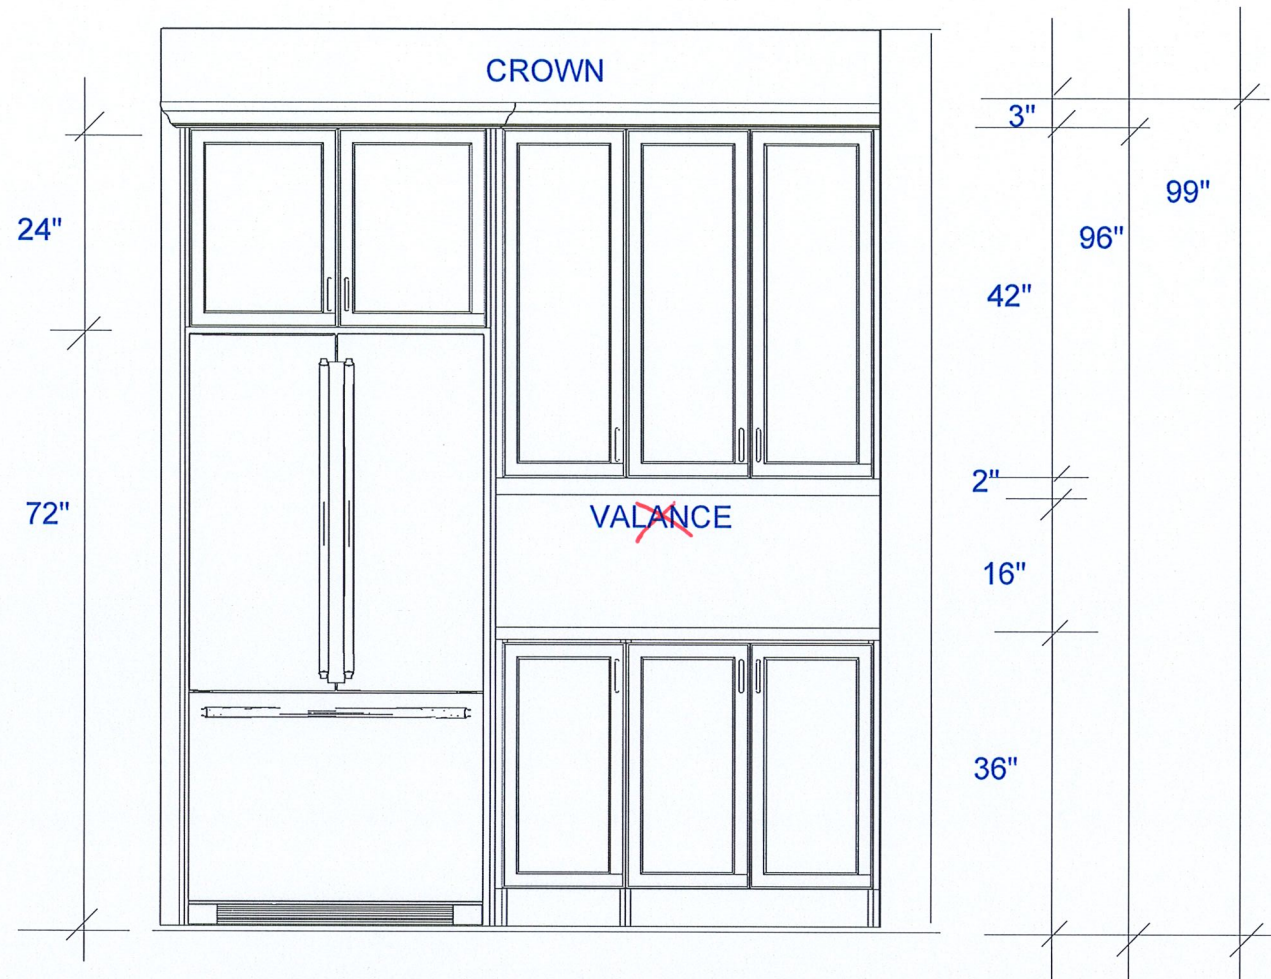

FRIDGE WALL ELEVATION

CUSTOMER APPROVAL

I have reviewed these drawings and understand the details of the design and the CARTIER KITCHENS specifications.

Signature _____

Date _____

Note: This drawing is an artistic interpretation of the general appearance of the design. It is not meant to be an exact rendition.

SPECTRUM KITCHEN and BATH DESIGN



Designed: 2021-05-20
Printed: 2021-05-20

DCR #45 - Diamondview Estates 2 - NEWINGTON -

All

Drawing #: 1