



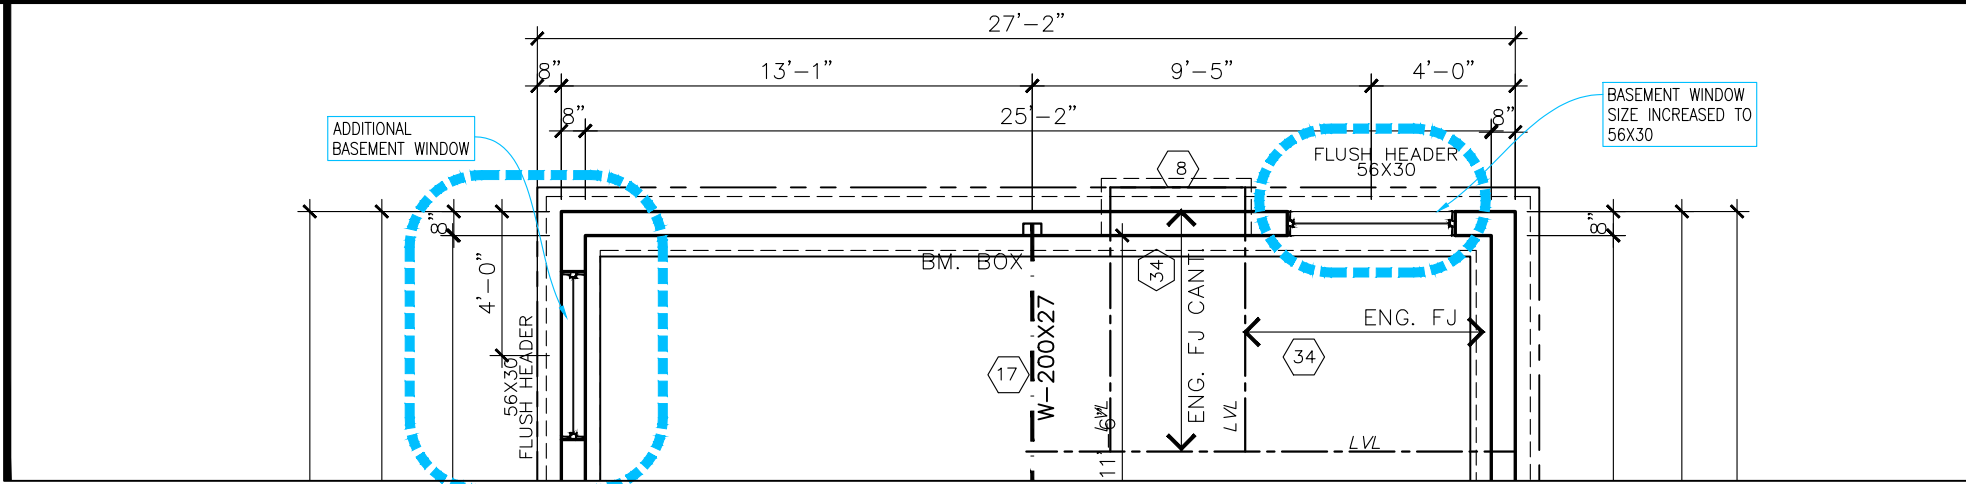



1 PARTIAL FOUNDATION PLAN
1 scale: 3/16"=1'-0"

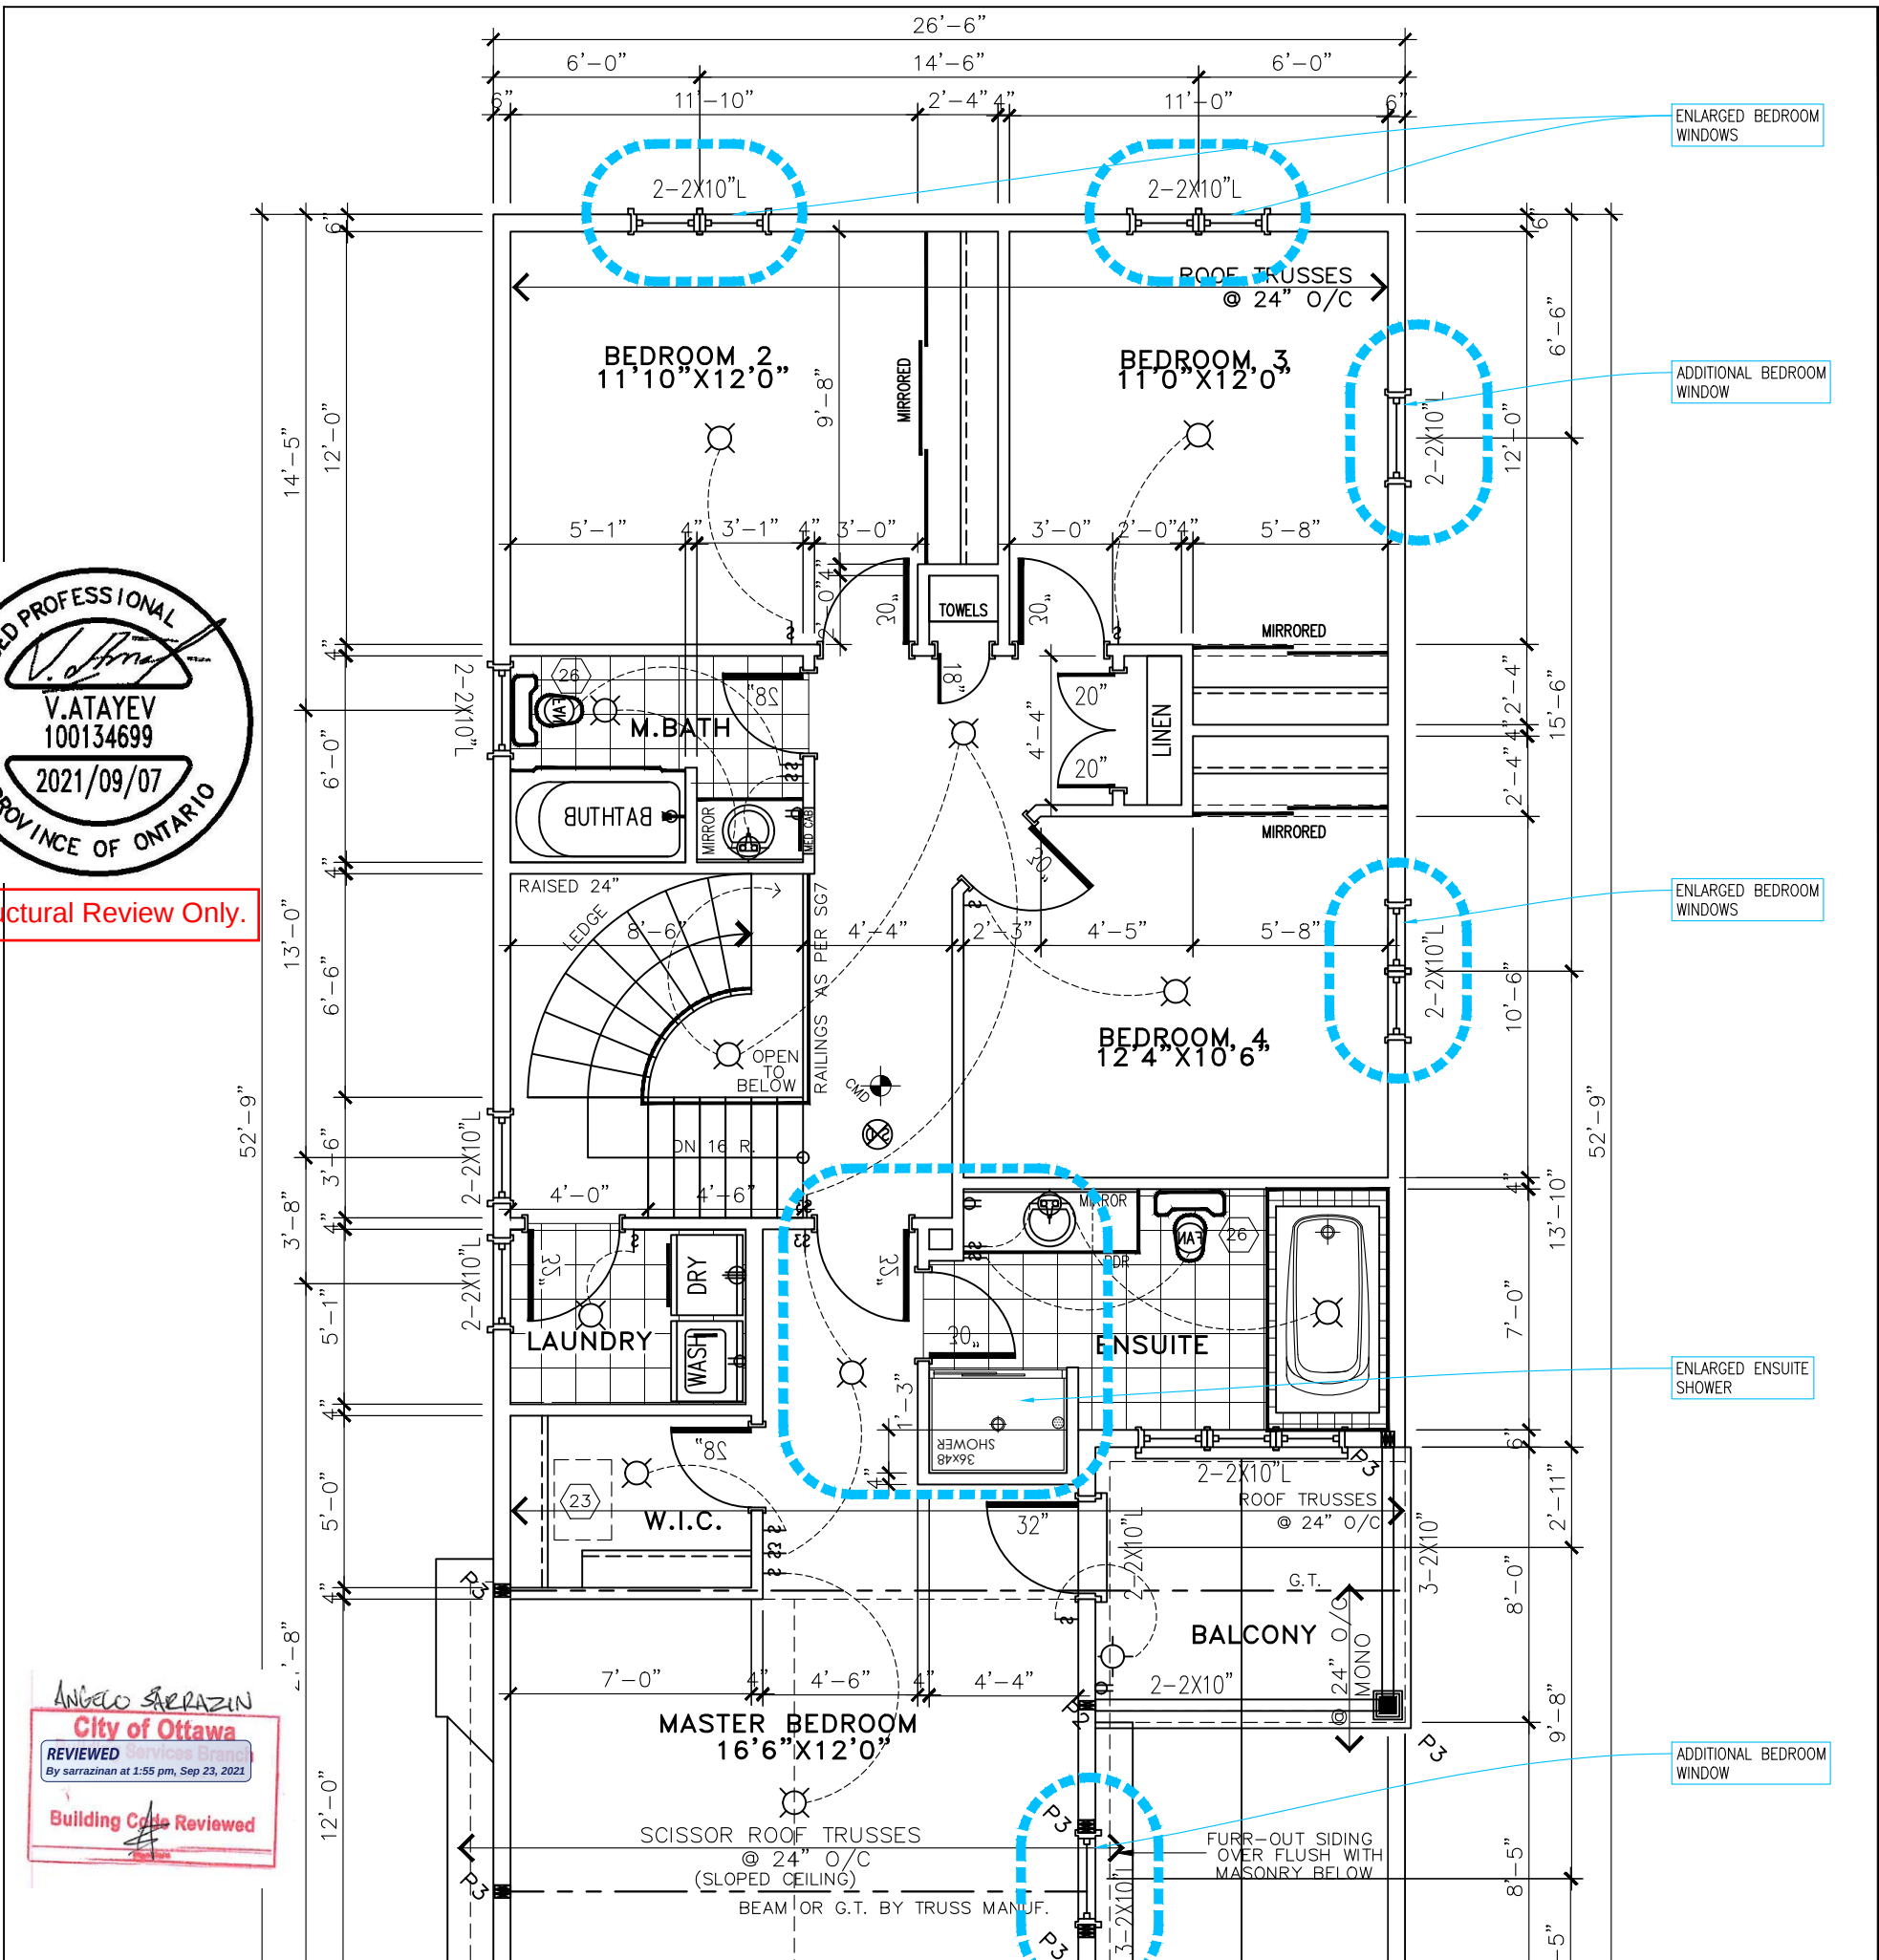

2 PARTIAL SECOND FLOOR PLAN
1 scale: 3/16"=1'-0"



Structural Review Only.

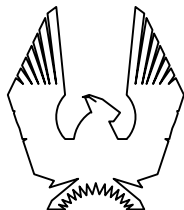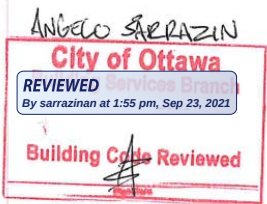

PHOENIX HOMES

ROSEMERE-2012-E

SITE: PATHWAYS


LOT NUMBER:

264


CIVIC ADDRESS:
909 OMAGAKI WAY

No.	Description	dd/mm/yy	By
2	ENGINEER MARKUPS APPLIED	XX/XX/XX	CB
1	ADDED BSMT WINDOW & ENLARGED BED WINDOWS	16/08/21	CB


footprint:	C10E
drawn by:	PL
date:	AUG/00
scale:	3/16"=1'-0"
sheet no:	1
	2

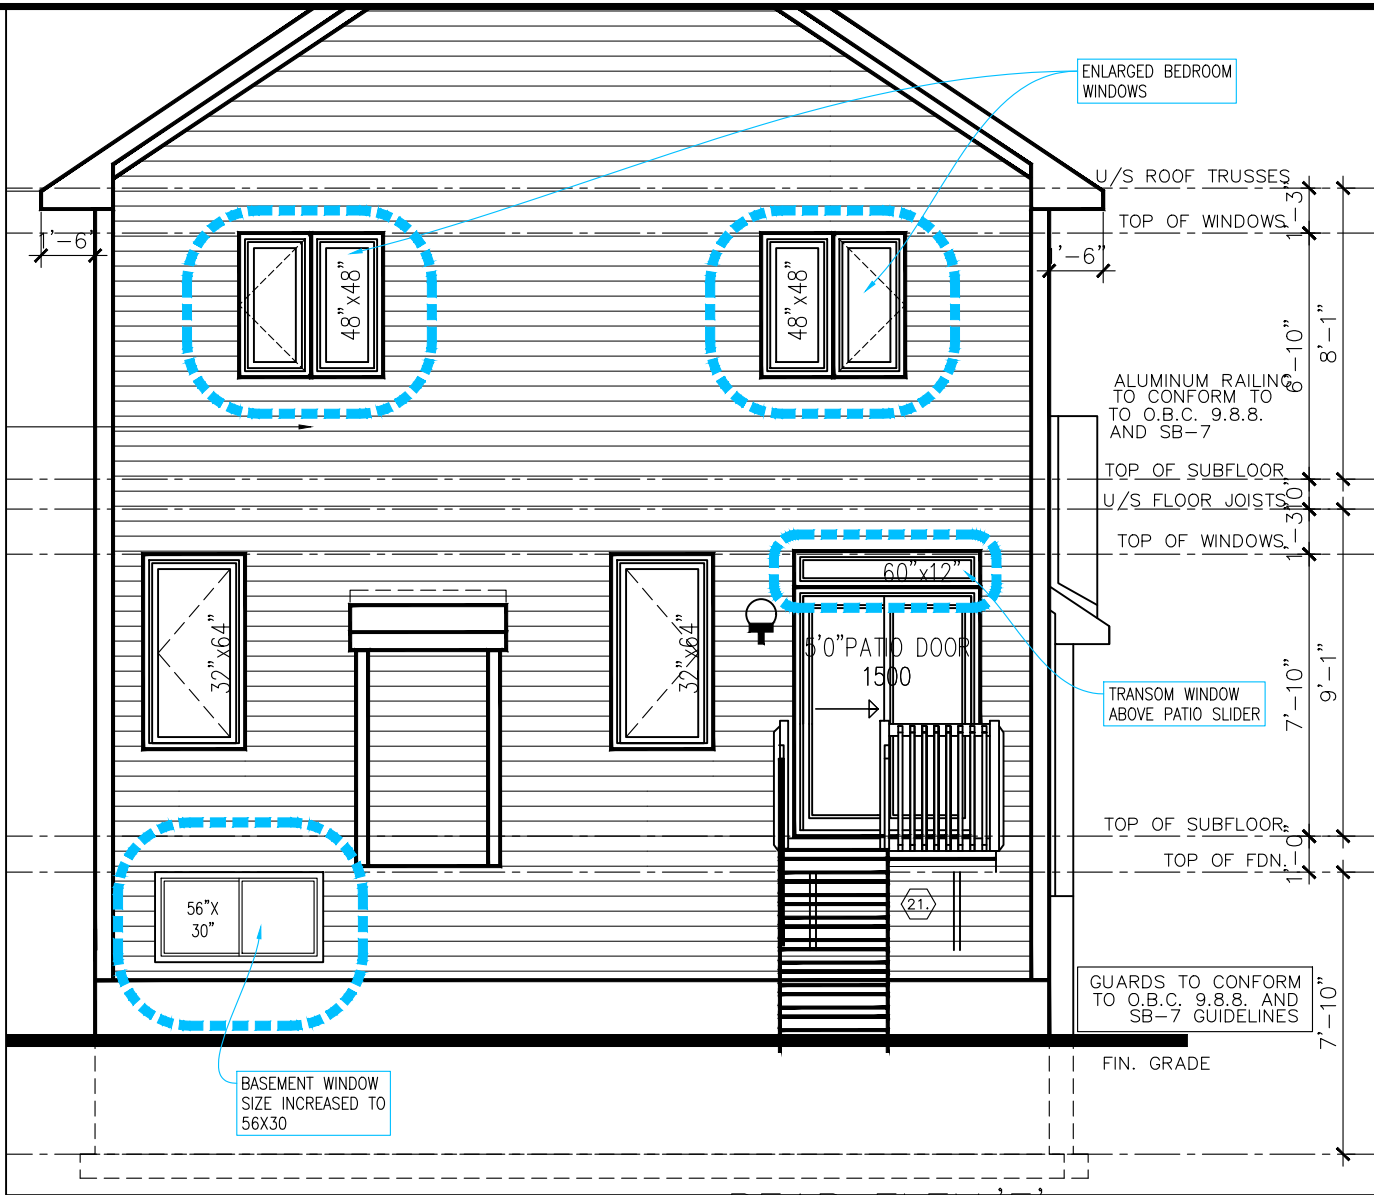

1 PARTIAL REAR ELEVATION
2 scale: 3/16"=1'-0"

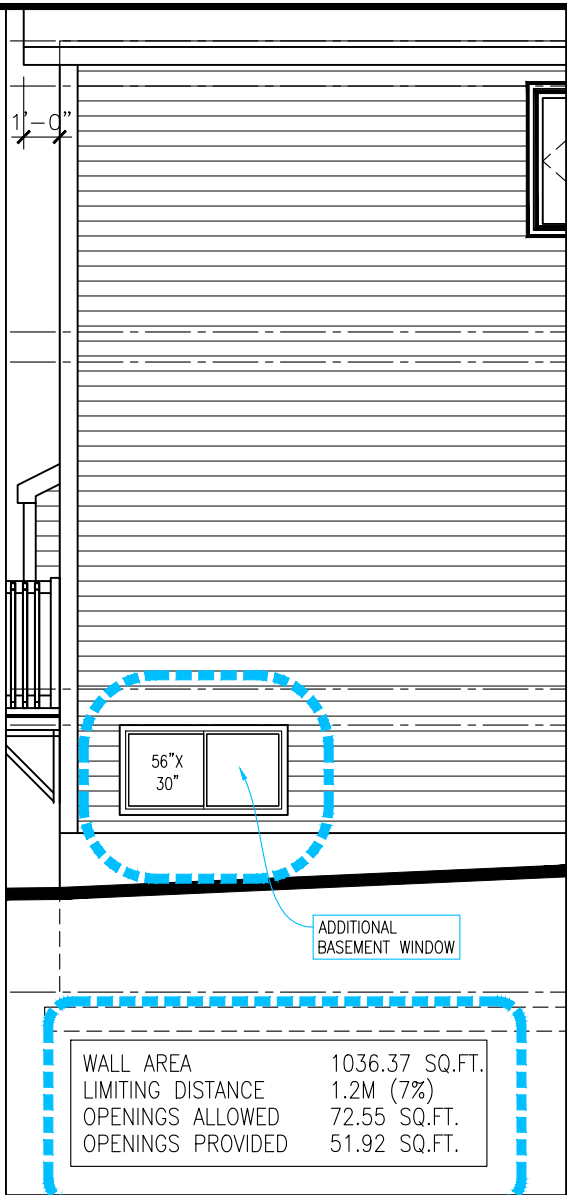

2 PARTIAL LEFT ELEVATION
2 scale: 3/16"=1'-0"

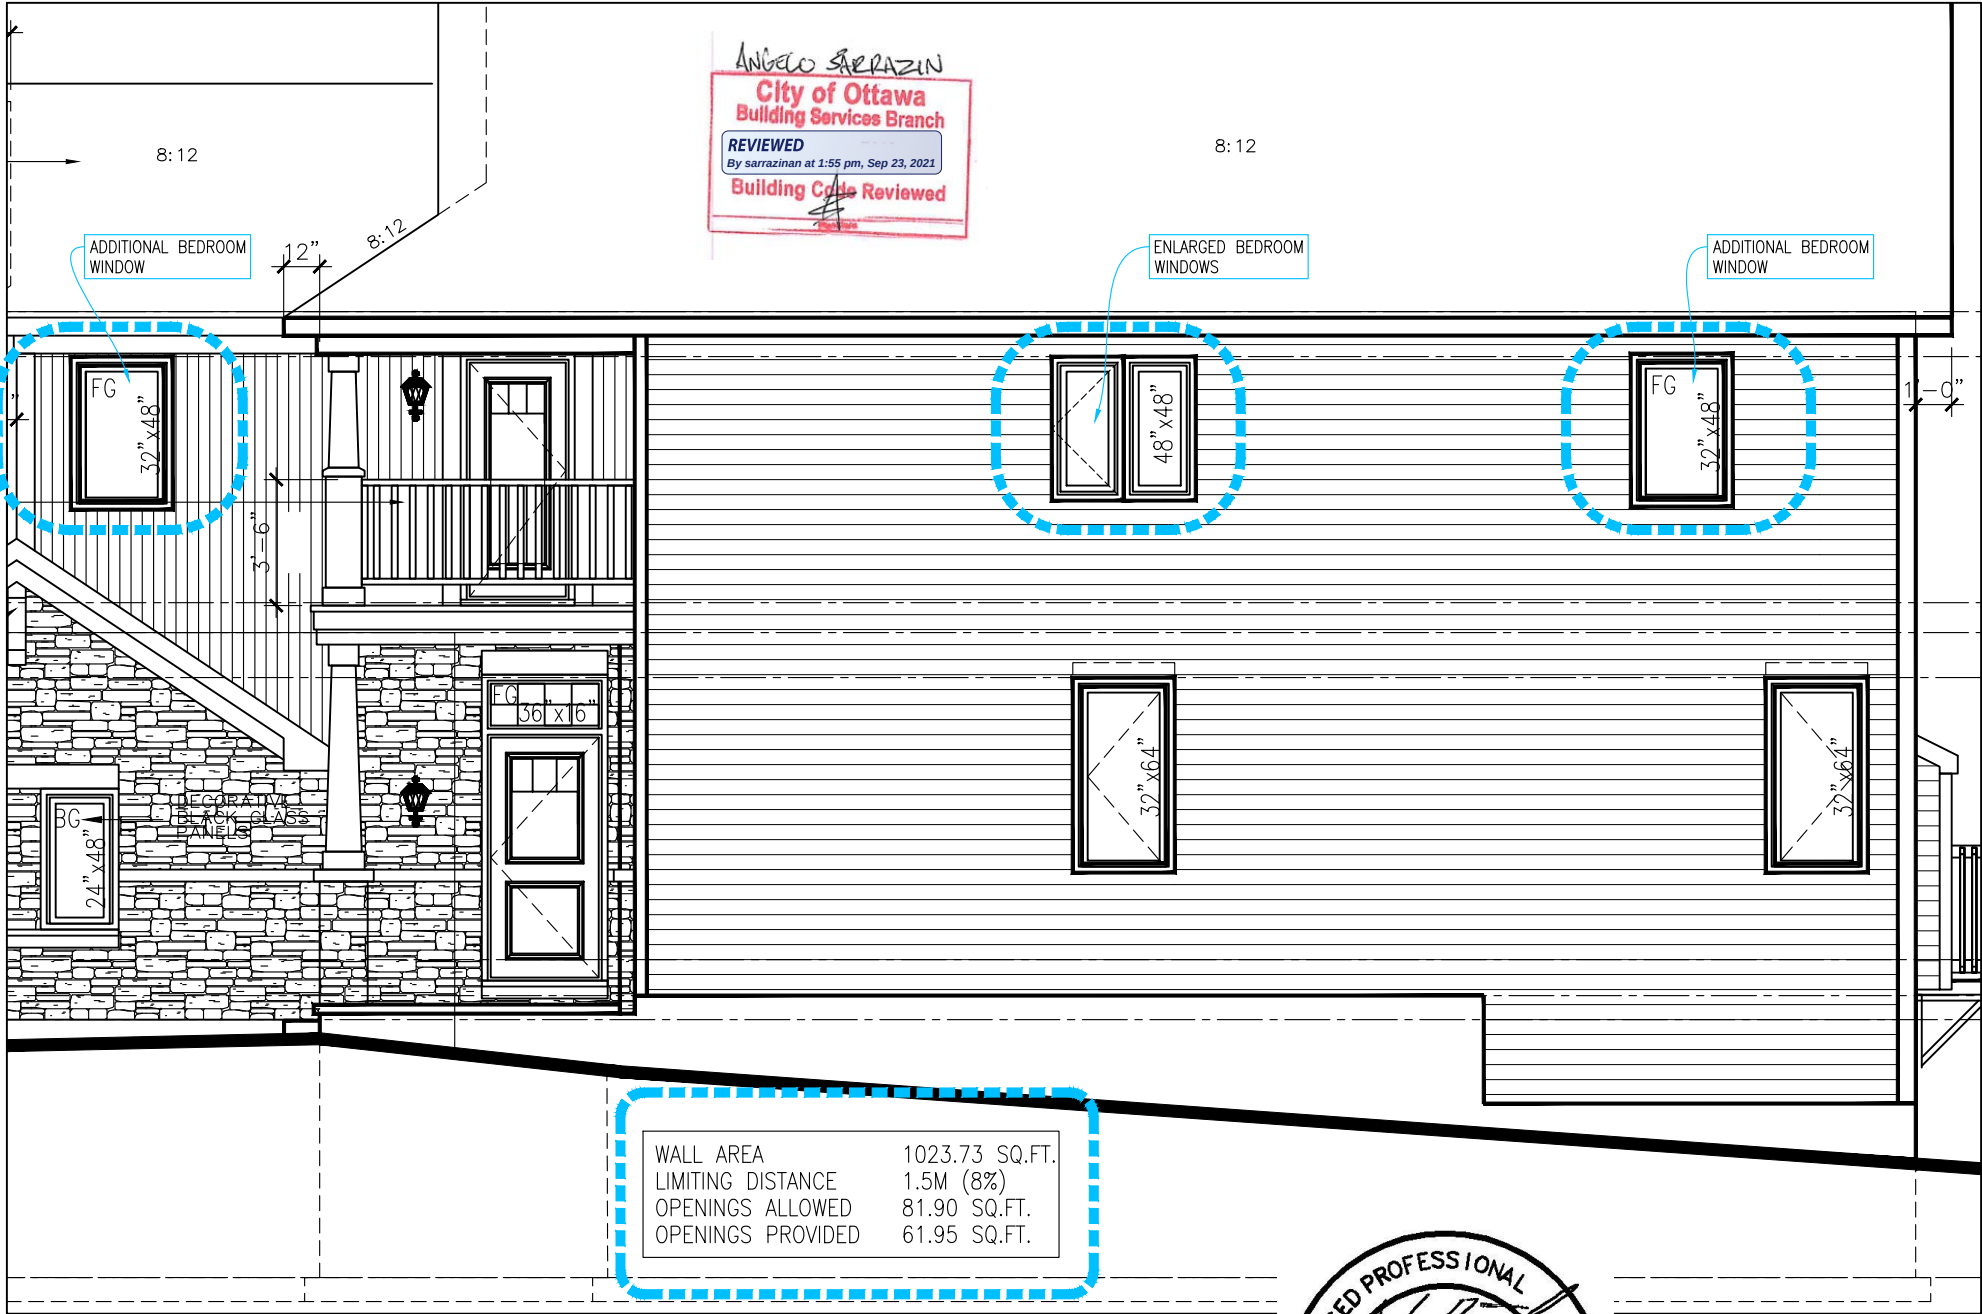

3 PARTIAL RIGHT ELEVATION
2 scale: 3/16"=1'-0"



ROSEMERE-2012-E

SITE: PATHWAYS

LOT NUMBER: 264

CIVIC ADDRESS: 909 OMAGAKI WAY

Structural Review Only.			
2	ENGINEER MARKUPS APPLIED	XX/XX/XX	CB
1	ADDED BSMT WINDOW & ENLARGED BED WINDOWS	16/08/21	CB
No.	Description	dd/mm/yy	By
REVISIONS			

footprint: C10E

drawn by: PL

date: AUG/00

scale: 3/16"=1'-0"

sheet no: 2