


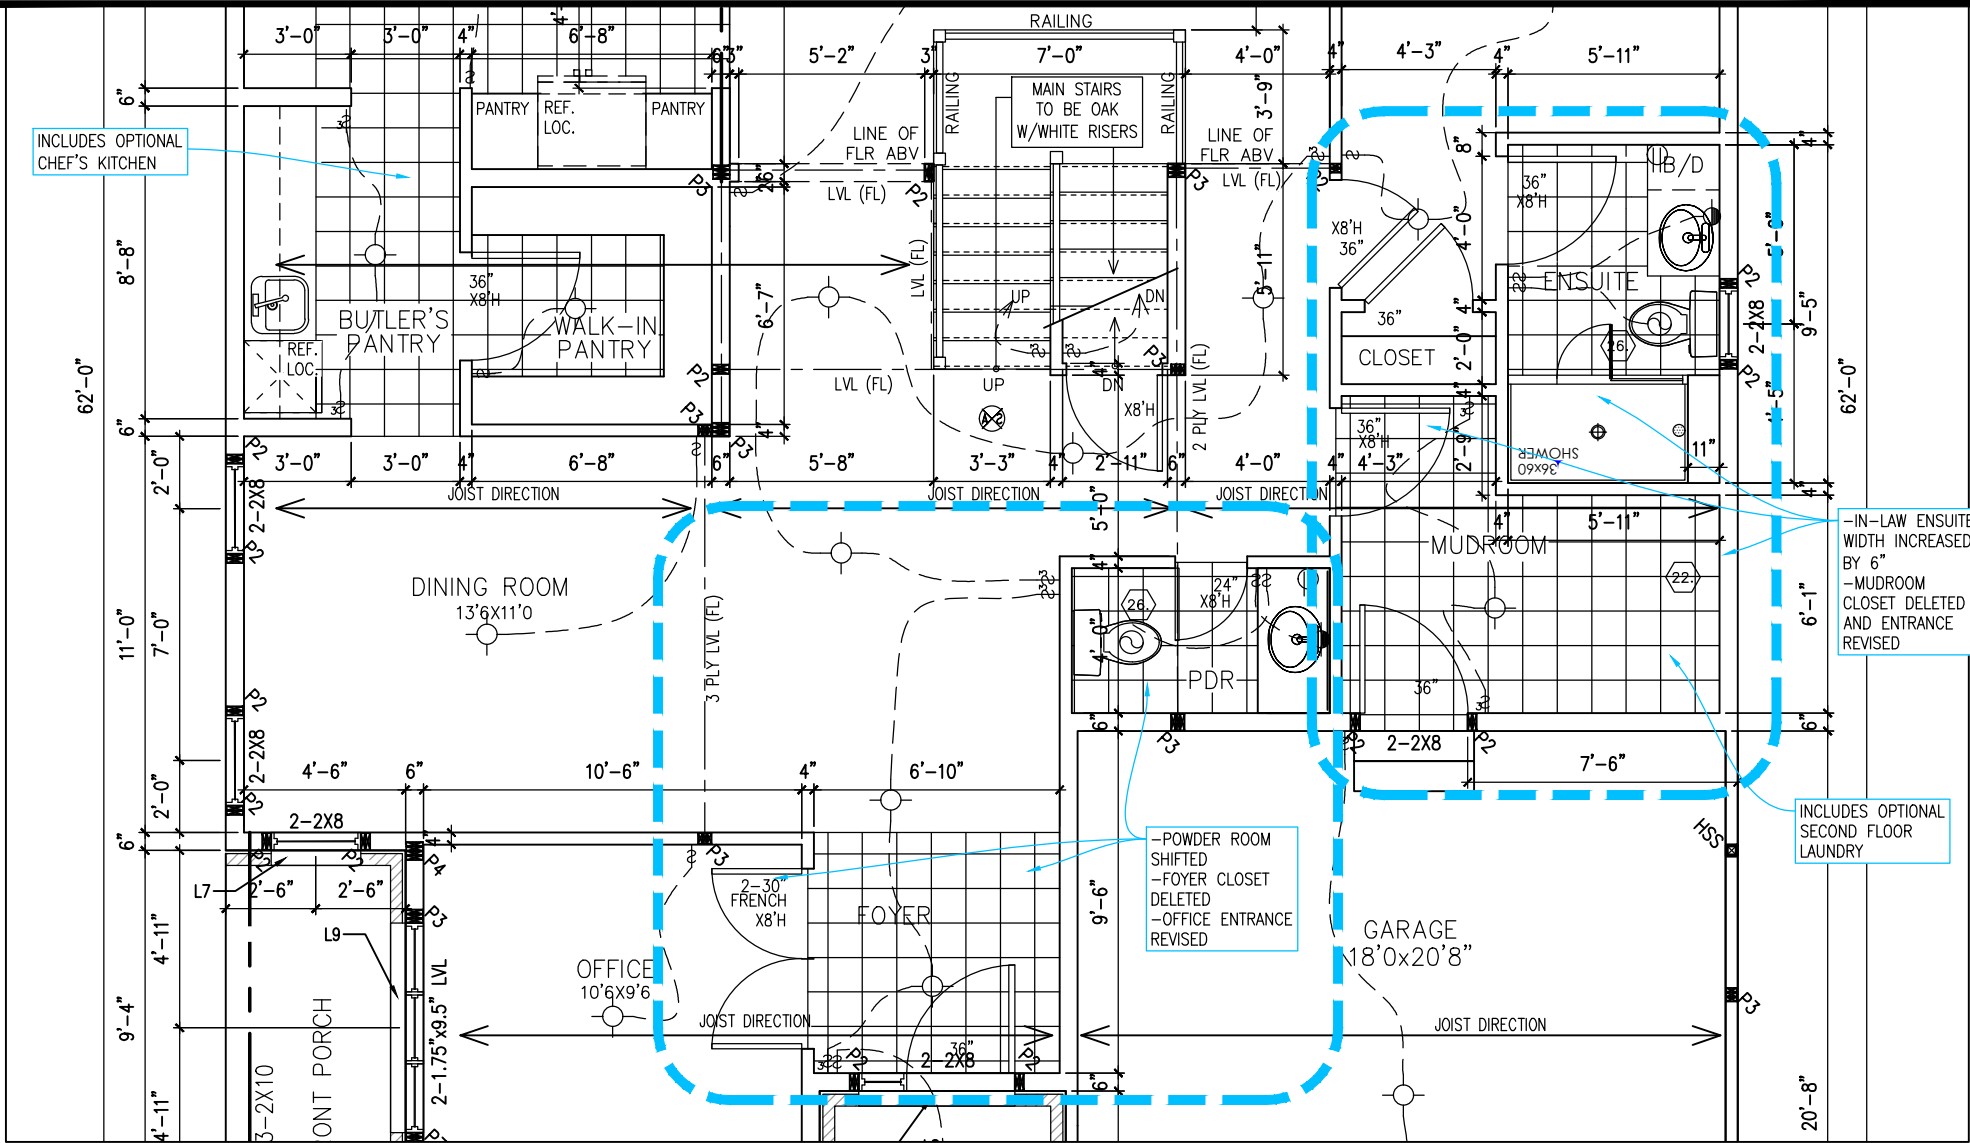

1 PARTIAL GROUND FLOOR PLAN – ELEVATION C
1 scale: 3/16"=1'-0"

TO BE READ IN CONJUNCTION WITH MASTER FOOTPRINTED PLANS
REVIEWED FOR MARKED CHANGE ONLY

City of Ottawa
Building Services Branch

REVIEWED
By Nicholas Winn at 9:29 am, Aug 26, 2021

Building Code Reviewed

Signature



NEWINGTON – 2018

SITE: DIAMONDVIEW ESTATES

LOT NUMBER: 2-20

CIVIC ADDRESS:
1979 CESSNA PRIVATE

1	MUDROOM AND ENTRY REVISIONS	12/08/21	CB
No.	Description	dd/mm/yy	By
REVISIONS			

footprint: 518

drawn by: SP

date: JUN 12/16

scale: 3/16"=1'-0"

sheet no:

1
1