

REVISED 9/29/2021
SEE 3D VIEW #1, #2 & #3.

DCR PHOENIX HOMES

LOT #36

DIAMONDVIEW ESTATES 2

MODEL - MADISON (43-10)

KITCHEN / VANITIES

MOUNTING HEIGHT - 96

42"H UPPERS @ 18" ABOVE COUNTER

CABNETS-

HARDWARE -

STANDARD WHITE INTERIOR

METAL DRAWER BOX

4 PCS - 5/8" KICK - FIN. BOTH ENDS

2 PCS - LOOSE FILLER - 6 x 96

1 PCS - 90 DEG. CORNER MOULD

1 PCS - T-MOULD

5 PCS - FLAT MOULD

CUSTOMER APPROVAL

I have reviewed these drawings and understand the details of the design and the CARTIER KITCHENS specifications.

Signature

Date

DELETED GLASS DOORS

POWDER ROOM

MAIN BATH

MASTER ENSUITE

NOTE: VANITY INCREASE BY APPROX. 27"
(LINEN SHELVES BY BUILDER REMOVED)

DESIGNED: 2021-07-14
PRINTED: 2021-07-14

All dimensions size designations given are subject to verification on job site and adjustment to fit job conditions.

SPECTRUM KITCHEN and BATH DESIGN

This is an original design and must not be released or copied unless applicable fee has been paid or job order placed.

DRAWN BY: LORI DISAVERIO, B.I.D


DCR - #36 Diamondview Estates 2 - Madison (43-10) .kit

All

Drawing #: 1 No Scale.

DS
PH

DS
AP

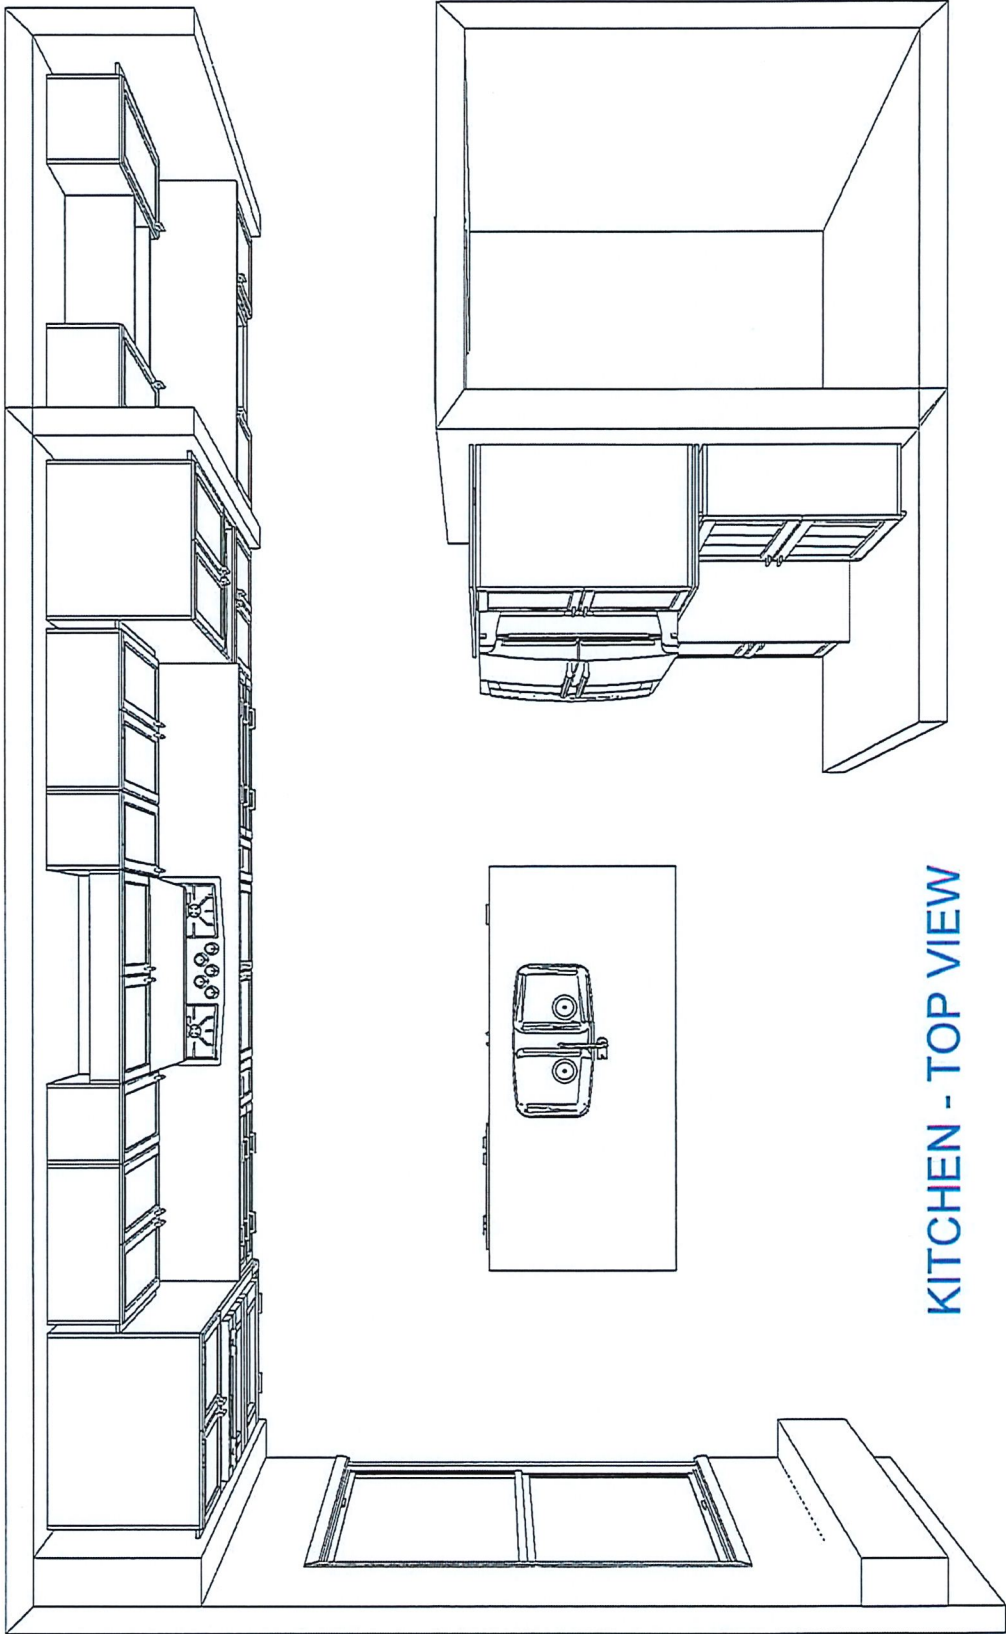

KITCHEN - TOP VIEW

CUSTOMER APPROVAL

I have reviewed these drawings and understand the details of the design and the CARTIER KITCHENS specifications.

Signature _____

Date _____

Note: This drawing is an artistic interpretation of the general appearance of the design. It is not meant to be an exact rendition.


SPECTRUM KITCHEN and BATH DESIGN



Designed: 2021-07-14
Printed: 2021-07-14

DCR - #36 Diamondview Estates 2 - Madison (43-10) All

Drawing #: 1

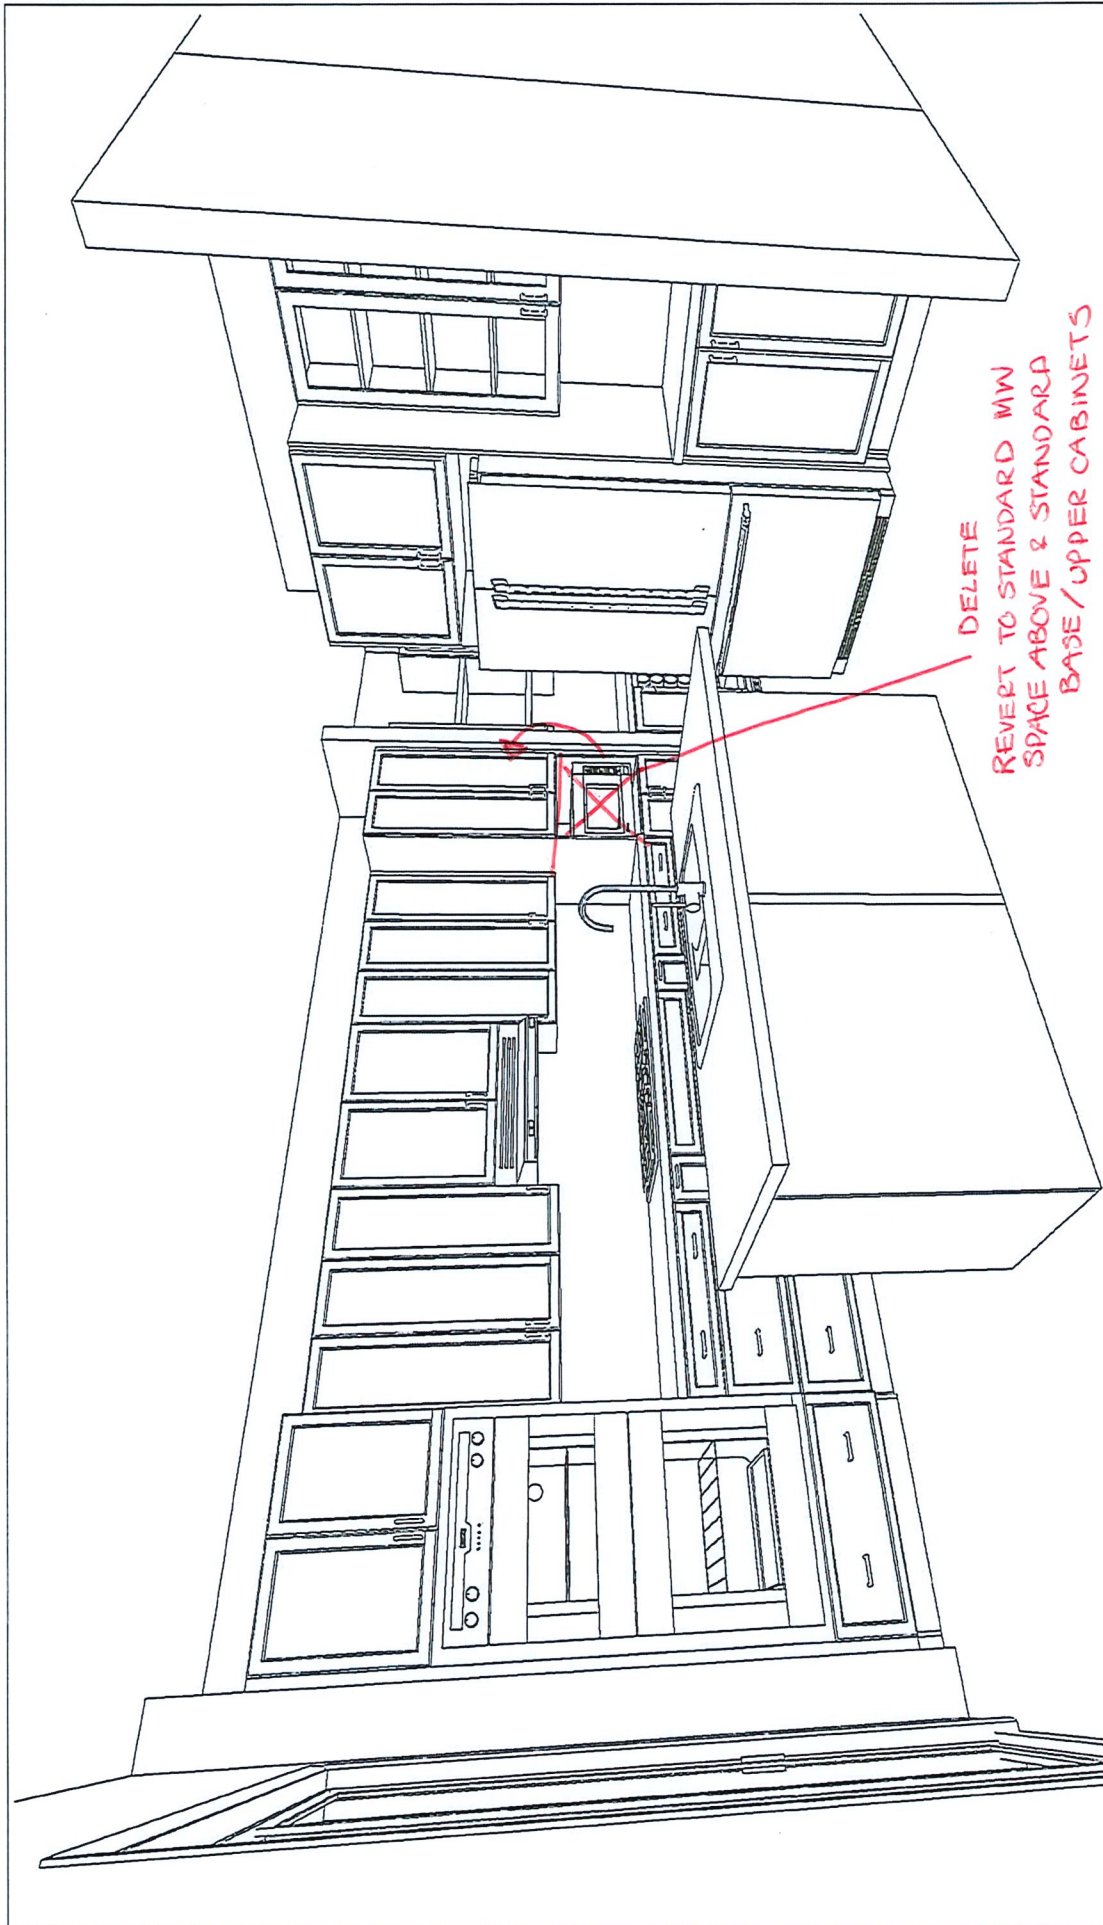

DELETE
REVERT TO STANDARD MW
SPACE ABOVE & STANDARD
BASE / UPPER CABINETS

KITCHEN - 3D VIEW #1

CUSTOMER APPROVAL

I have reviewed these drawings and understand the details of the design and the CARTIER KITCHENS specifications.

Signature _____

Date _____

Note: This drawing is an artistic interpretation of the general appearance of the design. It is not meant to be an exact rendition.


SPECTRUM KITCHEN and BATH DESIGN



Designed: 2021-07-14
Printed: 2021-07-14

DCR - #36 Diamondview Estates 2 - Madison (43-10) All

Drawing #: 1

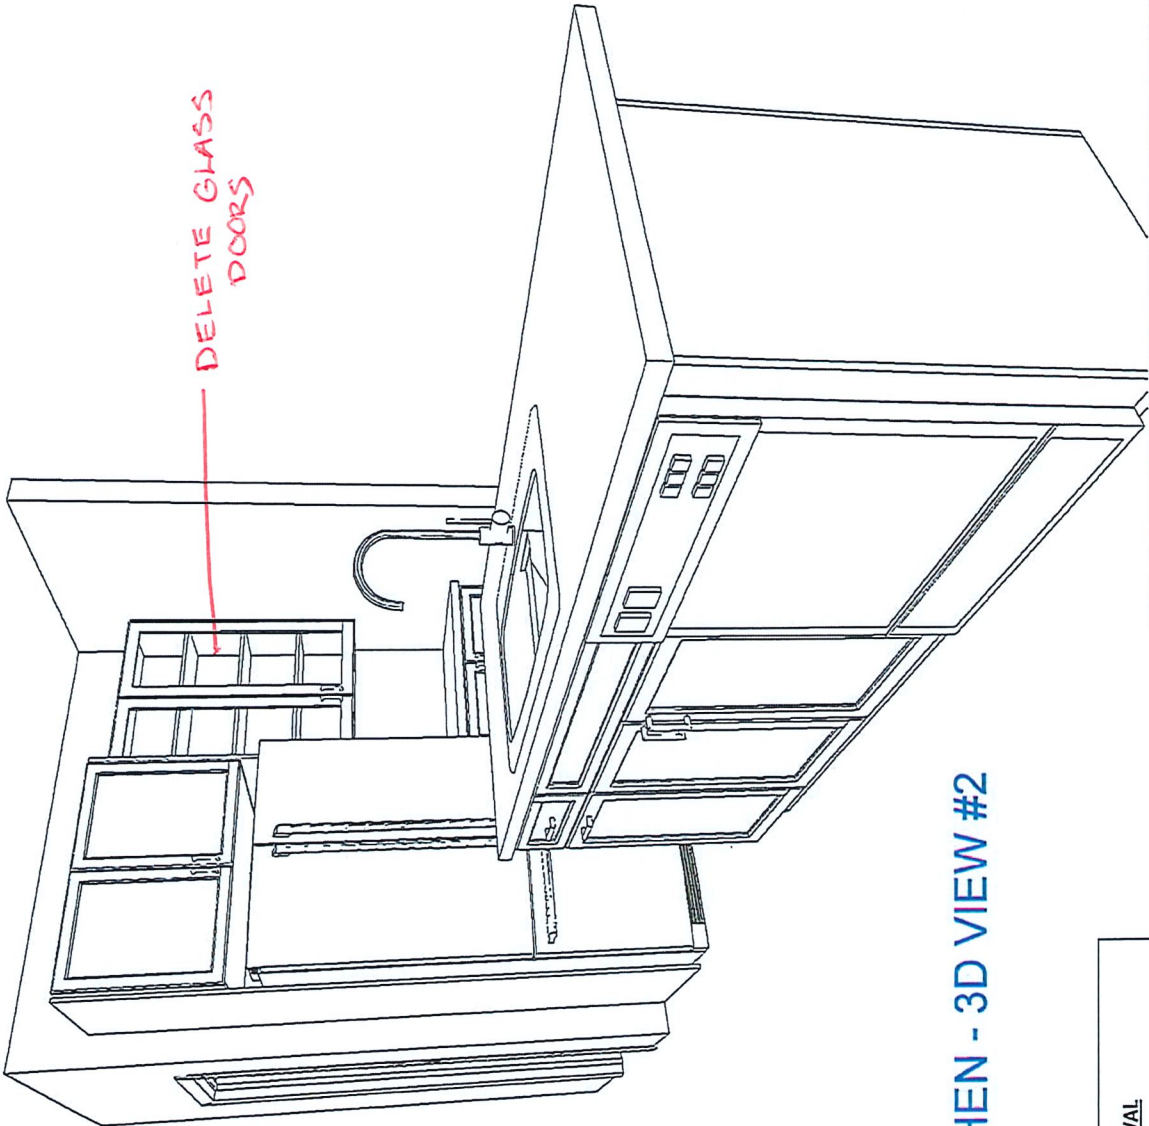

KITCHEN - 3D VIEW #2

CUSTOMER APPROVAL

I have reviewed these drawings and understand the details of the design and the CARTIER KITCHENS specifications.

Signature _____

Date _____

Note: This drawing is an artistic interpretation of the general appearance of the design. It is not meant to be an exact rendition.


SPECTRUM KITCHEN and BATH DESIGN

DCR - #36 Diamondview Estates 2 - Madison (43-10) All



Designed: 2021-07-14
Printed: 2021-07-14

Drawing #: 1

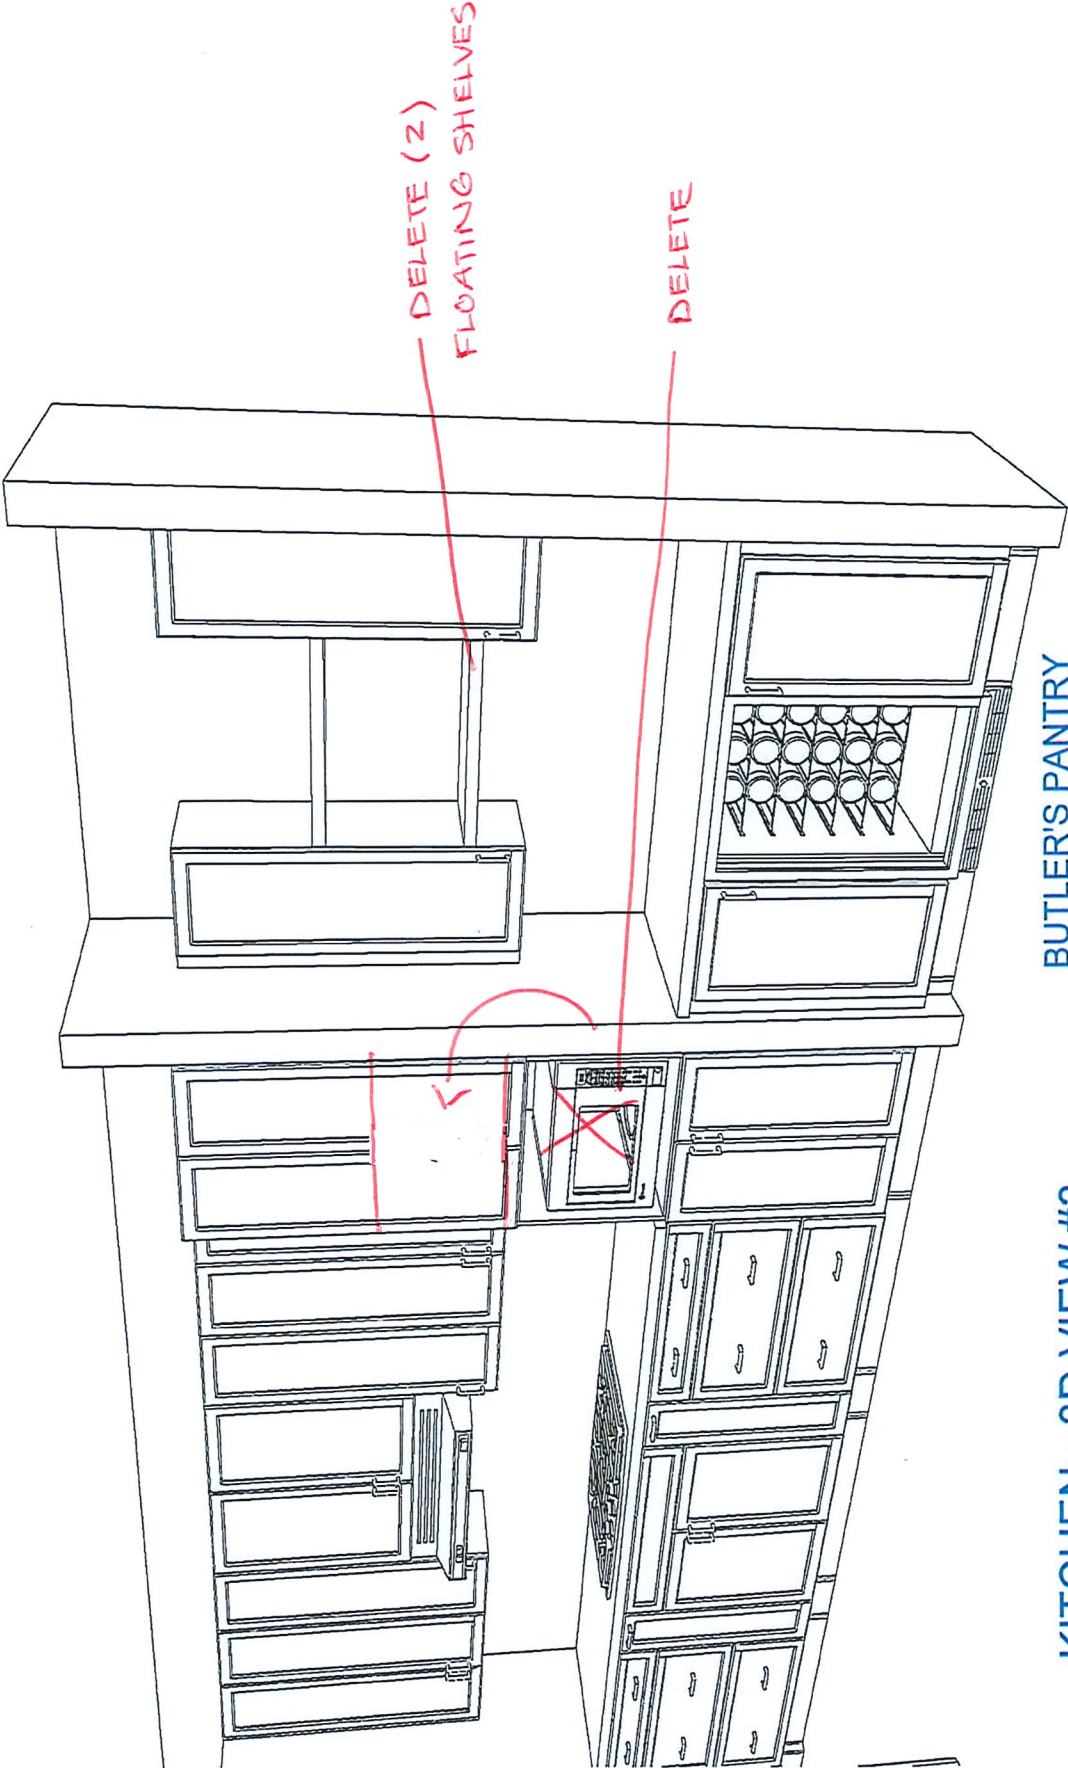

KITCHEN - 3D VIEW #3

BUTLER'S PANTRY

CUSTOMER APPROVAL

I have reviewed these drawings and understand the details of the design and the CARTIER KITCHENS specifications.

Signature _____

Date _____

Note: This drawing is an artistic interpretation of the general appearance of the design. It is not meant to be an exact rendition.


SPECTRUM KITCHEN and BATH DESIGN



Designed: 2021-07-14
Printed: 2021-07-14

DCR - #36 Diamondview Estates 2 - Madison (43-10) All

Drawing #: 1

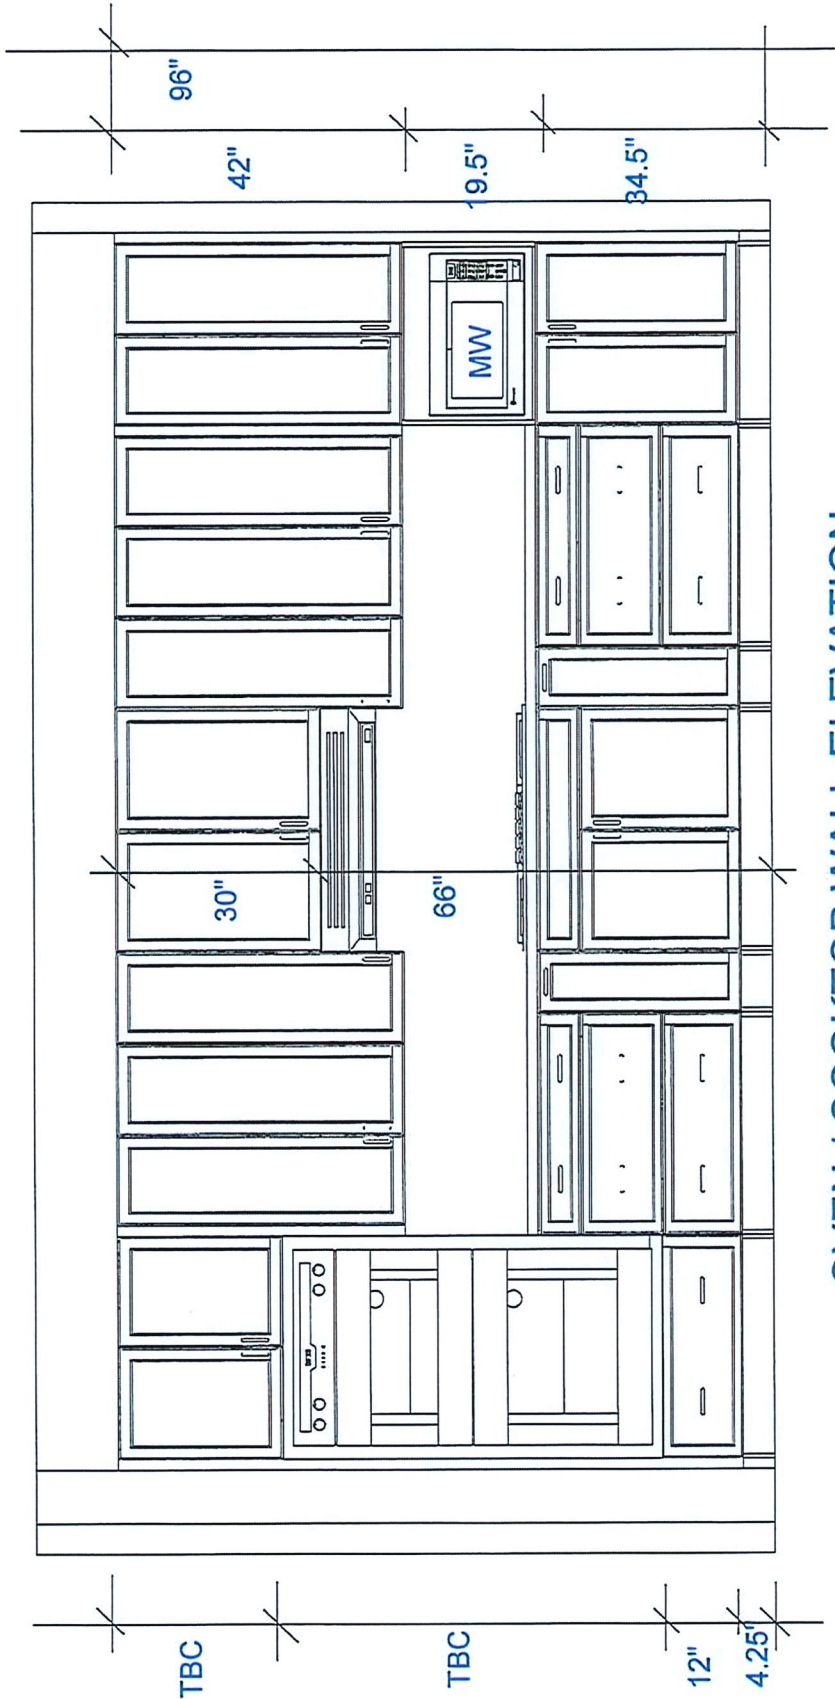

OVEN / COOKTOP WALL ELEVATION

CUSTOMER APPROVAL

I have reviewed these drawings and understand the details of the design and the CARTIER KITCHENS specifications.

Signature _____

Date _____

Note: This drawing is an artistic interpretation of the general appearance of the design. It is not meant to be an exact rendition.


SPECTRUM KITCHEN and BATH DESIGN

DCR - #36 Diamondview Estates 2 - Madison (43-10) All



Designed: 2021-07-14
Printed: 2021-07-14

Drawing #: 1

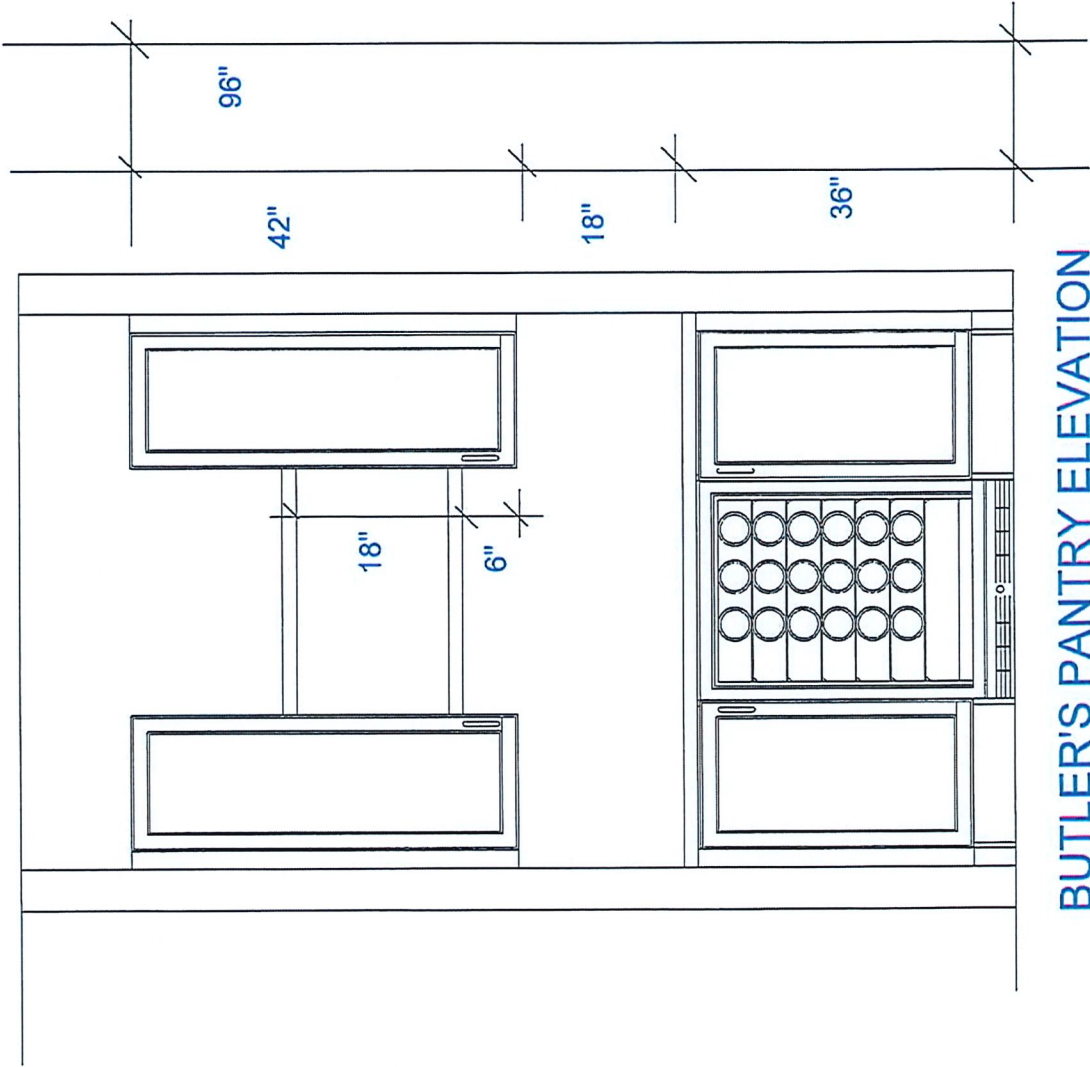

BUTLER'S PANTRY ELEVATION

CUSTOMER APPROVAL

I have reviewed these drawings and understand the details of the design and the CARTIER KITCHENS specifications.

Signature _____

Date _____

Note: This drawing is an artistic interpretation of the general appearance of the design. It is not meant to be an exact rendition.




SPECTRUM KITCHEN and BATH DESIGN

Designed: 2021-07-14
Printed: 2021-07-14

DCR - #36 Diamondview Estates 2 - Madison (43-10) All

Drawing #: 1

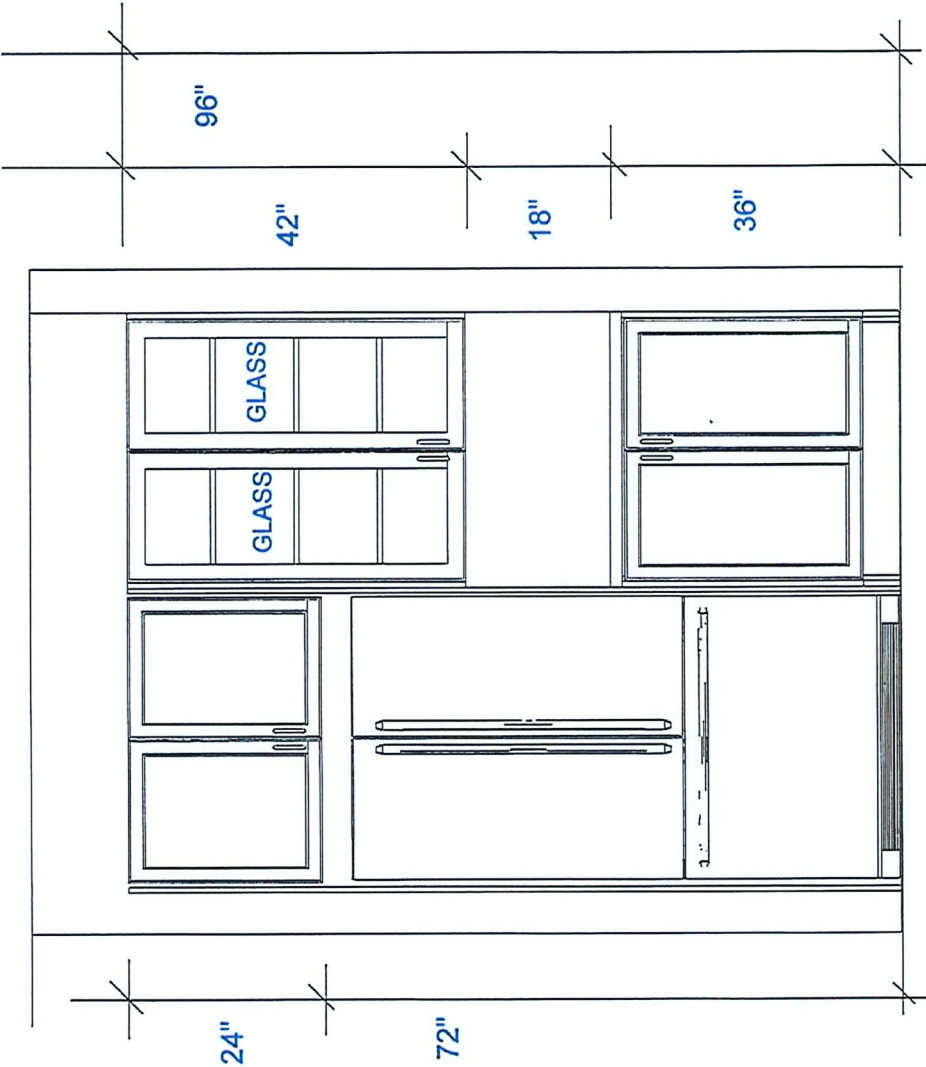

FRIDGE WALL ELEVATION

CUSTOMER APPROVAL

I have reviewed these drawings and understand the details of the design and the CARTIER KITCHENS specifications.

Signature _____

Date _____

Note: This drawing is an artistic interpretation of the general appearance of the design. It is not meant to be an exact rendition.


SPECTRUM KITCHEN and BATH DESIGN




Designed: 2021-07-14
Printed: 2021-07-14

DCR - #36 Diamondview Estates 2 - Madison (43-10) All


Drawing #: 1

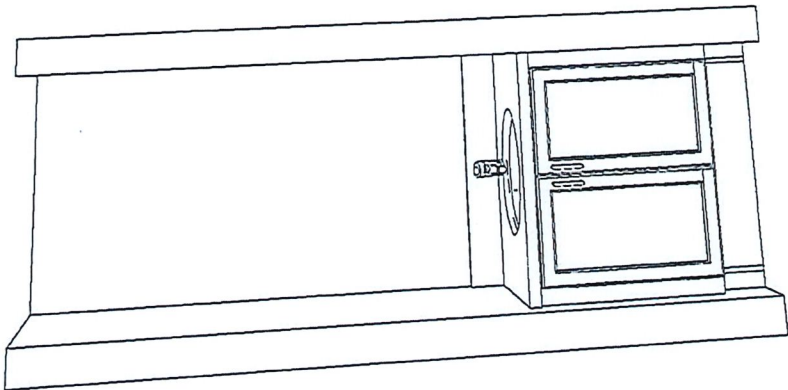

POWDER ROOM

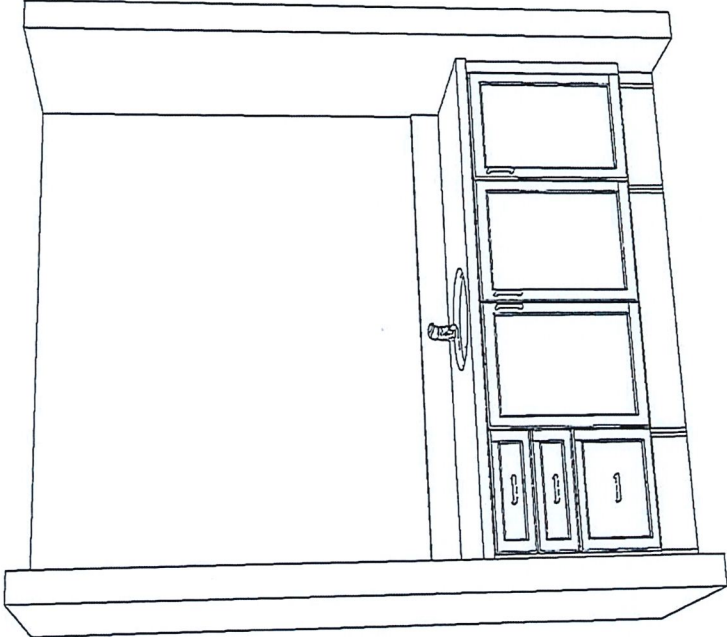

MAIN BATH

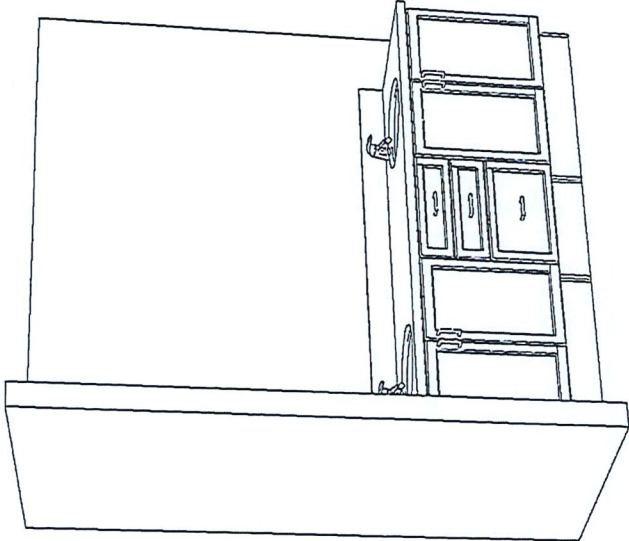

MASTER ENSUITE

CUSTOMER APPROVAL

I have reviewed these drawings and understand the details of the design and the CARTIER KITCHENS specifications.

Signature _____

Date _____

Note: This drawing is an artistic interpretation of the general appearance of the design. It is not meant to be an exact rendition.



SPECTRUM KITCHEN and BATH DESIGN

DCR - #36 Diamondview Estates 2 - Madison (43-10) All

Designed: 2021-07-14
Printed: 2021-07-14

Drawing #: 1