

REVISED 9/29/2021

DCR PHOENIX HOMES

MODEL - ANNAPOLIS (509)

KITCHEN

MOUNTING HEIGHT - 84

LINE - 1 & 2

HARDWARE - STD & 1ST UPGRADE

STANDARD WHITE INTERIOR

METAL DRAWER BOX

4 PCS - 5/8" KICK - FIN. BOTH ENDS


2 PCS - LOOSE FILLER - 6 x 96

2 PCS - 90 DEG. CORNER MOULD

1 PCS - T-MOULD

REVISED: NOV 22-17

\* ADD LIGHT VALANCE  
\* ADD 3" CROWN MOULDING TO UPPERS (SHAKER STYLE)  
24" D W/SIDE PANEL

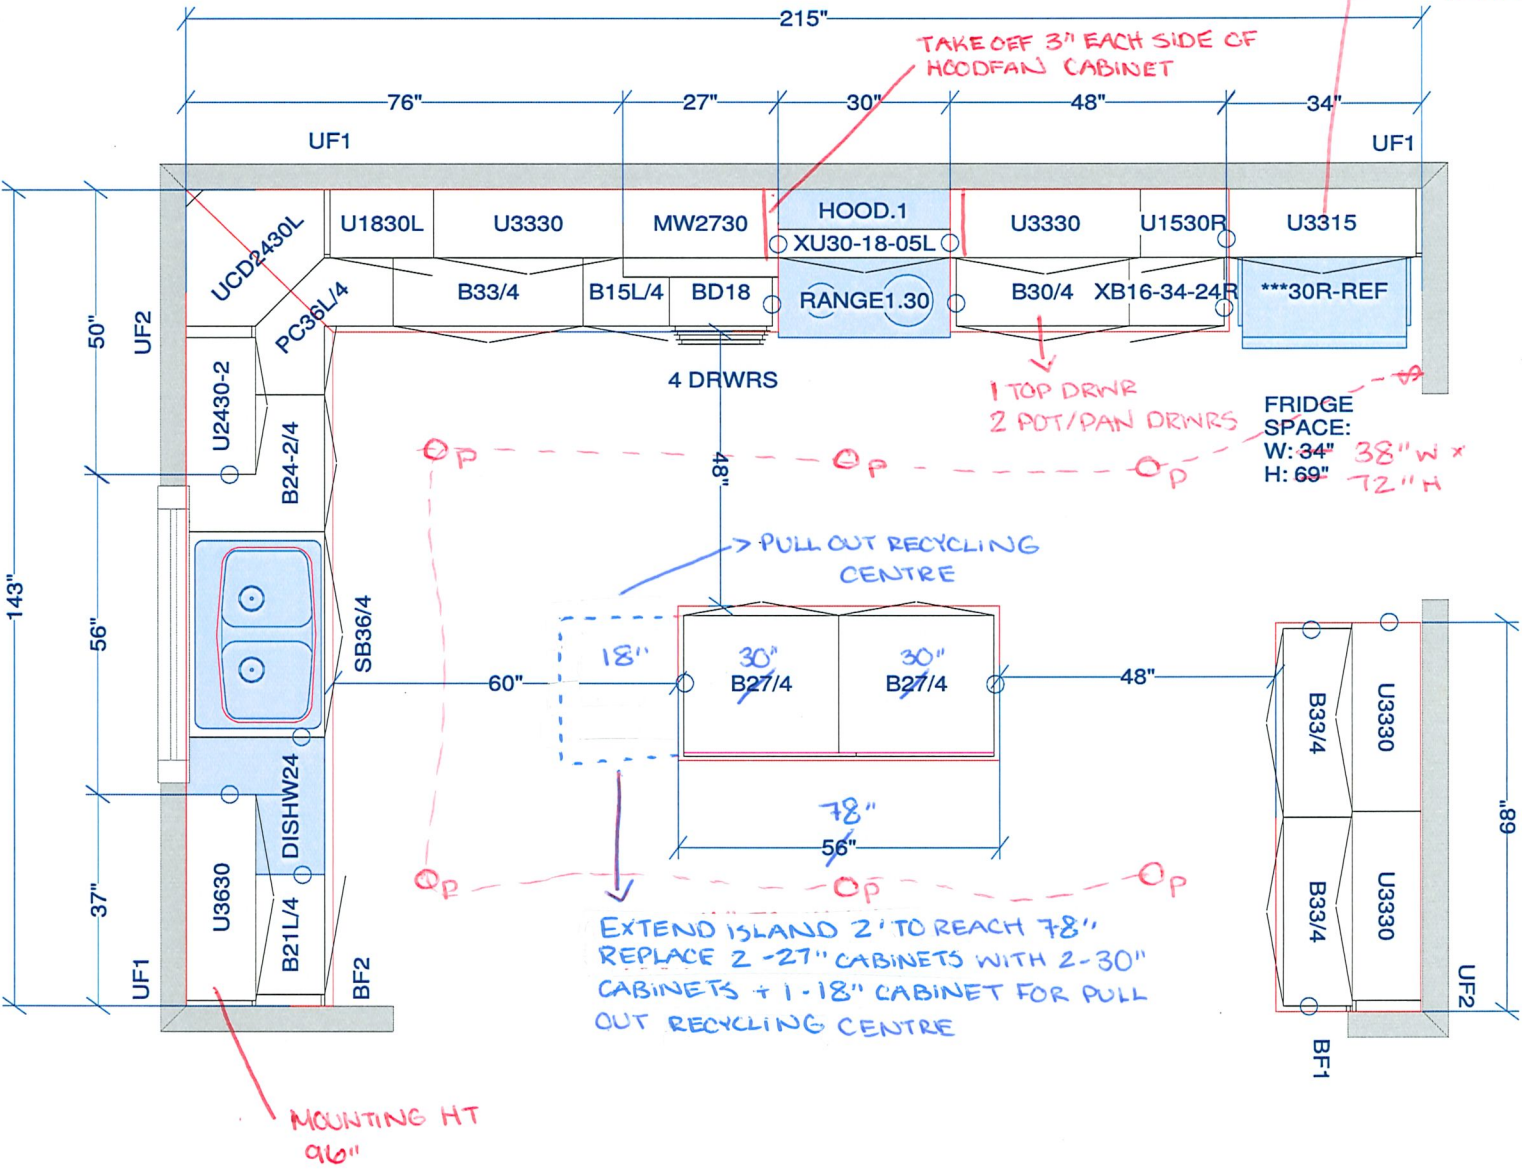

All dimensions size designations given are subject to verification on job site and adjustment to fit job conditions.

SPECTRUM KITCHEN and BATH DESIGN

509 Annapolis Kit

This is an original design and must not be released or copied unless applicable fee has been paid or job order placed.

DRAWN BY: LORI DISAVERIO, B.I.D

Designed: 2017-01-10  
Printed: 2017-11-22

All


Drawing #: 1 No Scale.

DCR PHOENIX HOMES


MODEL - ANNAPOLIS (509)

VANITIES

- LINE - 1 & 2
- HARDWARE - STD & 1ST UPGRADE
- STANDARD WHITE INTERIOR
- METAL DRAWER BOX
- 5/8" TOE KICK

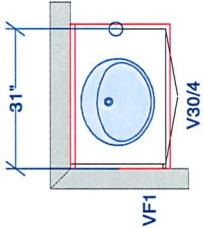


POWDER

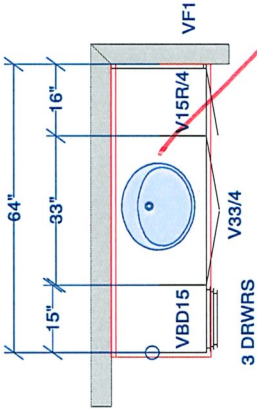


ENSUITE #2 -  
MAIN BATH

(2) SINKS W/  
STANDARD BASE  
CABINETS &  
(1) BANK OF DRAWERS  
IN MIDDLE

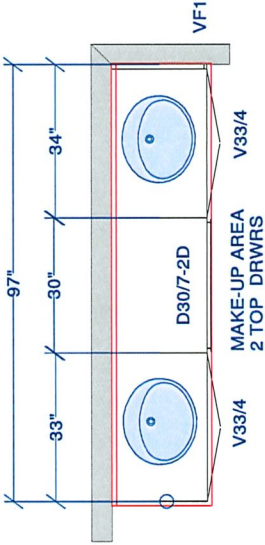

MASTER ENSUITE

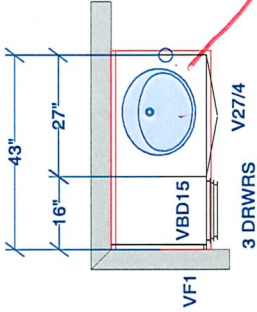

SHARED BATH -  
BDRM 3 & 4 -  
JACK & JILL

(2) SINKS W/  
STANDARD BASE  
CABINETS & (1)  
BANK OF DRAWERS  
IN MIDDLE


|                                                                                                                      |                                                                                       |                                                                                                                        |              |                                             |  |
|----------------------------------------------------------------------------------------------------------------------|---------------------------------------------------------------------------------------|------------------------------------------------------------------------------------------------------------------------|--------------|---------------------------------------------|--|
| All dimensions size designations given are subject to verification on job site and adjustment to fit job conditions. |  | This is an original design and must not be released or copied unless applicable fee has been paid or job order placed. |              | Designed: 2014-03-24<br>Printed: 2014-06-16 |  |
|                                                                                                                      |                                                                                       | All                                                                                                                    | Drawing #: 1 | No Scale.                                   |  |

SHAKER 3" CROWN  
MOLDING

24" D CAB W/  
SIDE PANEL

TAKEOFF 3" EACH SIDE  
TO ACCOMMODATE  
CHIMNEY HOOD.


POT/PAN  
DRAWERS.

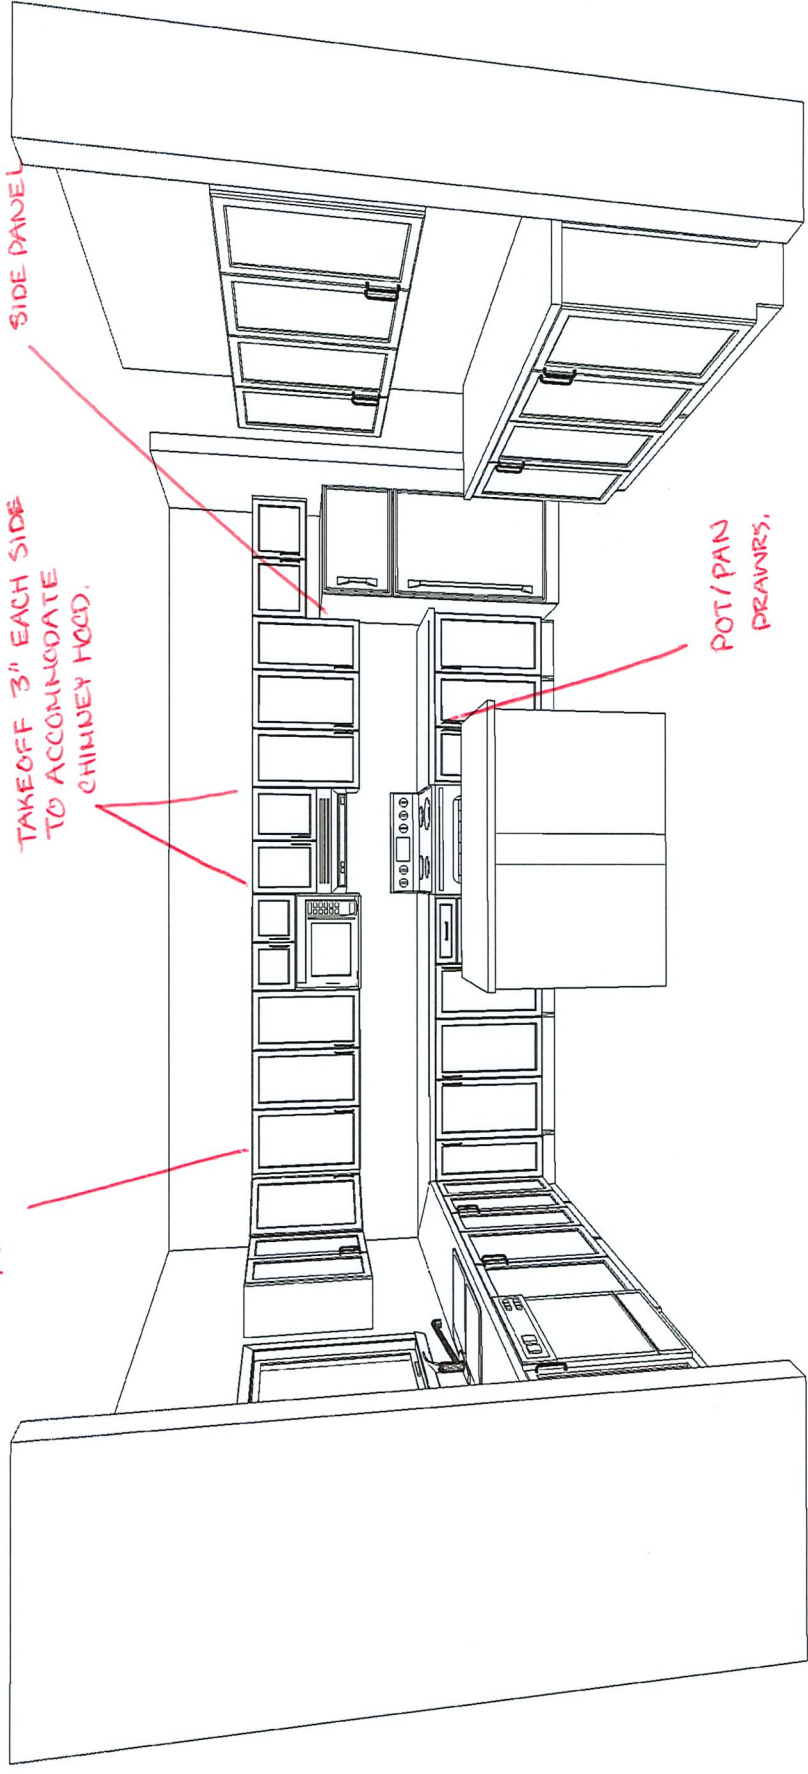

MOUNTING HT 96"

3D KITCHEN VIEW #1  
509 ANNAPOLIS

|                                                                                                                                     |                                                                                     |                                             |  |
|-------------------------------------------------------------------------------------------------------------------------------------|-------------------------------------------------------------------------------------|---------------------------------------------|--|
| Note: This drawing is an artistic interpretation of the general appearance of the design. It is not meant to be an exact rendition. |  | Designed: 2014-03-24<br>Printed: 2014-06-16 |  |
|                                                                                                                                     |                                                                                     |                                             |  |
| 509 Annapolis Kit.kit                                                                                                               | All                                                                                 | Drawing #: 1                                |  |

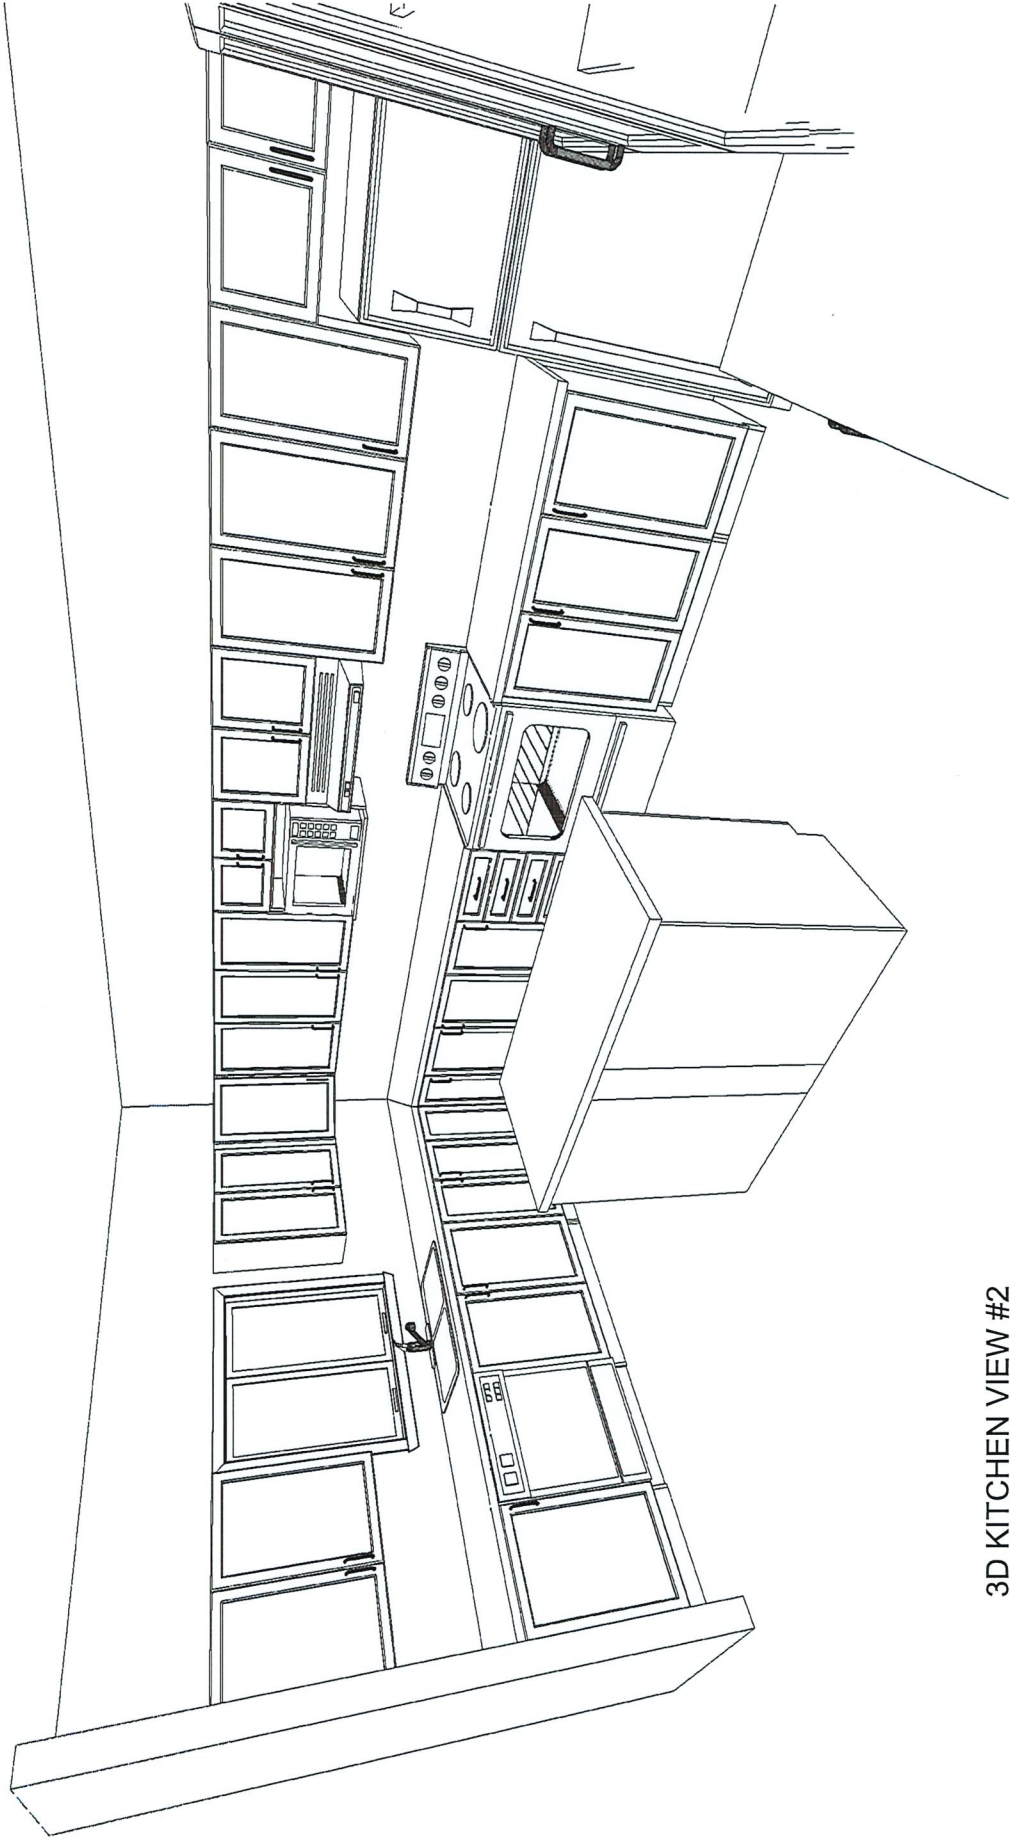

3D KITCHEN VIEW #2

509 ANNAPOLIS

Note: This drawing is an artistic interpretation of the general appearance of the design. It is not meant to be an exact rendition.




Designed: 2014-03-24  
Printed: 2014-06-16

509 Annapolis Kit.kit


All

Drawing #: 1

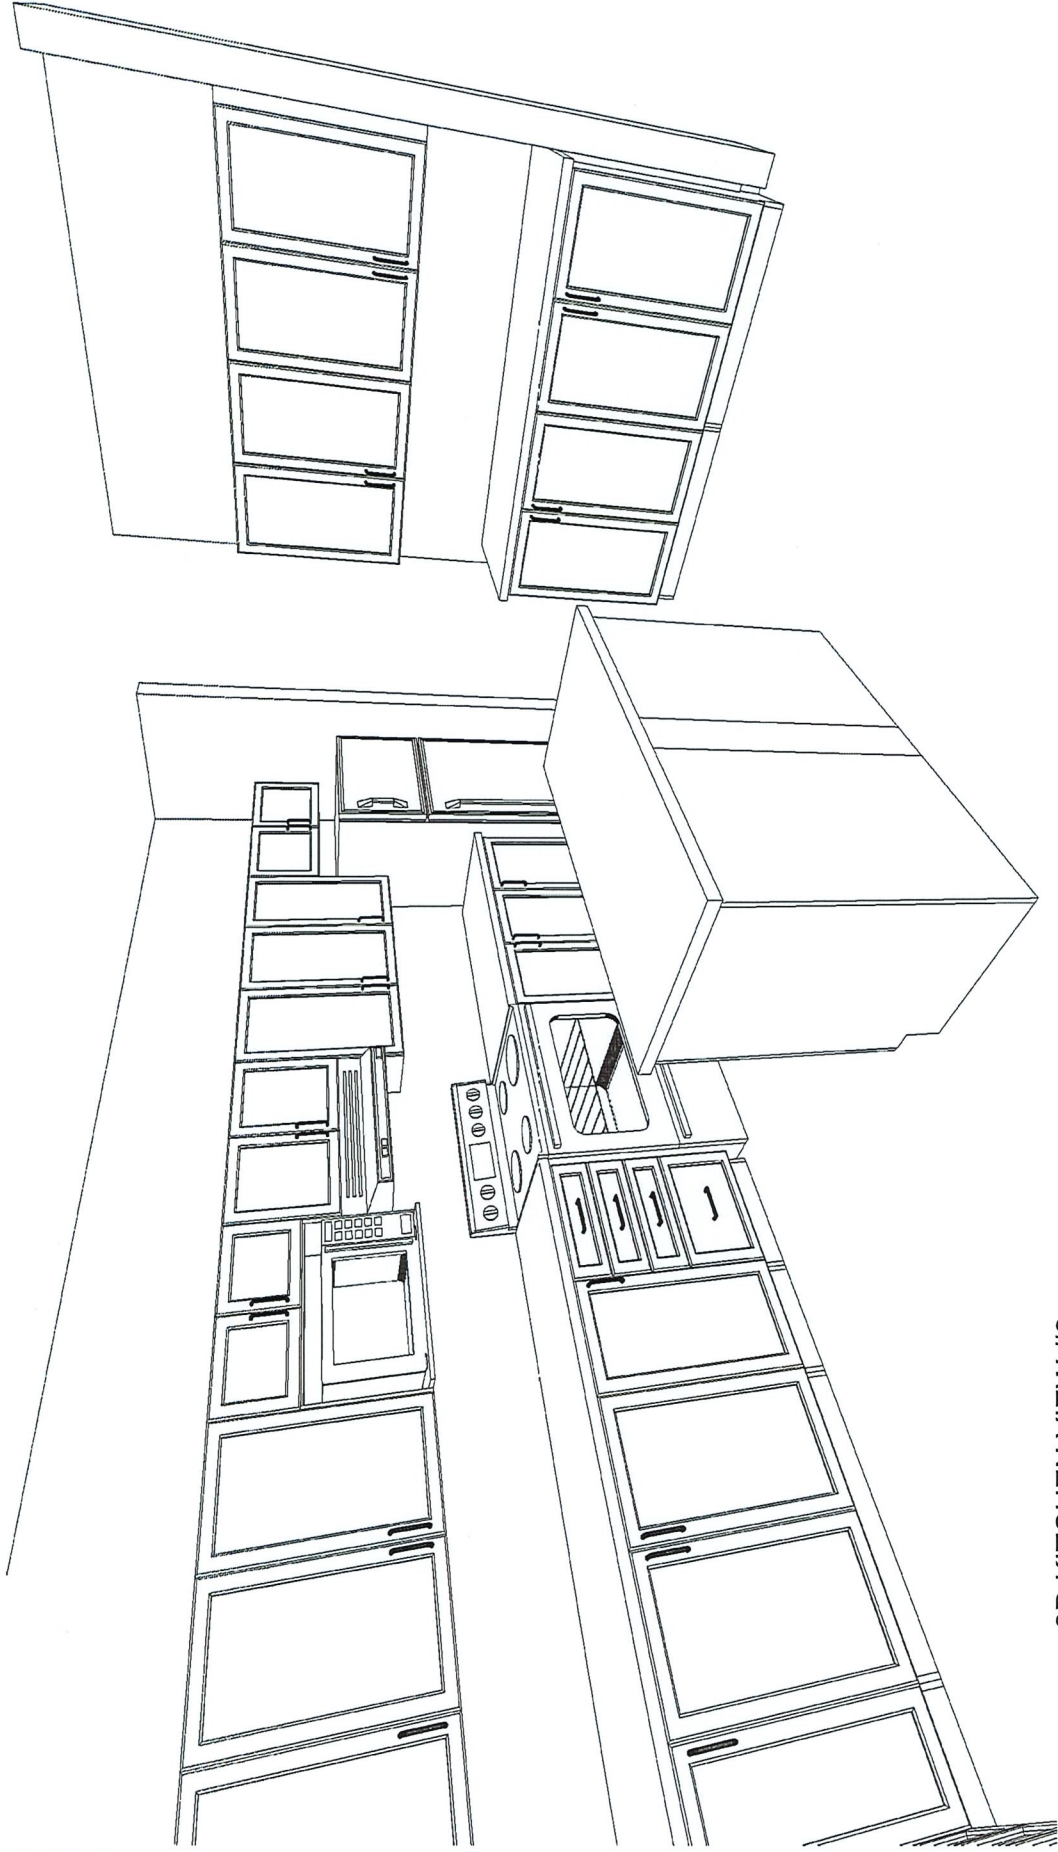

3D KITCHEN VIEW #3  
509 ANNAPOLIS


|                                                                                                                                     |                                                                                     |                                             |              |
|-------------------------------------------------------------------------------------------------------------------------------------|-------------------------------------------------------------------------------------|---------------------------------------------|--------------|
| Note: This drawing is an artistic interpretation of the general appearance of the design. It is not meant to be an exact rendition. |  | Designed: 2014-03-24<br>Printed: 2014-06-16 | Drawing #: 1 |
|                                                                                                                                     |                                                                                     |                                             | All          |

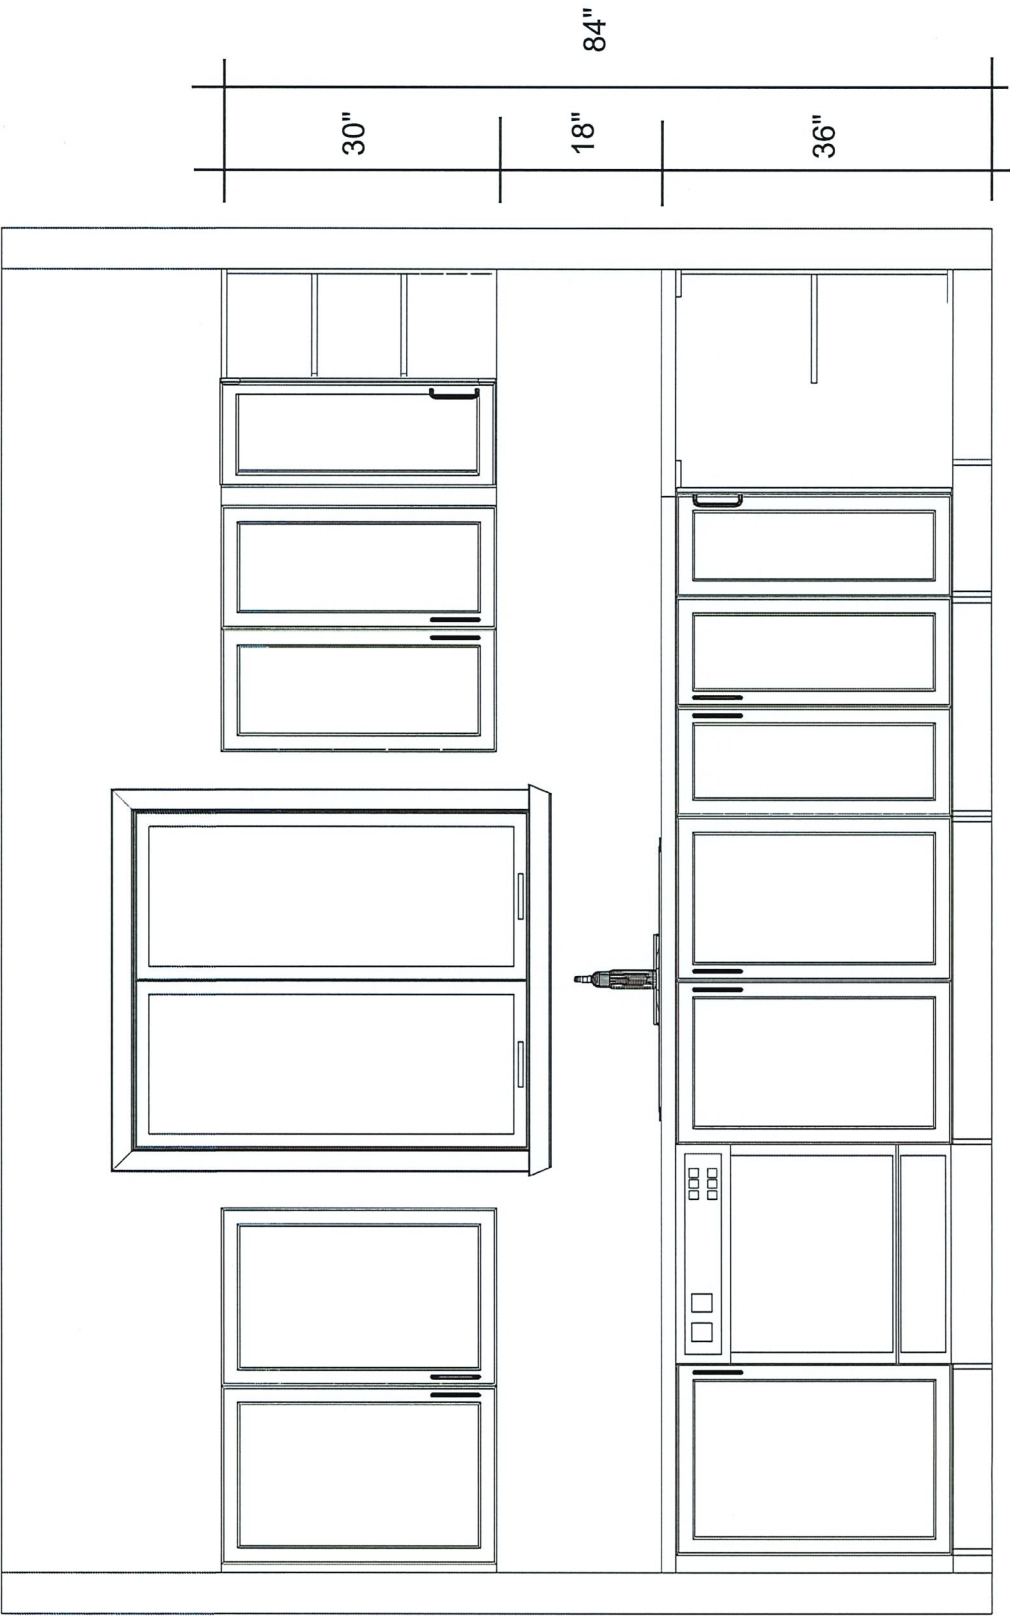

SINK WALL ELEVATION  
509 ANNAPOLIS

|                                                                                                                                     |                                                                                     |                                             |              |
|-------------------------------------------------------------------------------------------------------------------------------------|-------------------------------------------------------------------------------------|---------------------------------------------|--------------|
| Note: This drawing is an artistic interpretation of the general appearance of the design. It is not meant to be an exact rendition. |  | Designed: 2014-03-24<br>Printed: 2014-06-16 | Drawing #: 1 |
|                                                                                                                                     |                                                                                     |                                             | All          |

509 Annapolis Kit.kit

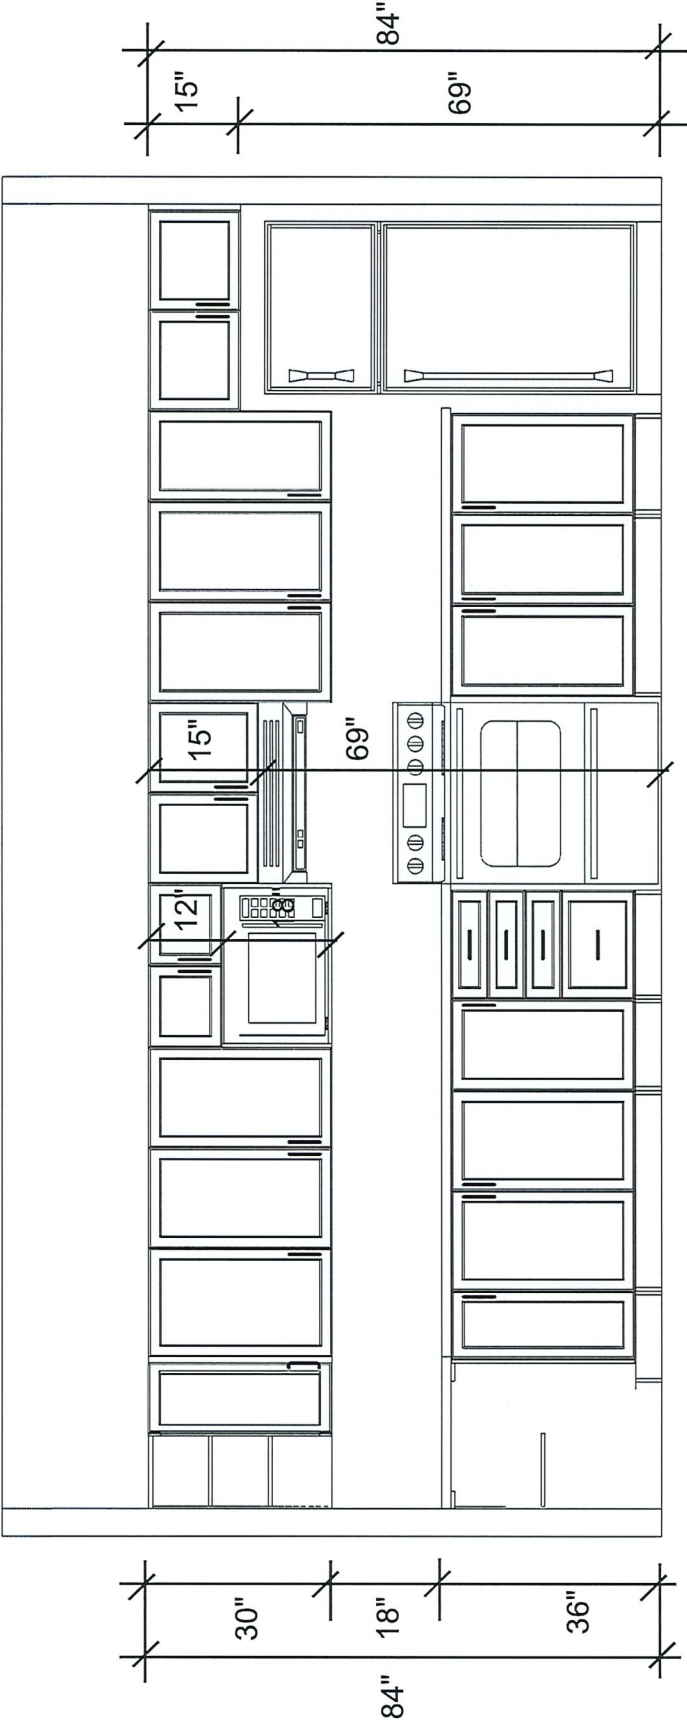

STOVE & FRIDGE WALL ELEVATION  
509 ANNAPOLIS

Note: This drawing is an artistic interpretation of the general appearance of the design. It is not meant to be an exact rendition.



Designed: 2014-03-24  
Printed: 2014-06-16