



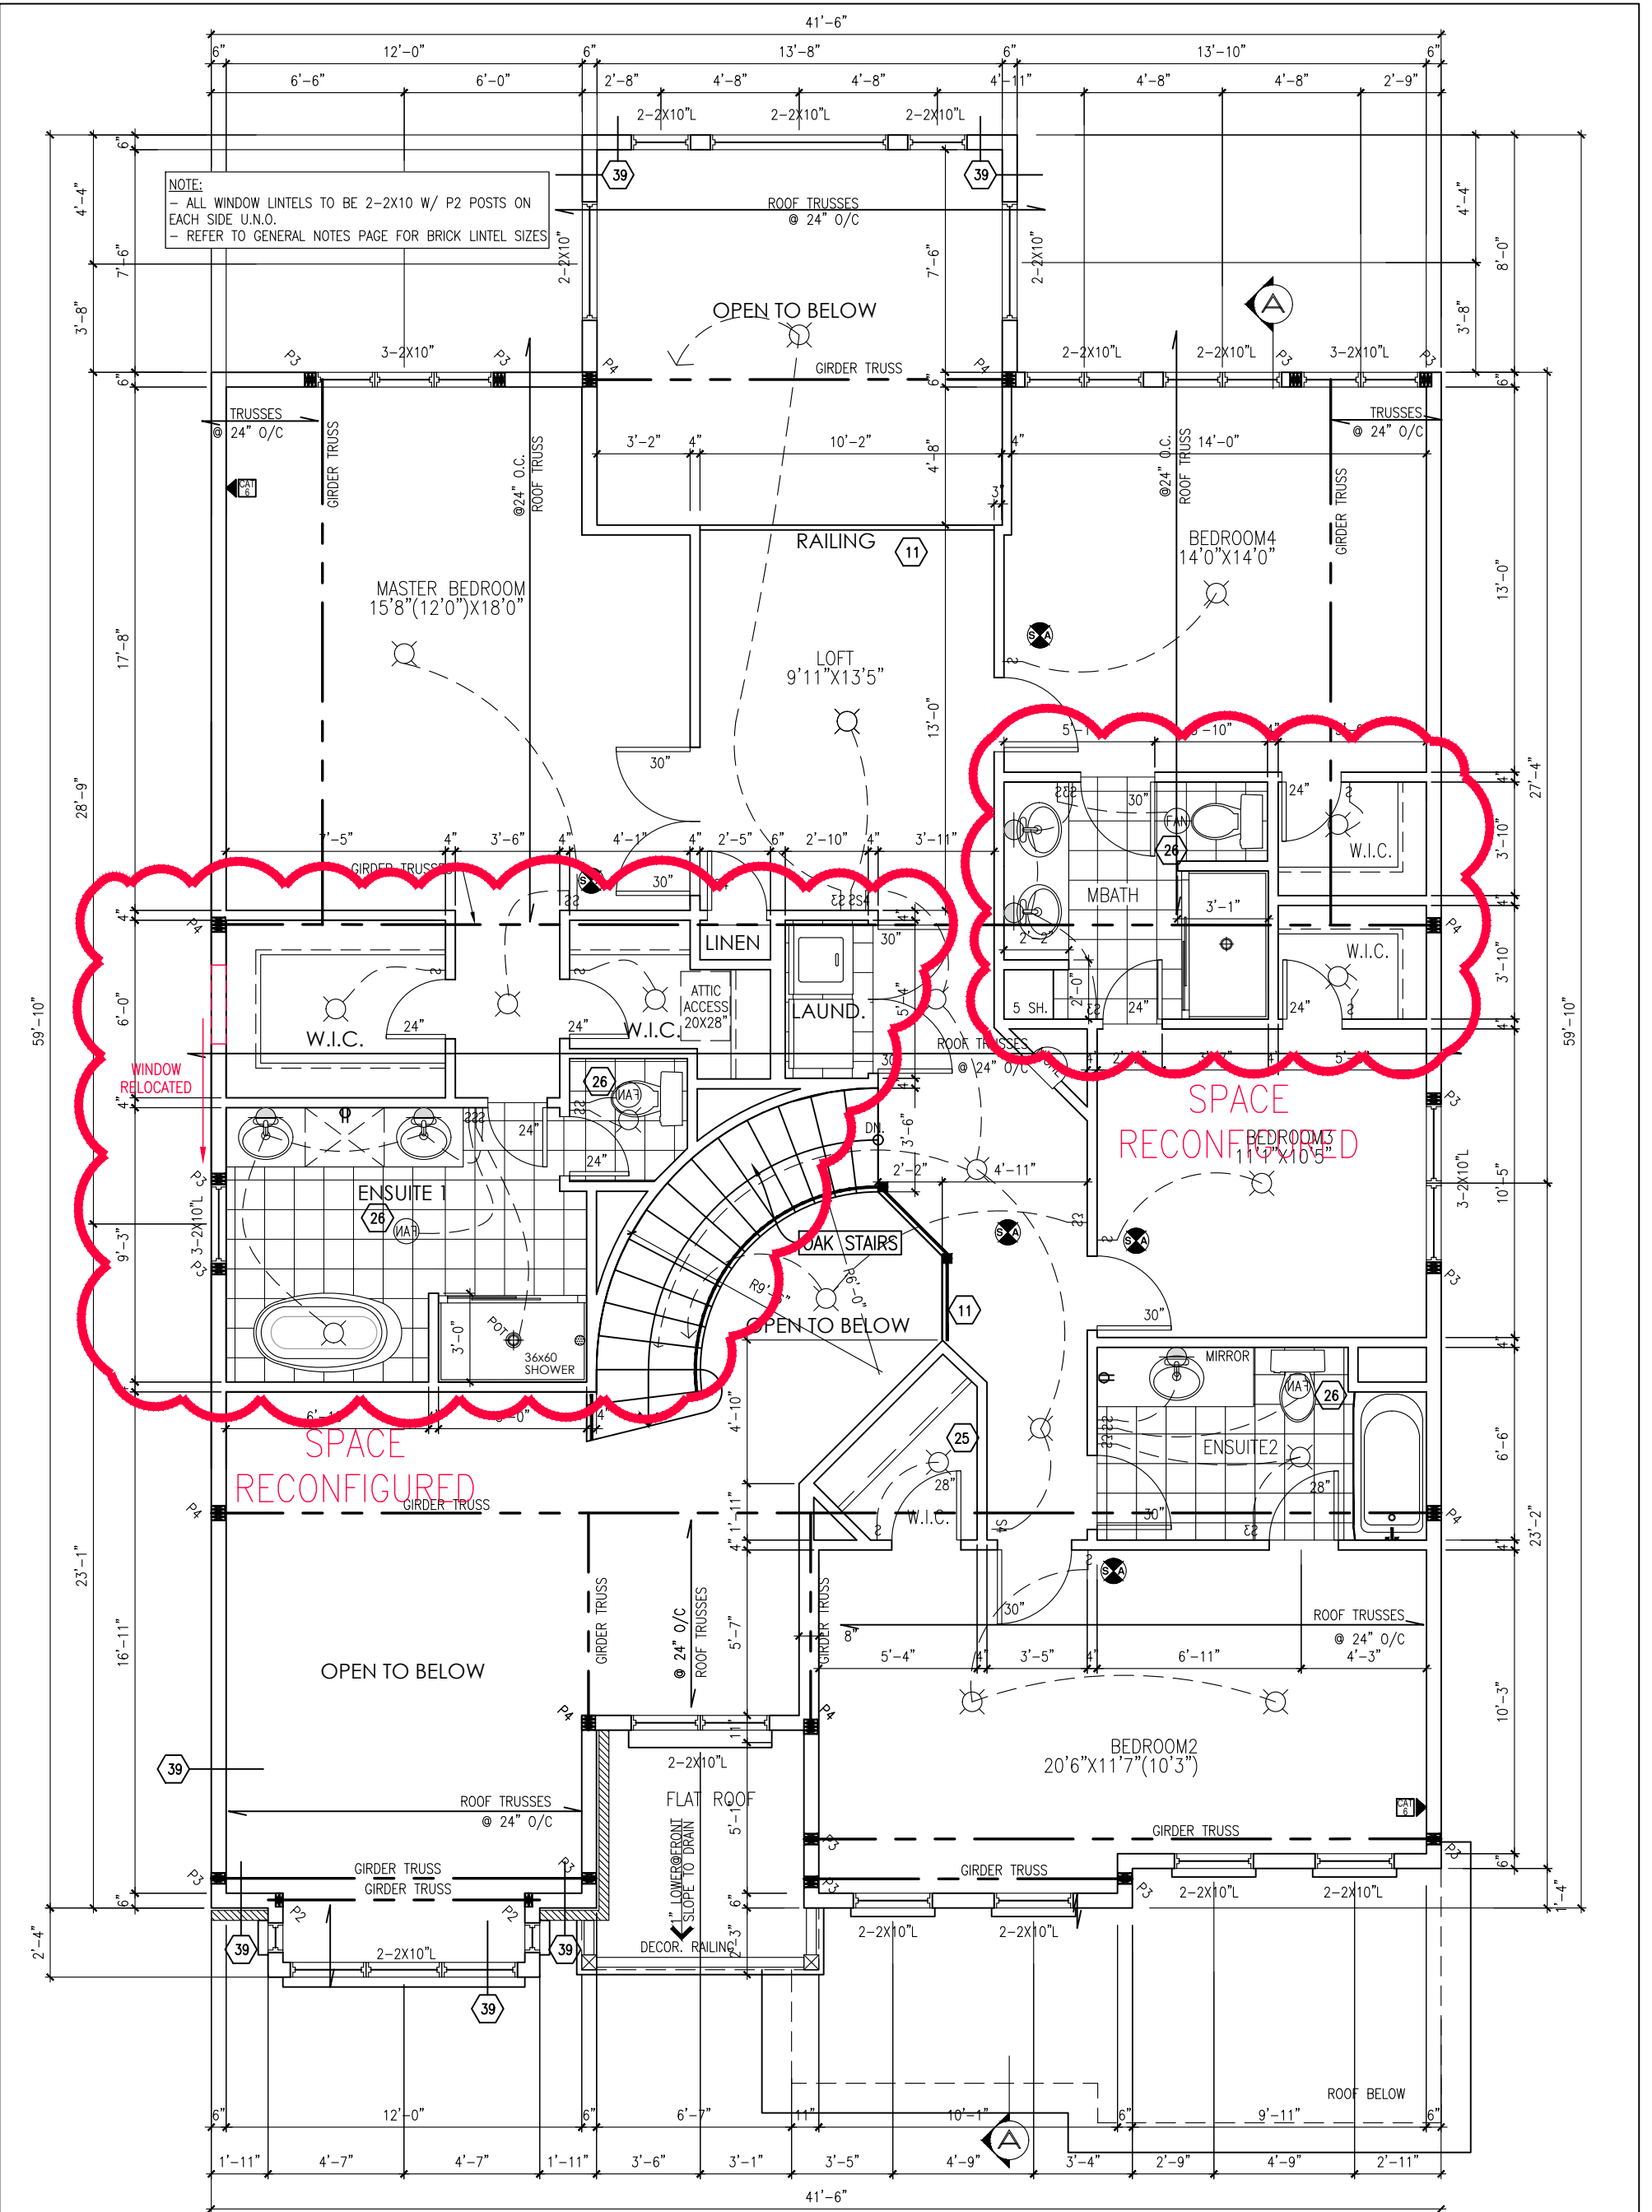

SECOND FLOOR PLAN ELEV. E – 1672 SF

9' SECOND FLOOR

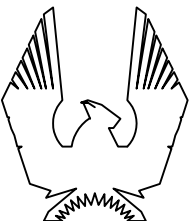

PHOENIX HOMES

ANNAPOLIS-2019-E

SITE:PATHWAYS

LOT NUMBER: 19

CIVIC ADDRESS:
21 SALAMANDER WAY

8	ISSUED FOR PERMIT	SEPT-16-21	SP
7	BEP BLACKLINES	AUG-23-21	SP
6	STRUCTURAL REVIEW	JUN-25-19	SP
5	ADD GARAGE WALL HEIGHTS	SEP-20-18	SP
No.	Description	Date	By
REVISIONS			

file number: 509

drawn by: T.L.

date: DEC. 2012

scale: 3/16"=1'

DCL-198
sheet no:

16

4E
9