

DCR - PHOENIX HOMES

LOT #44

DIAMONDVIEW ESTATES 2

NEWINGTON
STANDARD KITCHEN

MOUNTING HEIGHT: 96

42" UPPERS @ 18" A.C.

FILL TO CEILING
WITH 1" MOULDING,
FURRING PANEL &
CEILING CROWN

KITCHEN

CABINETS -

HARDWARE -

STANDARD WHITE INTERIOR


METAL DRAWER BOX

4 PCS - 5/8" KICK - FIN, BOTH ENDS

2 PCS - 90 DEG. CORNER MOULD

1 PCS - T-MOULD

5 PCS - FLAT MOULDING

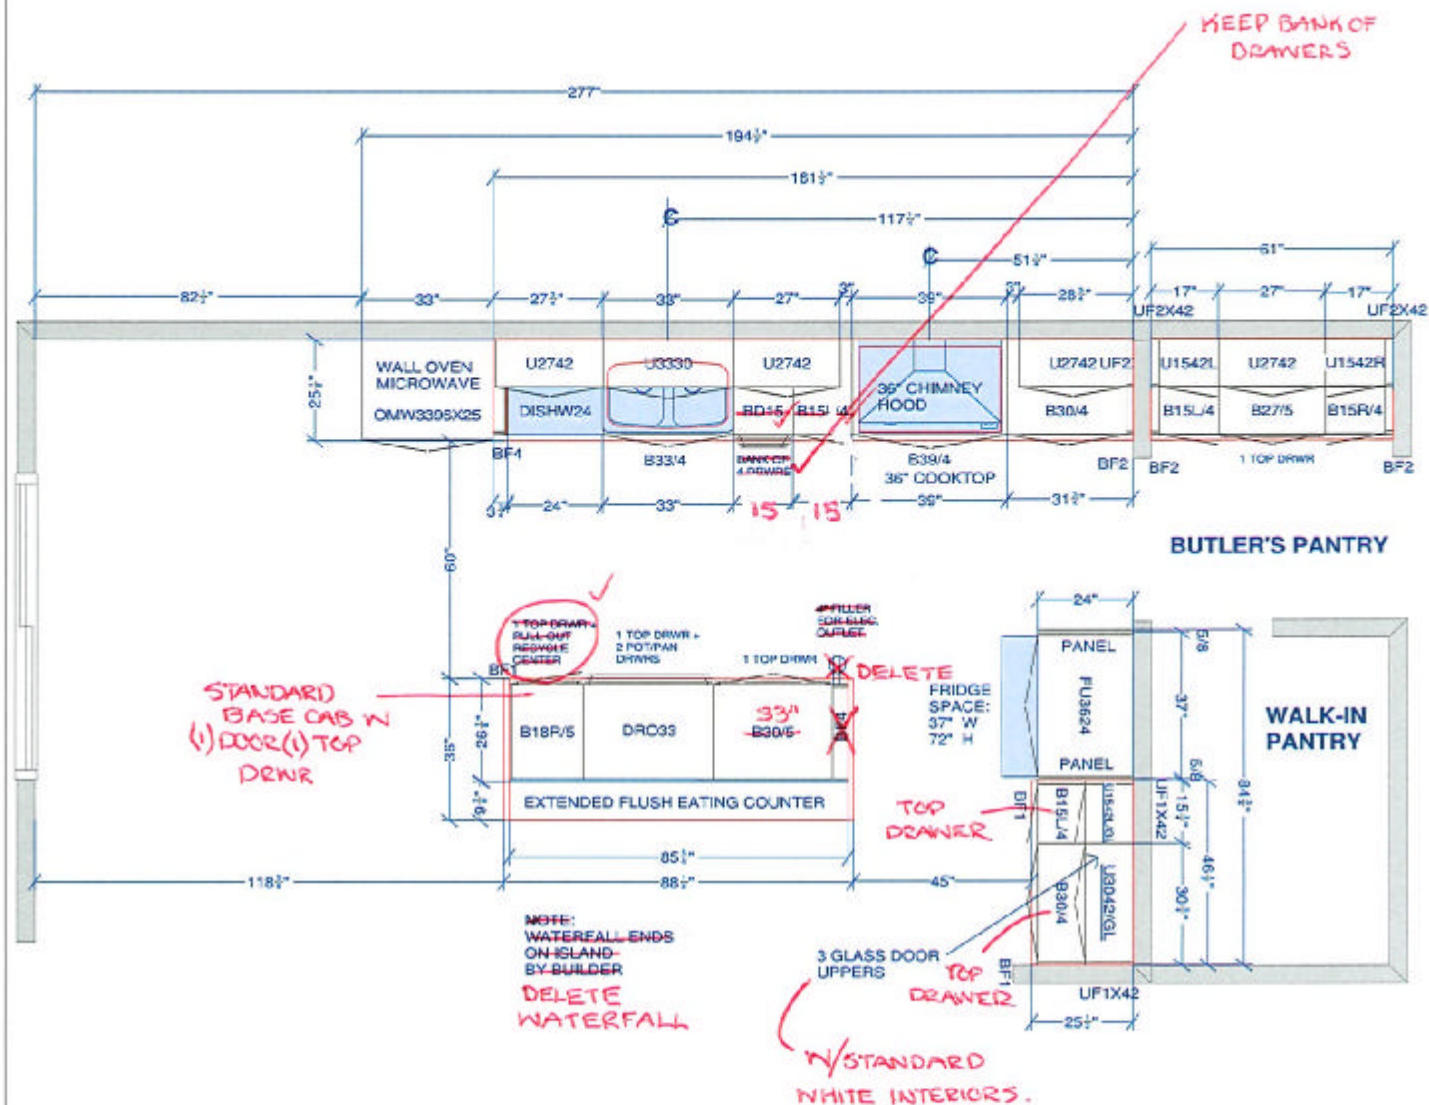

All dimensions & size designations given are subject to verification on job site and adjustment to fit job conditions.

SPECTRUM KITCHEN and BATH
DESIGN



This is an original design and must not be released or copied unless applicable fee has been paid or job order placed.

DRAWN BY: LORI DISAVERIO, B.I.D


Designed: 2021-09-19
Printed: 2021-09-19

DCR #44 Diamondview Estates 2 - NEWINGTON - STD KITCHEN.kit

ΔΠ

Drawing #: 1	No Scale.
--------------	-----------

DS DS
JML DLV

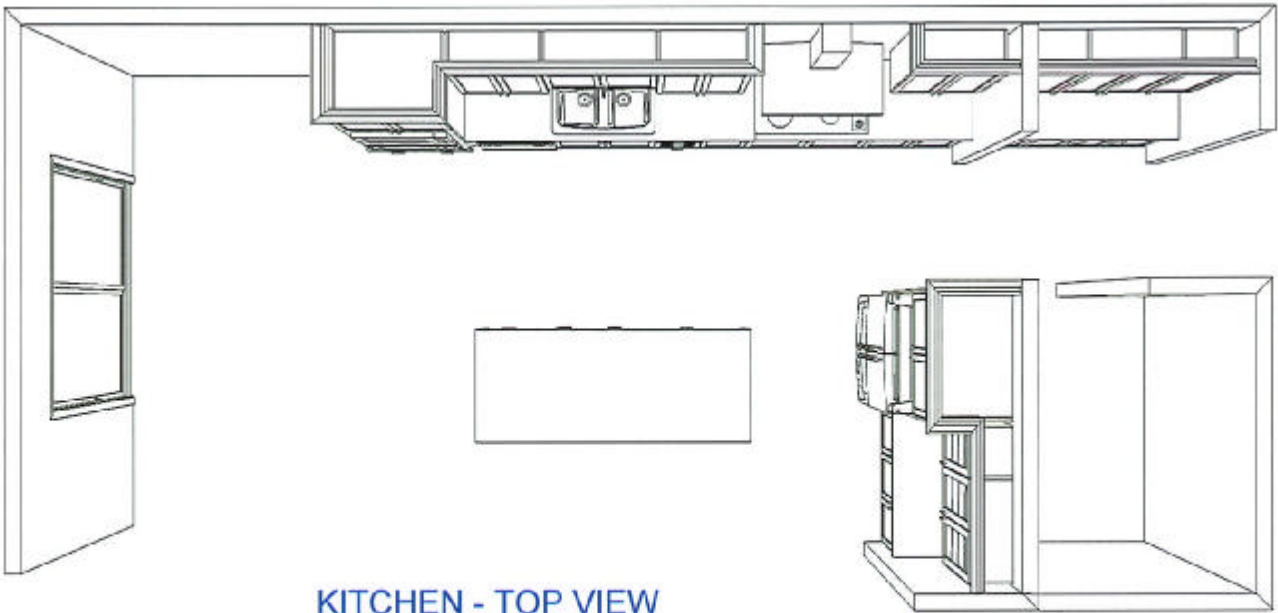

KITCHEN - TOP VIEW

CUSTOMER APPROVAL

I have reviewed these drawings and understand the details of the design and the CARTIER KITCHENS specifications.

Signature _____

Date _____

Note: This drawing is an artistic interpretation of the general appearance of the design. It is not meant to be an exact rendition.




Designed: 2021-09-19
Printed: 2021-09-19

SPECTRUM KITCHEN and BATH DESIGN

DCR #44 Diamondview Estates 2 - NEWINGTON -

All


Drawing #: 1

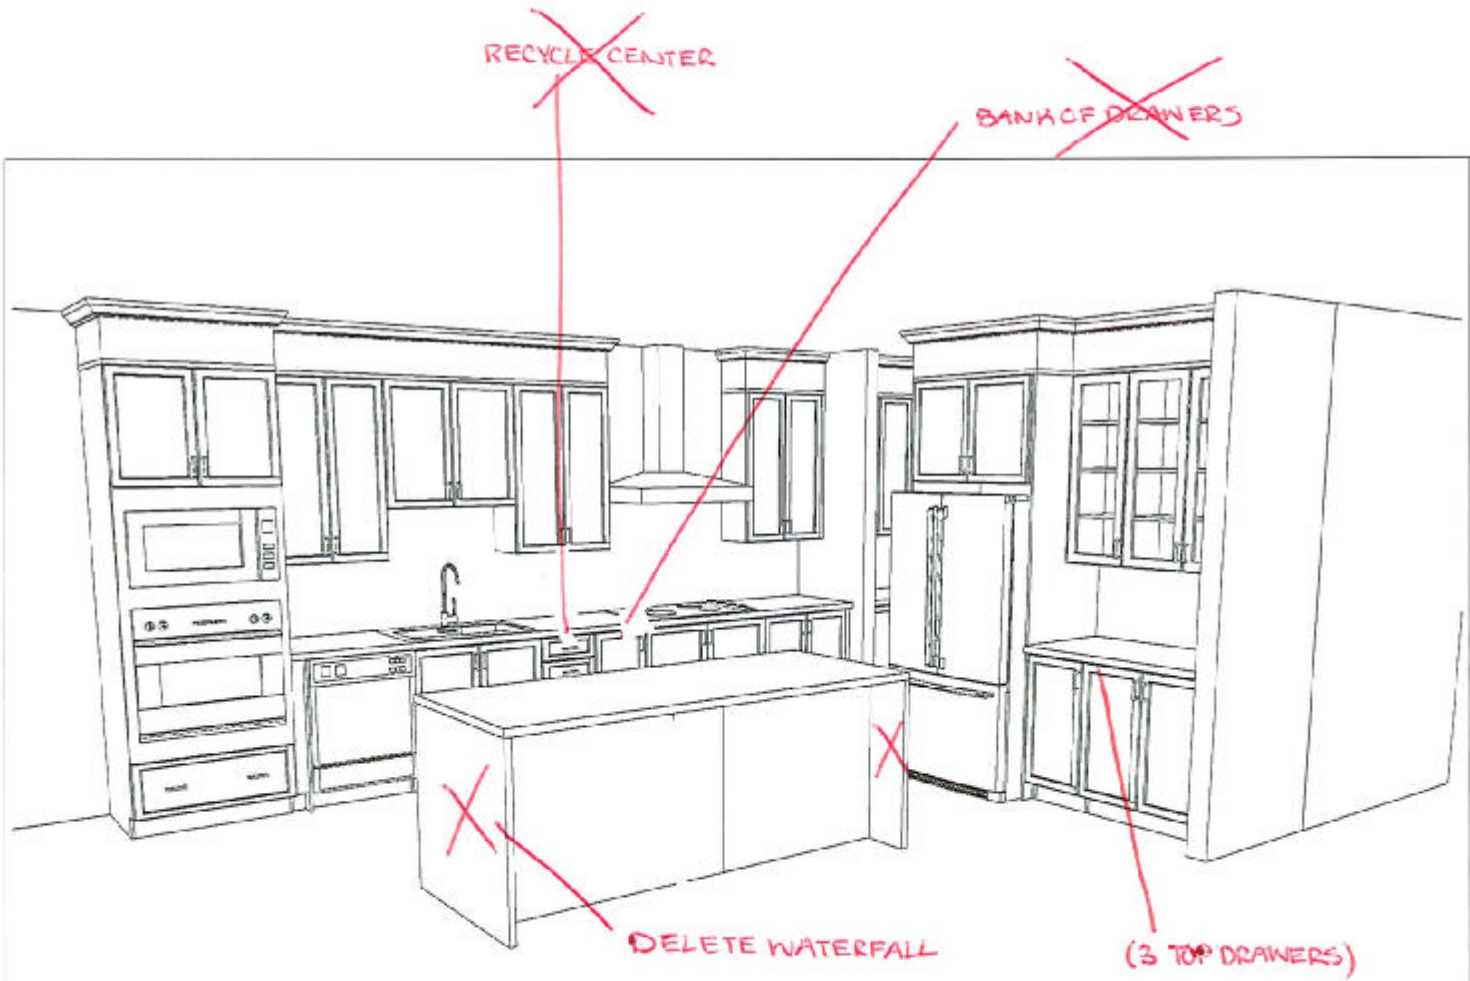

KITCHEN - 3D VIEW #1

CUSTOMER APPROVAL	
I have reviewed these drawings and understand the details of the design and the CARTIER KITCHENS specifications.	
Signature _____	
Date _____	


Note: This drawing is an artistic interpretation of the general appearance of the design. It is not meant to be an exact rendition.		Digned: 2021-09-19
		Printed: 2021-09-19
SPECTRUM KITCHEN and BATH DESIGN		
DCR #44 Diamondview Estates 2 - NEWINGTON -	All	Drawing #: 1

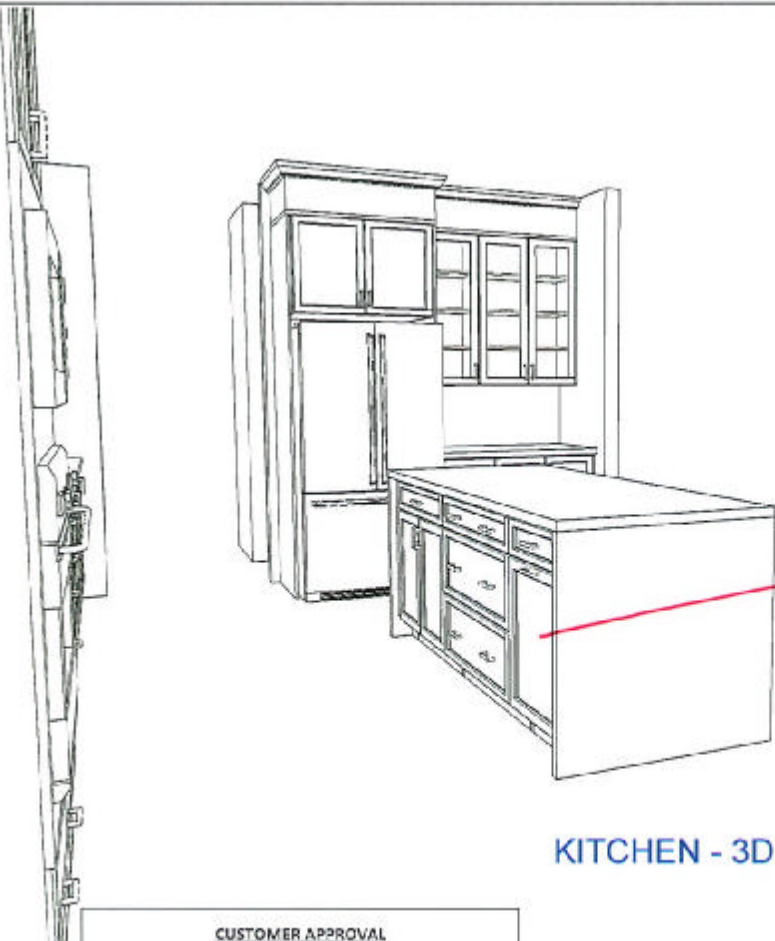

KEEP.
~~DELETE RECYCLE
CENTRE
STANDARD BASE
CAB W/ (1) TOP
DRAWER~~

KITCHEN - 3D VIEW #2

CUSTOMER APPROVAL I have reviewed these drawings and understand the details of the design and the CANTIER KITCHENS specifications. Signature: _____ Date: _____	Note: This drawing is an artistic interpretation of the general appearance of the design. It is not meant to be an exact rendition. SPECTRUM KITCHEN and BATH DESIGN DCR #44 Diamondview Estates 2 - NEWINGTON - All	 Designed: 2021-09-19 Printed: 2021-09-19	Drawing #: 1
--	---	--	---------------------

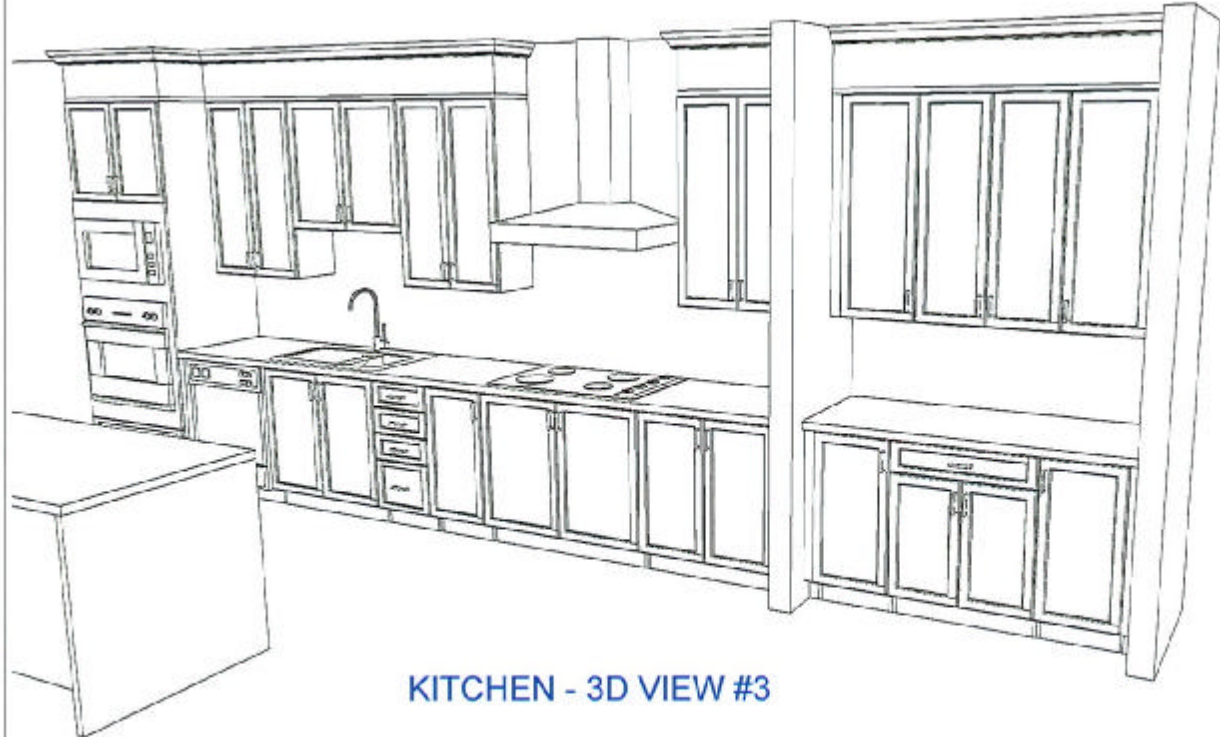

KITCHEN - 3D VIEW #3

CUSTOMER APPROVAL

I have reviewed these drawings and understand the details of the design and the CARTIER KITCHENS specifications.

Signature _____

Date _____

Note: This drawing is an artistic interpretation of the general appearance of the design. It is not meant to be an exact rendition.

SPECTRUM KITCHEN and BATH DESIGN

DCR #44 Diamondview Estates 2 - NEWINGTON -



Dsgn: 2021-09-19

Printed: 2021-09-19

All

Drawing #: 1

DS

JML

DS

DEL



OVEN / SINK / COOKTOP WALL ELEVATION BUTLER'S PANTRY

CUSTOMER APPROVAL

I have reviewed these drawings and understand the details of the design and the CARTIER KITCHENS specifications.

Signature _____

Date _____

Note: This drawing is an artistic interpretation of the general appearance of the design. It is not meant to be an exact rendition.		Designed: 2021-09-19
		Printed: 2021-09-19
SPECTRUM KITCHEN and BATH DESIGN		
DCR #44 Diamondview Estates 2 - NEWINGTON -	All	Drawing #: 1

DS DS
JML D&V



FRIDGE WALL ELEVATION

CUSTOMER APPROVAL

I have reviewed these drawings and understand the details of the design and the CARTIER KITCHENS specifications.

Signature _____

Date _____

Note: This drawing is an artistic interpretation of the general appearance of the design. It is not meant to be an exact rendition.

SPECTRUM KITCHEN and BATH DESIGN



Designed: 2021-09-19
Printed: 2021-09-19

DCR #44 Diamondview Estates 2 - NEWINGTON -

All

Drawing #: 1