
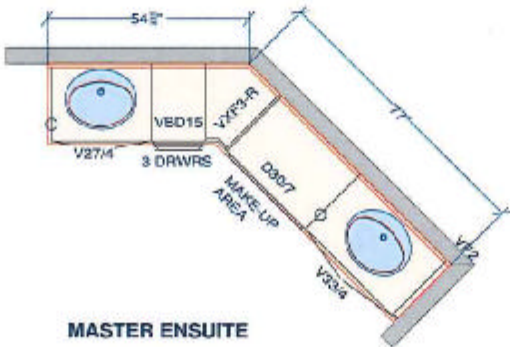
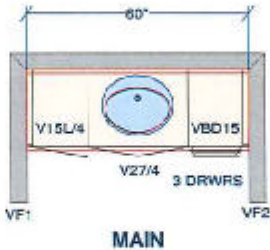
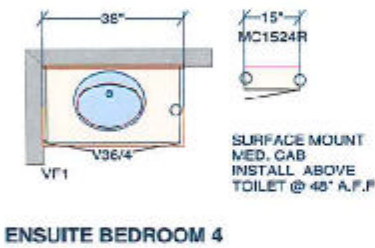
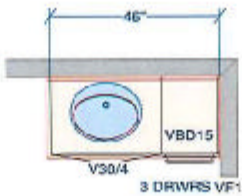


DCR PHOENIX HOMES

NEWINGTON
VANITIES

- LINE 1 & 2
HARDWARE - STD & 1ST UPGRADE
STANDARD WHITE INTERIOR
METAL DRAWER BOX
6 PCS - 5/8" KICK - FIN. BOTH ENDS
6 PCS - FLAT MOULDING

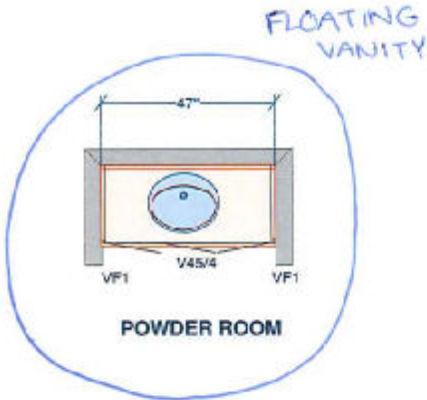

All dimensions ,size designations
given are subject to verification on
job site and adjustment to fit job
conditions.



This is an original design and must
not be released or copied unless
applicable fee has been paid or job
order placed.

Designed: 2017-07-20
Printed: 2017-07-27


NEWINGTON - VANITIES

All

Drawing #: 1 No Scale.

DS
DEL


DS
JML

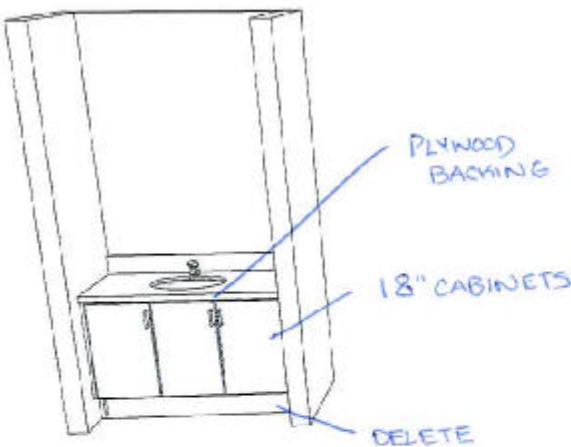

POWDER ROOM VANITY



IN-LAW ENSUITE VANITY

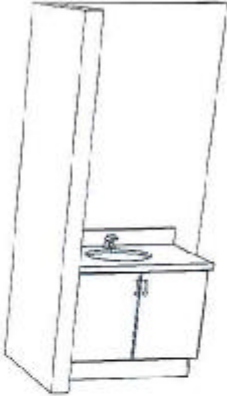

BDRM #4 ENSUITE


CUSTOMER APPROVAL	
I have reviewed these drawings and understand the details of the design and the CARTIER KITCHENS specifications.	
Signature _____	
Date _____	

Note: This drawing is an artistic interpretation of the general appearance of the design. It is not meant to be an exact rendition.		Designed: 2019-09-04	
		Printed: 2021-05-04	
SPECTRUM KITCHEN and BATH DESIGN			
NEWINGTON - VANITIES - 4 bdrm.kit		All	Drawing #: 1

DS DS
DEV JML



MAIN BATH VANITY

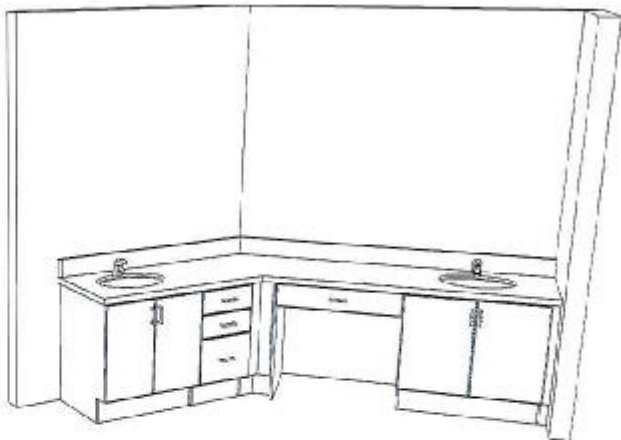

MASTER ENSUITE VANITY

CUSTOMER APPROVAL

I have reviewed these drawings and understand the details of the design and the CARTIER KITCHENS specifications.

Signature _____

Date _____

Note: This drawing is an artistic interpretation of the general appearance of the design. It is not meant to be an exact rendition.

SPECTRUM KITCHEN and BATH DESIGN

NEWINGTON - VANITIES - 4 bdrm.kit



Designed: 2019-09-04
Printed: 2021-05-04

All

Drawing #: 1

DS
DKV

DS
JML