

DCR PHOENIX HOMES


LOT #29
WHITE TAIL RIDGE 2
NEWINGTON
OPTIONAL CHEF'S KITCHEN
GARAGE RIGHT

MOUNTING HEIGHT: 96

39"H UPPERS @ 21" ABOVE COUNTER
LIGHT VALANCE
CROWN MOULDING - SHAKER STYLE

- CABINETS -
- HARDWARE -
- STANDARD WHITE INTERIOR
- METAL DRAWER BOX
- 3 PCS - 5/8" KICK - FIN. BOTH ENDS
- 3 PCS - LOOSE FILLER - 3 x 96
- 2 PCS - 90 DEG. CORNER MOULD
- 1 PCS - T-MOULD
- 1 PCS - FLAT MOULDING

REVISED: JAN 29-21
CHIMNEY HOODFAN + 3" SPACE
BESIDE EACH

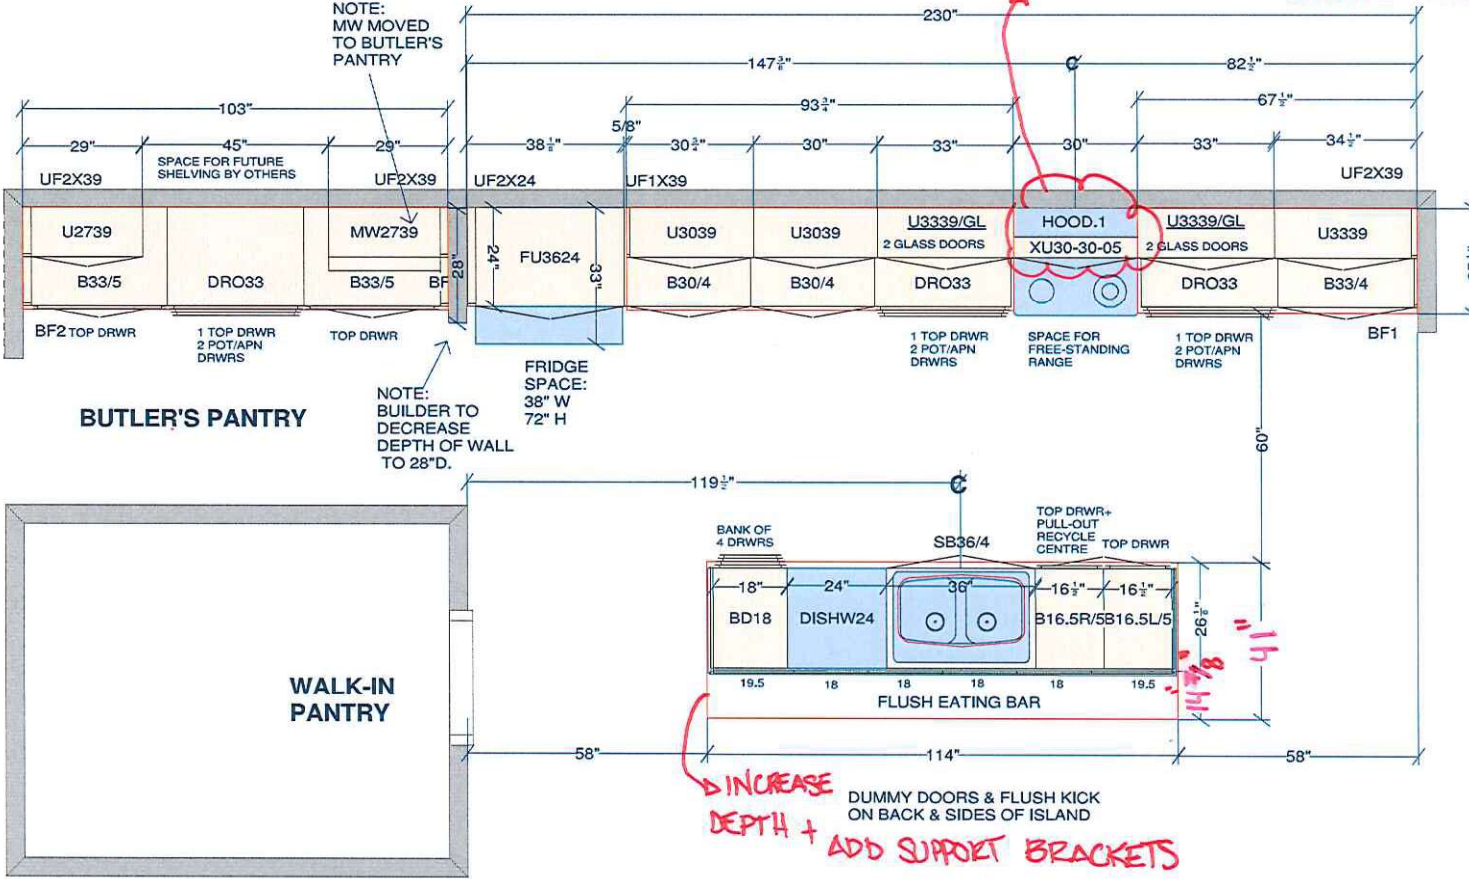

All dimensions, size designations given are subject to verification on job site and adjustment to fit job conditions.

SPECTRUM KITCHEN and BATH DESIGN



This is an original design and must not be released or copied unless applicable fee has been paid or job order placed.


DRAWN BY: LORI DISAVERIO, B.I.D

Designed: 2021-01-29
Printed: 2021-01-29

DCR #29 WTR2 - NEWINGTON - OPT. CHEF'S KITCHEN 2 .kit

All

Drawing #: 1 No Scale.

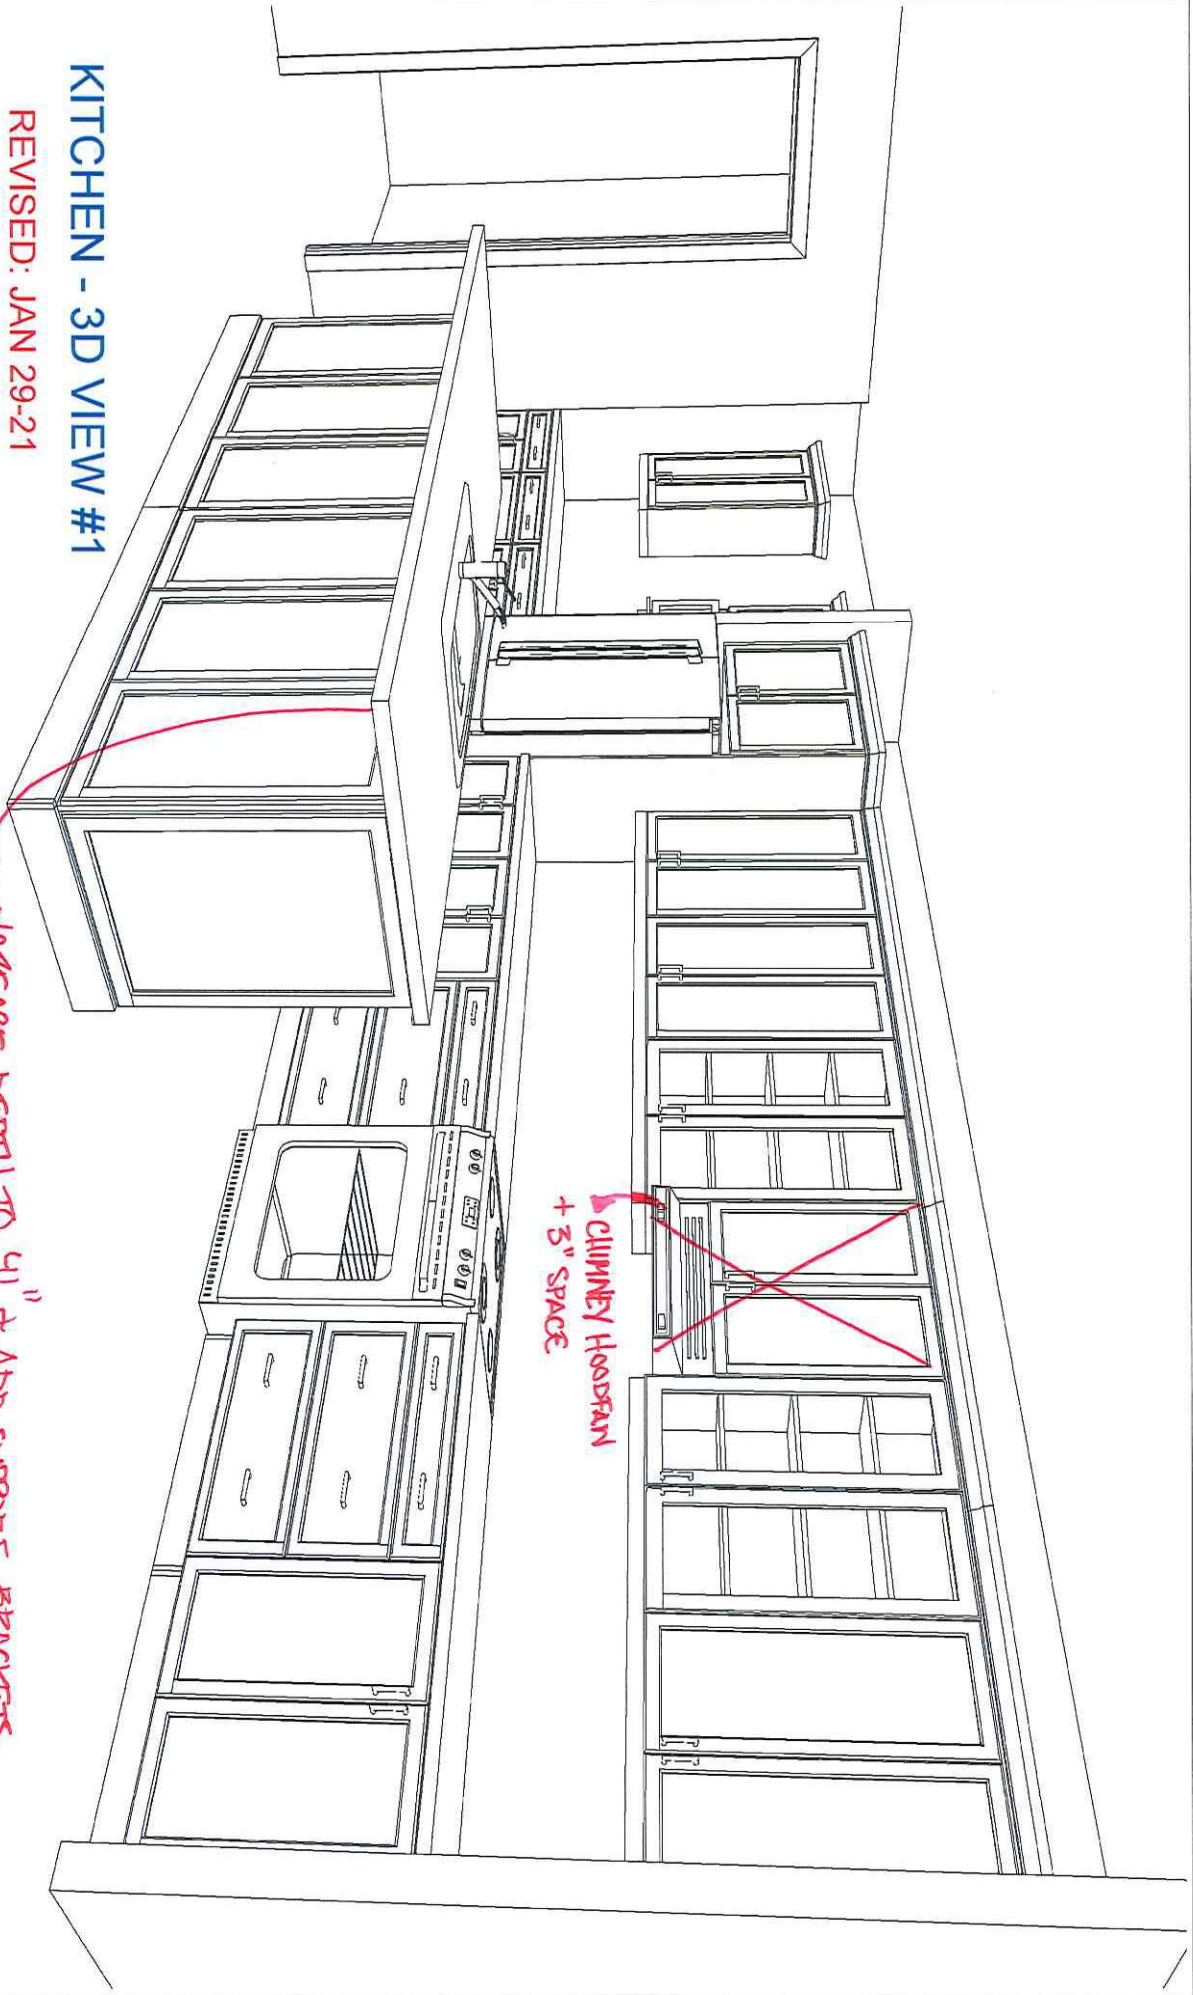

KITCHEN - 3D VIEW #1

REVISED: JAN 29-21

CUSTOMER APPROVAL

I have reviewed these drawings and understand the details of the design and the CARTIER KITCHENS specifications.

Signature _____

Date _____

Note: This drawing is an artistic interpretation of the general appearance of the design. It is not meant to be an exact rendition.




Designed: 2021-01-29
Printed: 2021-01-29

SPECTRUM KITCHEN and BATH DESIGN

DCR #29 WTR2 - NEWINGTON - OPT. CHEFS

All

Drawing #: 1

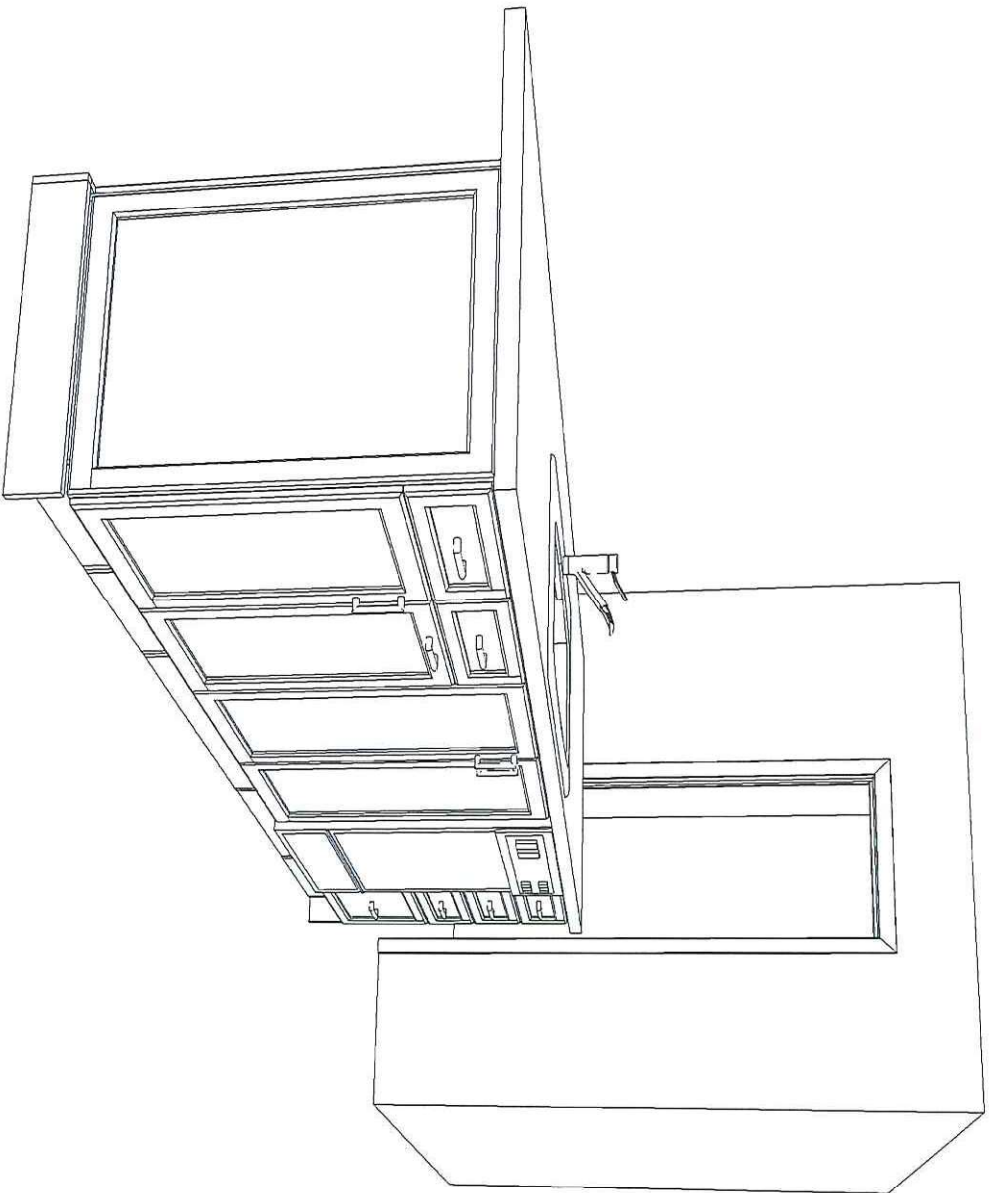

KITCHEN - 3D VIEW #2

REVISED: JAN 29-21

CUSTOMER APPROVAL

I have reviewed these drawings and understand the details of the design and the CARTIER KITCHENS specifications.

Signature _____

Date _____

Note: This drawing is an artistic interpretation of the general appearance of the design. It is not meant to be an exact rendition.

SPECTRUM KITCHEN and BATH

DESIGN


DCR #29 WTR2 - NEWINGTON - OPT. CHIEF'S

All

Drawing #: 1



Designed: 2021-01-29
Printed: 2021-01-29

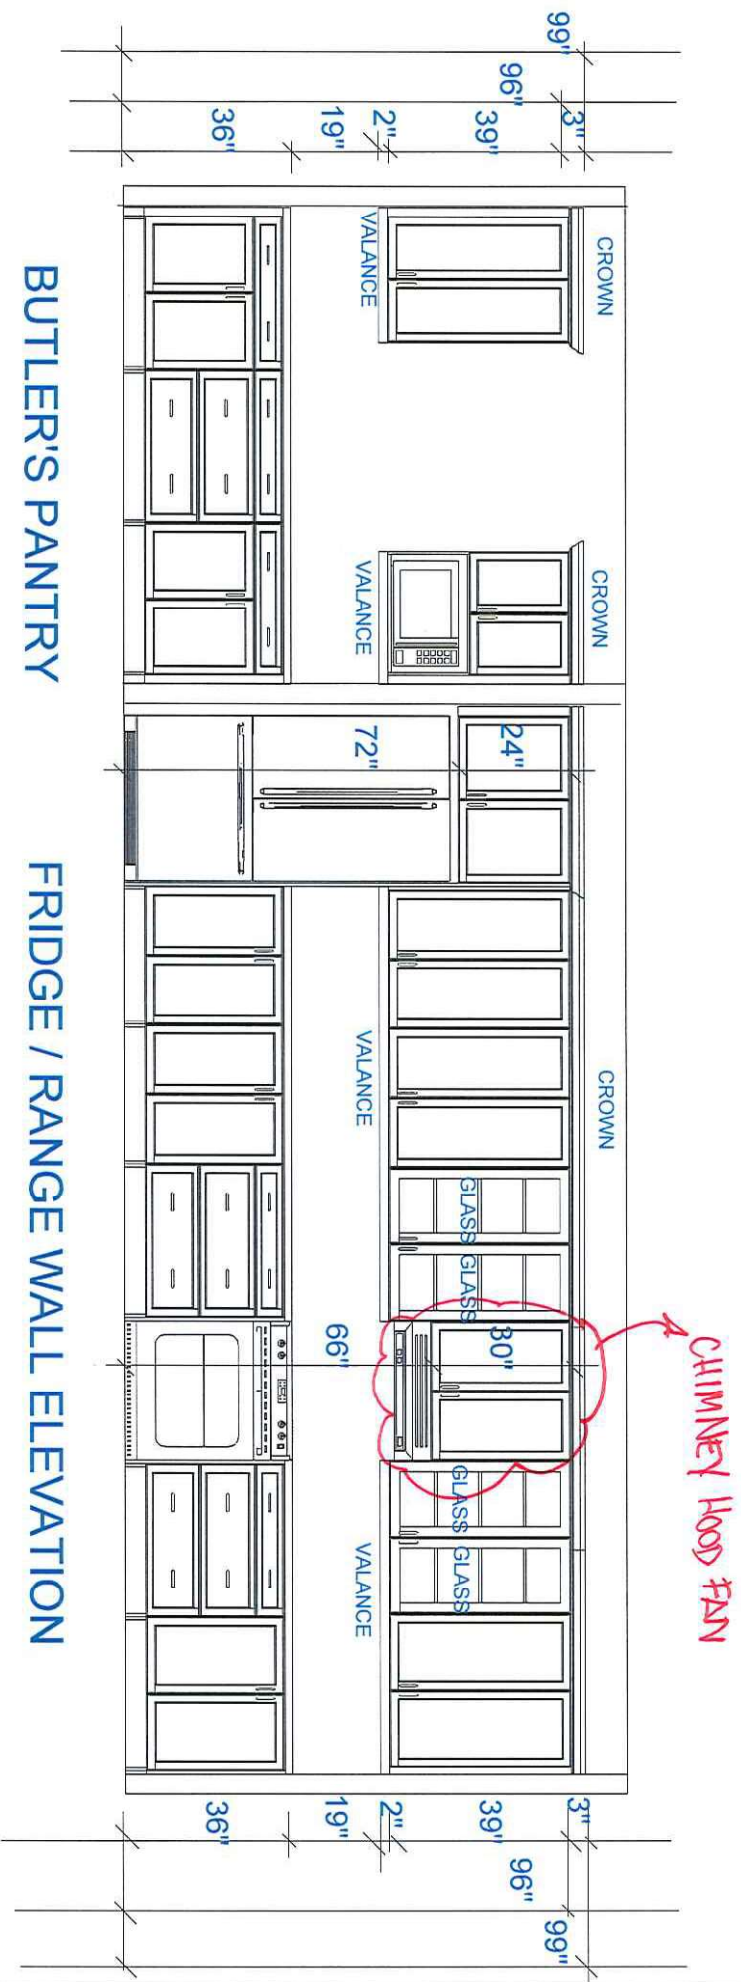

REVISED: JAN 29-21

CUSTOMER APPROVAL

I have reviewed these drawings and understand the details of the design and the CARTIER KITCHENS specifications.

Signature _____

Date _____

Note: This drawing is an artistic interpretation of the general appearance of the design. It is not meant to be an exact rendition.

SPECTRUM KITCHEN and BATH

DESIGN

DCR #29 WTR2 - NEWINGTON - OPT. CHEFS

All

Drawing #: 1




Designed: 2021-01-29
Printed: 2021-01-29

DCR PHOENIX HOMES


LOT #29
WHITE TAIL RIDGE 2
NEWINGTON - 5 BDRM
VANITIES

REVISED: JAN 29 - 21


CABINETS -
HARDWARE -
STANDARD WHITE INTERIOR
METAL DRAWER BOX
6 PCS - 5/8" KICK - FIN. BOTH ENDS
6 PCS - FLAT MOULDING

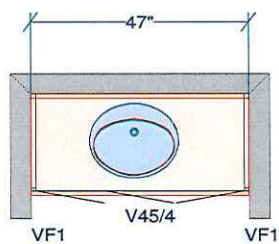

POWDER ROOM

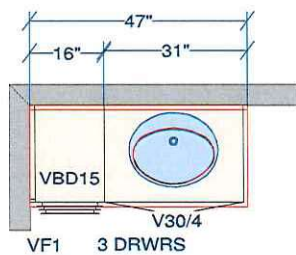


IN LAW - ENSUITE

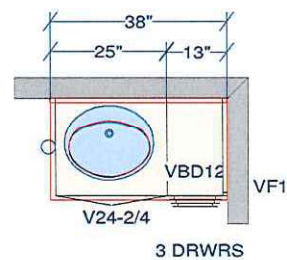


ENSUITE BEDROOM 4



SURFACE MOUNT
MED. CAB
INSTALL ABOVE
TOILET @ 48" A.F.F

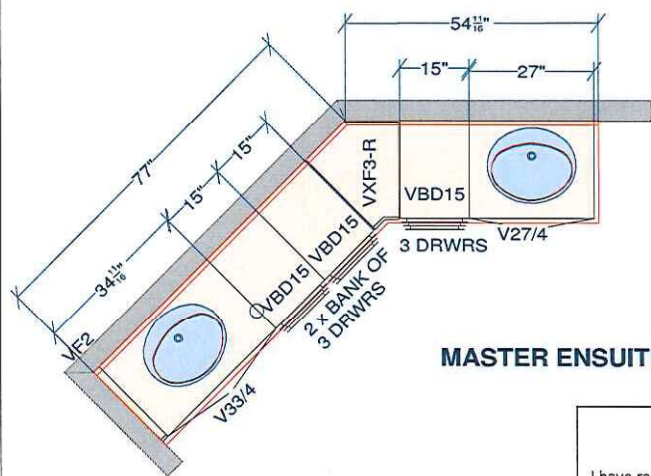

MASTER ENSUITE

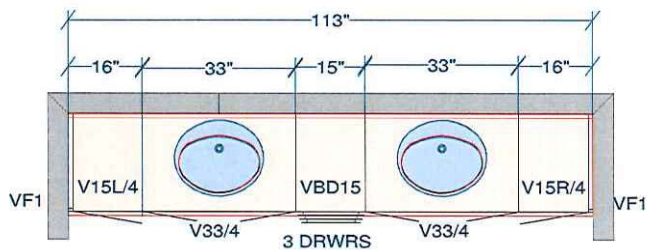

BEDROOM 3 & 5 - JACK & JILL ENSUITE

CUSTOMER APPROVAL

I have reviewed these drawings and understand the details of the design and the CARTIER KITCHENS specifications.

Signature _____

Date _____

All dimensions size designations given are subject to verification on job site and adjustment to fit job conditions.

SPECTRUM KITCHEN and BATH DESIGN



This is an original design and must not be released or copied unless applicable fee has been paid or job order placed.


DRAWN BY: LORI DISAVERIO, B.I.D

Designed: 2021-01-14
Printed: 2021-01-29


DCR #29 WTR2 - NEWINGTON - VANITIES -

All

Drawing #: 1 No Scale.

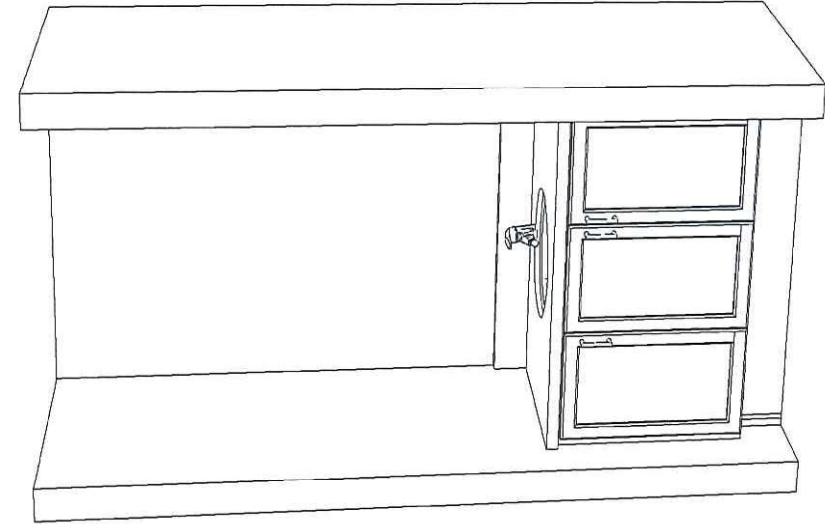

POWDER ROOM
VANITY

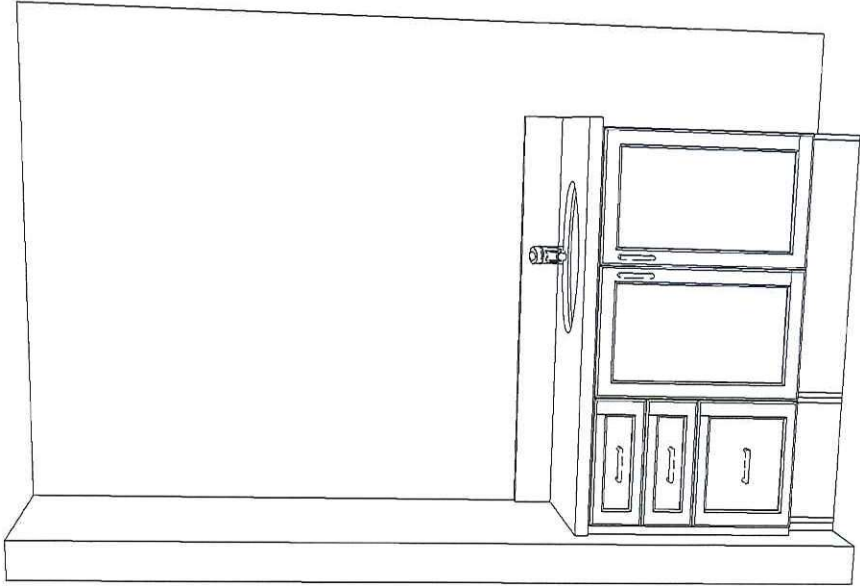

IN-LAW ENSUITE
VANITY

CUSTOMER APPROVAL

I have reviewed these drawings and understand the details of the design and the CARTIER KITCHENS specifications.

Signature _____

Date _____

Note: This drawing is an artistic interpretation of the general appearance of the design. It is not meant to be an exact rendition.




SPECTRUM KITCHEN and BATH
DESIGN

DCR #29 WTR2 - NEWINGTON - VANITIES .


All

Drawing #: 1


Designed: 2021-01-14
Printed: 2021-01-14

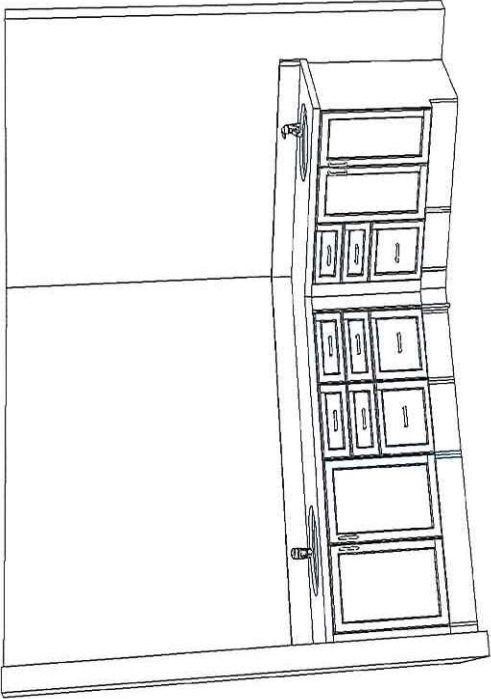

MASTER ENSUITE

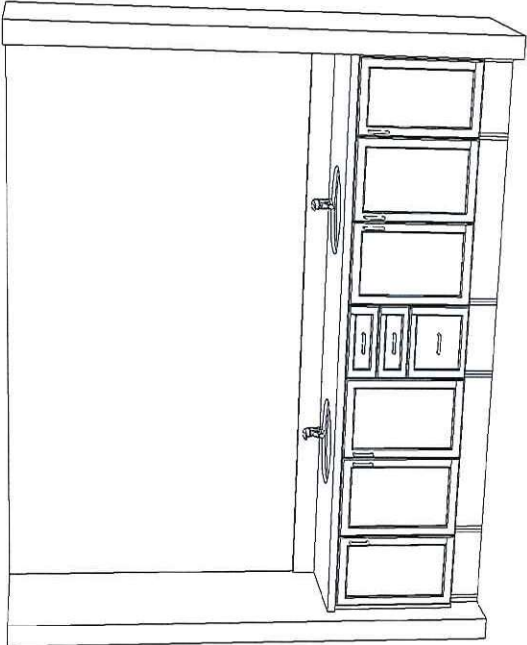

MAIN BATH (JACK & JILL)

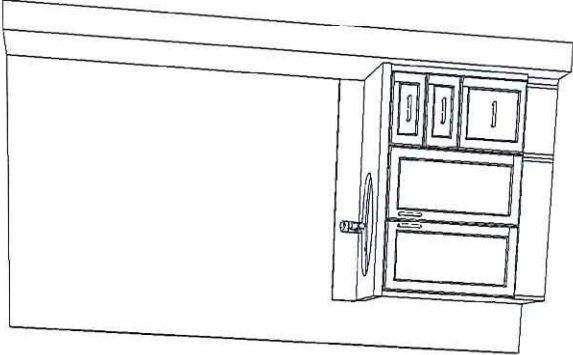

ENSUITE #4

CUSTOMER APPROVAL

I have reviewed these drawings and understand the details of the design and the CARTIER KITCHENS specifications.

Signature

Date

Note: This drawing is an artistic interpretation of the general appearance of the design. It is not meant to be an exact rendition.		Designed: 2021-01-14 Printed: 2021-01-29
SPECTRUM KITCHEN and BATH DESIGN		Drawing #: 1
DCR #29 WTR2 - NEWINGTON - VANITIES 5 BDRM All		