




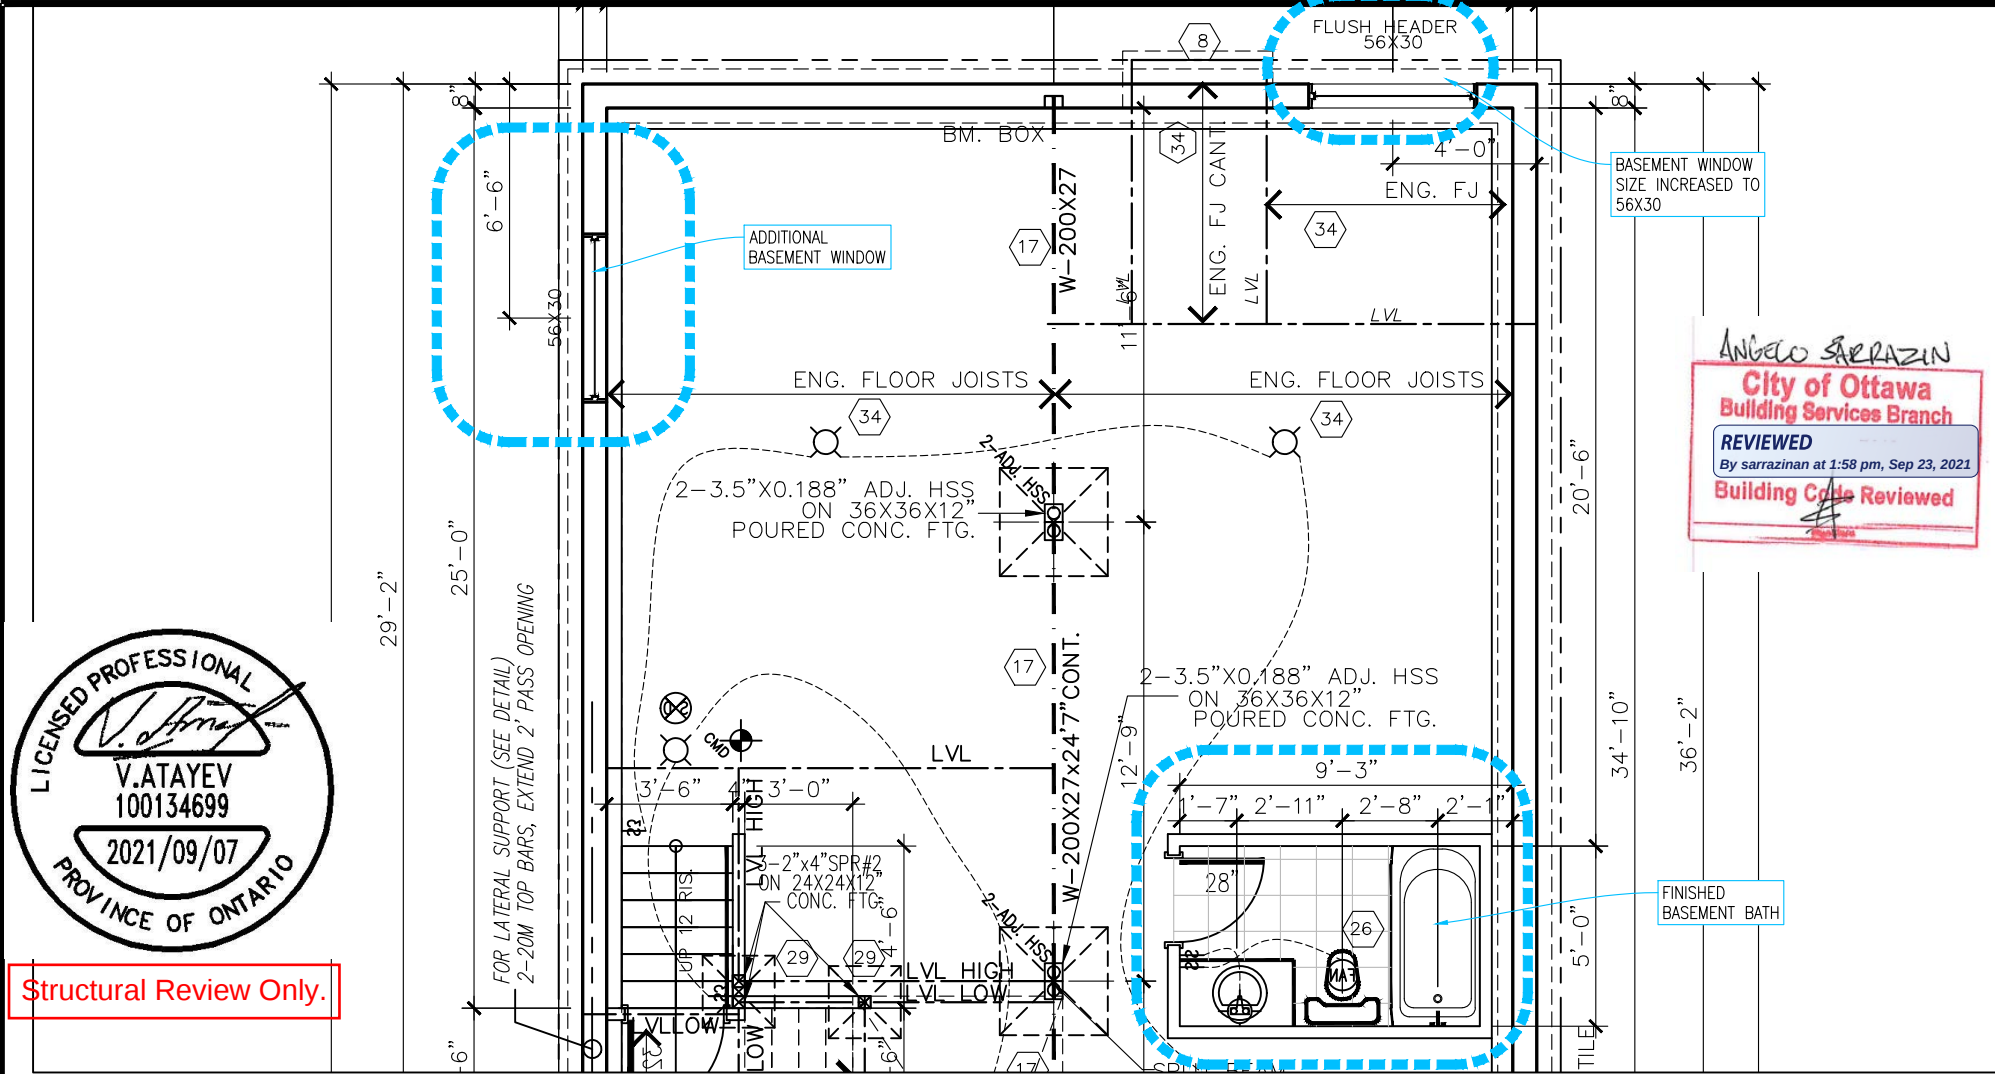

1 PARTIAL FOUNDATION PLAN  
1 scale: 3/16"=1'-0"

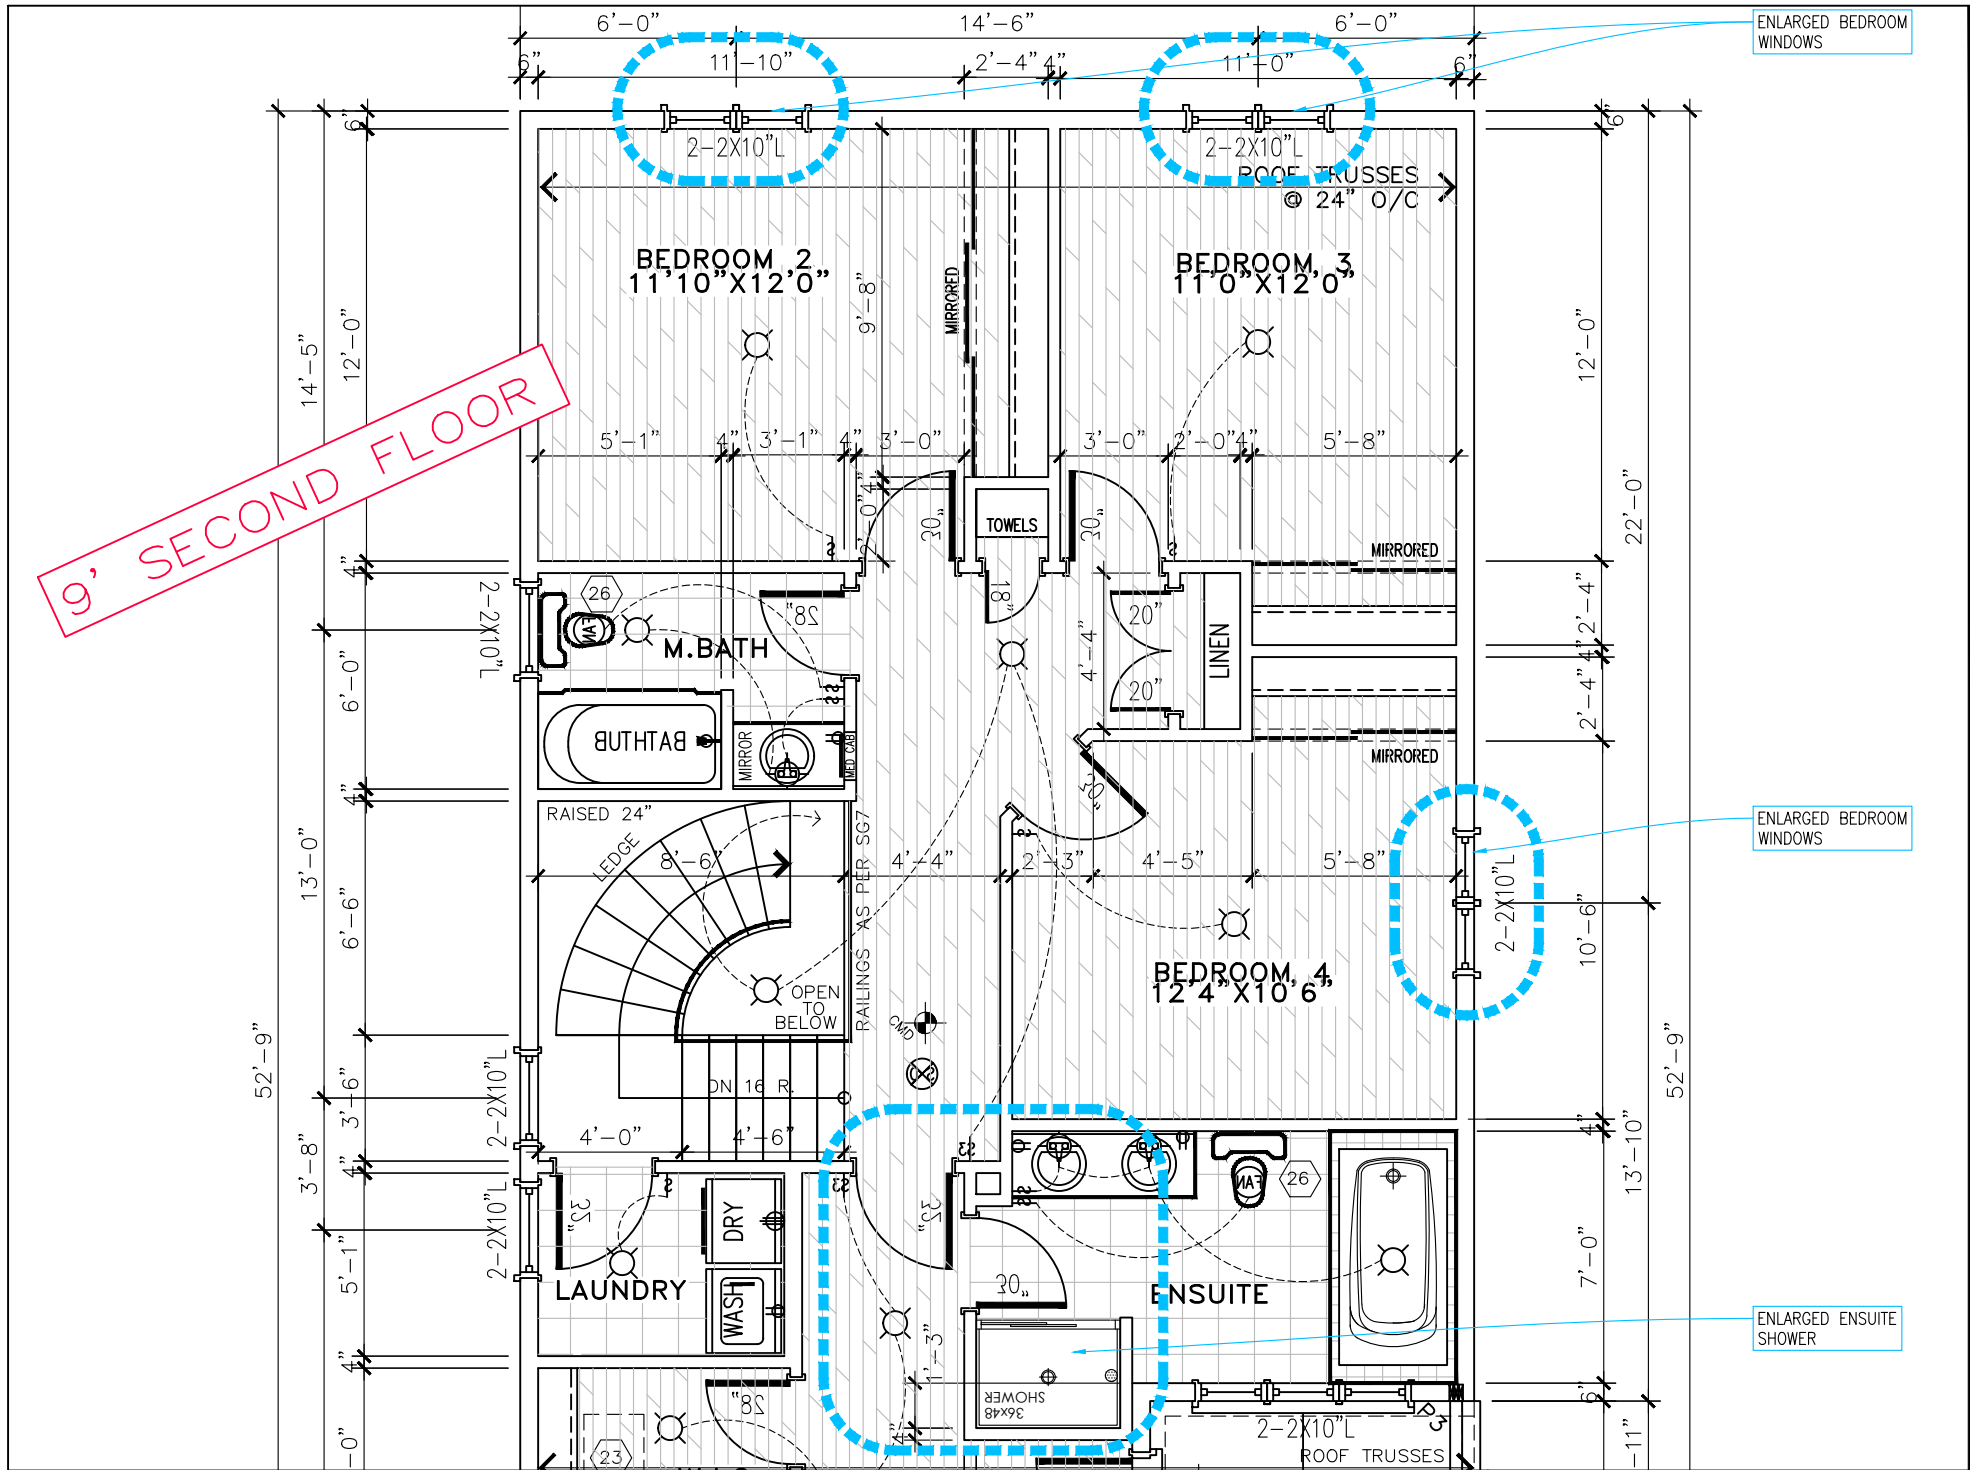

2 PARTIAL SECOND FLOOR PLAN  
1 scale: 3/16"=1'-0"

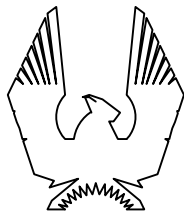

PHOENIX HOMES

ROSEMERE-2012-E

SITE: PATHWAYS

LOT NUMBER:

CIVIC ADDRESS:  
276 GINEBIK WAY

315

2 ENGINEER MARKUPS APPLIED

07/09/21

CB

1 ADDED BSMT WINDOW & ENLARGED WINDOWS

20/08/21

CB

No. Description  
REVISIONS

dd/mm/yy  
By

footprint: C10E

drawn by: PL

date: AUG/00

scale: 3/16"=1'-0"


sheet no:

1


2




1 PARTIAL REAR ELEVATION  
2 scale: 3/16"=1'-0"

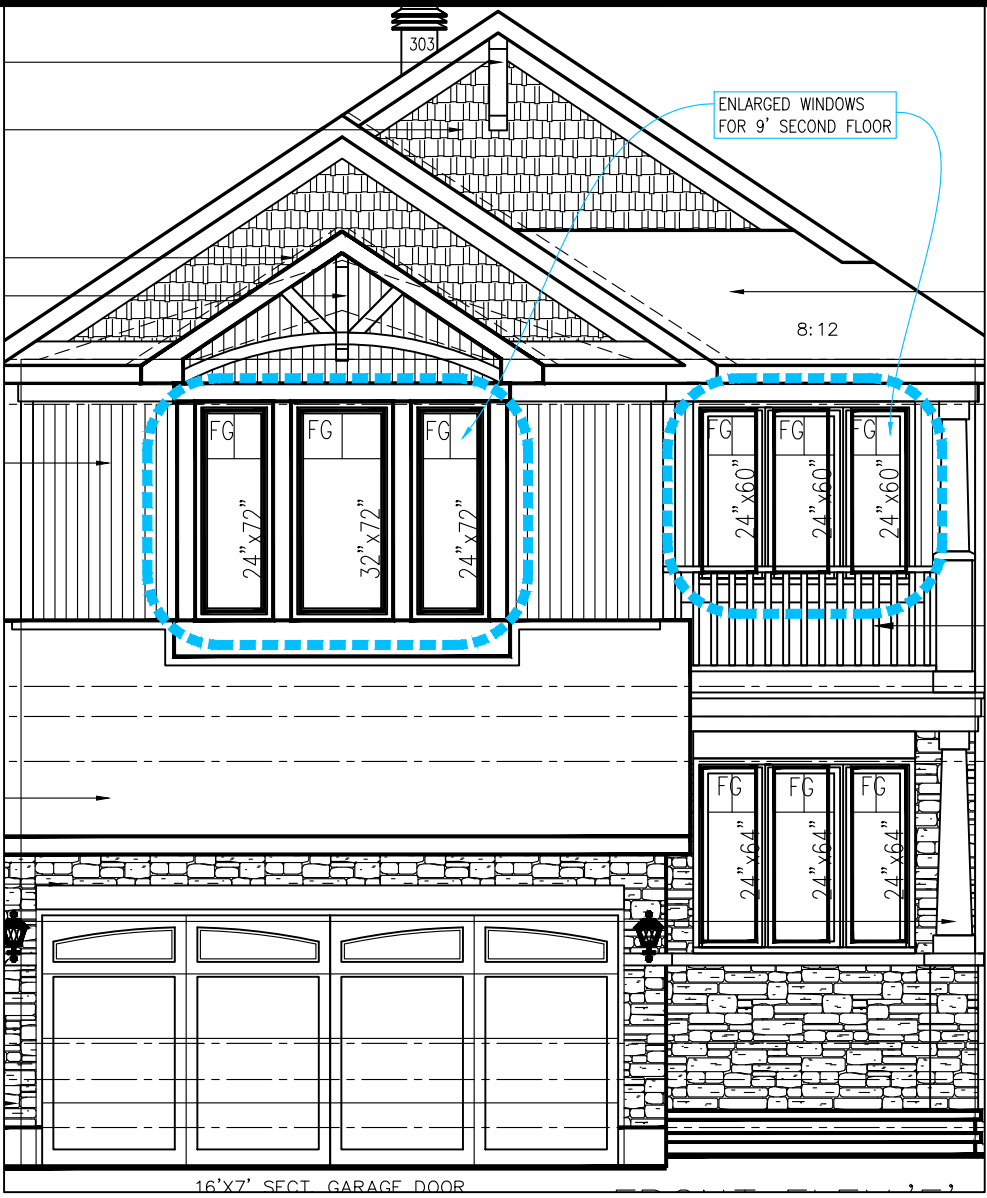

2 PARTIAL FRONT ELEVATION  
2 scale: 3/16"=1'-0"

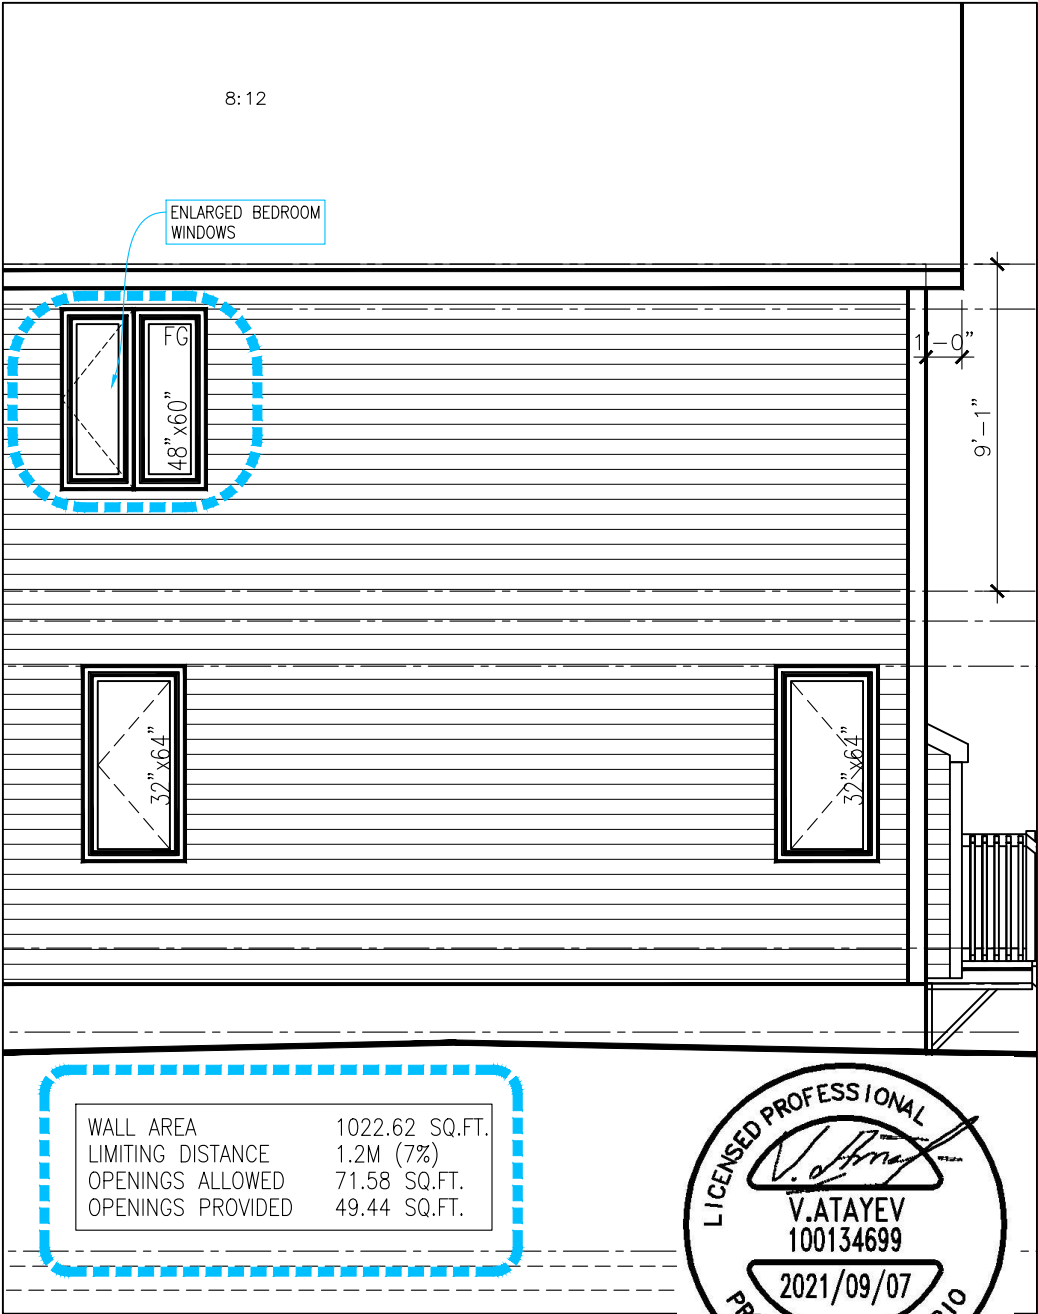

3 PARTIAL RIGHT ELEVATION  
2 scale: 3/16"=1'-0"

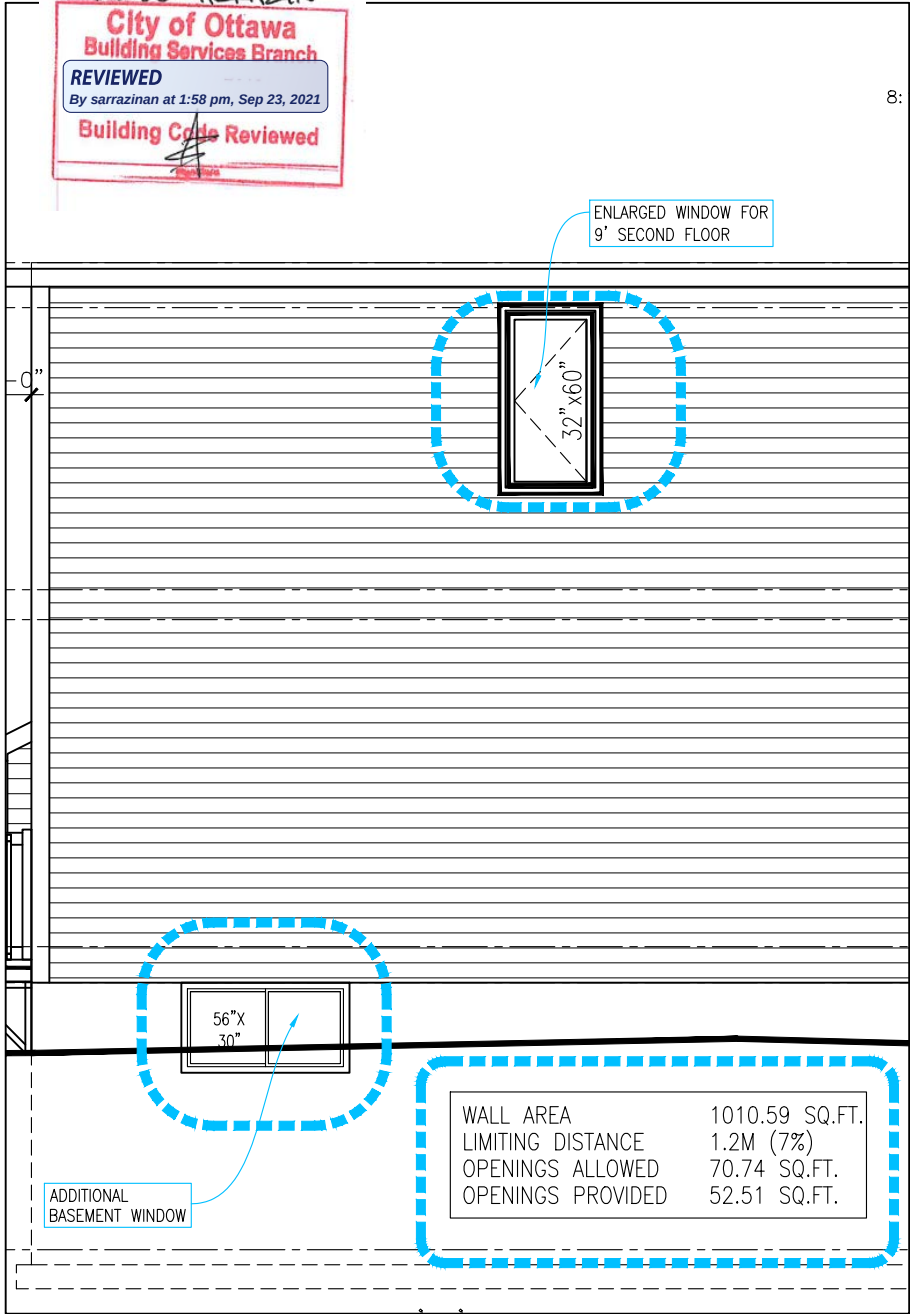

4 PARTIAL LEFT ELEVATION  
2 scale: 3/16"=1'-0"



Structural Review Only.



ROSEMERE-2012-E

SITE: PATHWAYS

LOT NUMBER:

315

CIVIC ADDRESS:  
276 GINEBIK WAY

| No. | Description                          | dd/mm/yy | By |
|-----|--------------------------------------|----------|----|
| 2   | ENGINEER MARKUPS APPLIED             | 07/09/21 | CB |
| 1   | ADDED BSMT WINDOW & ENLARGED WINDOWS | 20/08/21 | CB |

|            |             |
|------------|-------------|
| footprint: | C10E        |
| drawn by:  | PL          |
| date:      | AUG/00      |
| scale:     | 3/16"=1'-0" |
| sheet no:  | 2           |