

DCR PHOENIX HOMES

MODEL - STRATHMORE (35-10)

KITCHEN / VANITIES

MOUNTING HEIGHT - 84

LINE -

HARDWARE -

STANDARD WHITE INTERIOR

METAL DRAWER BOX


4 PCS - 5/8" KICK - FIN. BOTH ENDS

2 PCS - LOOSE FILLER - 6 x 96

1 PCS - 90 DEG. CORNER MOULD

1 PCS - T-MOULD

4 PCS - FLAT MOULD

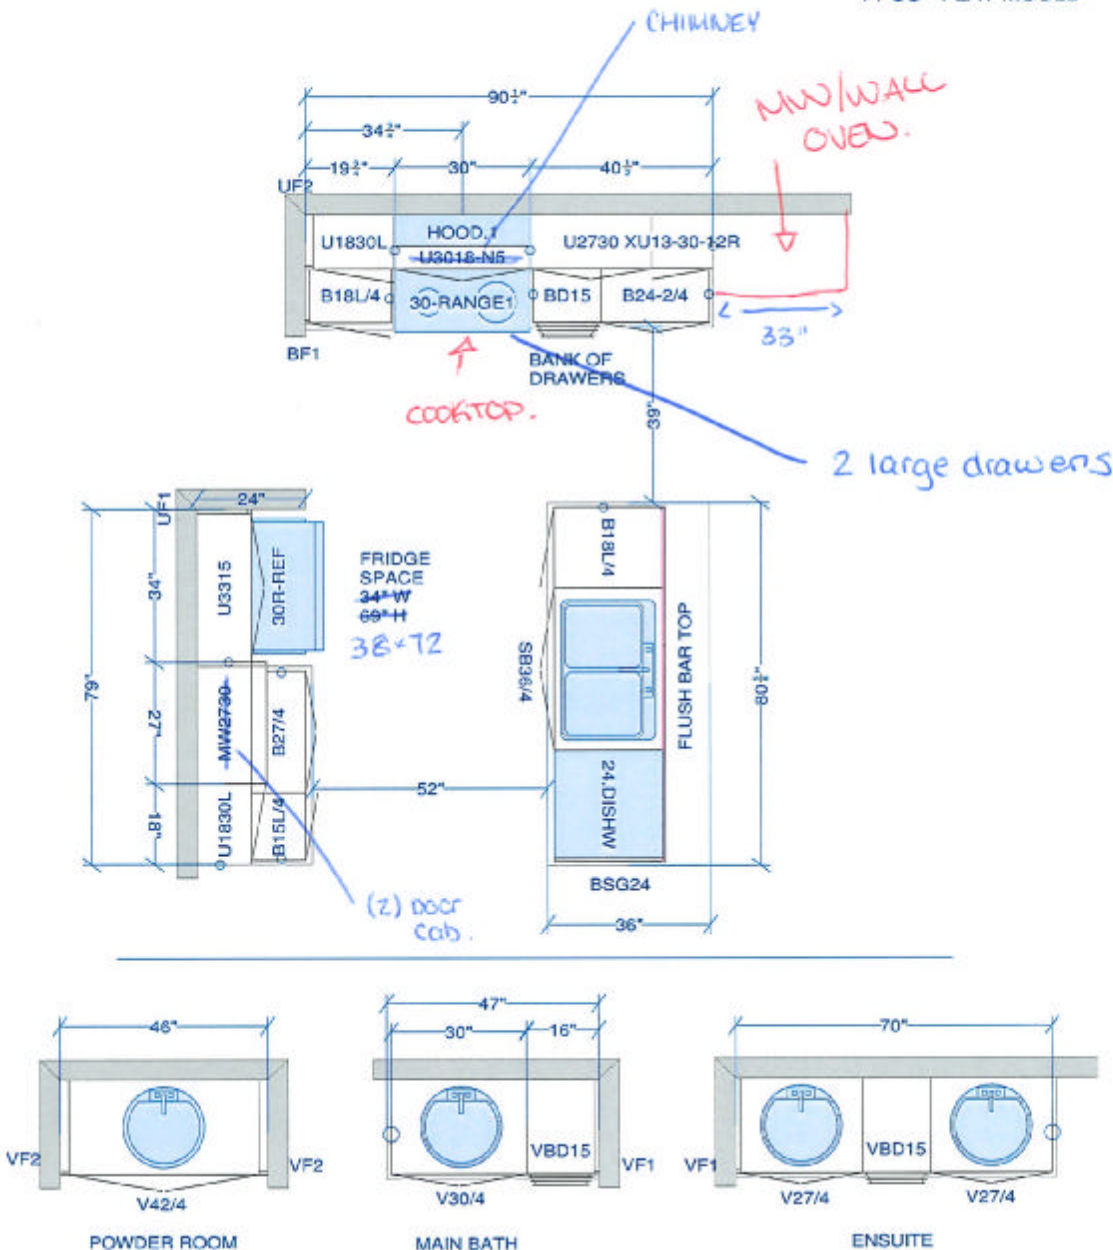

All dimensions & size designations given are subject to verification on job site and adjustment to fit job conditions.

SPECTRUM KITCHENS INC.

35-10 STRATHMORE.kit



This is an original design and must not be released or copied unless applicable fee has been paid or job order placed.

Drawn by: Lori Di Saverio, B.I.D.
SPECTRUM KITCHENS INC.


Designed: 19/04/2016
Printed: 22/04/2016

All

Drawing #: 1

No Scale.

DS DS
SAR

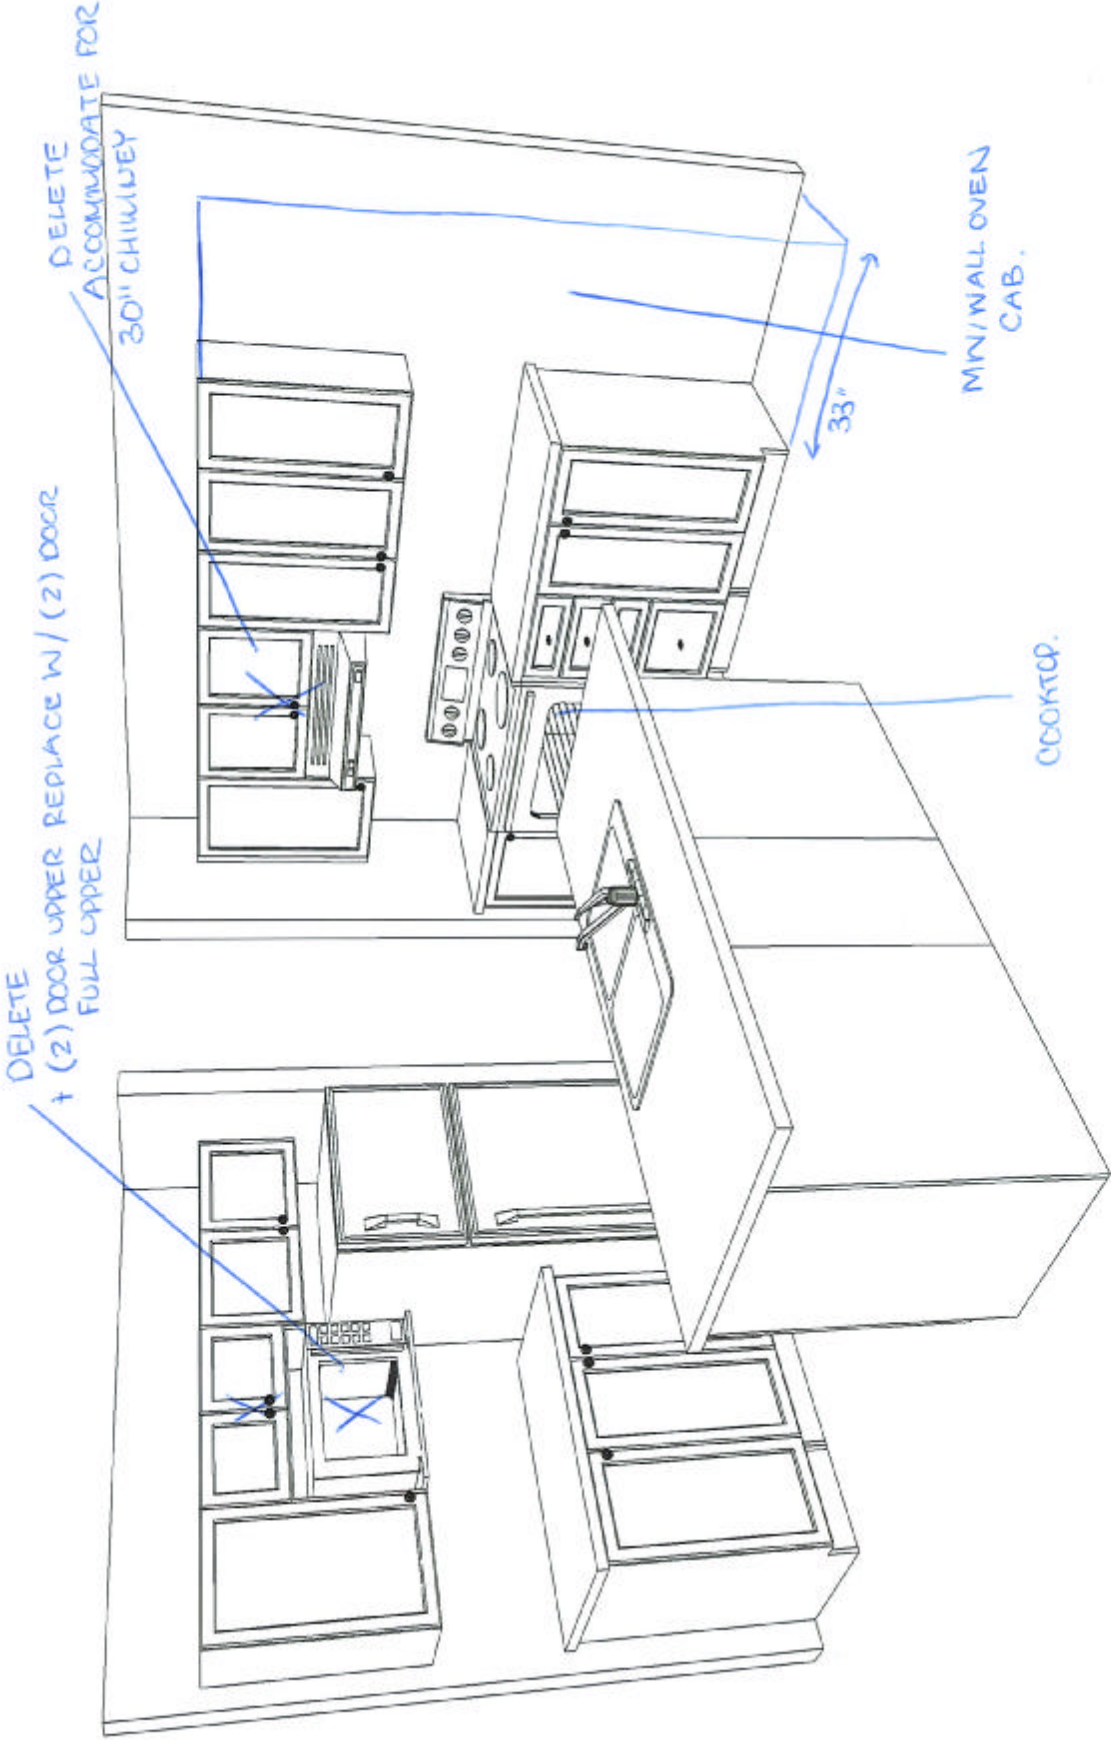

DS
SmAR

DCR PHOENIX 35-10 STRATHMORE STD
3D KITCHEN VIEW #1

Note: This drawing is an artistic interpretation of the general appearance of the design. It is not meant to be an exact rendition.




Designed: 4/20/2016
Printed: 4/20/2016

35-10 STRATHMORE

All


Drawing #: 1

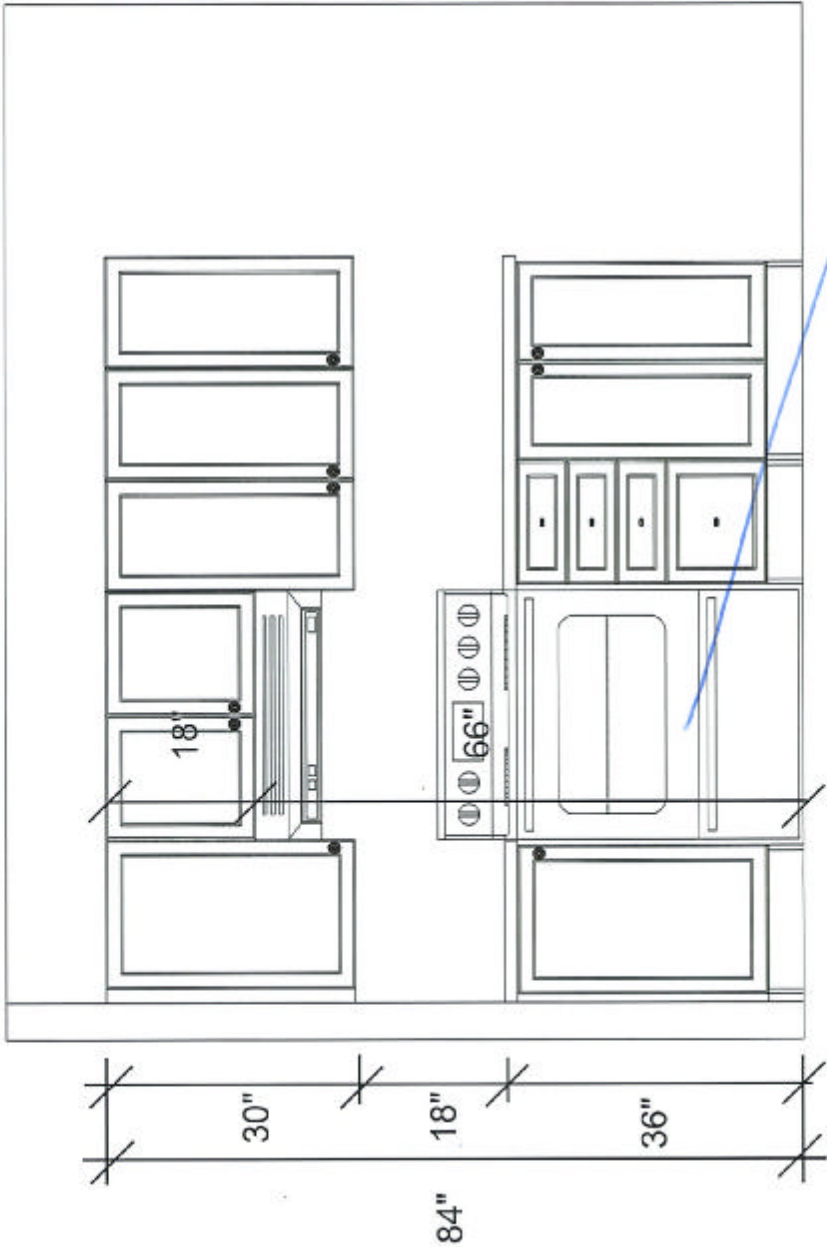

DCR PHOENIX 35-10 STRATHMORE STD
STOVE WALL ELEVATION

^{DS}
SAR
^{DS}

Note: This drawing is an artistic interpretation of the general appearance of the design. It is not meant to be an exact rendition.	 	Designed: 4/20/2016 Printed: 4/20/2016
	35-10 STRATHMORE	All

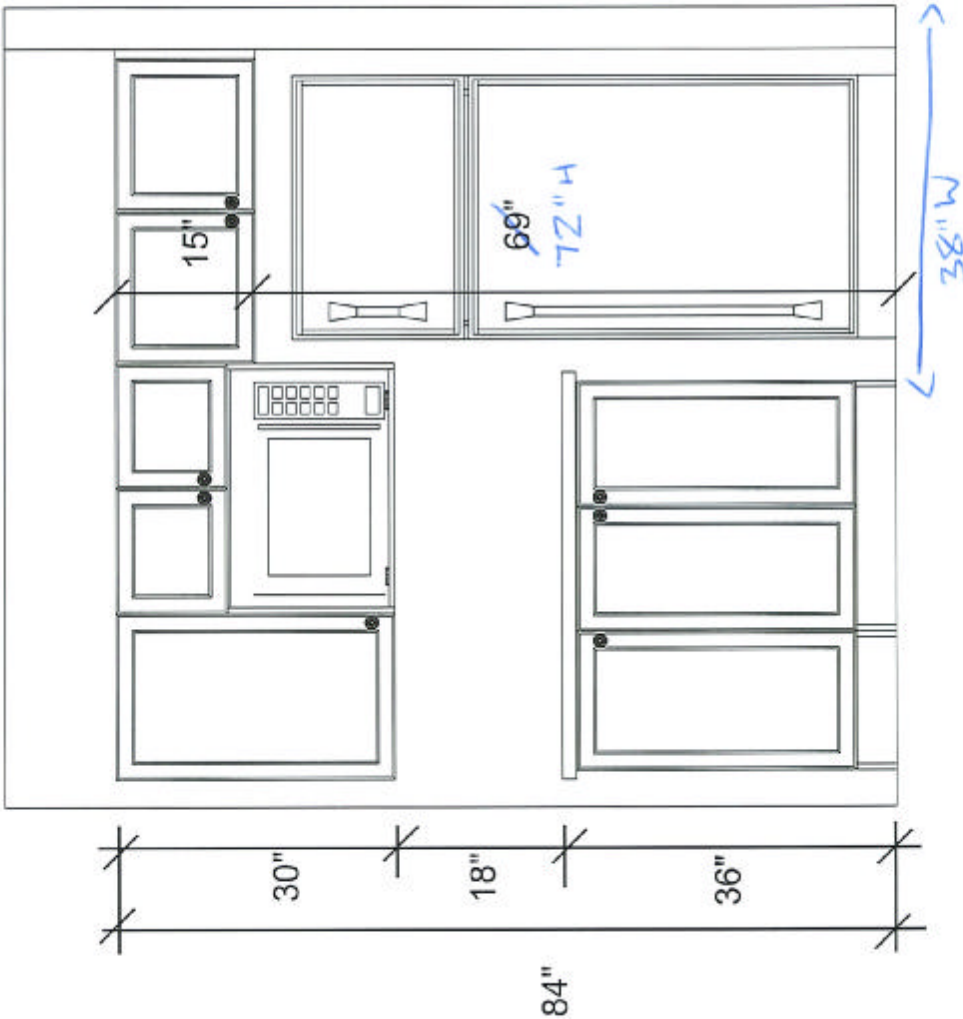

DS
SmAR

DCR PHOENIX 35-10 STRATHMORE STD
FRIDGE WALL ELEVATION

Note: This drawing is an artistic interpretation of the general appearance of the design. It is not meant to be an exact rendition.




Designed: 4/20/2016
Printed: 4/20/2016

35-10 STRATHMORE


All


Drawing #: 1

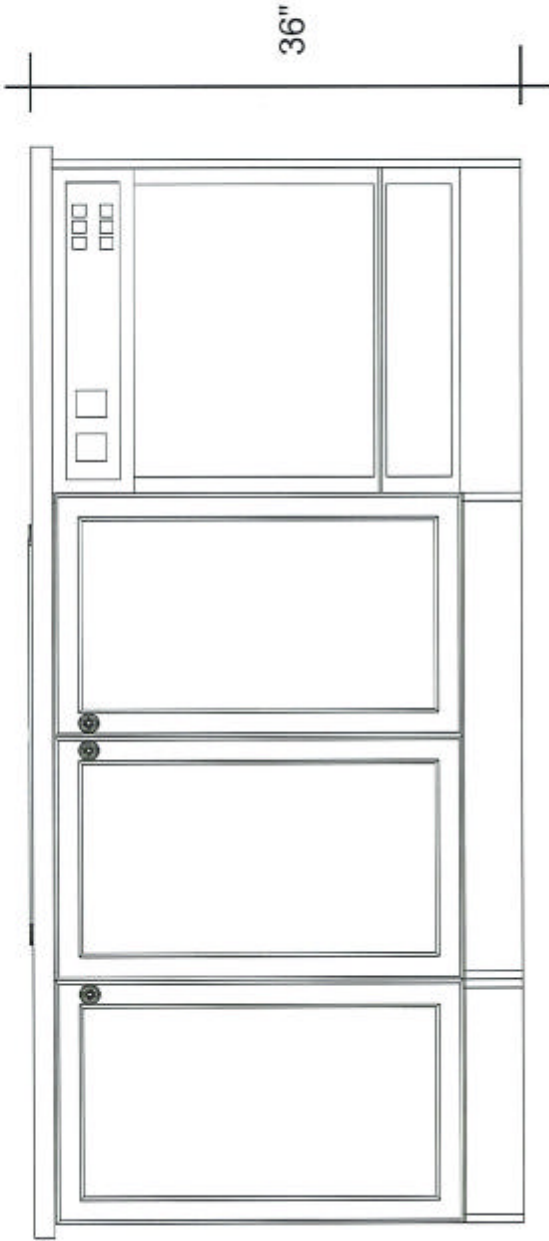

DCR PHOENIX 35-10 STRATHMORE STD
ISLAND ELEVATION

DS DS
SAR

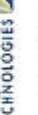
Note: This drawing is an artistic interpretation of the general appearance of the design. It is not meant to be an exact rendition.	 	Designed: 4/20/2016 Printed: 4/20/2016
35-10 STRATHMORE	All	Drawing #: 1

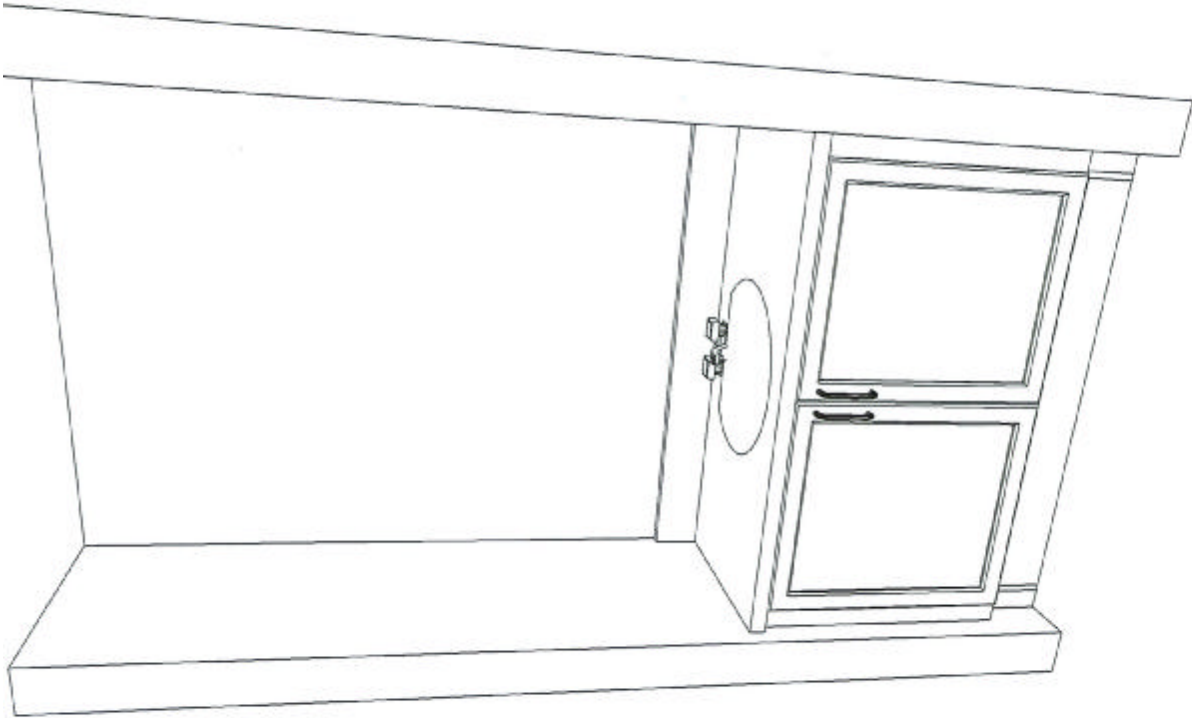

POWDER ROOM VANITY - 3D VIEW
DCR PHOENIX HOMES
STRATHMORE (35-10)

 DS

Note: This drawing is an artistic interpretation of the general appearance of the design. It is not meant to be an exact rendition. Drawn By: Lori D Saverio, B.I.D. SPECTRUM KITCHENS INC 35-10 STRATHMORE.kit		Designed: 19/04/2016 Printed: 22/04/2016
	All	Drawing #: 1

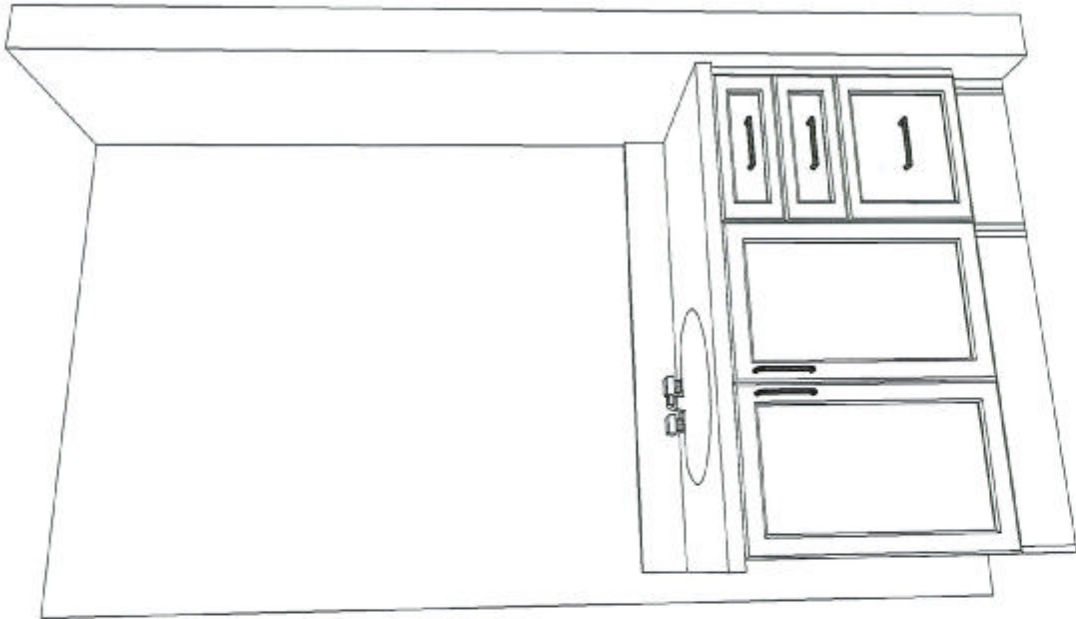

DS DS
SAR

MAIN BATH - 3D VIEW
DCR PHOENIX HOMES
STRATHMORE (35-10)

Note: This drawing is an artistic interpretation of the general appearance of the design. It is not meant to be an exact rendition.


Drawn By: Lori D Saverio, B.I.D.
SPECTRUM KITCHENS INC
35-10 STRATHMORE.kit



Designed: 19/04/2016
Printed: 22/04/2016

All

Drawing #: 1

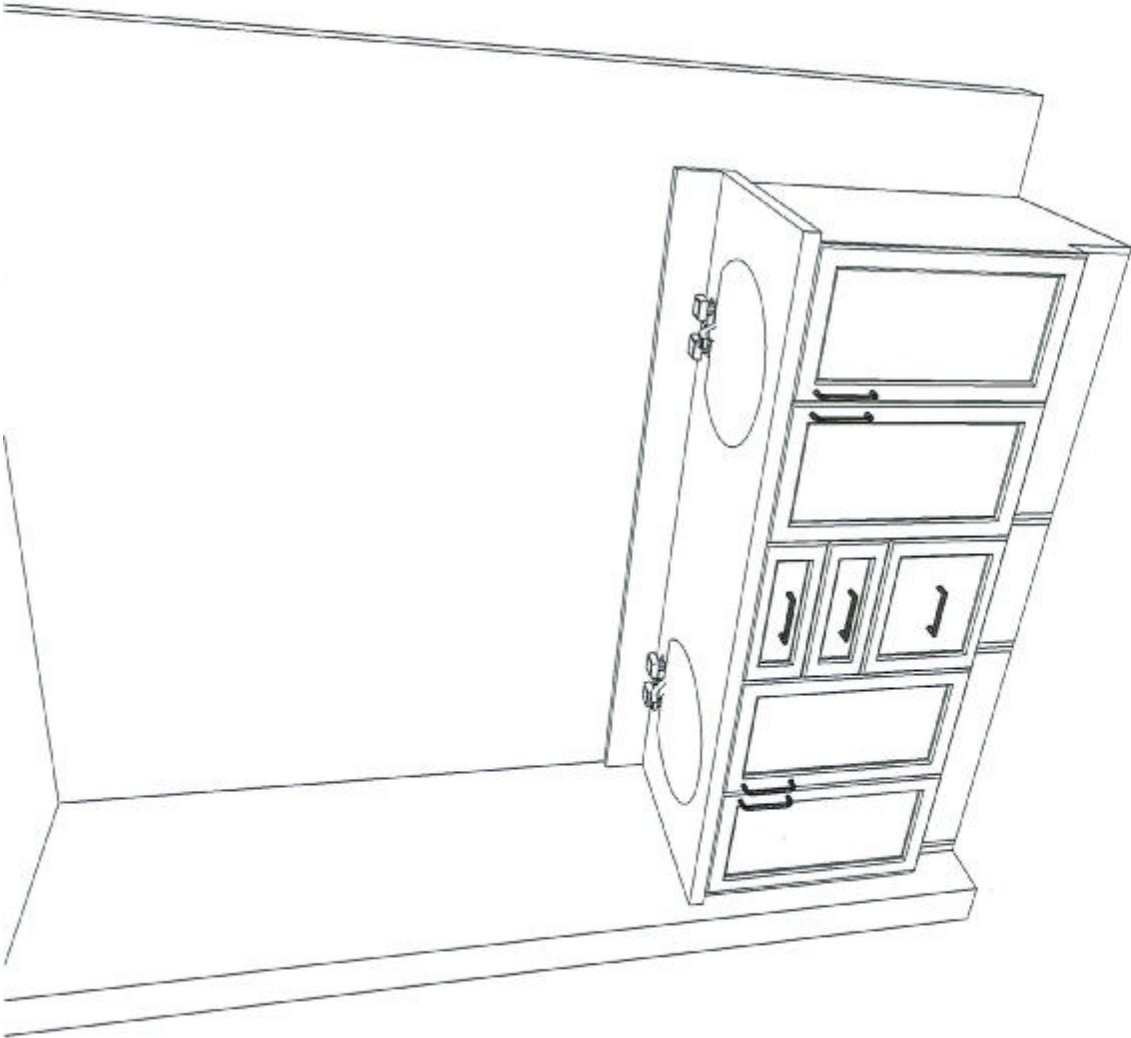

DS DS
SAR

ENSUITE VANITY - 3D VIEW
DCR PHOENIX HOMES
STRATHMORE (35-10)

Note: This drawing is an artistic interpretation of the general appearance of the design. It is not meant to be an exact rendition. Drawn By: Lori D Saverio, B.I.D. SPECTRUM KITCHENS INC 35-10 STRATHMORE.kit		Designed: 19/04/2016 Printed: 22/04/2016
		All Drawing #: 1