


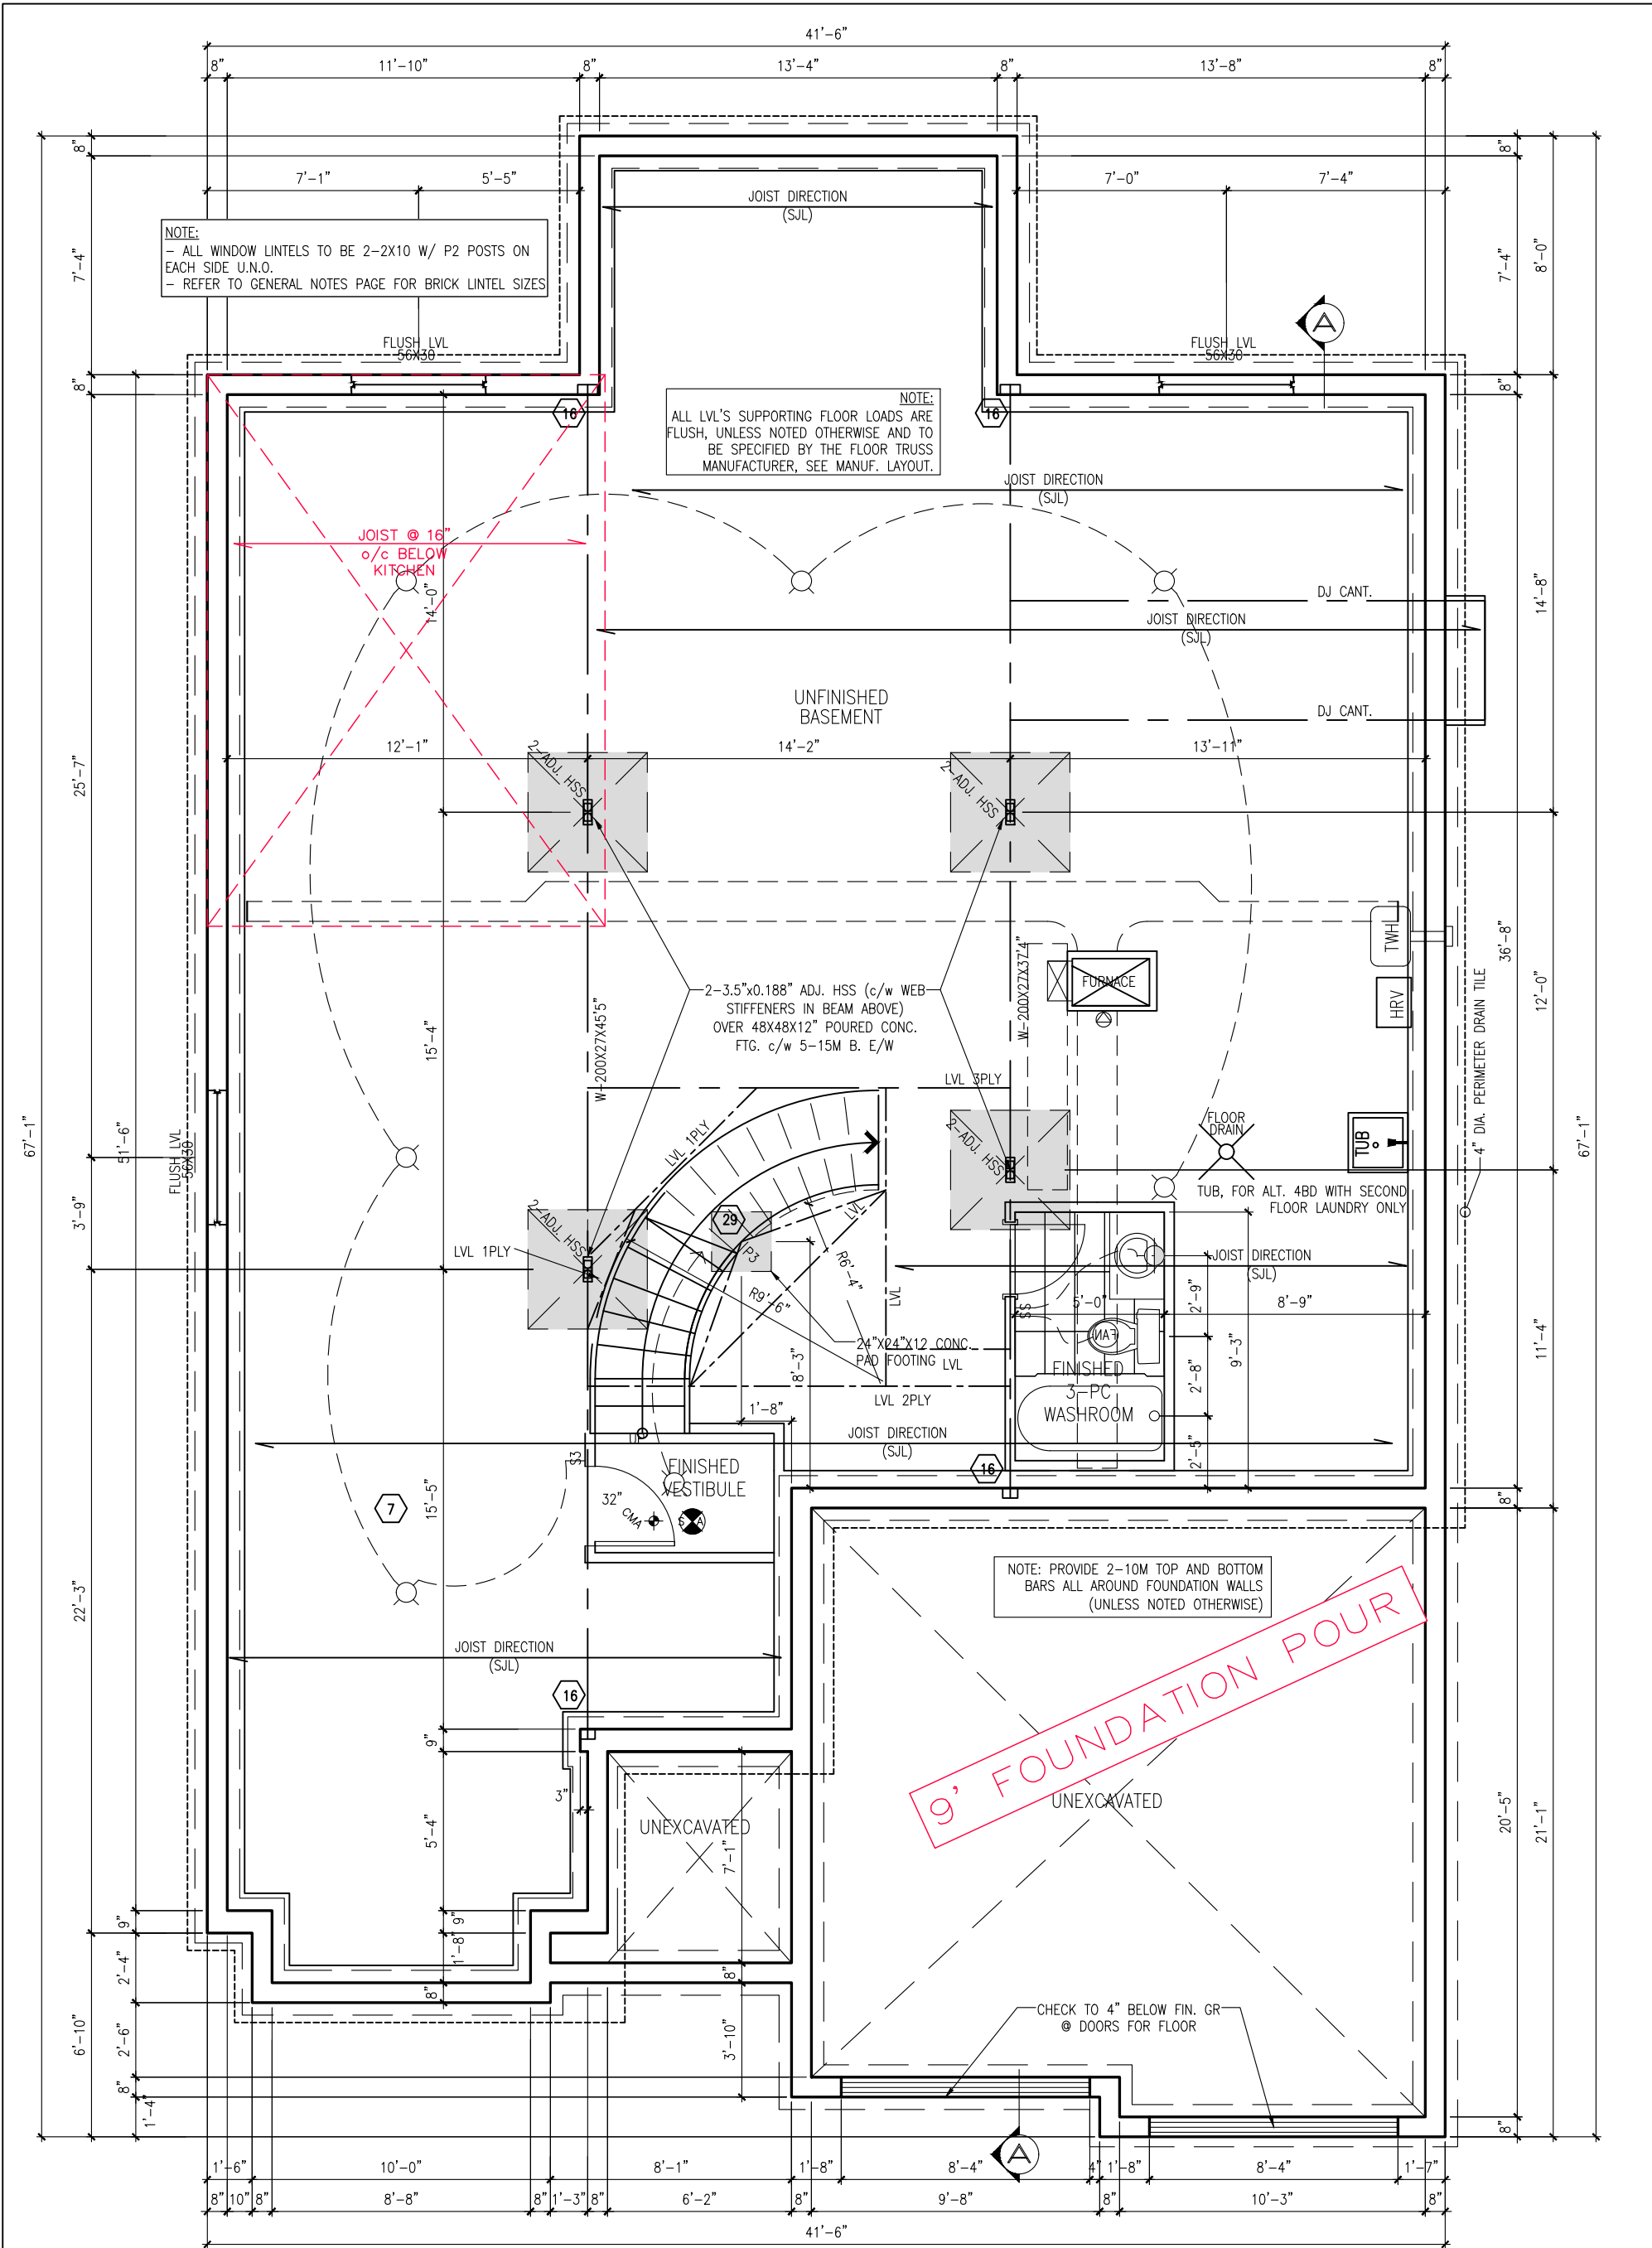

BASEMENT FLOOR PLAN EL. A,B,E,F

PHOENIX HOMES

ANNAPOLIS-2019-A,B,E,F

SITE:PATHWAYS

LOT NUMBER: 19

CIVIC ADDRESS:
21 SALAMANDER WAY

13	MOVE WALL OVEN 15" /ADD PANTRY	JAN-19-22	SP
12	FINAL FOR SITE	JAN-04-22	SP
11	FINAL BLACKLINES - REVISED	DEC-16-21	SP
10	FINAL BLACKLINES	DEC-15-21	GK
9	BEP FOR SITE	SEPT-29-21	SP
8	ISSUED FOR PERMIT	SEPT-16-21	SP
No.	Description	Date	By
REVISIONS			

file number: 509

drawn by: T.L.


date: DEC. 2012

scale: 3/16"=1'


DCL-201
sheet no:

2

9

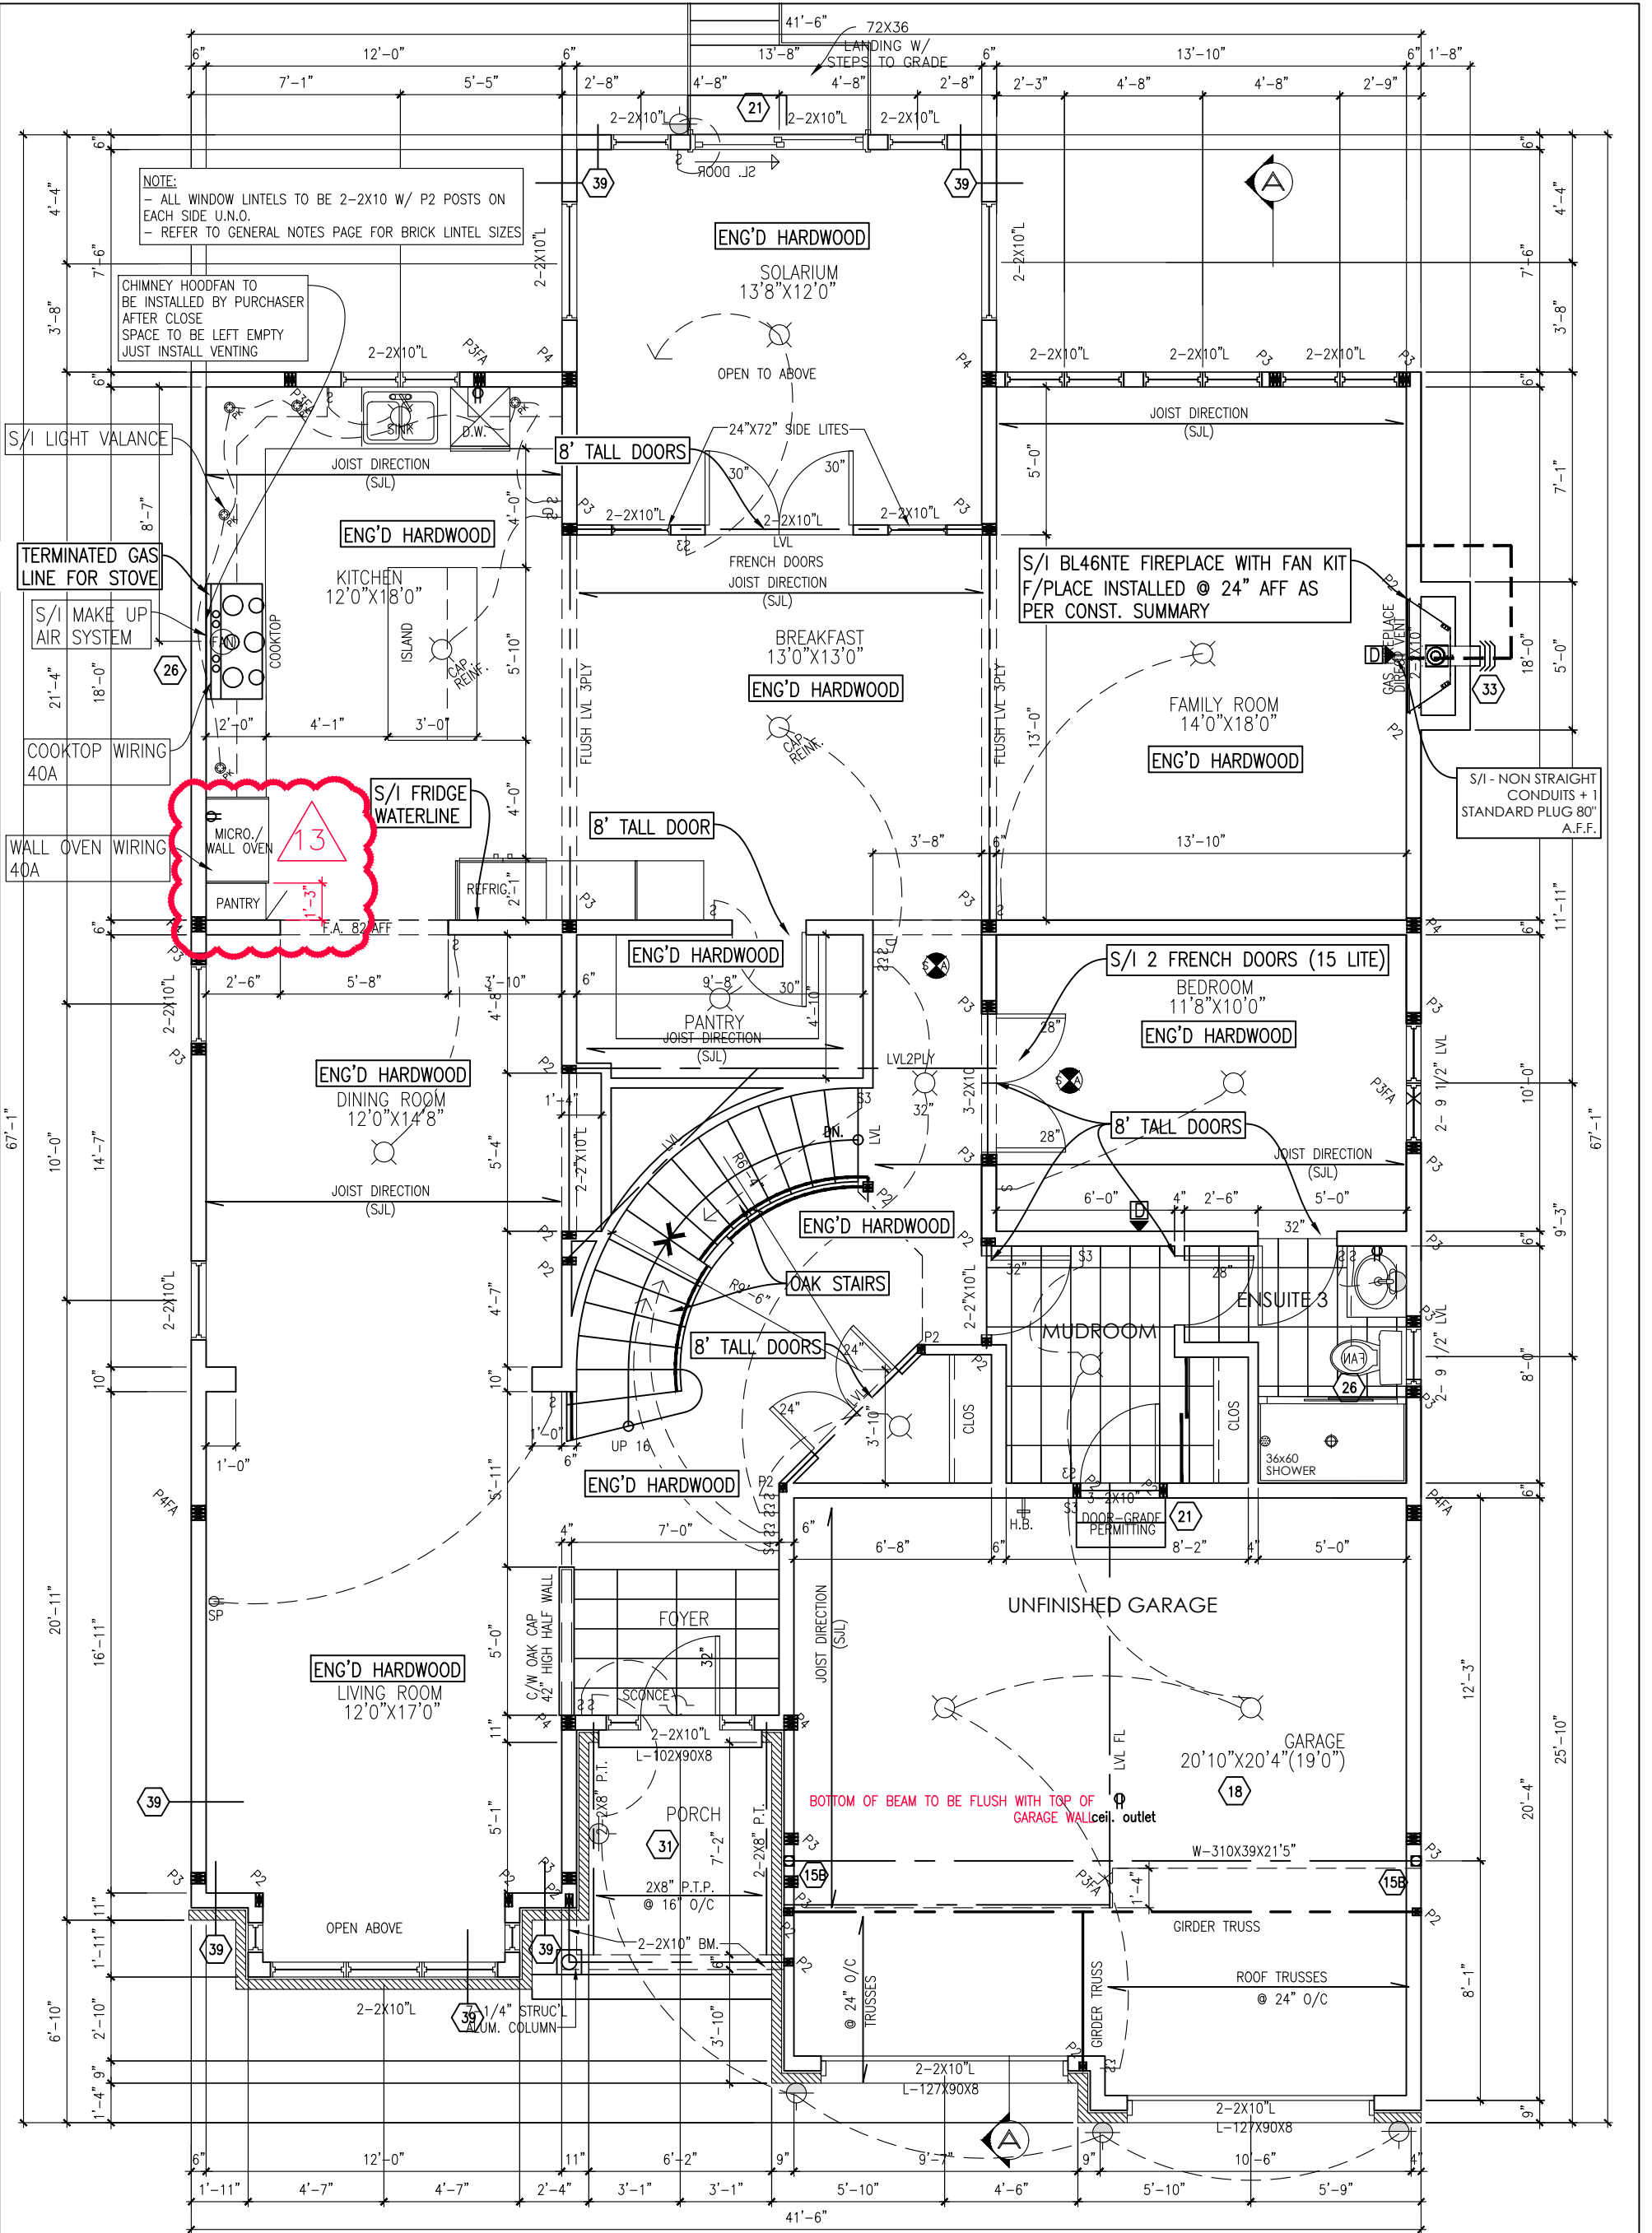

MAIN FLOOR PLAN ELEV. E – 1958 SF

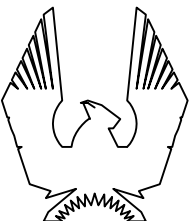

PHOENIX HOMES

ANNAPOLIS-2019-E

SITE:PATHWAYS

LOT NUMBER: 19

CIVIC ADDRESS:
21 SALAMANDER WAY

13	MOVE WALL OVEN 15" /ADD PANTRY	JAN-19-22	SP
12	FINAL FOR SITE	JAN-04-22	SP
11	FINAL BLACKLINES – REVISED	DEC-16-21	SP
10	FINAL BLACKLINES	DEC-15-21	GK
9	BEP FOR SITE	SEPT-29-21	SP
8	ISSUED FOR PERMIT	SEPT-16-21	SP
No. Description		Date	By
REVISIONS			

file number: 509

drawn by: T.L.


date: DEC. 2012

scale: 3/16"=1'

DCL-201
sheet no:

15

3E
9

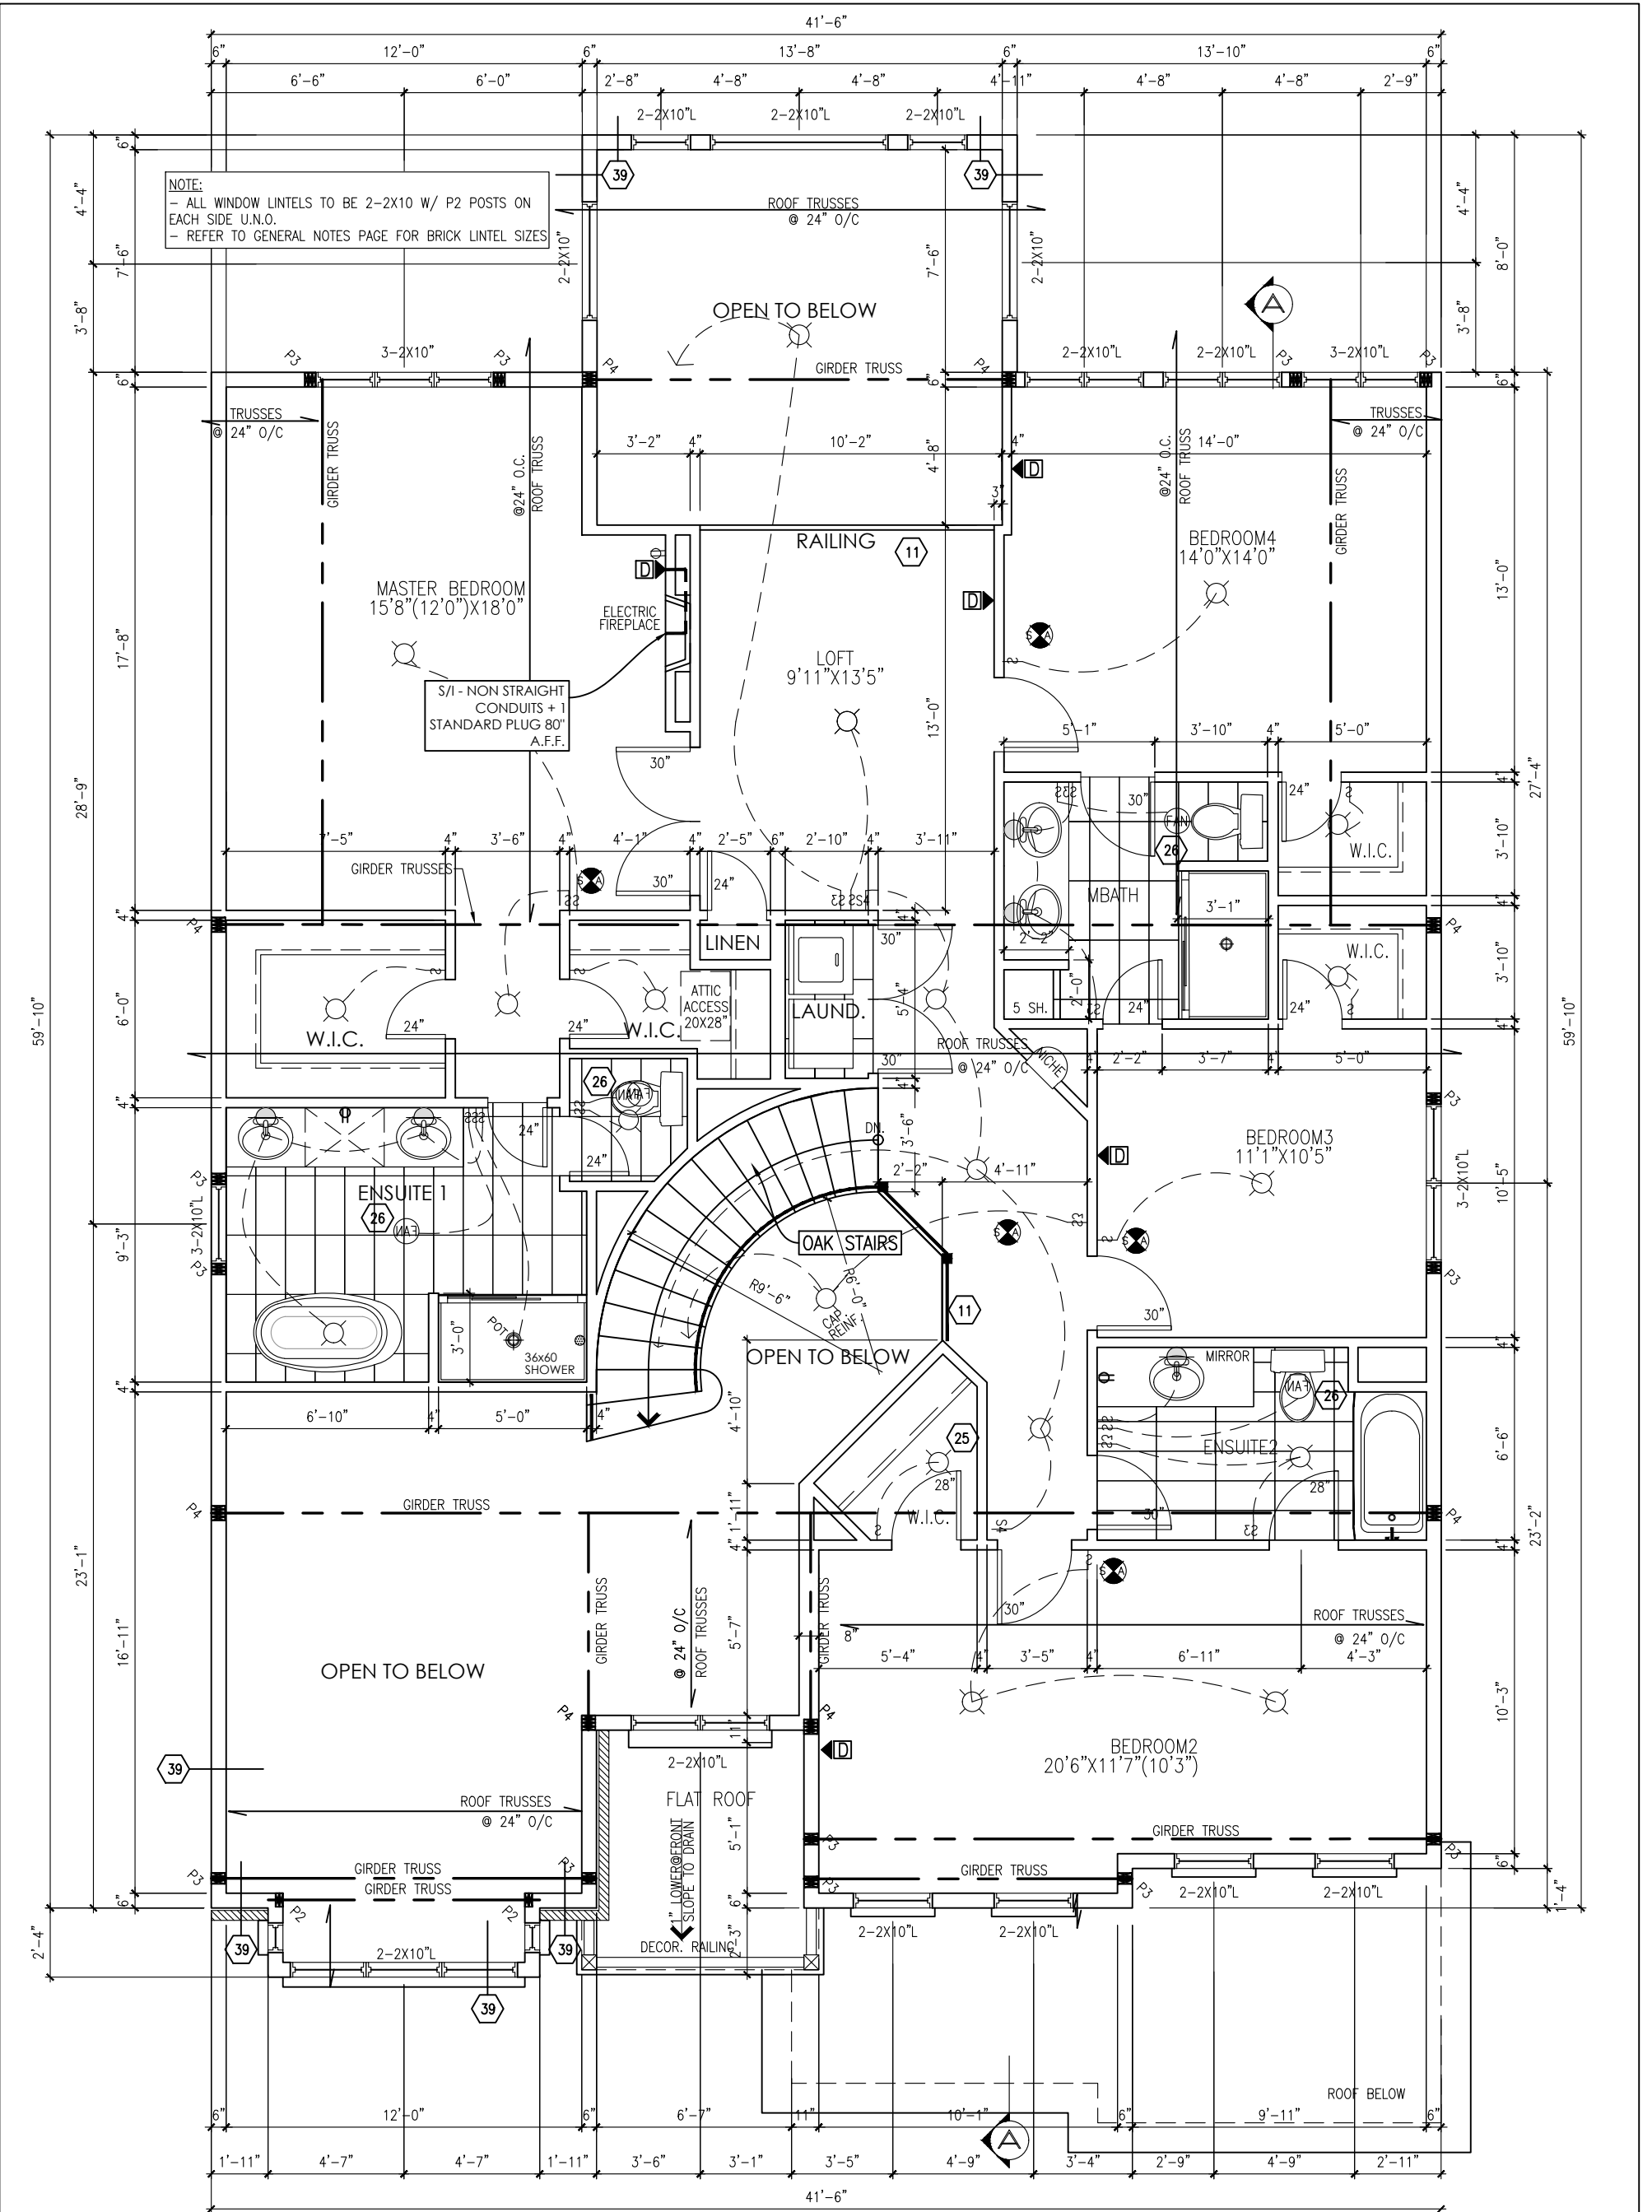

SECOND FLOOR PLAN ELEV. E – 1672 SF

9' SECOND FLOOR



ANNAPOLIS-2019-E

SITE:PATHWAYS

LOT NUMBER: 19

CIVIC ADDRESS:
21 SALAMANDER WAY

13	MOVE WALL OVEN 15" /ADD PANTRY	JAN-19-22	SP
12	FINAL FOR SITE	JAN-04-22	SP
11	FINAL BLACKLINES – REVISED	DEC-16-21	SP
10	FINAL BLACKLINES	DEC-15-21	GK
9	BEP FOR SITE	SEPT-29-21	SP
8	ISSUED FOR PERMIT	SEPT-16-21	SP
No.	Description	Date	By
REVISIONS			

file number: 509

drawn by: T.L.

date: DEC. 2012


scale: 3/16"=1'

DCL-201
sheet no:

16

4E
9

9' SECOND FLOOR

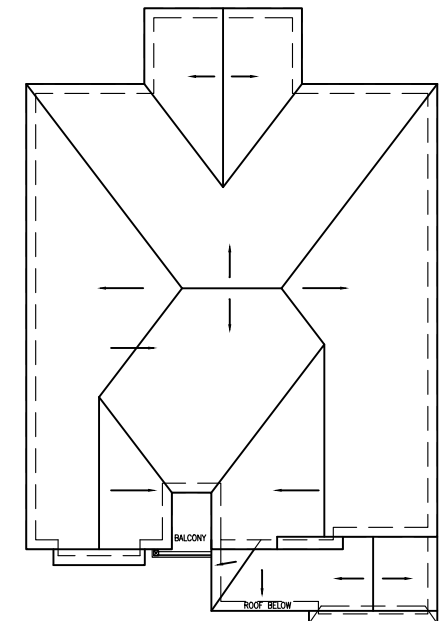

ROOF PLAN-E NTS

FRONT ELEVATION 'E'



ANNAPOLIS-2019-E

SITE:PATHWAYS

LOT NUMBER: 19

CIVIC ADDRESS:
21 SALAMANDER WAY

13	MOVE WALL OVEN 15" /ADD PANTRY	JAN-19-22	SP
12	FINAL FOR SITE	JAN-04-22	SP
11	FINAL BLACKLINES -- REVISED	DEC-16-21	SP
10	FINAL BLACKLINES	DEC-15-21	GK
9	BEP FOR SITE	SEPT-29-21	SP
8	ISSUED FOR PERMIT	SEPT-16-21	SP
No.	Description	Date	By
REVISIONS			

file number: 509

drawn by: T.L.


date:DEC.2012 DCL-79

scale: 3/16"=1'

sheet no: 17

5E
9

9' FOUNDATION POUR

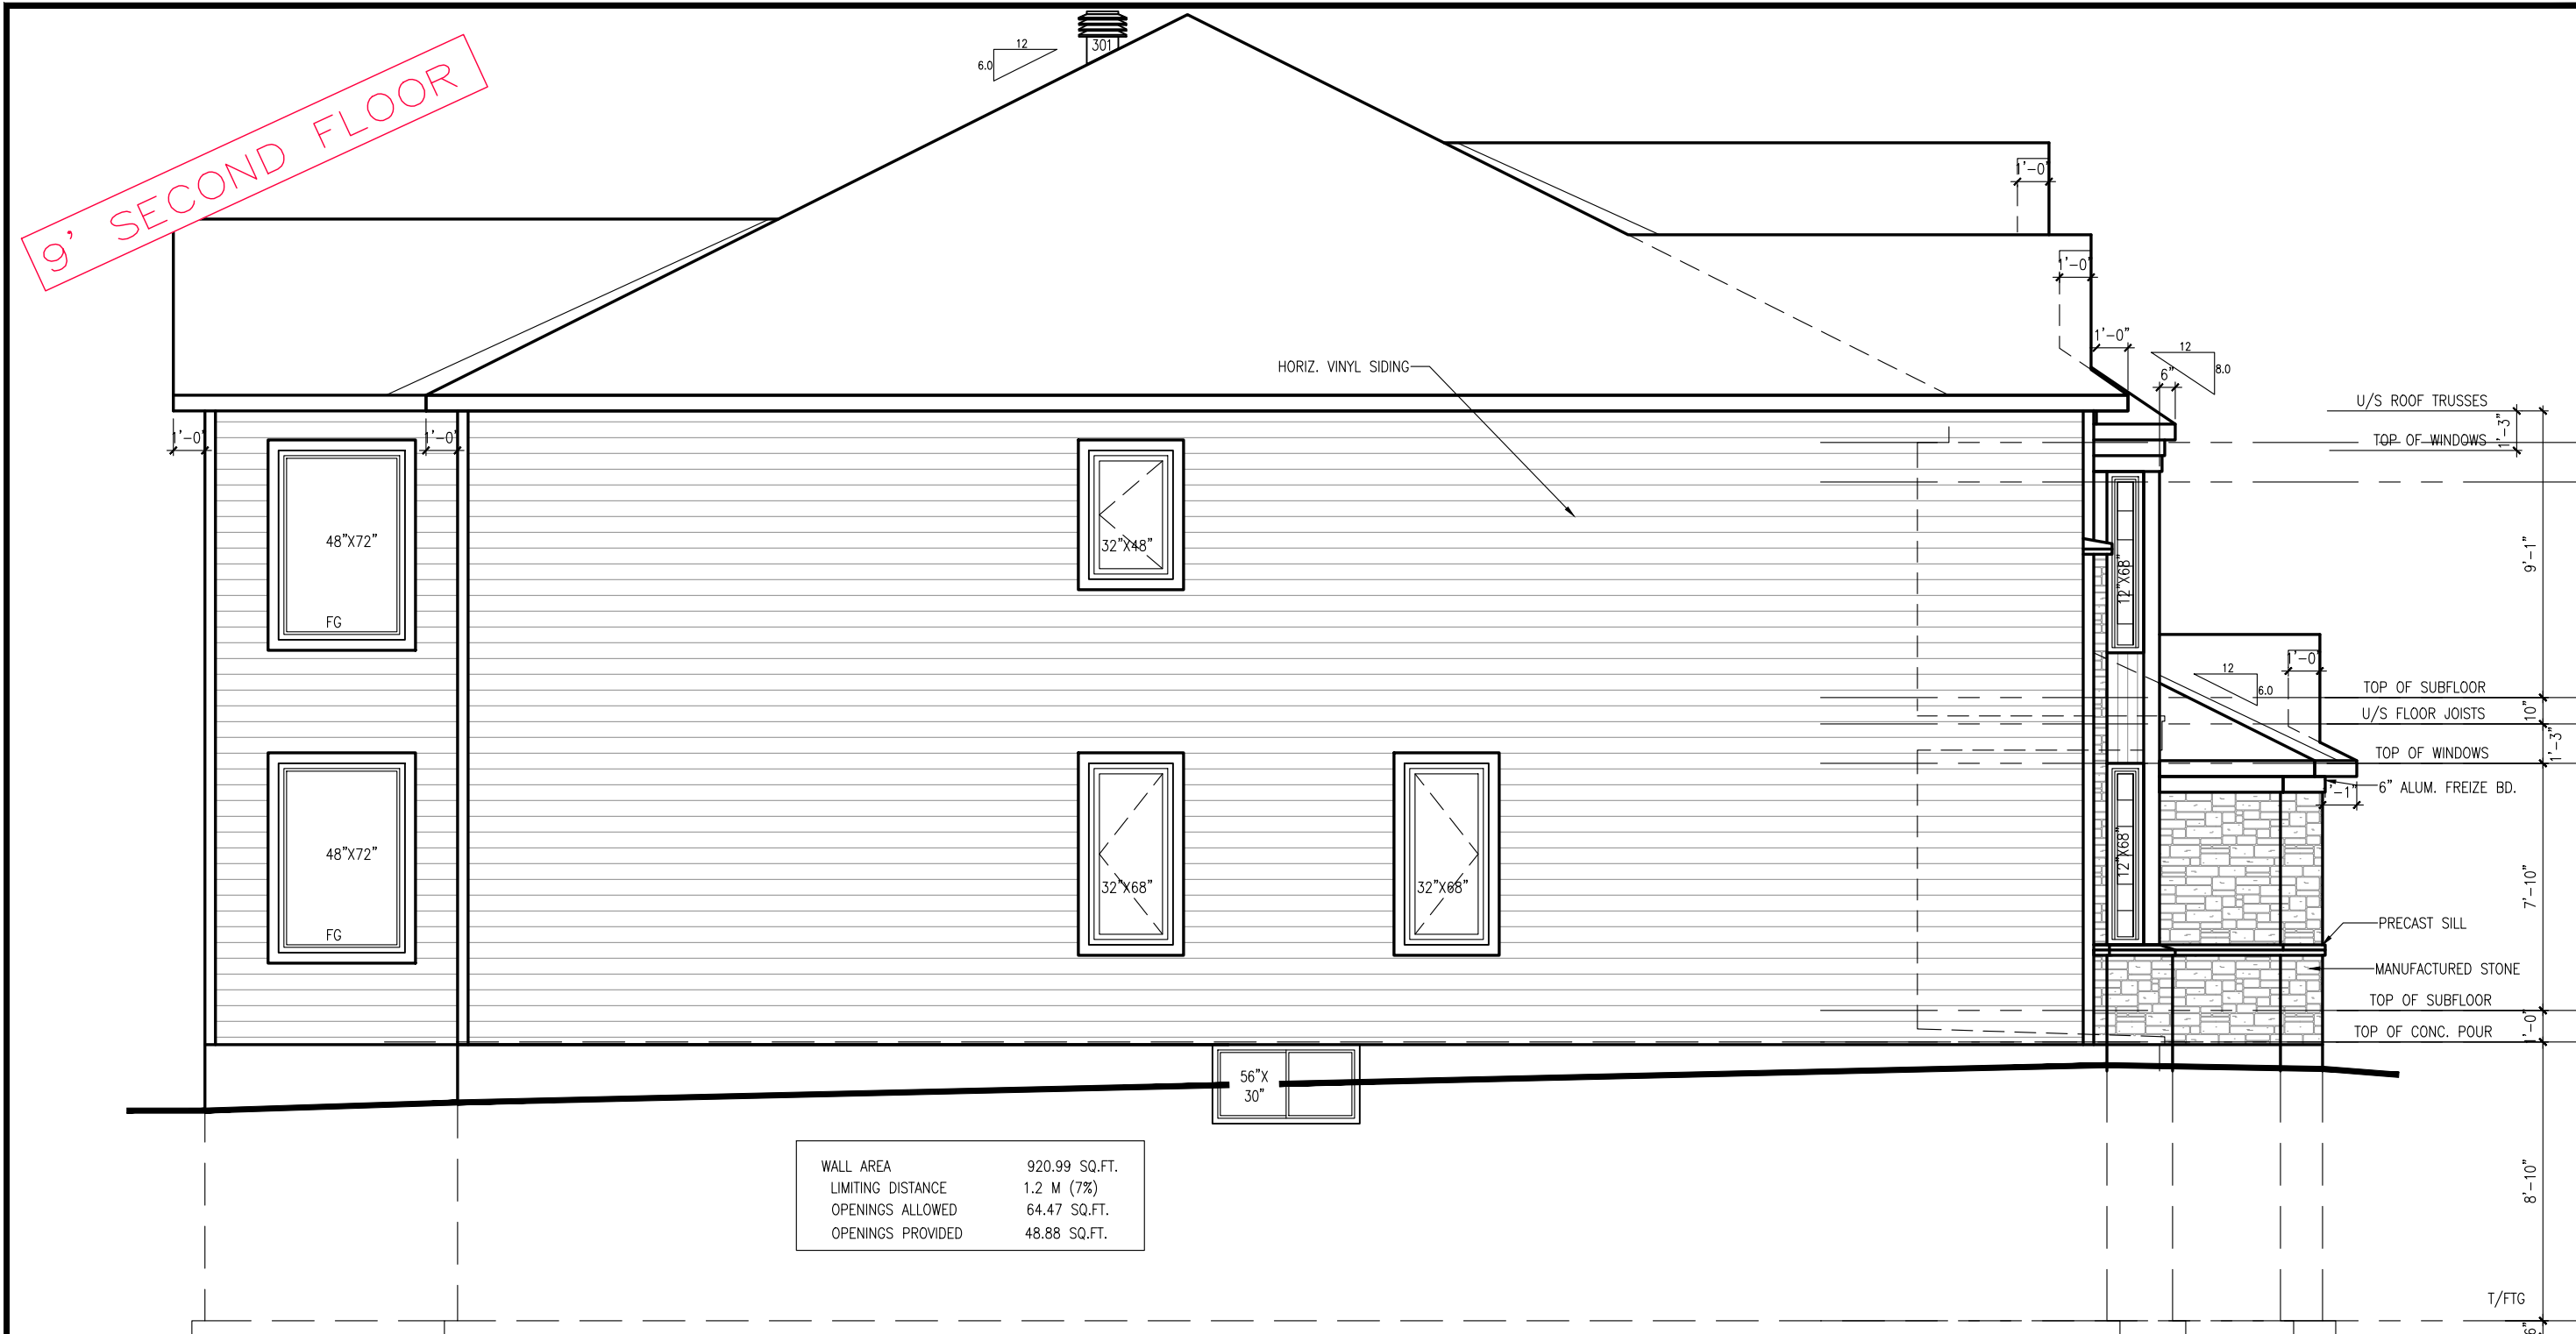

LEFT SIDE ELEVATION 'E'



ANNAPOLIS-2019-E

SITE: PATHWAYS

LOT NUMBER: 19

CIVIC ADDRESS: 21 SALAMANDER WAY

13	MOVE WALL OVEN 15" /ADD PANTRY	JAN-19-22	SP
12	FINAL FOR SITE	JAN-04-22	SP
11	FINAL BLACKLINES -- REVISED	DEC-16-21	SP
10	FINAL BLACKLINES	DEC-15-21	GK
9	BEP FOR SITE	SEPT-29-21	SP
8	ISSUED FOR PERMIT	SEPT-16-21	SP
No.	Description	Date	By
REVISIONS			

file number: 509

drawn by: T.L.


date: DEC. 2012 DCL-79

scale: 3/16"=1'

sheet no: 18

6E
9

9' FOUNDATION POUR

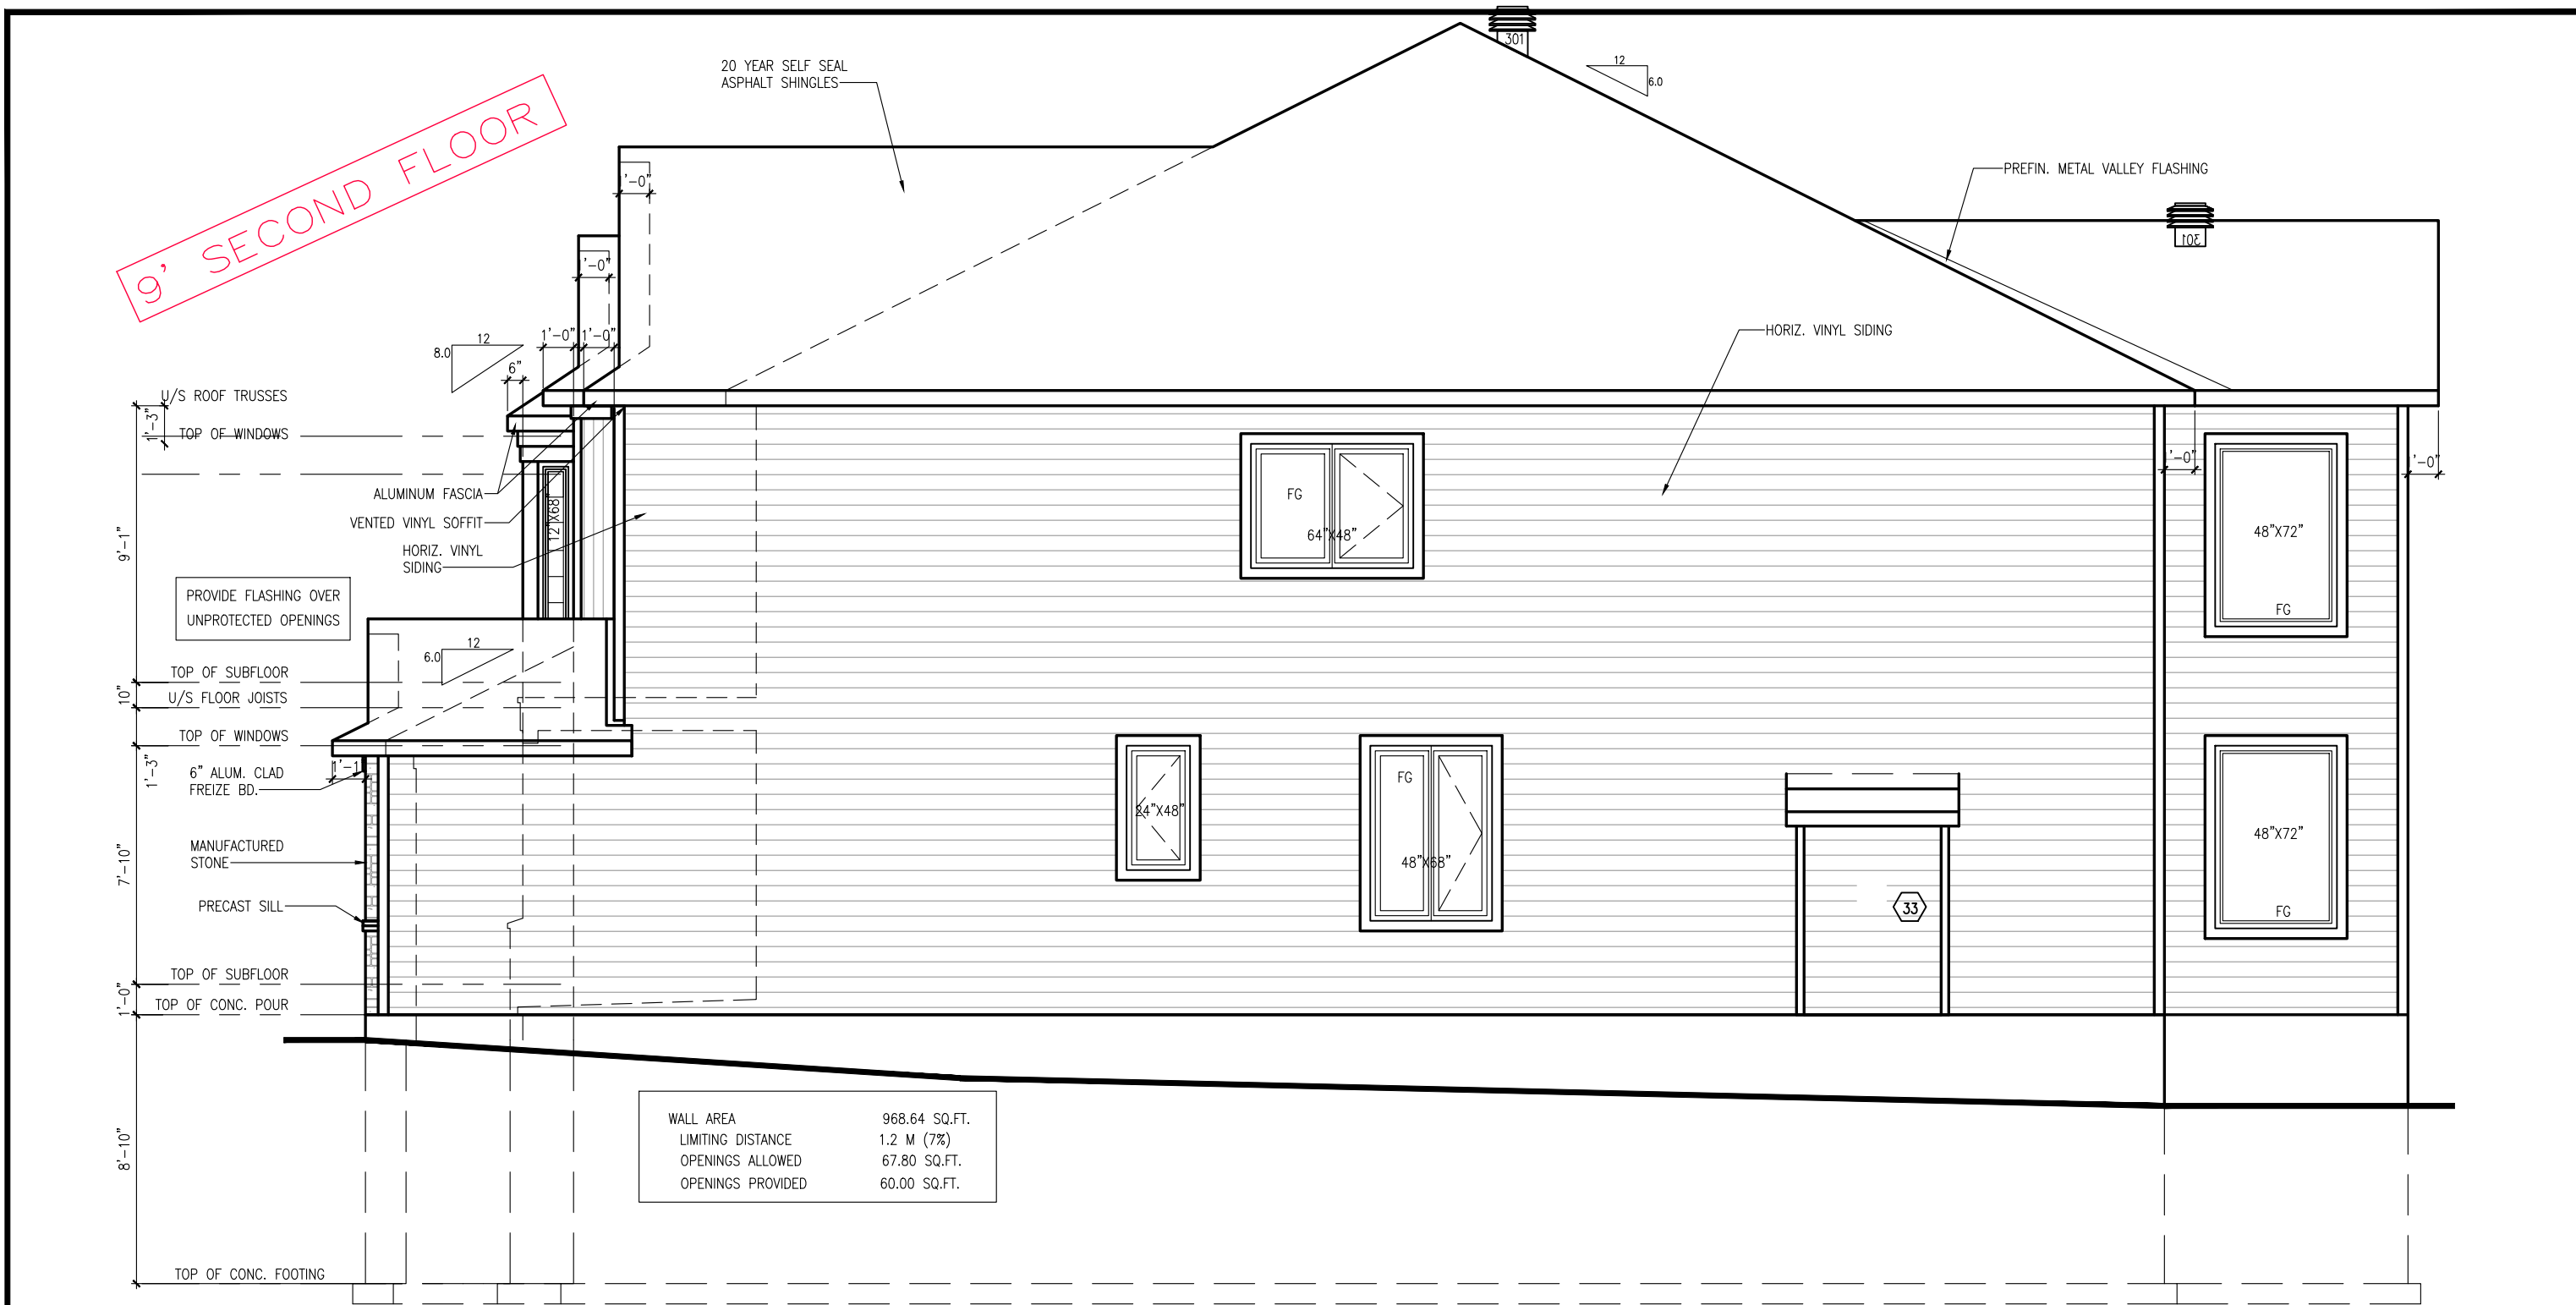

RIGHT SIDE ELEVATION 'E'



ANNAPOLIS-2019-E

SITE: PATHWAYS

LOT NUMBER: 19

CIVIC ADDRESS: 21 SALAMANDER WAY

13	MOVE WALL OVEN 15" /ADD PANTRY	JAN-19-22	SP
12	FINAL FOR SITE	JAN-04-22	SP
11	FINAL BLACKLINES - REVISED	DEC-16-21	SP
10	FINAL BLACKLINES	DEC-15-21	GK
9	BEP FOR SITE	SEPT-29-21	SP
8	ISSUED FOR PERMIT	SEPT-16-21	SP
No.	Description	Date	By
REVISIONS			

file number: 509

drawn by: T.L.

date: DEC. 2012 DCL-79

scale: 3/16"=1'

sheet no: 19

7E
9

9' FOUNDATION POUR



MAXI VENT #301.
TWO REQ'D AT UPPER ROOF NOTE: LOCATIONS SHOWN ARE
APPROXIMATION ONLY AND WILL BE LOCATED ON SITE BY
QUALIFIED INSTALLER.

9' SECOND FLOOR

REAR ELEVATION E&F



ANNAPOLIS-2019-E/F

SITE: PATHWAYS

LOT NUMBER: 19

CIVIC ADDRESS:
21 SALAMANDER WAY

13	MOVE WALL OVEN 15" /ADD PANTRY	JAN-19-22	SP
12	FINAL FOR SITE	JAN-04-22	SP
11	FINAL BLACKLINES - REVISED	DEC-16-21	SP
10	FINAL BLACKLINES	DEC-15-21	GK
9	BEP FOR SITE	SEPT-29-21	SP
8	ISSUED FOR PERMIT	SEPT-16-21	SP
No.	Description	Date	By
REVISIONS			

file number: 509

drawn by: T.L.

date: DEC. 2012

scale: 3/16"=1'

DCL-201
sheet no:


20

8EF
9

9' FOUNDATION POUR

CONTRACTOR MUST VERIFY ALL DIMENSIONS ON THE JOB AND REPORT ANY DISCREPANCY TO DCR/PHOENIX BEFORE PROCEEDING WITH THE WORK. ALL DRAWINGS AND SPECIFICATIONS ARE INSTRUMENTS OF SERVICE AND THE PROPERTY OF THE DCR/PHOENIX WHICH MUST BE RETURNED AT THE COMPLETION OF THE WORK. ALL DRAWINGS TO BE USED FOR CONSTRUCTION ONLY AFTER BUILDING PERMIT HAS BEEN ISSUED. DO NOT SCALE DRAWINGS, USE DIMENSIONS PROVIDED.

9' SECOND FLOOR

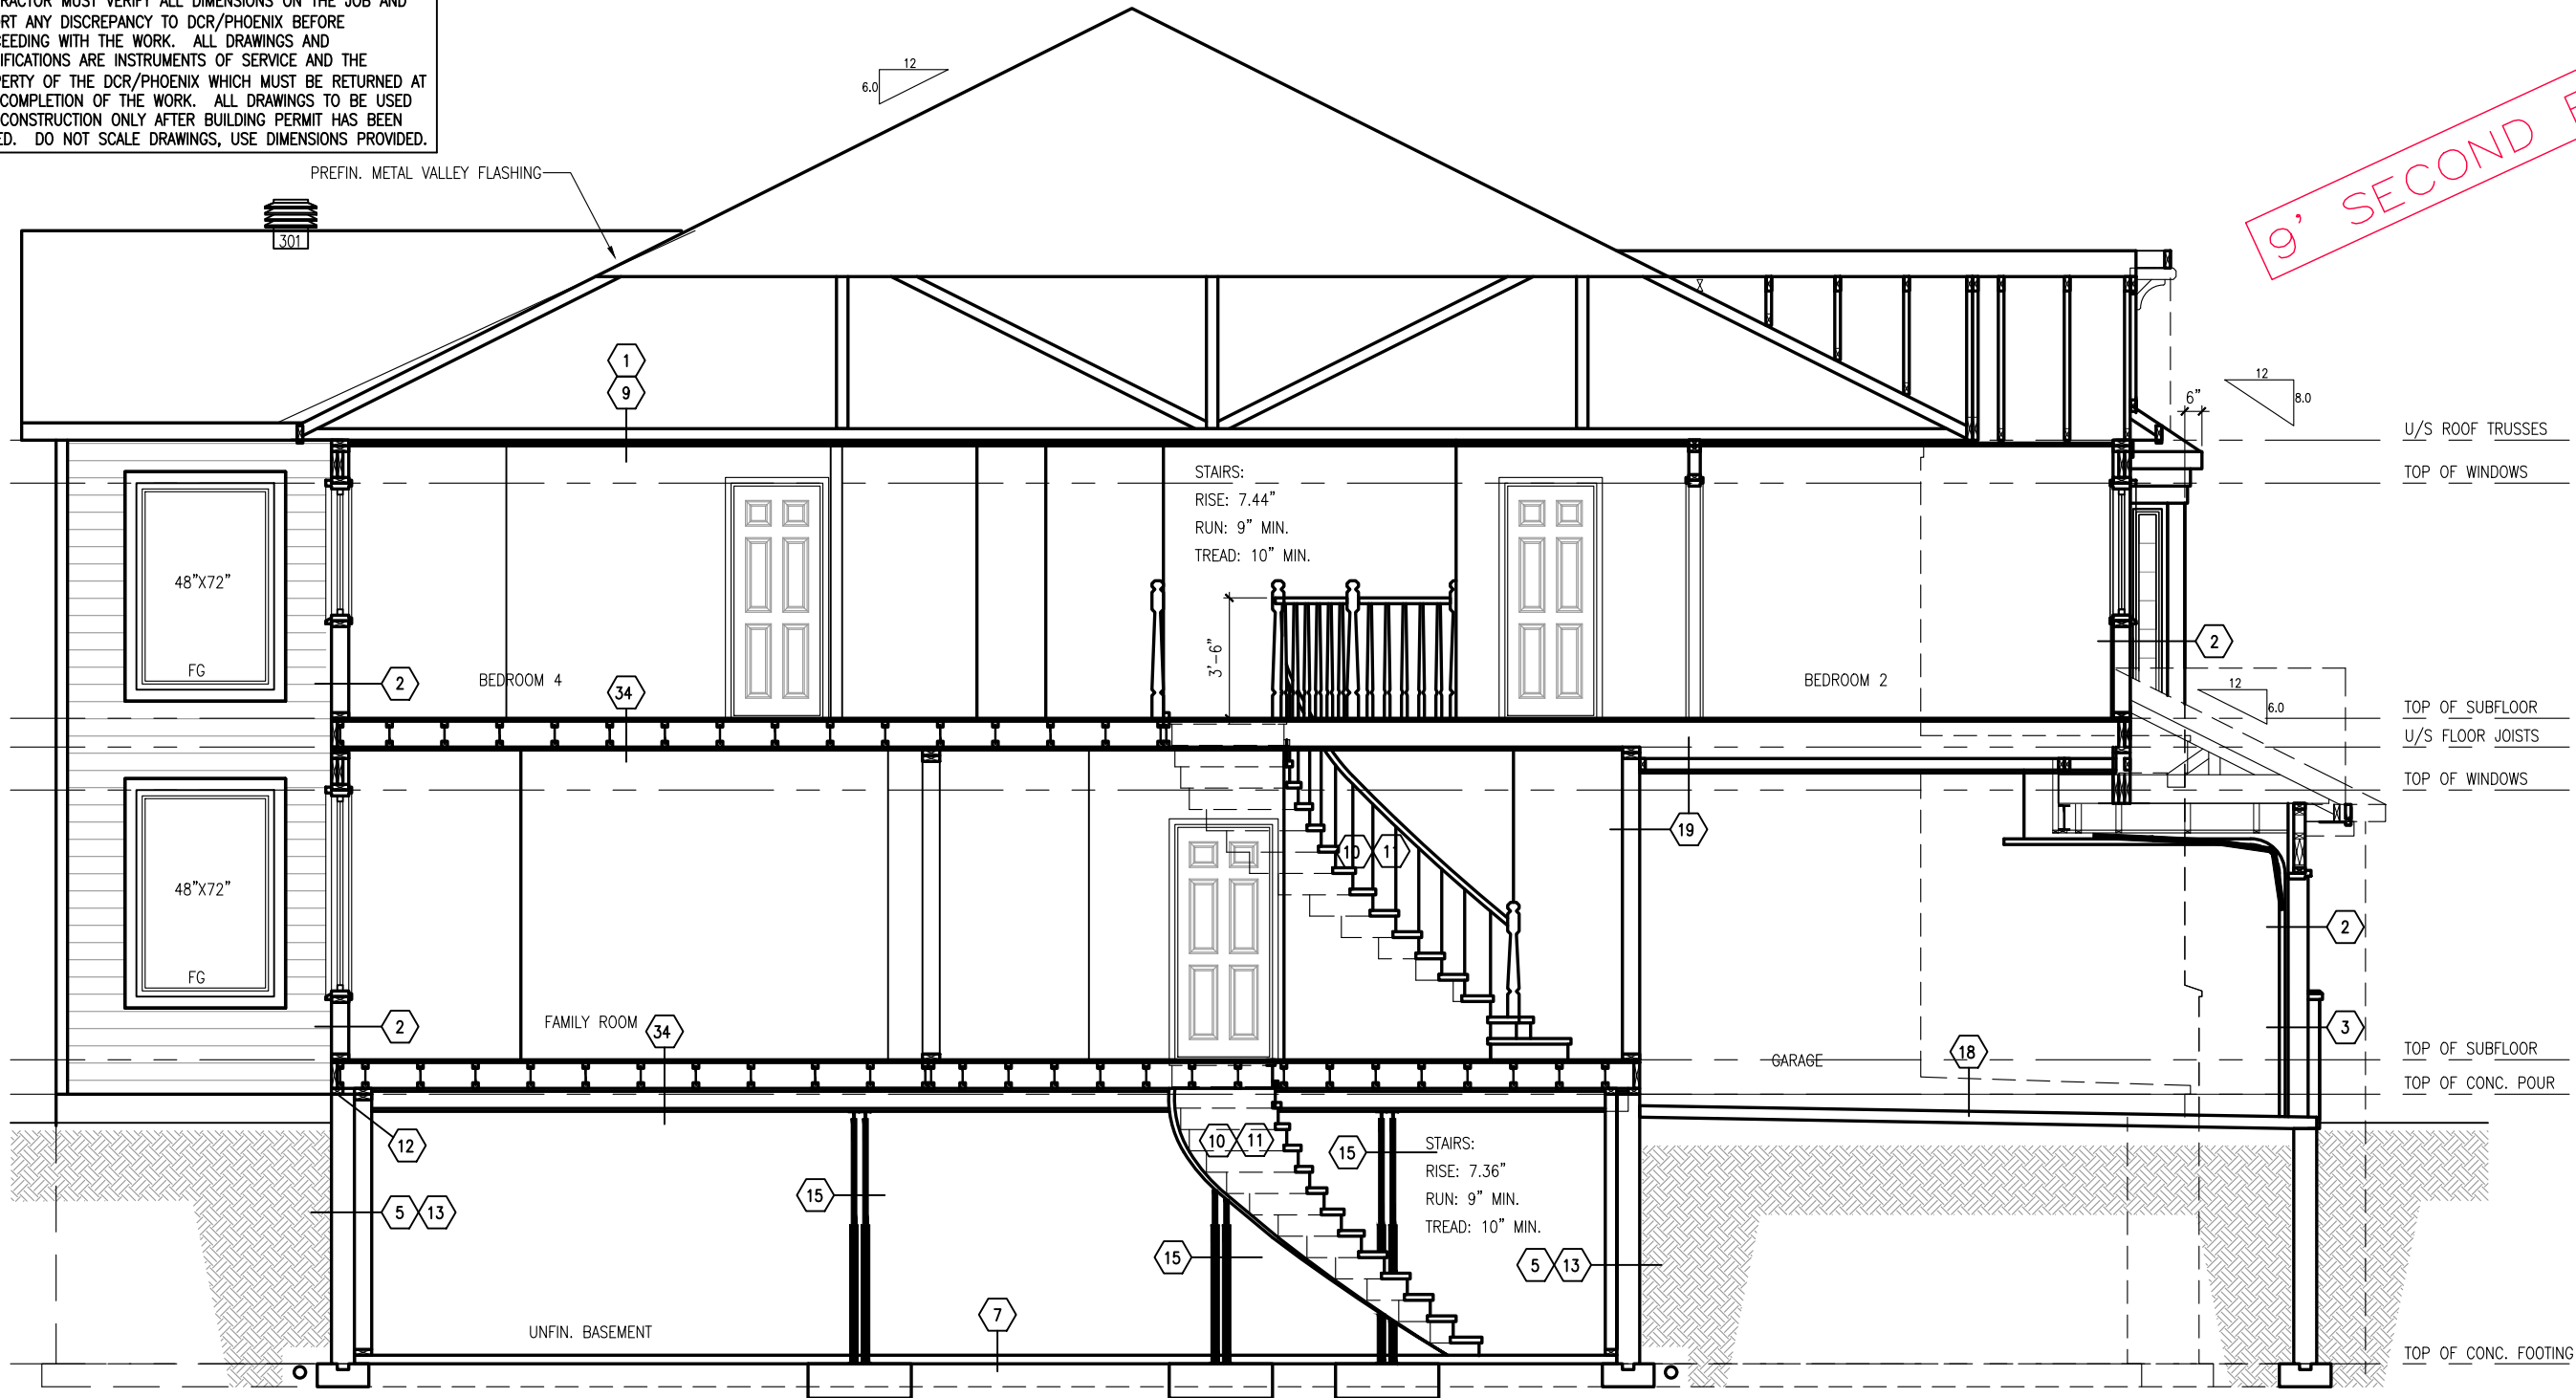

SECTION @ STAIRS



ANNAPOLIS-2019-E

SITE: PATHWAYS

LOT NUMBER:

19

CIVIC ADDRESS:
21 SALAMANDER WAY

13	MOVE WALL OVEN 15" /ADD PANTRY	JAN-19-22	SP
12	FINAL FOR SITE	JAN-04-22	SP
11	FINAL BLACKLINES - REVISED	DEC-16-21	SP
10	FINAL BLACKLINES	DEC-15-21	GK
9	BEP FOR SITE	SEPT-29-21	SP
8	ISSUED FOR PERMIT	SEPT-16-21	SP
No.	Description	Date	By
REVISIONS			

file number: 509
drawn by: T.L.
date: DEC. 2012
scale: 3/16"=1'
DCL-201 sheet no:
9E 9