

REVISED 1/19/2022

* SEE HIGHLIGHTED FOR
CHANGES +

DCR PHOENIX HOMES

LOT #19

PATHWAYS

MODEL - ANNAPOLIS (509)

KITCHEN

MOUNTING HEIGHT -96

39"H UPPERS @ 21"
ABOVE COUNTER

FILL TO CEILING WITH
PLAIN PANEL IN MATCHING
MATERIAL & COLOUR TO CABINETS

LIGHT VALANCE

CABINETS -

HARDWARE -


STANDARD WHITE INTERIOR

METAL DRAWER BOX


4 PCS - 5/8" KICK - FIN. BOTH ENDS

2 PCS - 90 DEG. CORNER MOULD

1 PCS - T-MOULD

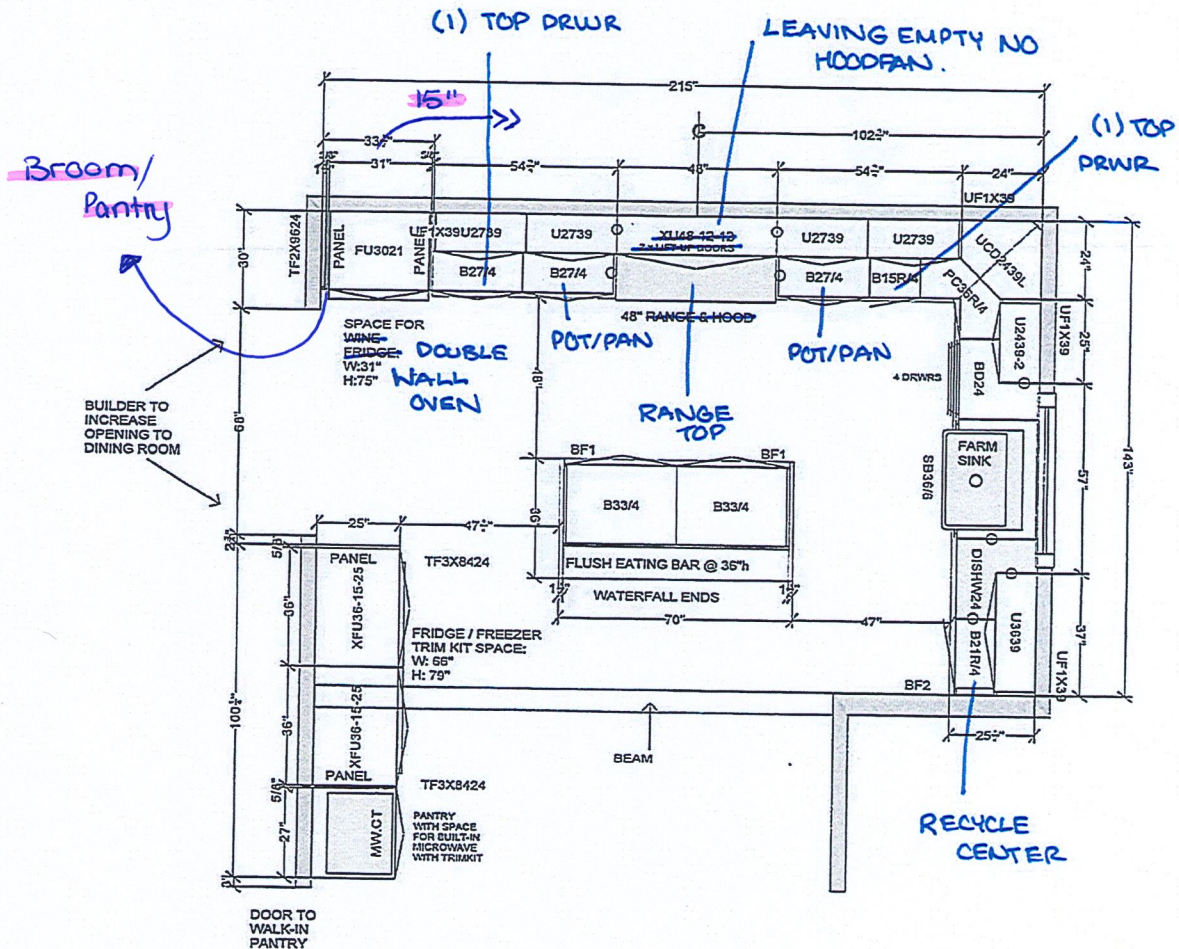


CUSTOMER APPROVAL I have reviewed this design and understand the details of the design and the materials and finishes. Signature: _____ Date: _____	All dimensions, size designations given are subject to verification on job site and adjustment to fit job conditions.	SPECTRUM	This is an original design and must not be released or copied unless applicable fee has been paid or job order placed.	Designed: 11/10/2020 Printed: 11/11/2020
DCR #21 PWYS - KITCHEN - ANNAPOLIS				Drawing #: 1 No Scale.

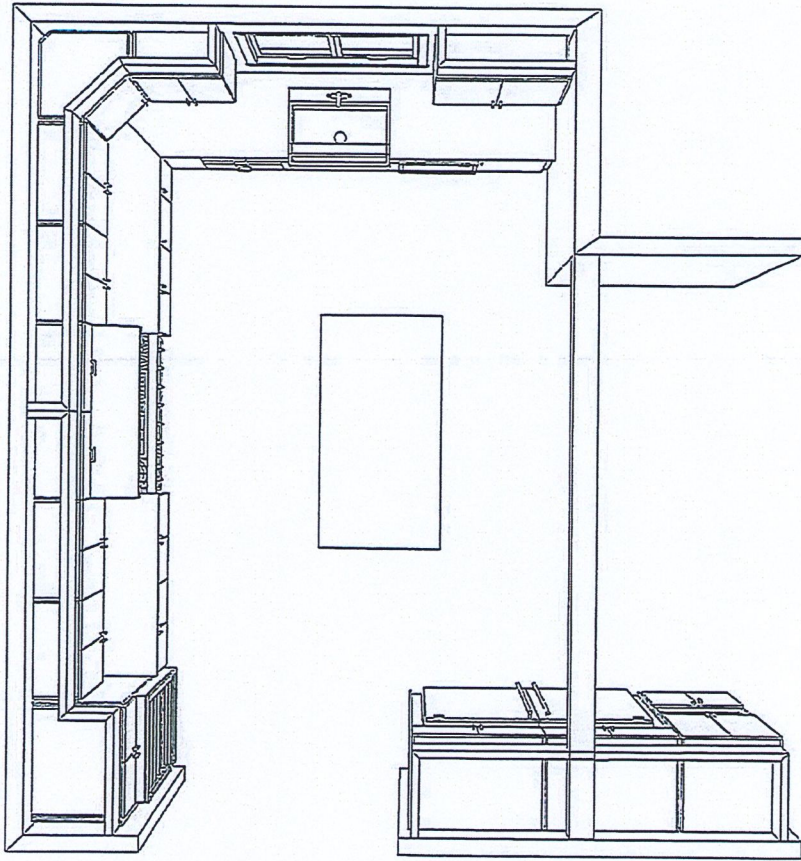

KITCHEN - TOP VIEW

CUSTOMER APPROVAL I have reviewed these drawings and understand the details of the design and the Center Kitchens specifications Signature _____ Date _____		SPECTRUM KITCHEN DESIGN	DCR #21 PWYS - KITCHEN - ANNAPOLIS	Alt	Designed: 11/11/2020 Printed: 11/11/2020

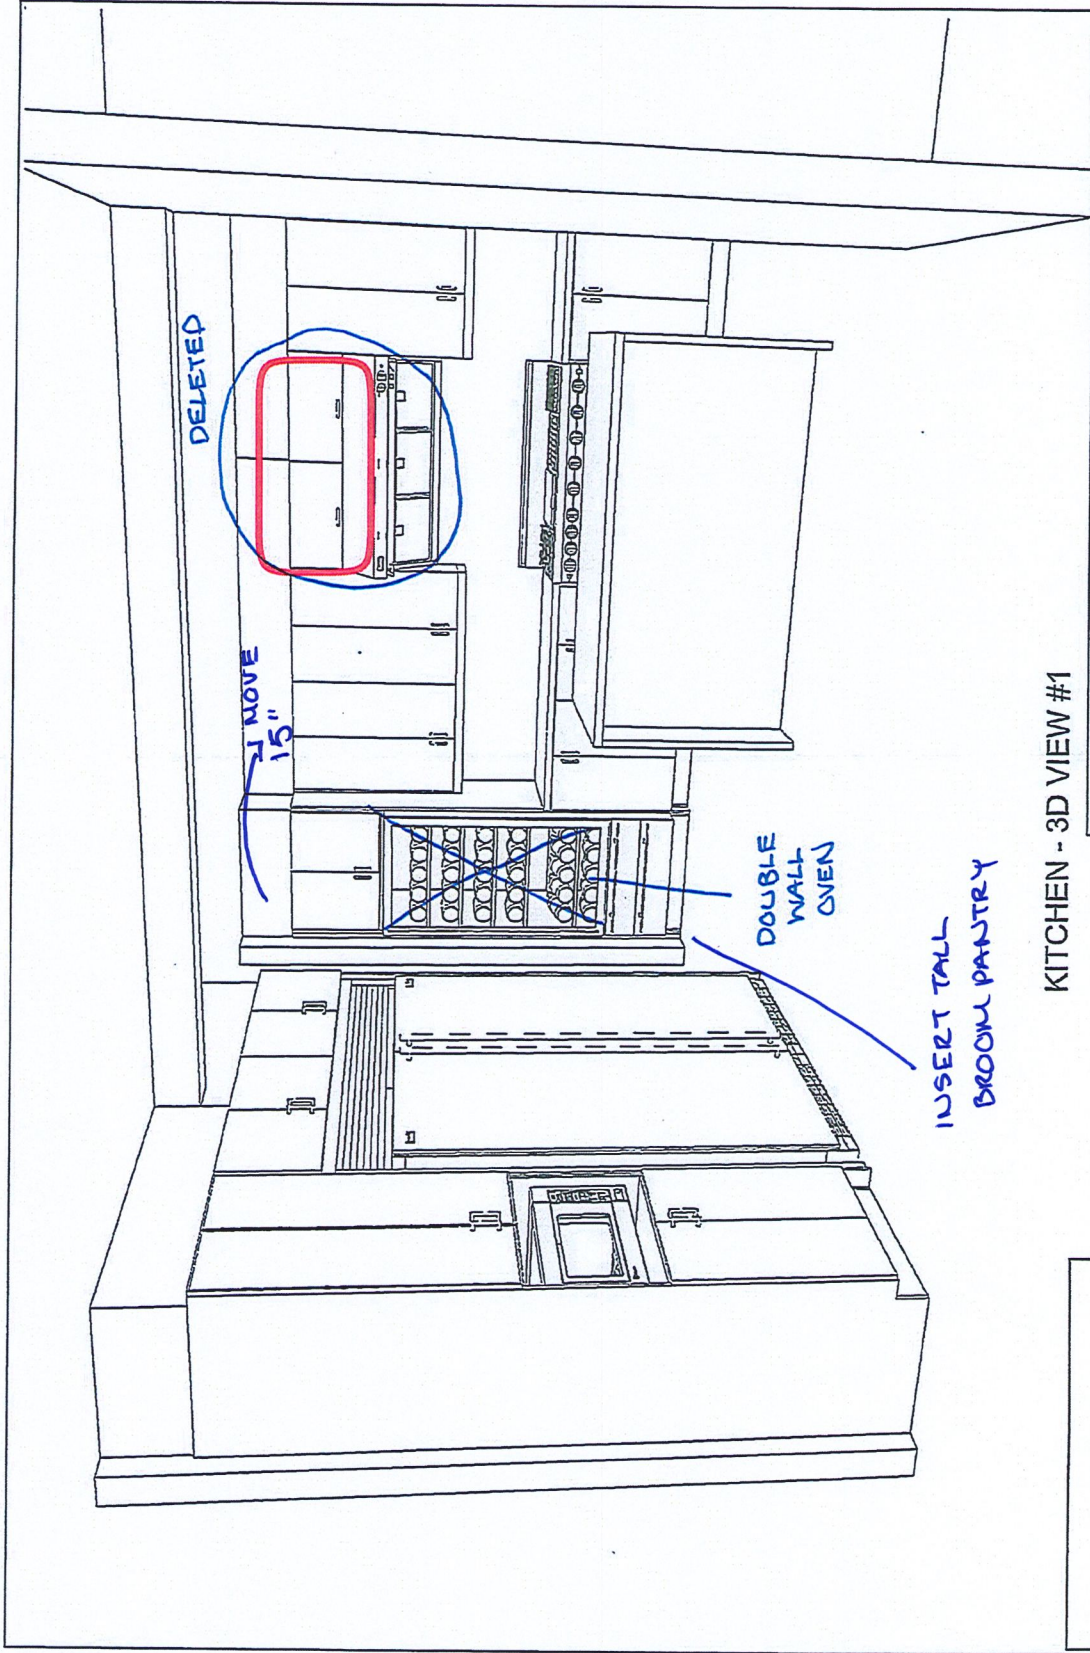

KITCHEN - 3D VIEW #1

Note: This drawing is an artistic interpretation of the general appearance of the design. It is not meant to be an exact rendition.

SPECTRUM
interior architecture

Designed: 11/10/2020
Printed: 11/11/2020

DCR #21 PWYS - KITCHEN - ANNAPOLIS	ALL	Drawing #: 1
------------------------------------	-----	--------------


CUSTOMER APPROVAL

I have reviewed these drawings and understand the details of the design and the Cabinet Kitchen's specifications

Signature _____

Date _____



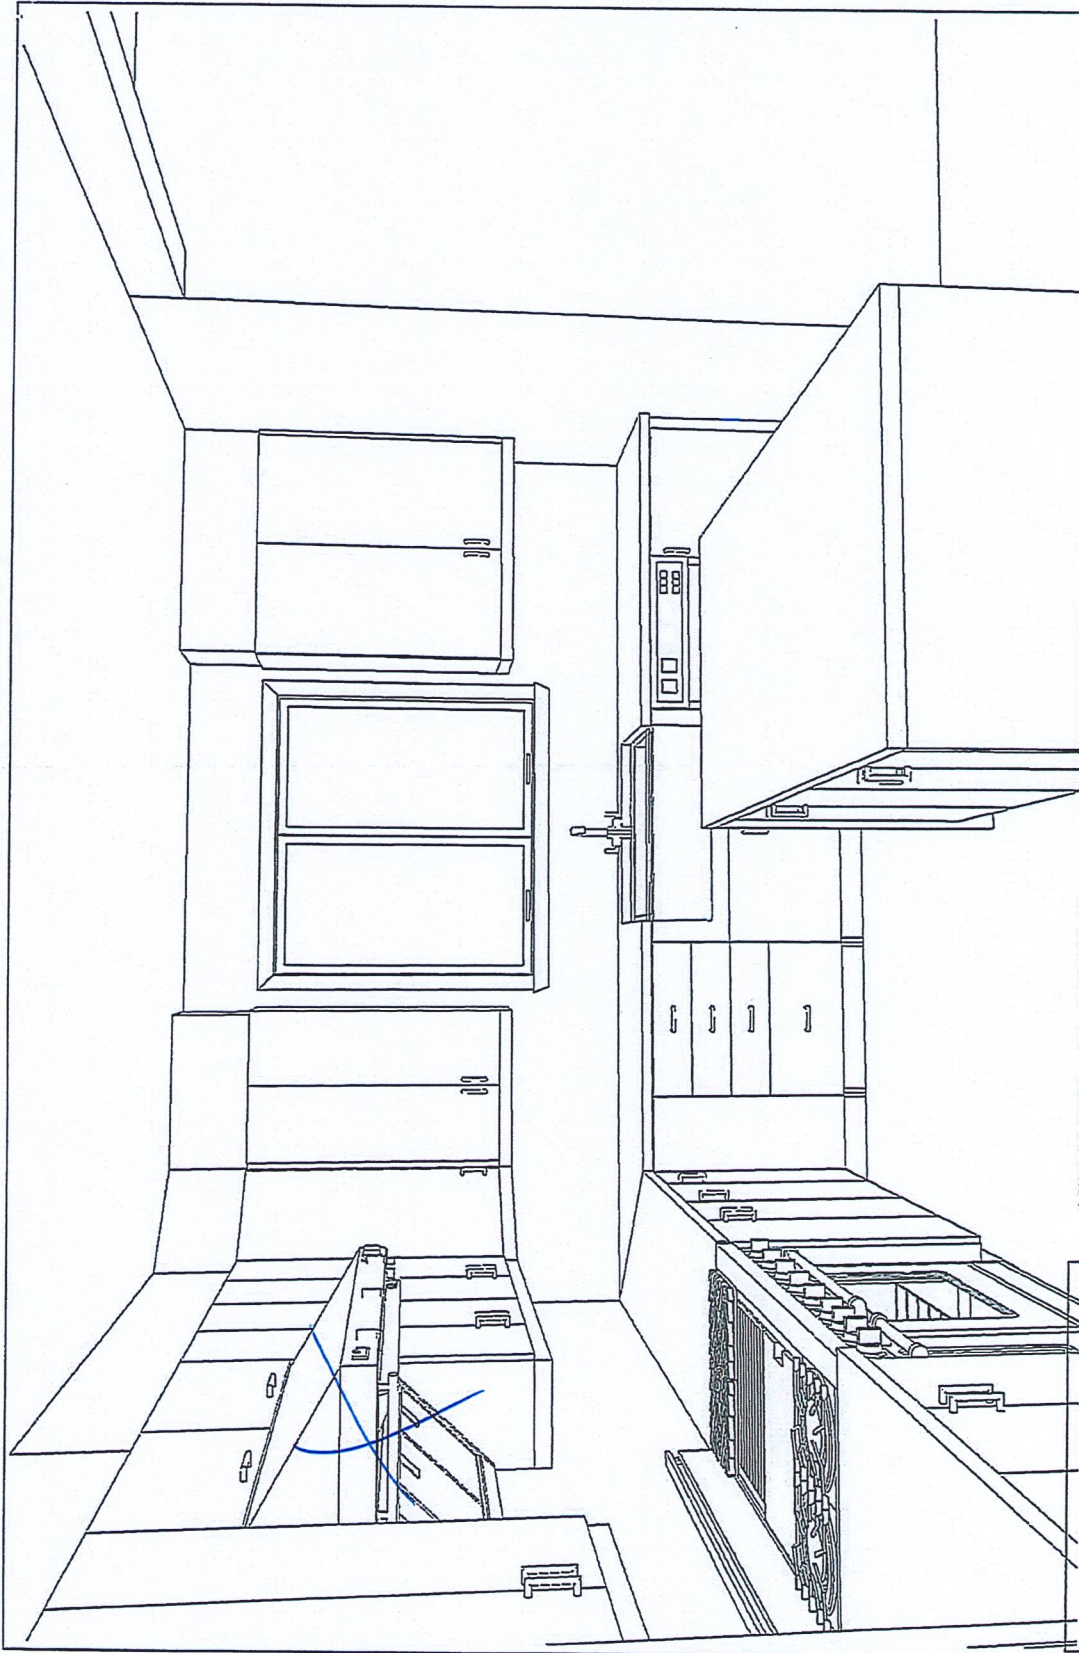

KITCHEN - 3D VIEW #2

Designed: 11/10/2020
Printed: 11/11/2020



Note: This drawing is an artistic interpretation of the general appearance of the design. It is not meant to be an exact rendition.

Drawing #: 1


All

DCR #21 PWYS - KITCHEN - ANNAPOLIS

CUSTOMER APPROVAL


I have reviewed these drawings and understand the details of the design and the Center Kitchens specifications


Signature _____
Date _____

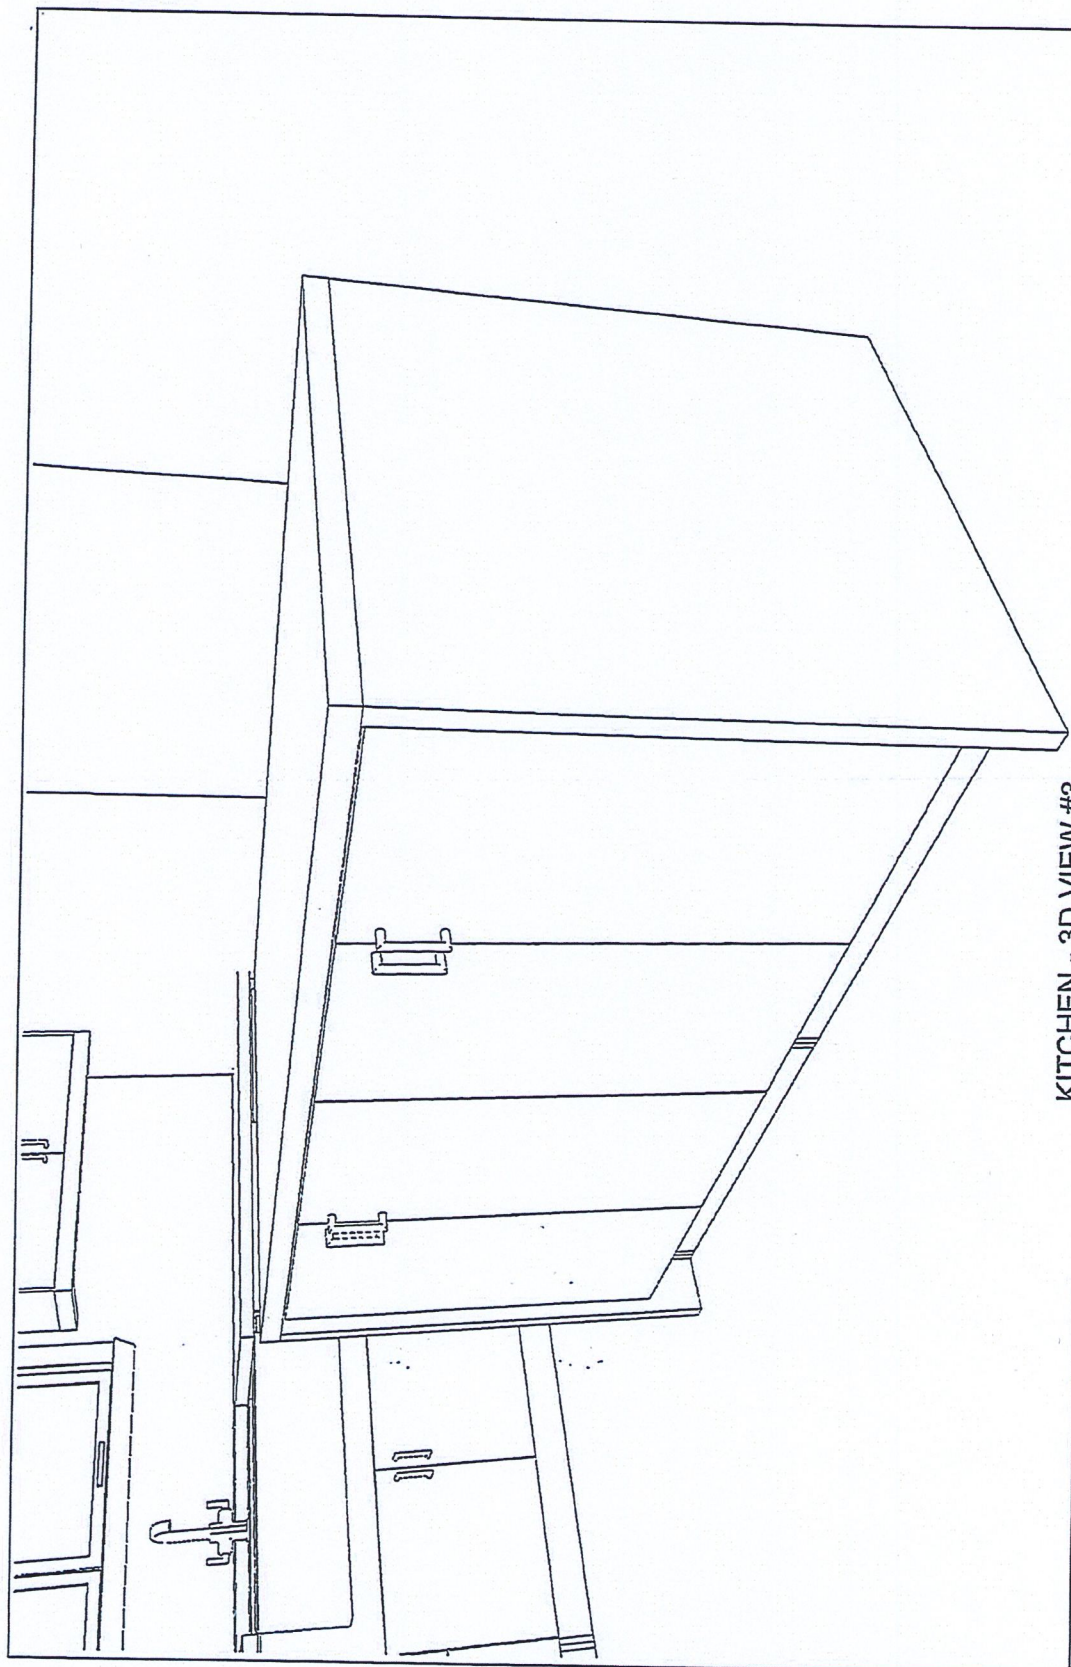

KITCHEN - 3D VIEW #3

CUSTOMER APPROVAL I have reviewed these drawings and understand the details of the design and the Client Kitchen's specifications Signature _____ Date _____		Note: This drawing is an artistic interpretation of the general appearance of the design. It is not meant to be an exact rendition.		Designed: 11/10/2020 Printed: 11/11/2020
DCR #21 PWYS - KITCHEN - ANNAPOLIS		All	Drawing #: 1	

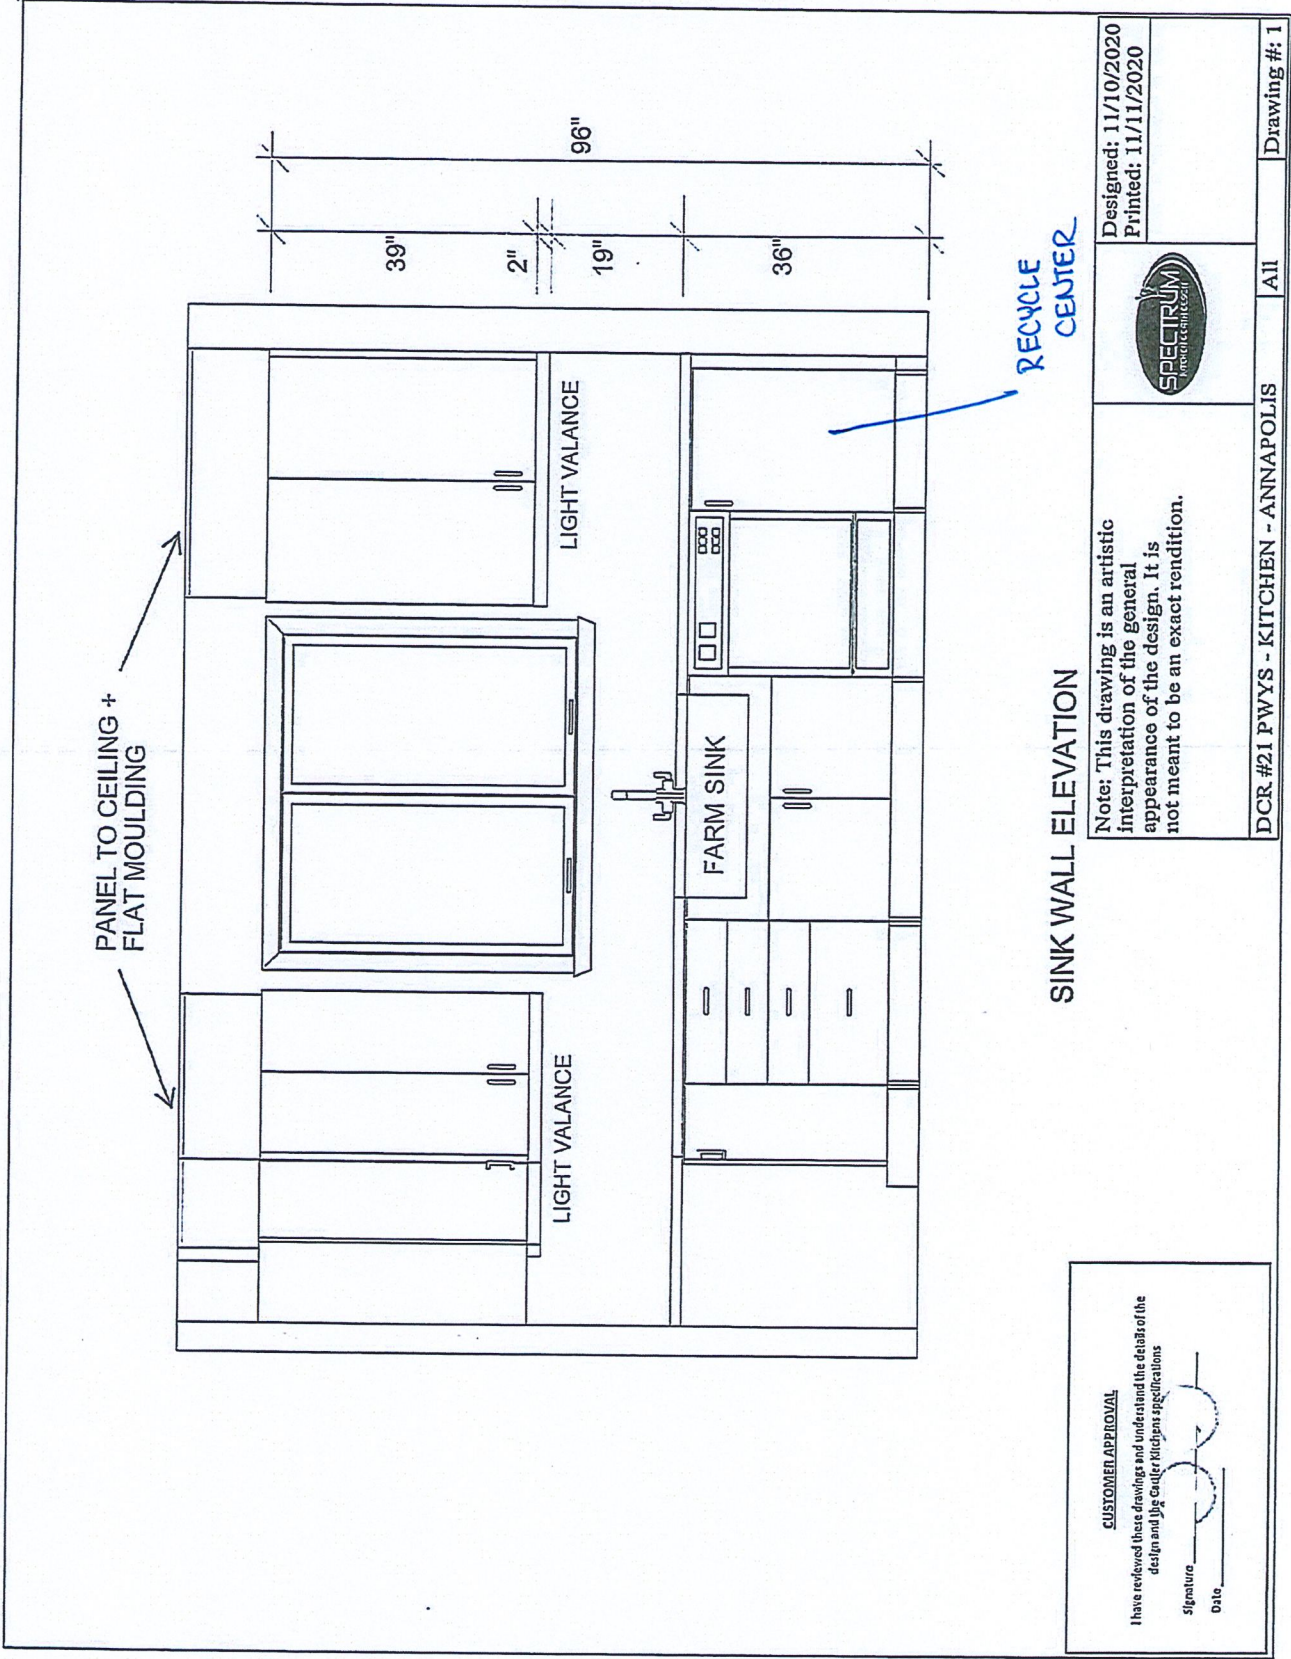

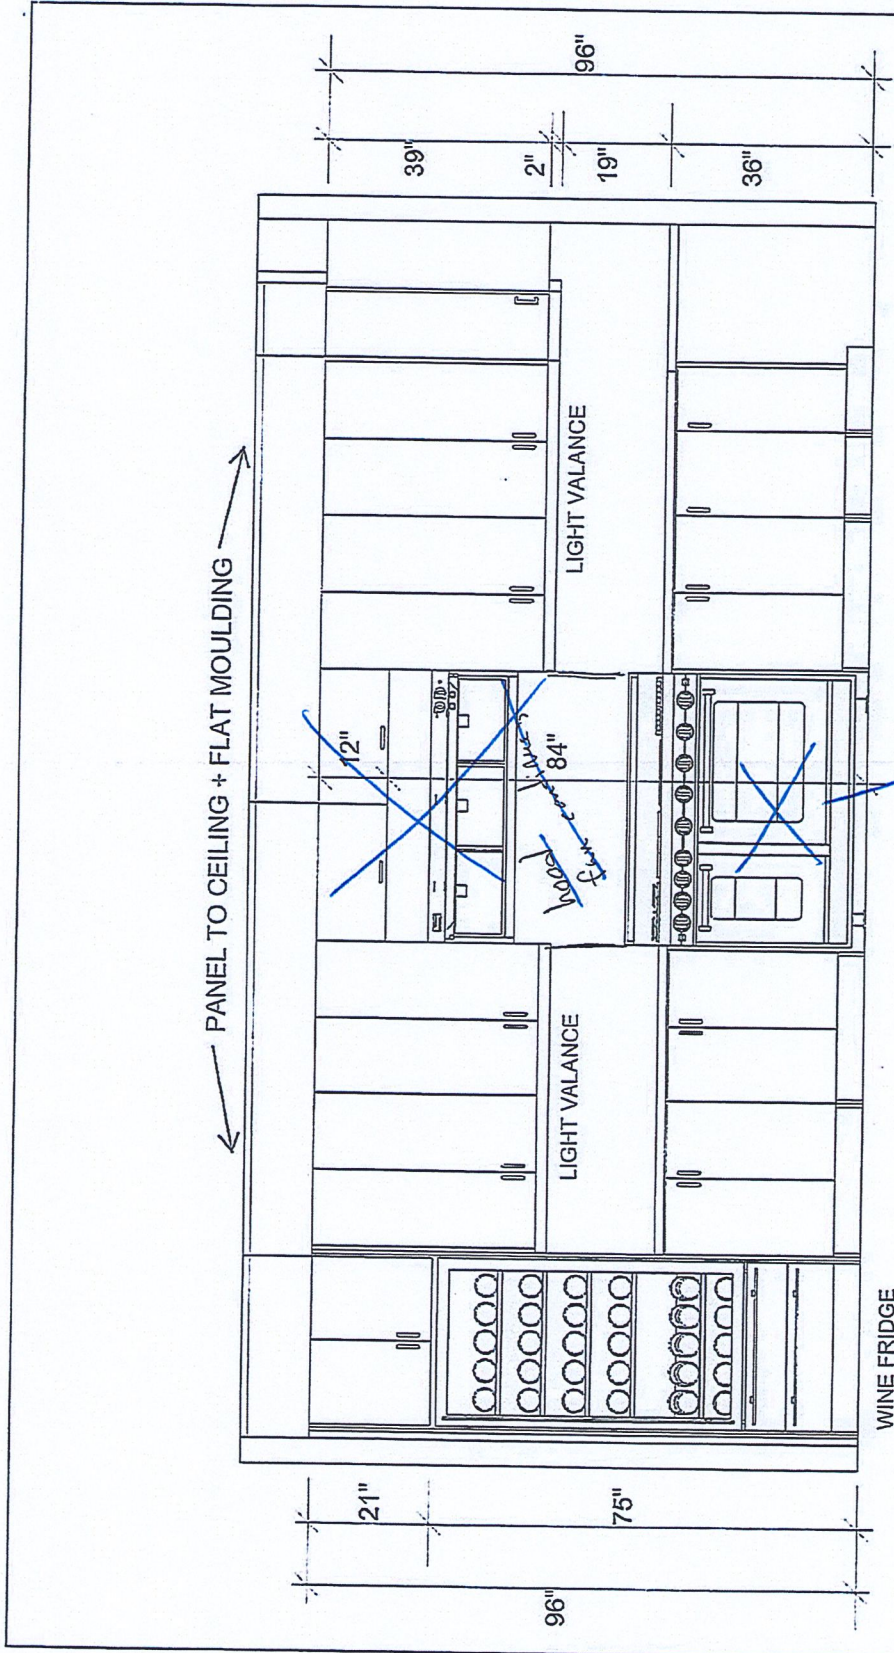

RANGE / WINE FRIDGE WALL ELEVATION

CUSTOMER APPROVAL

I have reviewed these drawings and understand the details of the design and the Carter Kitchens specifications

Signature _____ Date _____


Note: This drawing is an artistic interpretation of the general appearance of the design. It is not meant to be an exact rendition.

SPECTRUM
interiorspaces

Designed: 11/10/2020
Printed: 11/11/2020

DCR #21 PWYS - KITCHEN - ANNAPOLIS All Drawing #: 1

PANEL TO CEILING + FLAT MOULDING ↗

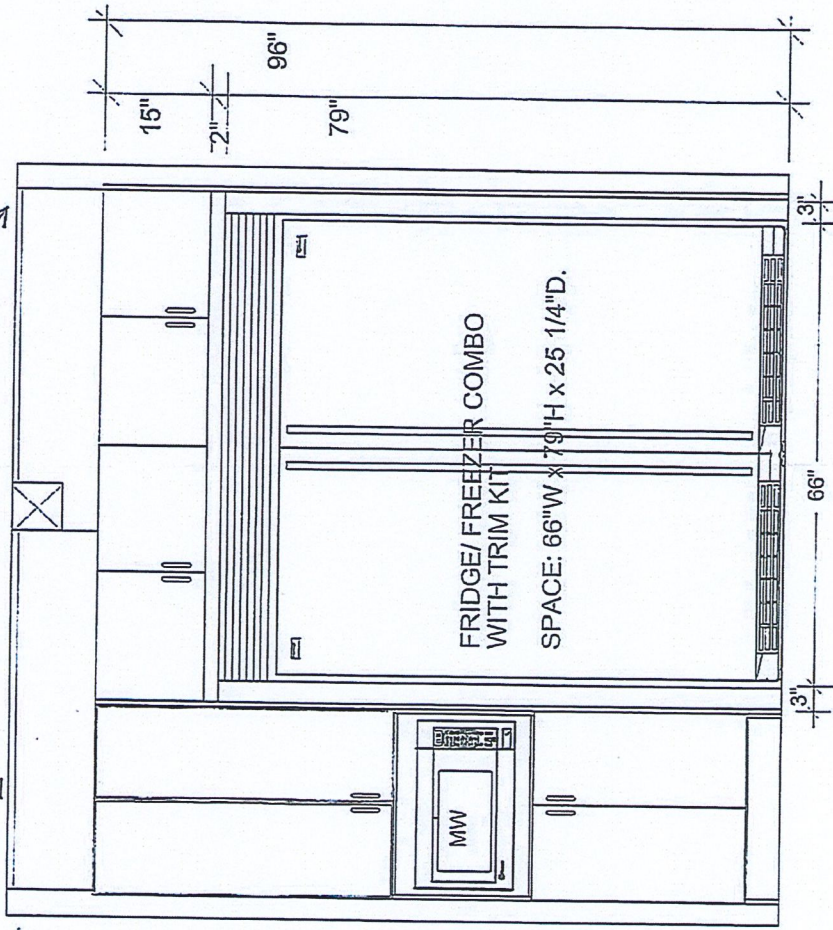

FRIDGE WALL ELEVATION

CUSTOMER APPROVAL
I have reviewed these drawings and understand the details of the design and the Carling Kitchens specifications

Signature _____
Date _____

Note: This drawing is an artistic interpretation of the general appearance of the design. It is not meant to be an exact rendition.



Designed: 11/10/2020
Printed: 11/11/2020

DCR #21 PWYS - KITCHEN - ANNAPOLIS

All

Drawing #: 1