

DCR PHOENIX HOMES



LOT #155
PATHWAYS

MODEL: MIRAPOSA PLUS (LEFT)
KITCHEN & VANITIES

- CABINETS -
HARDWARE -
STANDARD WHITE INTERIORS
METAL DRAWER BOX
4 PCS - 5/8" TOEKICK
1PCS - 90 DEG. CORNER MOULD
1PCS - T MOULD
8 PCS - FLAT MOULDINGS

GROUND FLOOR KITCHEN


MOUNTING HEIGHT 96"H.
42" H. UPPERS INSTALLED
@18" ABOVE COUNTER

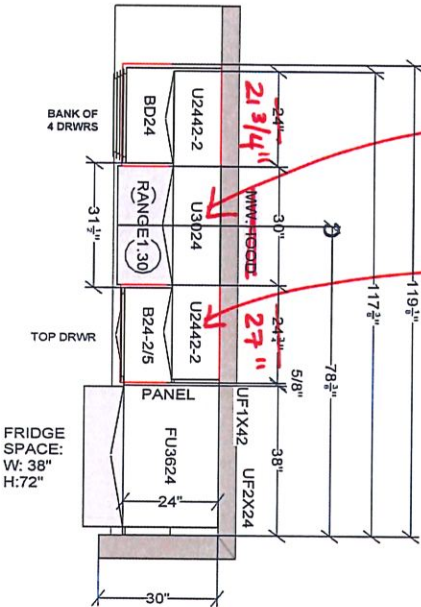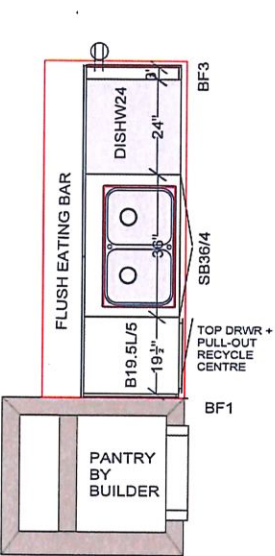


CHIMNEY HOOD.

STANDARD MW / SHELF.


VANITIES

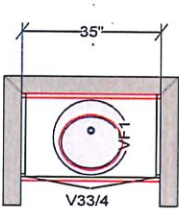

POWDER ROOM

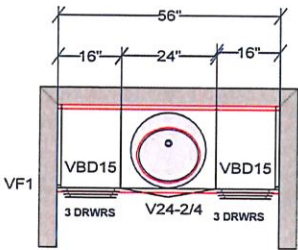

MAIN BATH

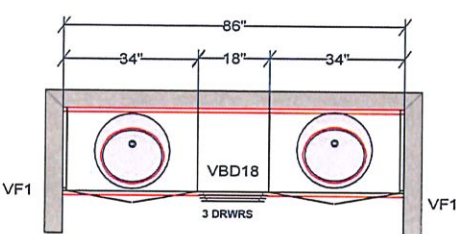

LUXURY ENSUITE

CUSTOMER APPROVAL

I have reviewed these drawings and found the details of the design and the Cabinet finishes specifications

Signature: JSB
Date: Dec. 17/20

All dimensions, size designations given are subject to verification on job site and adjustment to fit job conditions.



This is an original design and must not be released or copied unless applicable fee has been paid or job order placed.

Designed: 9/13/2020
Printed: 9/14/2020

DCR #155 Pathways - MIRAPOSA - Kitchen vanities

All

Drawing #: 1

No Scale.

DCR PHOENIX HOMES

LOT #155
PATHWAYS
MODEL: 35-32 MIRAPOSA PLUS



BASEMENT APARTMENT

KITCHEN & VANITIES

- CABINETS -
HARDWARE -
STANDARD WHITE INTERIORS
METAL DRAWER BOX
4 PCS - 5/8" TOEKICK
1PCS - 90 DEG. CORNER MOULD
1PCS - T MOULD
8 PCS - FLAT MOULDINGS

KITCHEN

MOUNTING HT: 96
42"H UPPERS INSTALLED
@ 18" ABOVE COUNTER

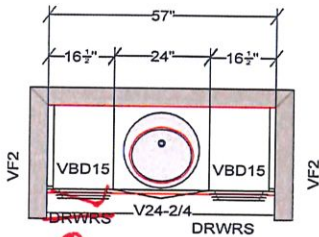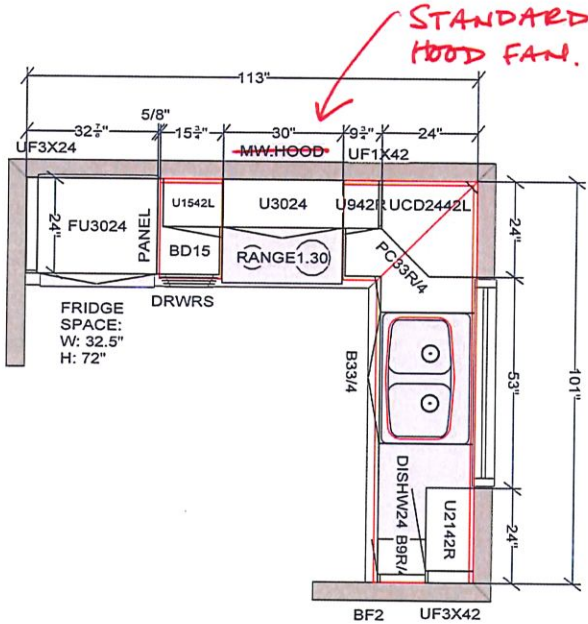

BSMT APT VANITY

CUSTOMER APPROVAL
I have reviewed these drawings and understand the details of the design and the Carrier Kitchen specifications
Signature _____
Date _____
Dec. 17/20

All dimensions size designations given are subject to verification on job site and adjustment to fit job conditions.



This is an original design and must not be released or copied unless applicable fee has been paid or job order placed.

Designed: 9/13/2020
Printed: 9/14/2020