


DCR - PHOENIX HOMES

NEWINGTON III
KITCHEN

MOUNTING HEIGHT: 84

- KITCHEN
LINE 1 & 2
HARDWARE - STD & 1st UPGRADE
STANDARD WHITE INTERIOR
METAL DRAWER BOX
3 PCS - 5/8" KICK - FIN. BOTH ENDS
3 PCS - LOOSE FILLER - 3 x 96
2 PCS - 90 DEG. CORNER MOULD
1 PCS - T-MOULD
1 PCS - FLAT MOULDING

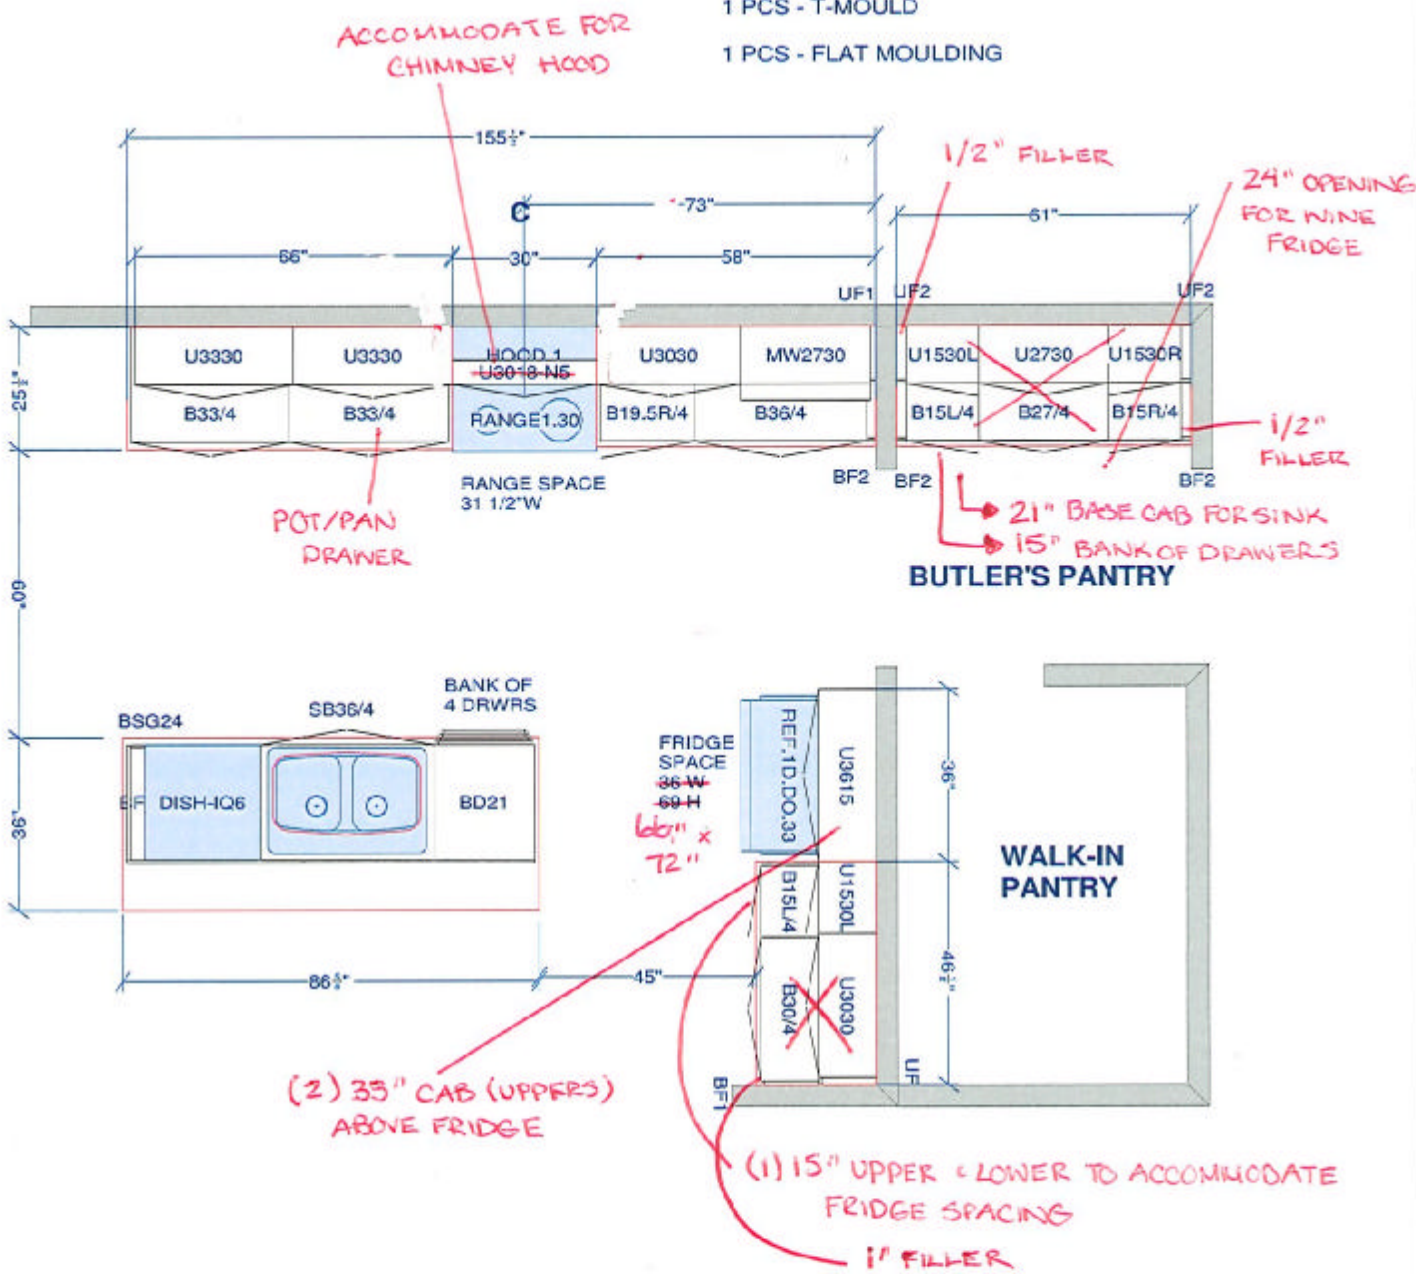

CUSTOMER APPROVAL
I have reviewed these drawings and understand the details of the design and the Customer's specifications.
Signature _____
Date _____

All dimensions, size designations given are subject to verification on job site and adjustment to fit job conditions.

NEWINGTON III






This is an original design and must not be released or copied unless applicable fee has been paid or job order placed.

Designed: 2017-07-04
Printed: 2017-07-04

Drawing #: 1 No Scale.

DS DS
PHOENIX

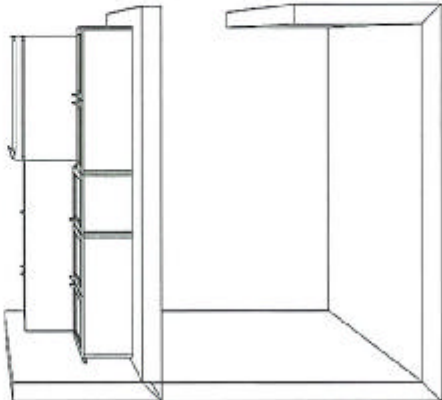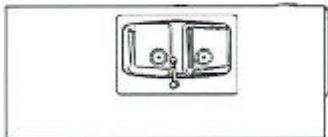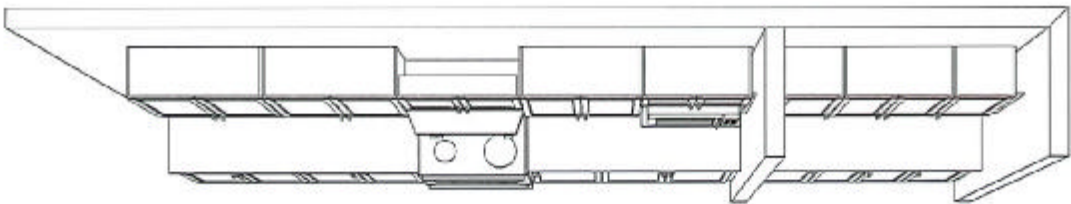

KITCHEN TOP VIEW
NEWINGTON III - STANDARD KITCHEN

CUSTOMER APPROVAL

I have reviewed these drawings and understand the details of the design and the Centle Kitchens specifications

Signature _____
Date _____

Note: This drawing is an artistic interpretation of the general appearance of the design. It is not meant to be an exact rendition.



Designed: 2017-07-04
Printed: 2017-07-05

ACCOMMODATE FOR
66" x 72" OPENING
FOR FRIDGE

POT/PAN
DRAWER

DELETE

KITCHEN 3D-VIEW 1
NEWINGTON III - STANDARD KITCHEN

CUSTOMER APPROVAL

I have reviewed these drawings and understand the details of the design and the Cartier Kitchens specifications

Signature: _____

Date: _____

Note: This drawing is an artistic interpretation of the general appearance of the design. It is not meant to be an exact rendition.




Designed: 2017-07-04
Printed: 2017-07-04

NEWINGTON III

All

Drawing #: 1

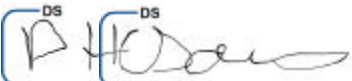



KITCHEN 3D-VIEW 2
NEWINGTON III - STANDARD KITCHEN

CUSTOMER APPROVAL

I have reviewed these drawings and understand the details of the design and the Cartier Kitchens specifications.

Signature _____

Date _____

Note: This drawing is an artistic interpretation of the general appearance of the design. It is not meant to be an exact rendition.





Designed: 2017-07-04
Printed: 2017-07-04

NEWINGTON III

All

Drawing #: 1

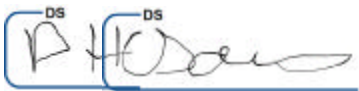^{DS}

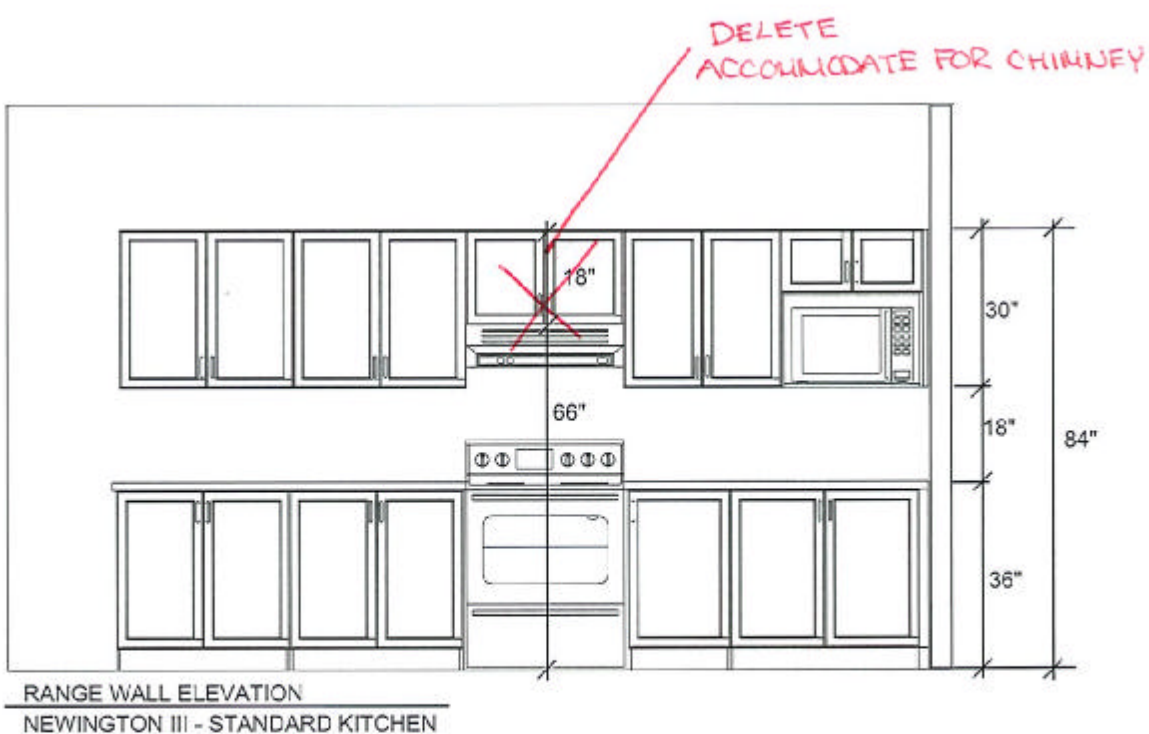


CUSTOMER APPROVAL

I have reviewed these drawings and understand the details of the design and the Cartier Kitchens specifications.

Signature _____

Date _____

Note: This drawing is an artistic interpretation of the general appearance of the design. It is not meant to be an exact rendition.




Designed: 2017-07-04
Printed: 2017-07-04

NEWINGTON III

All

Drawing #: 1



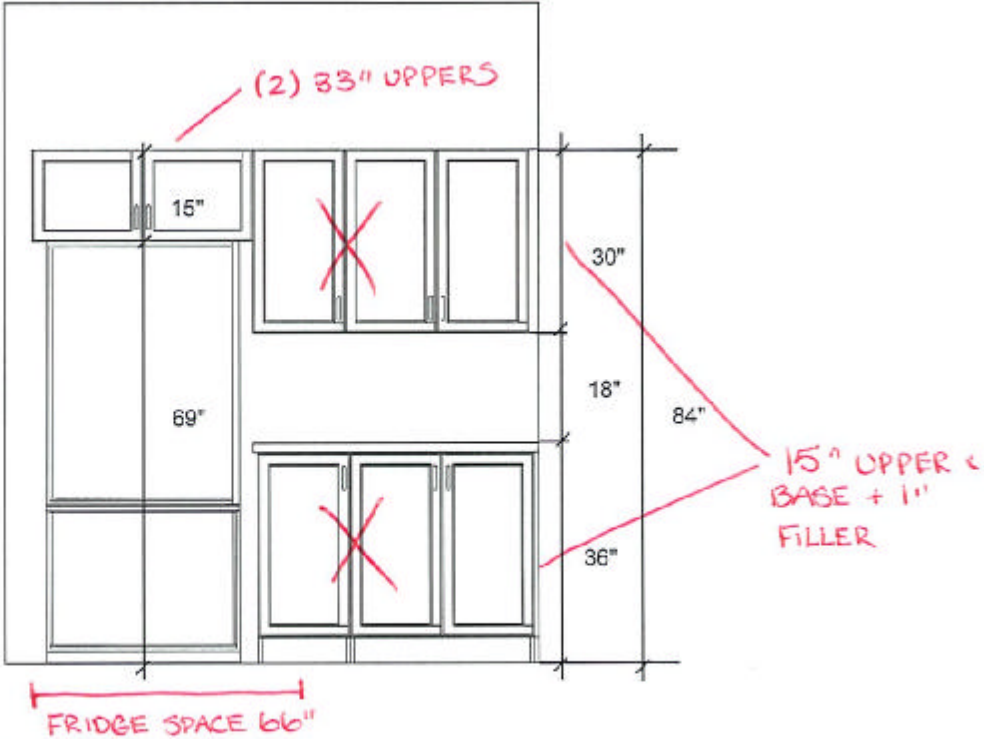

FRIDGE WALL ELEVATION
NEWINGTON III - STANDARD KITCHEN

CUSTOMER APPROVAL

I have reviewed these drawings and understand the details of the design and the Cartier Kitchens specifications

Signature _____

Date _____

Note: This drawing is an artistic interpretation of the general appearance of the design. It is not meant to be an exact rendition.

NEWINGTON III




Designed: 2017-07-04
Printed: 2017-07-04

All

Drawing #: 1

DS DS
P. H. O. S. O. W.

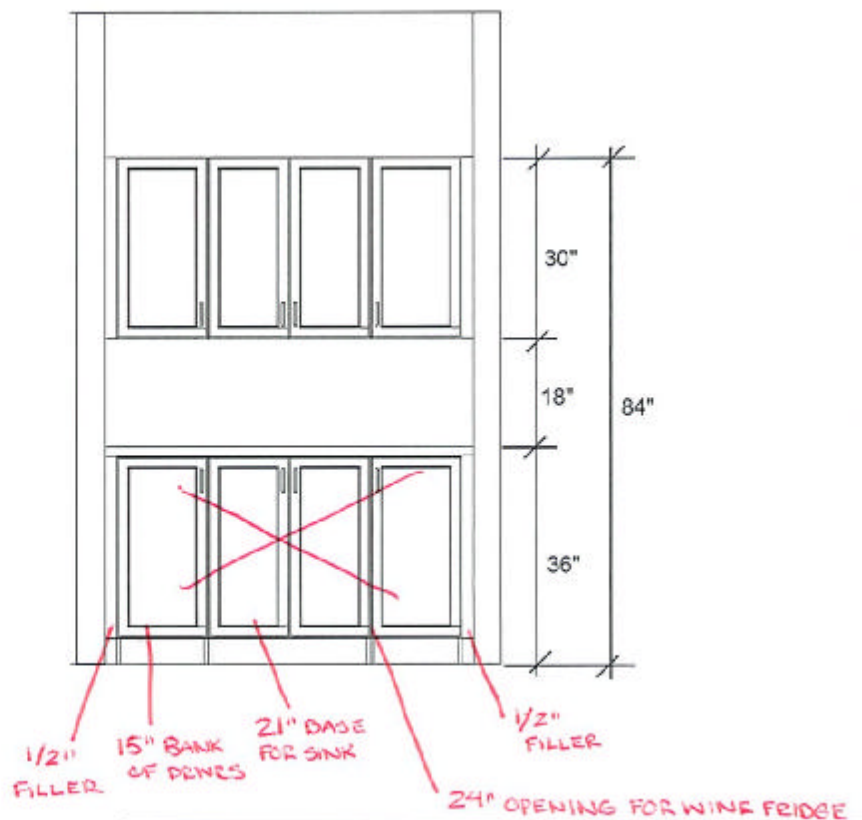

BUTLER'S PANTRY WALL ELEVATION
NEWINGTON III - STANDARD KITCHEN

CUSTOMER APPROVAL

I have reviewed these drawings and understand the details of the design and the Carter Kitchens specifications.

Signature _____

Date _____

Note: This drawing is an artistic interpretation of the general appearance of the design. It is not meant to be an exact rendition.



Designed: 2017-07-04
Printed: 2017-07-04

Printed: 2017-07-04

NEWINGTON III

All

Drawing #: 1

