



DCR PHOENIX HOMES

NEWINGTON III
VANITIES


- LINE 1 & 2
HARDWARE - STD & 1ST UPGRADE
STANDARD WHITE INTERIOR
METAL DRAWER BOX
3 PCS - 5/8" KICK - FIN. BOTH ENDS
3 PCS - LOOSE FILLER - 3 x 96
2 PCS - 90 DEG. CORNER MOULD
1 PCS - T-MOULD
1 PCS - FLAT MOULDING

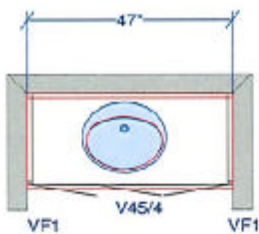


POWDER ROOM

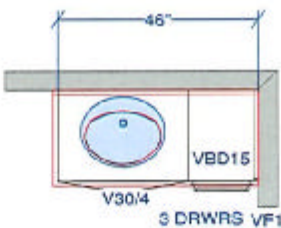

IN LAW - ENSUITE

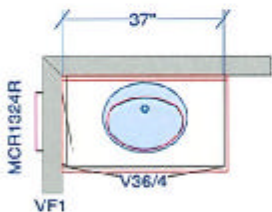


ENSUITE BEDROOM 4

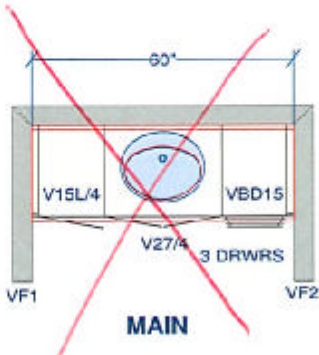

MAIN

SEE LAST PAGES FOR
ELEVATION / PLANS
FOR JACK & JILL
ENSUITE

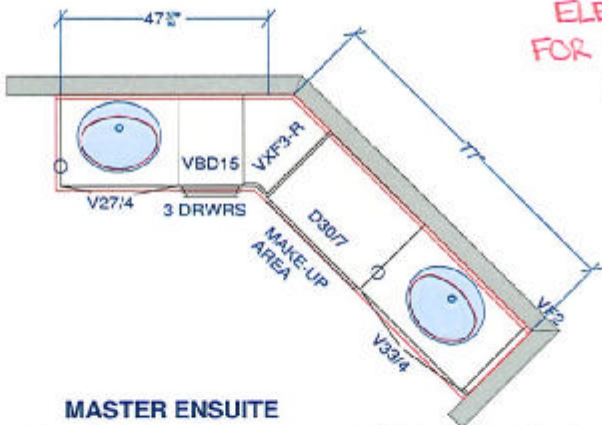

MASTER ENSUITE

CUSTOMER APPROVAL

I have reviewed these drawings and understand the details of the design and the Contractor's specifications.

Signature _____
Date _____

All dimensions, size designations given are subject to verification on job site and adjustment to fit job conditions.



This is an original design and must not be released or copied unless applicable fee has been paid or job order placed.

Designed: 2017-07-05
Printed: 2017-07-06

NEWINGTON III - VANITIES

All

Drawing #: 1


No Scale.

DS DS
P. H. H. H.

DCR PHOENIX HOMES


NEWINGTON III
OPTIONAL VANITIES

LINE 1 & 2
HARDWARE - STD & 1ST UPGRADE
STANDARD WHITE INTERIOR
METAL DRAWER BOX
3 PCS - 5/8" KICK - FIN. BOTH ENDS

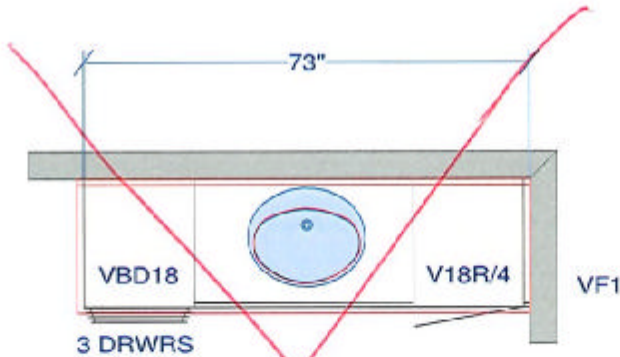

VANITY AT 31.75" H.
OPEN UNDER SINK
WITH 4.5"H APRON


OPTIONAL IN-LAW SUITE
ACCESSIBLE ENSUITE

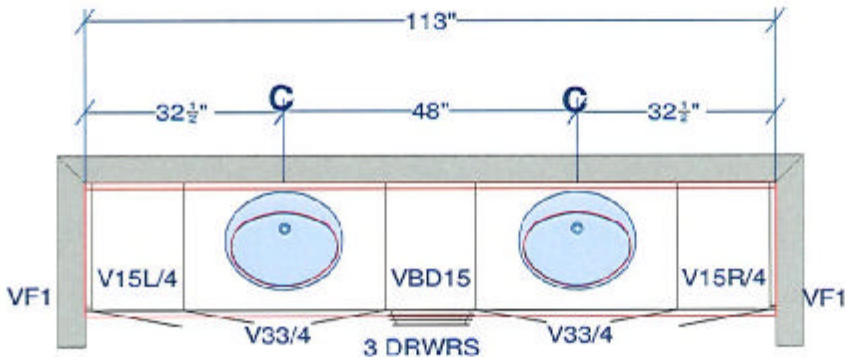


SEE LAST PAGE FOR
ELEVATION

OPTIONAL BEDROOM 5 - JACK & JILL ENSUITE

All dimensions ,size designations given are subject to verification on job site and adjustment to fit job conditions.		This is an original design and must not be released or copied unless applicable fee has been paid or job order placed.	Designed: 2017-07-05 Printed: 2017-07-06
NEWINGTON III - OPTIONAL VANITIES	All	Drawing #: 1	No Scale.

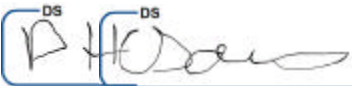DS DS

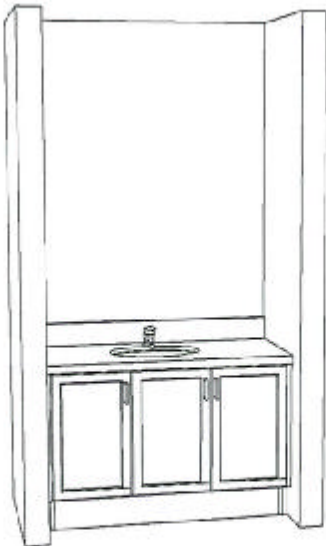


POWDER ROOM 3D-VIEW
NEWINGTON III - VANITY

CUSTOMER APPROVAL

I have reviewed these drawings and understand the details of the design and the Cartier Kitchens specifications

Signature _____

Date _____

Note: This drawing is an artistic interpretation of the general appearance of the design. It is not meant to be an exact rendition.




Designed: 2017-07-05


Printed: 2017-07-06

NEWINGTON III - VANITIES

All

Drawing #: 1

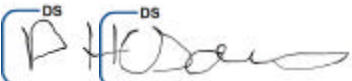^{DS}  ^{DS}

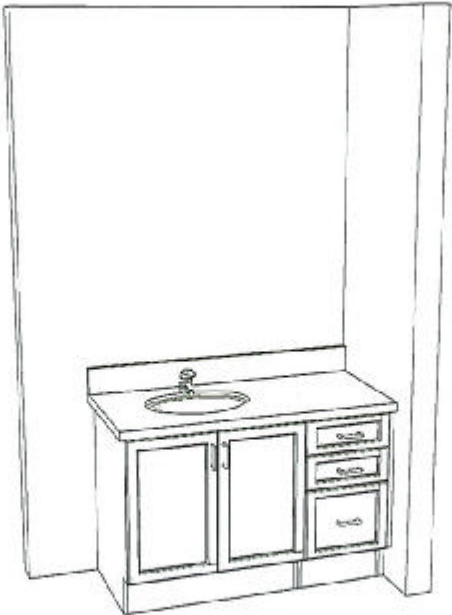

IN-LAW ENSUITE 3D-VIEW
NEWINGTON III - VANITY


<u>CUSTOMER APPROVAL</u> I have reviewed these drawings and understand the details of the design and the Cartier Kitchens specifications Signature _____ Date _____

Note: This drawing is an artistic interpretation of the general appearance of the design. It is not meant to be an exact rendition.



Designed: 2017-07-05
Printed: 2017-07-06

^{DS}
A handwritten signature in blue ink, appearing to read "P. H. O. S. O. W.", enclosed within a blue rectangular box. Above the box, the letters "DS" are printed.

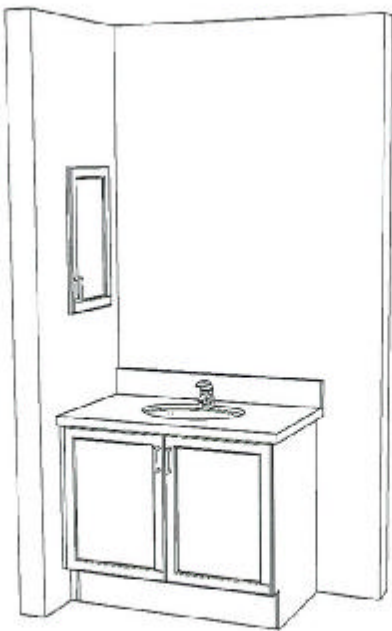

ENSUITE BEDROOM 4 - 3D VIEW
NEWINGTON III - VANITY


CUSTOMER APPROVAL I have reviewed these drawings and understand the details of the design and the Carrier Kitchens specifications Signature _____ Date _____

Note: This drawing is an artistic interpretation of the general appearance of the design. It is not meant to be an exact rendition.



Designed: 2017-07-05
Printed: 2017-07-06

A handwritten signature in blue ink, appearing to read "P. H. O. S.", with two small "DS" marks above the first and last letters, indicating a DocuSign signature.

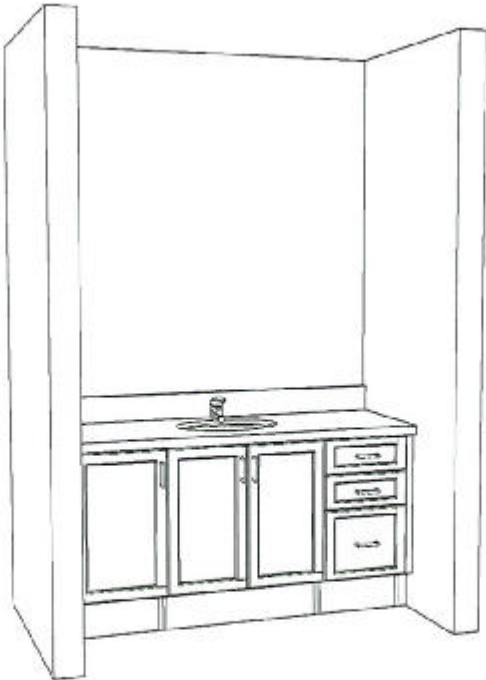


MAIN BATH 3D-VIEW
NEWINGTON III - VANITY

CUSTOMER APPROVAL I have reviewed these drawings and understand the details of the design and the Currier Kitchens specifications. Signature _____ Date _____
--

Note: This drawing is an artistic interpretation of the general appearance of the design. It is not meant to be an exact rendition.



Designed: 2017-07-05
Printed: 2017-07-06

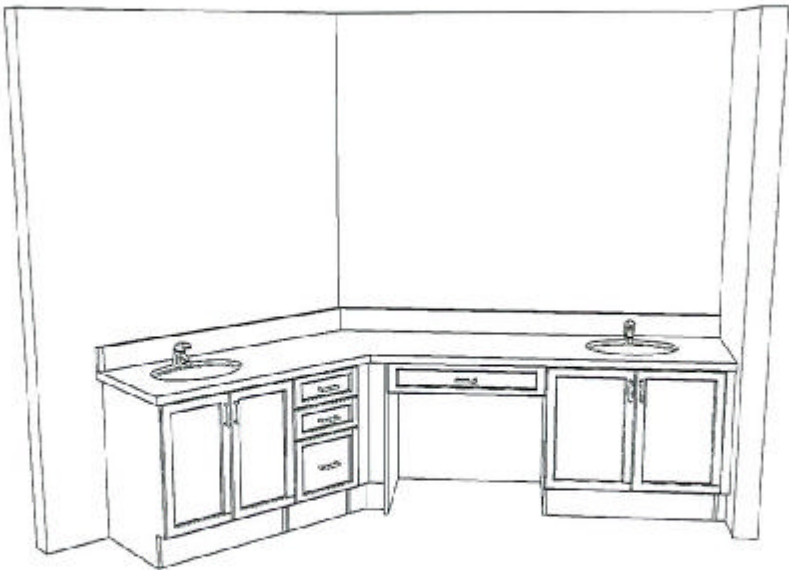

ENSUITE 3D-VIEW
NEWINGTON III - VANITY

CUSTOMER APPROVAL

I have reviewed these drawings and understand the details of the design and the Cartier Kitchens specifications

Signature _____

Date _____

Note: This drawing is an artistic interpretation of the general appearance of the design. It is not meant to be an exact rendition.




Designed: 2017-07-05
Printed: 2017-07-06

NEWINGTON III - VANITIES

All

Drawing #: 1

^{DS}

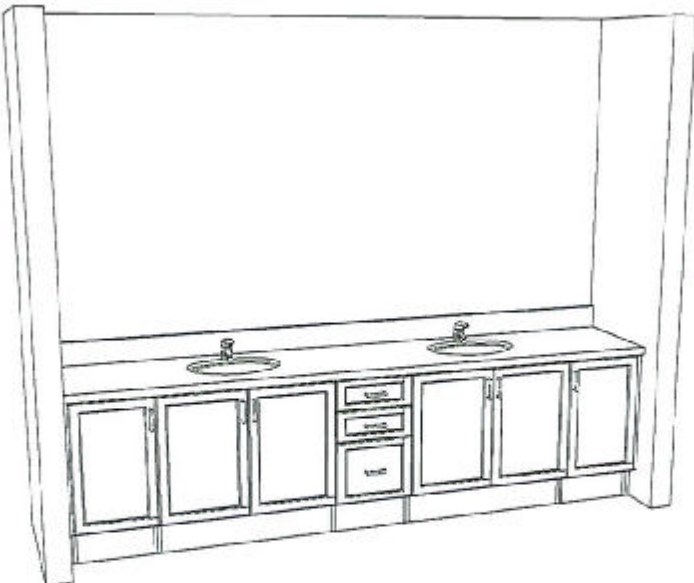

BEDROOM 5 JACK & JILL - 3D VIEW
NEWINGTON III - OPTIONAL VANITY

CUSTOMER APPROVAL	
I have reviewed these drawings and understand the details of the design and the Currier/Kitchens specifications	
Signature _____	
Date _____	

Note: This drawing is an artistic interpretation of the general appearance of the design. It is not meant to be an exact rendition.





Digned: 2017-07-05
Printed: 2017-07-05

^{DS} ^{DS}

DCR PHOENIX HOMES


NEWINGTON III
OPTIONAL VANITIES


LINE 1 & 2
HARDWARE - STD & 1ST UPGRADE
STANDARD WHITE INTERIOR
METAL DRAWER BOX
3 PCS - 5/8" KICK - FIN. BOTH ENDS

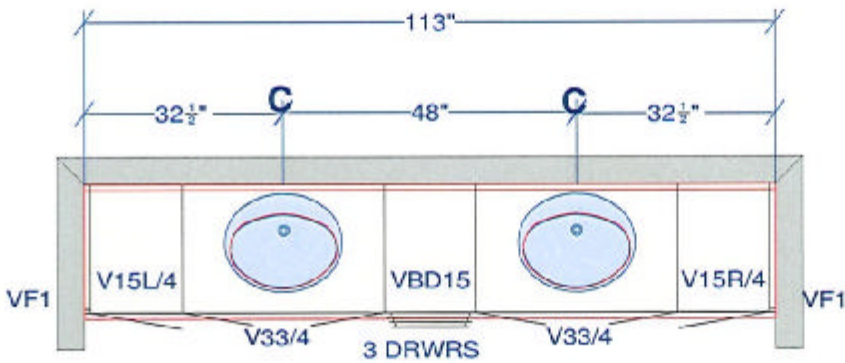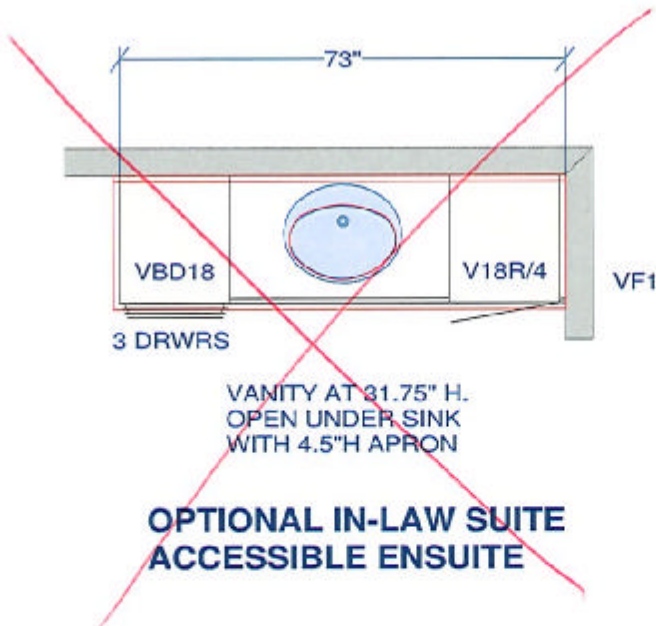

OPTIONAL BEDROOM 5 - JACK & JILL ENSUITE

All dimensions & size designations given are subject to verification on job site and adjustment to fit job conditions.		This is an original design and must not be released or copied unless applicable fee has been paid or job order placed.	Designed: 2017-07-05 Printed: 2017-07-06
NEWINGTON III - OPTIONAL VANITIES	A11	Drawing #: 1	No Scale.

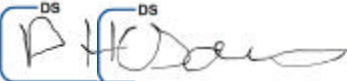

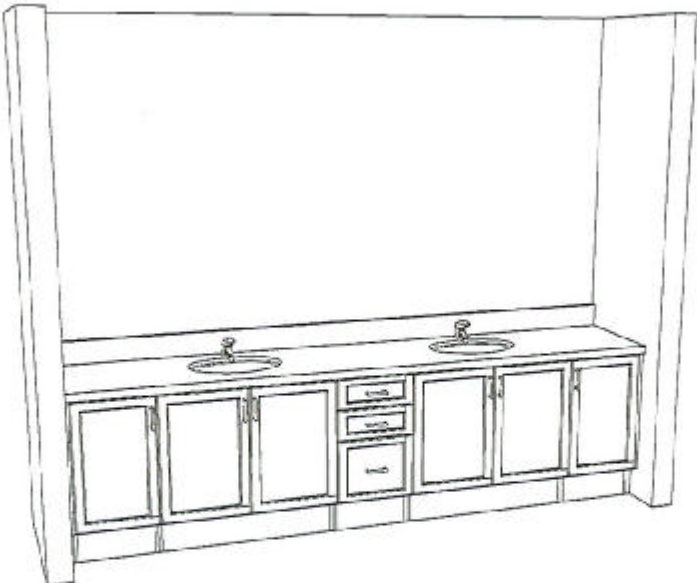

BEDROOM 5 JACK & JILL - 3D VIEW
NEWINGTON III - OPTIONAL VANITY

CUSTOMER APPROVAL

I have reviewed these drawings and understand the details of the design and the Cartier Kitchens specifications

Signature _____

Date _____

Note: This drawing is an artistic interpretation of the general appearance of the design. It is not meant to be an exact rendition.		Designed: 2017-07-05
		Printed: 2017-07-05
NEWINGTON III - OPTIONAL VANITIES	All	Drawing #: 1

DS

DS

