

DCR PHOENIX HOMES

LOT #116

PATHWAYS

MODEL - WINCHESTER (43-4) - RIGHT

KITCHEN

MOUNTING HEIGHT - 96



39" UPPERS 21" ABOVE COUNTER

LIGHT VALANCE


CROWN MOULDING

- CABINETS -
HARDWARE -
STANDARD WHITE INTERIOR
METAL DRAWER BOX
4 PCS - 5/8" KICK - FIN. BOTH ENDS
5 PCS - FLAT MOULDING
2 PCS - 90 DEG. CORNER MOULD
1 PCS - T-MOULD

REVISED: APRIL 1, 2021

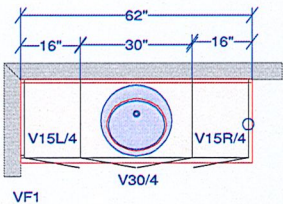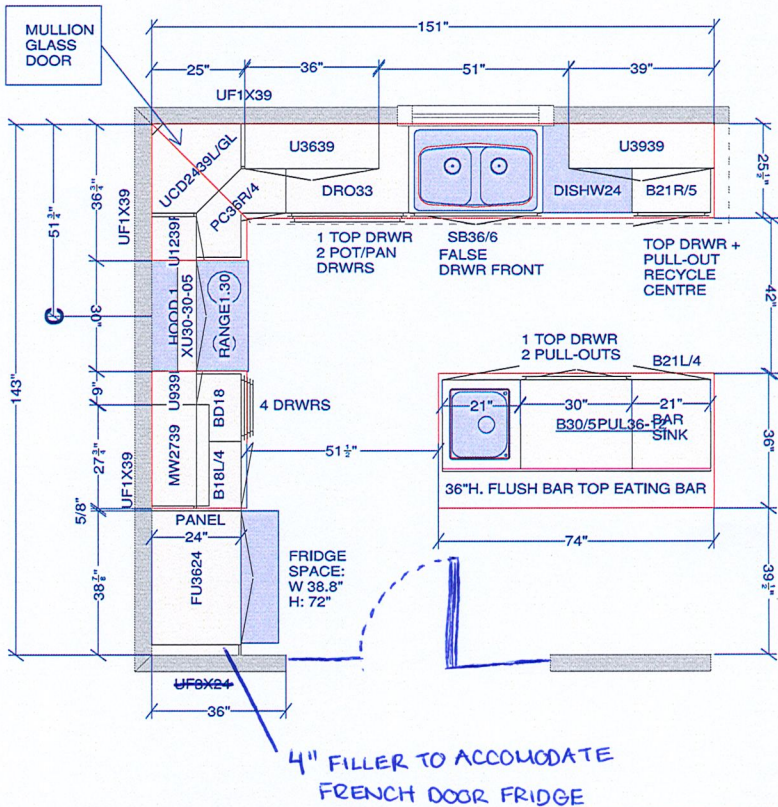


POWDER

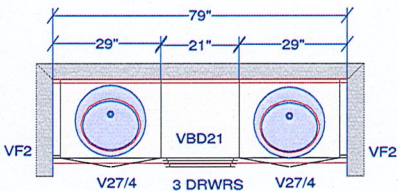

MAIN BATH

2ND SINK ADDED

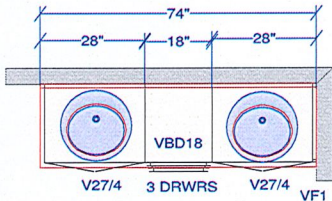

ENSUITE


LENGTH INCREASED BY 6"
2ND SINK ADDED

All dimensions ,size designations given are subject to verification on job site and adjustment to fit job conditions.



This is an original design and must not be released or copied unless applicable fee has been paid or job order placed.

Designed: 2021-04-01
Printed: 2021-04-01

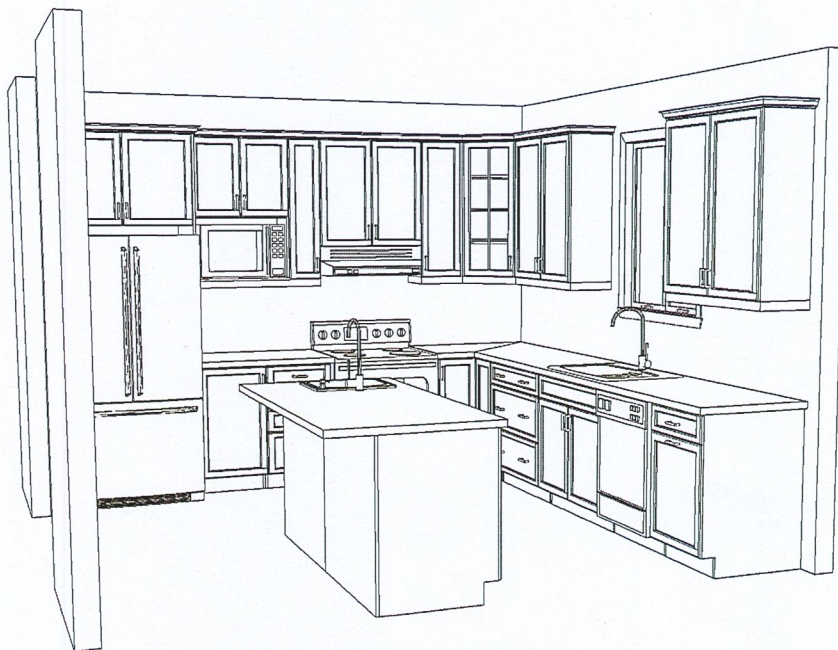

KITCHEN - 3D VIEW #1

REVISED: APRIL 1-21

CUSTOMER APPROVAL

I have reviewed these drawings and understand the details of the design and the Cartier Kitchens specifications


Signature _____

Date _____

Note: This drawing is an artistic interpretation of the general appearance of the design. It is not meant to be an exact rendition.



Designed: 2021-04-01
Printed: 2021-04-01

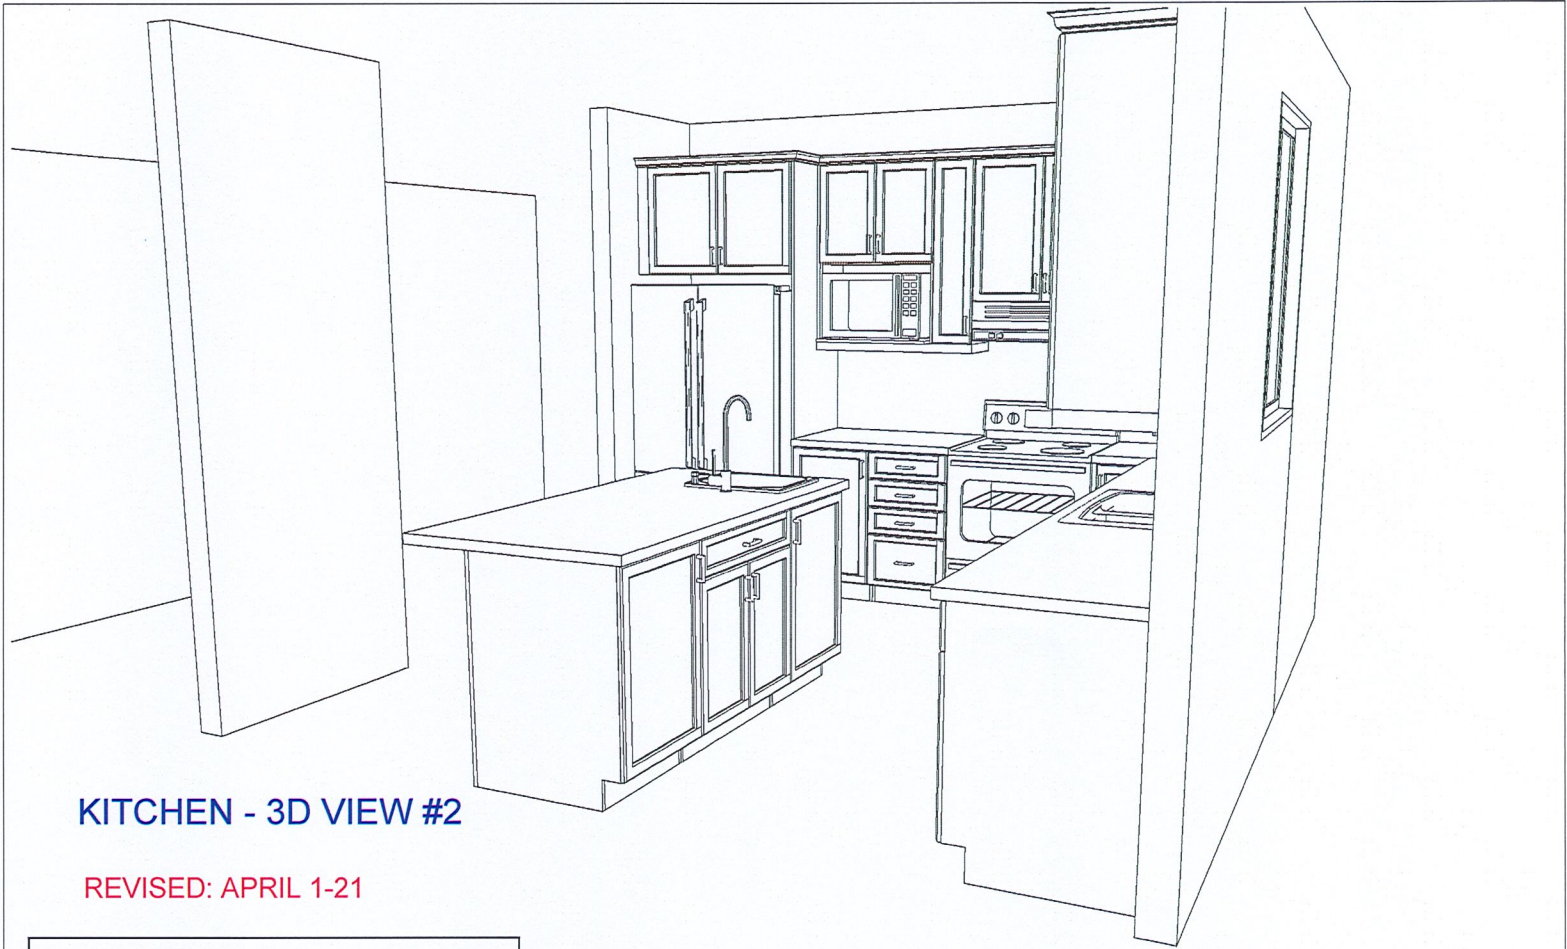

KITCHEN - 3D VIEW #2

REVISED: APRIL 1-21

CUSTOMER APPROVAL


I have reviewed these drawings and understand the details of the design and the Cartier Kitchens specifications

Signature _____


Date _____

Note: This drawing is an artistic interpretation of the general appearance of the design. It is not meant to be an exact rendition.		Designed: 2021-04-01
		Printed: 2021-04-01
DCR #116 Pathways - kit 3 Winchester - RIGHT .kit	All	Drawing #: 1


DS
R4

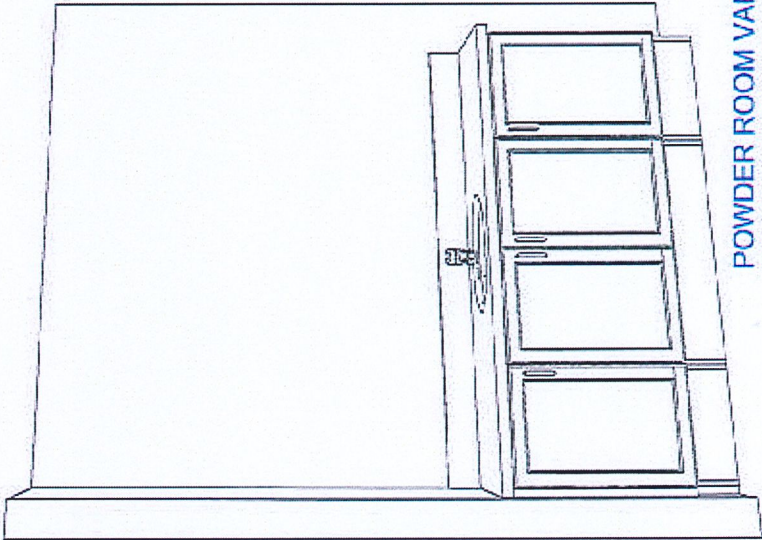

POWDER ROOM VANITY

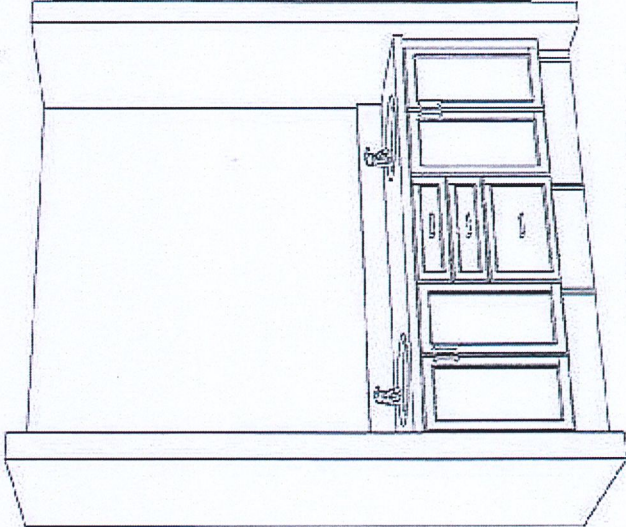

MAIN BATH VANITY

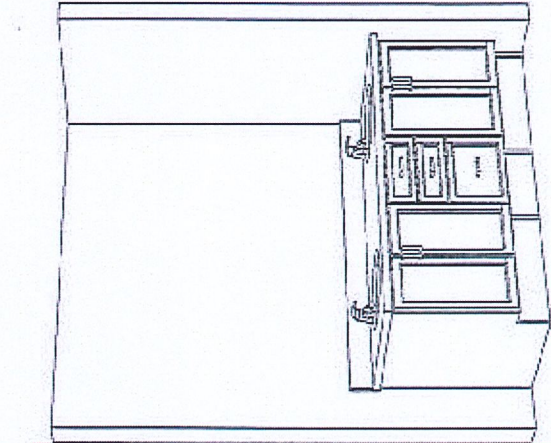

ENSUITE VANITY

CUSTOMER APPROVAL

I have reviewed these drawings and understand the details of the design and the **CORNER KITCHENS** specifications.

Signature _____

Date _____

Note: This drawing is an artistic interpretation of the general appearance of the design. It is not meant to be an exact rendition.

SPECTRUM KITCHEN and BATH DESIGN



Designed: 2020-11-15
Printed: 2020-11-15