


DCR PHOENIX HOMES

MODEL - RUTHERFORD (517)
ALTERNATE KITCHEN
MOUNTING HEIGHT - 84

- LINE-
HARDWARE -
STANDARD WHITE INTERIOR
METAL DRAWER BOX
4 PCS - 5/8" KICK - FIN. BOTH ENDS
2 PCS - LOOSE FILLER - 6 x 96
1 PCS - 90 DEG. CORNER MOULD
1 PCS - T-MOULD
5 PCS - FLAT MOULD

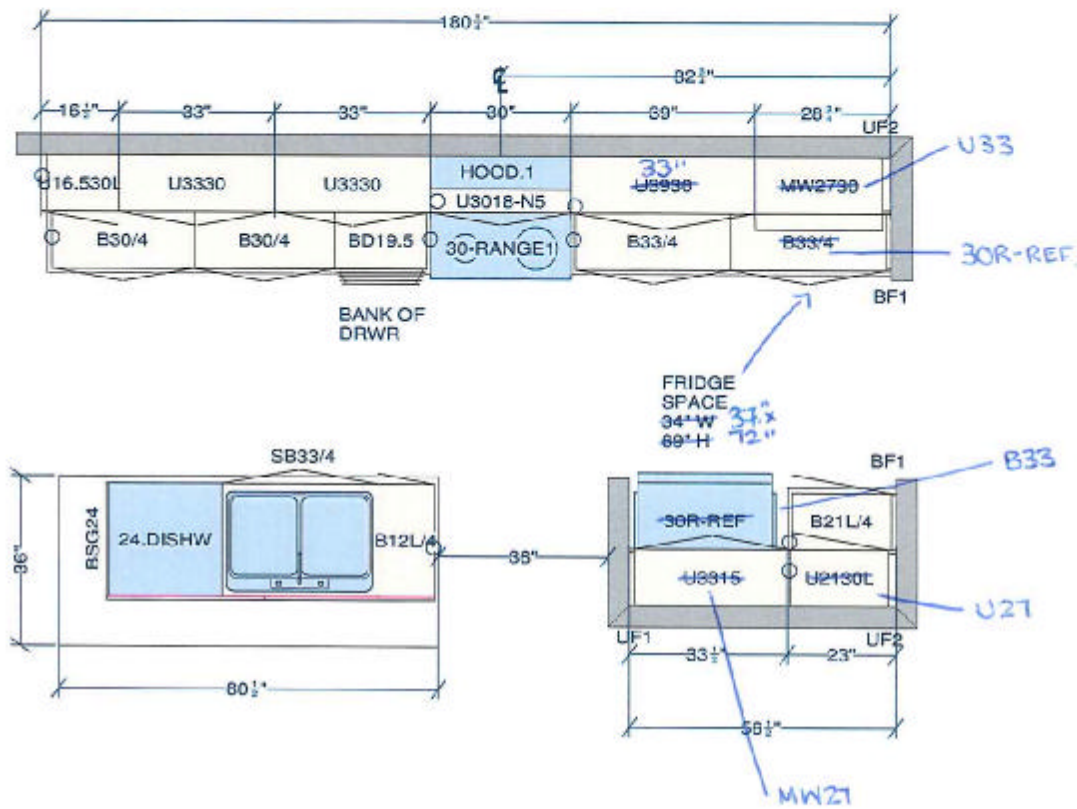

All dimensions ,size designations
given are subject to verification on
job site and adjustment to fit job
conditions.



Spectrum Kitehen ,Bath Design
430 Hazeldean Rd. Unit 2
P:613-521-6966
F:613 521-1617
Drawn by: Mirian


Designed: 4/19/2016
Printed: 4/19/2016

517 Rutherford ALT

All

Drawing #: 1 No Scale.

DS DS

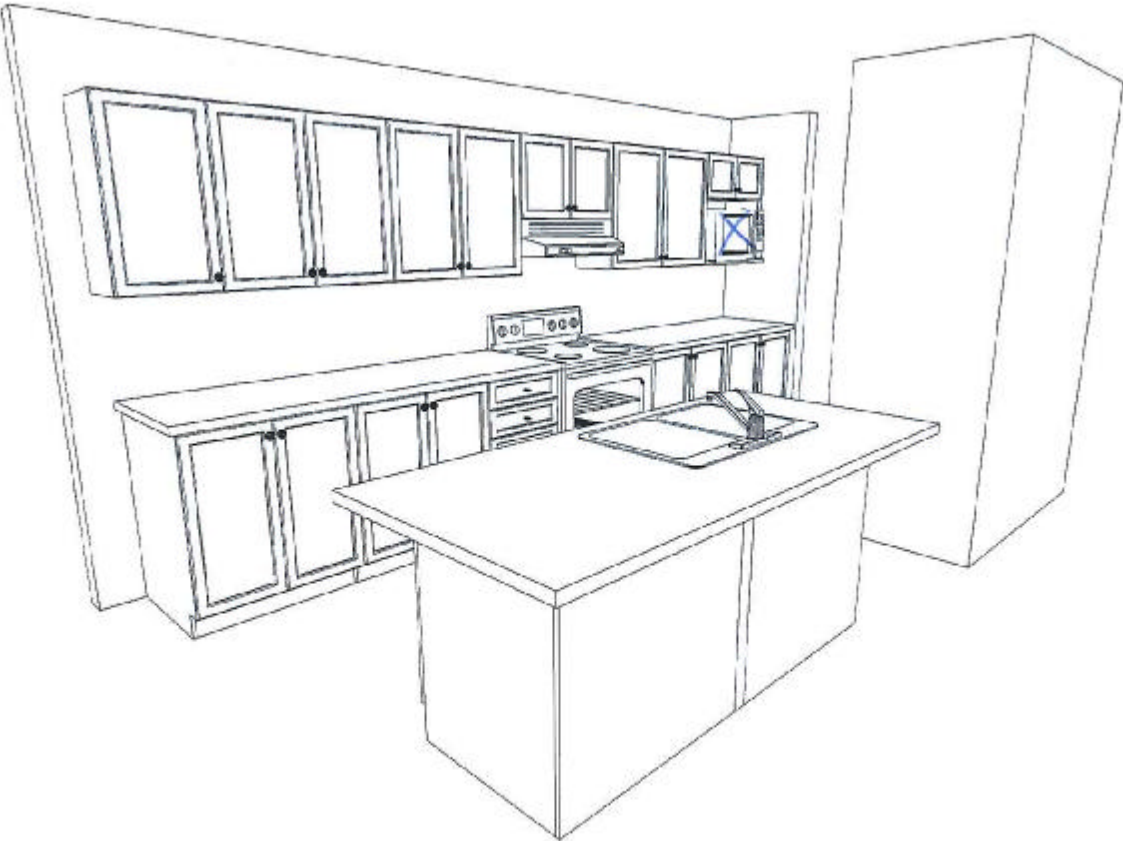

DCR PHOENIX 517 RUTHERFORD ALT
3D KITCHEN VIEW #1

Note: This drawing is an artistic interpretation of the general appearance of the design. It is not meant to be an exact rendition.




Designed: 4/19/2016
Printed: 4/19/2016

517 Rutherford ALT


All

Drawing #: 1

DS DS

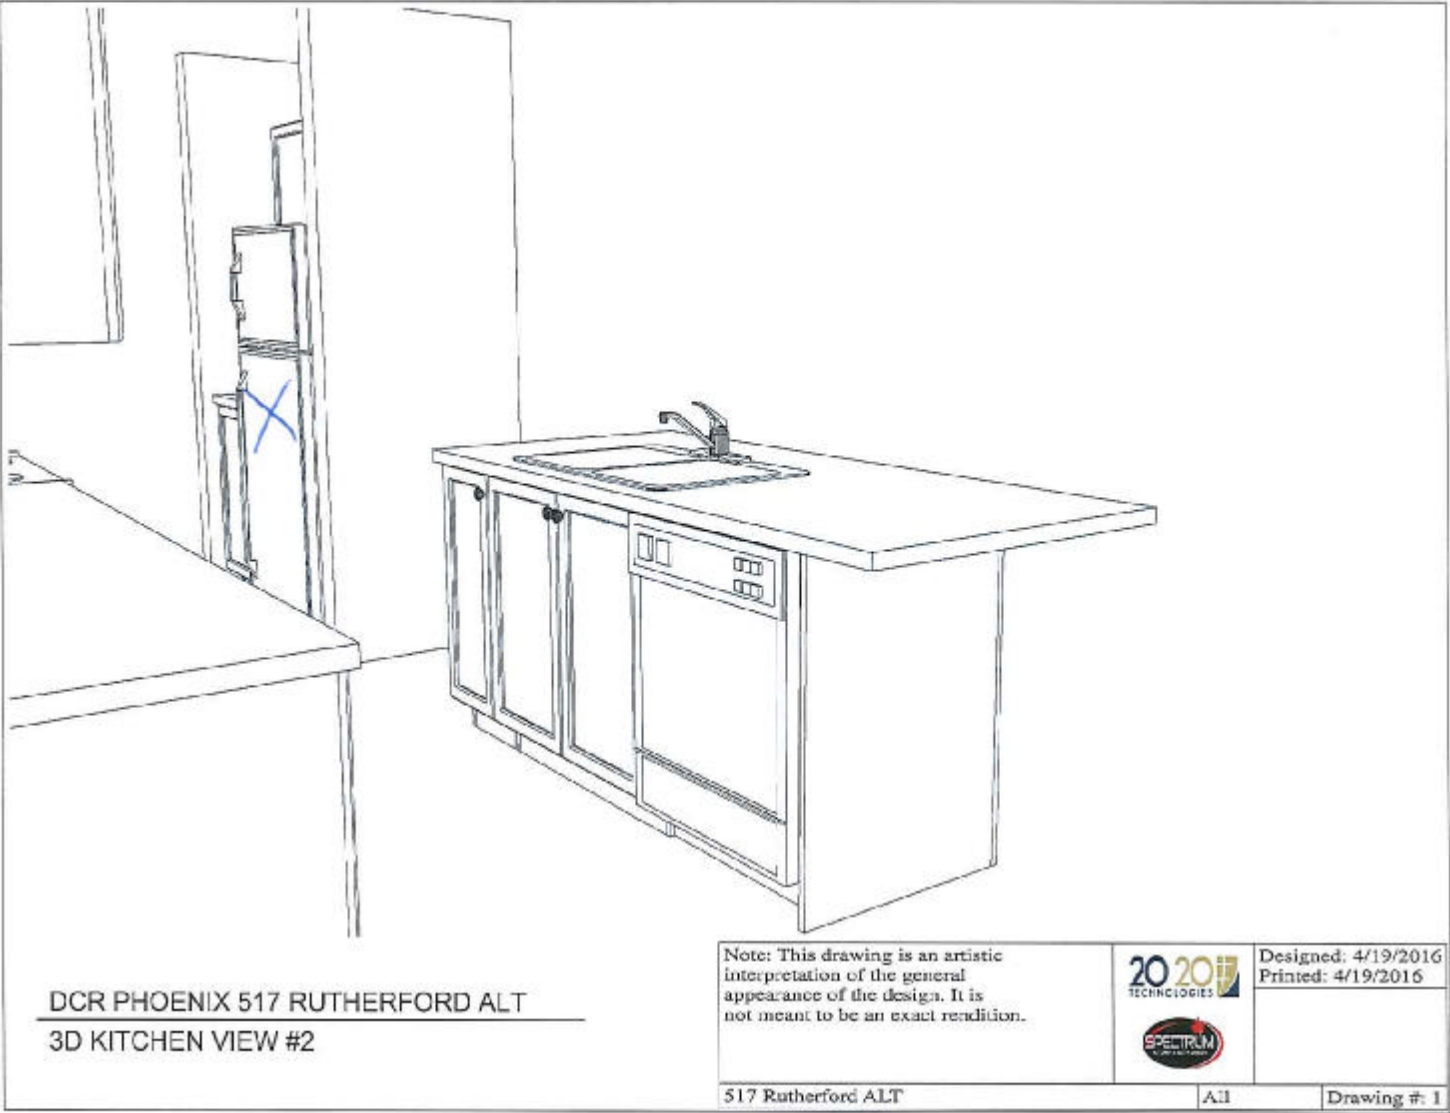


DS DS
[Signature]

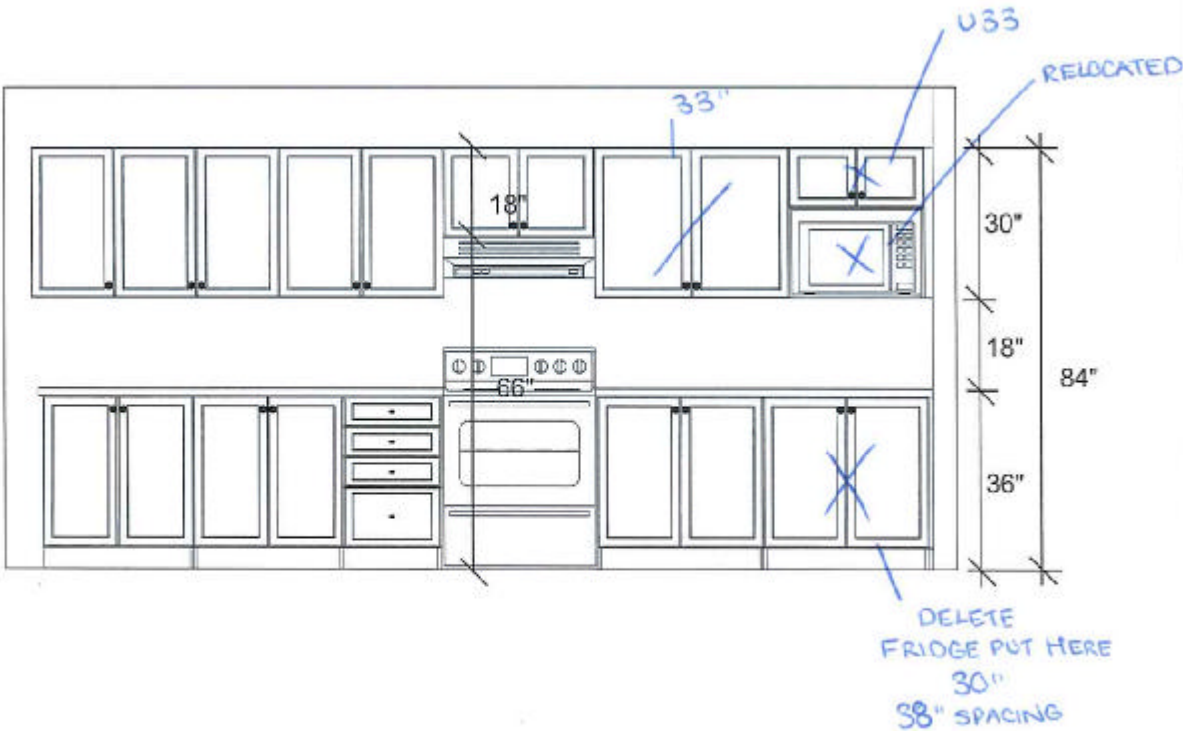

DCR PHOENIX 517 RUTHERFORD ALT
STOVE WALL ELEVATION

Note: This drawing is an artistic interpretation of the general appearance of the design. It is not meant to be an exact rendition.		Designed: 4/19/2016
		Printed: 4/19/2016
517 Rutherford ALT	All	Drawing #: 1

DS DS

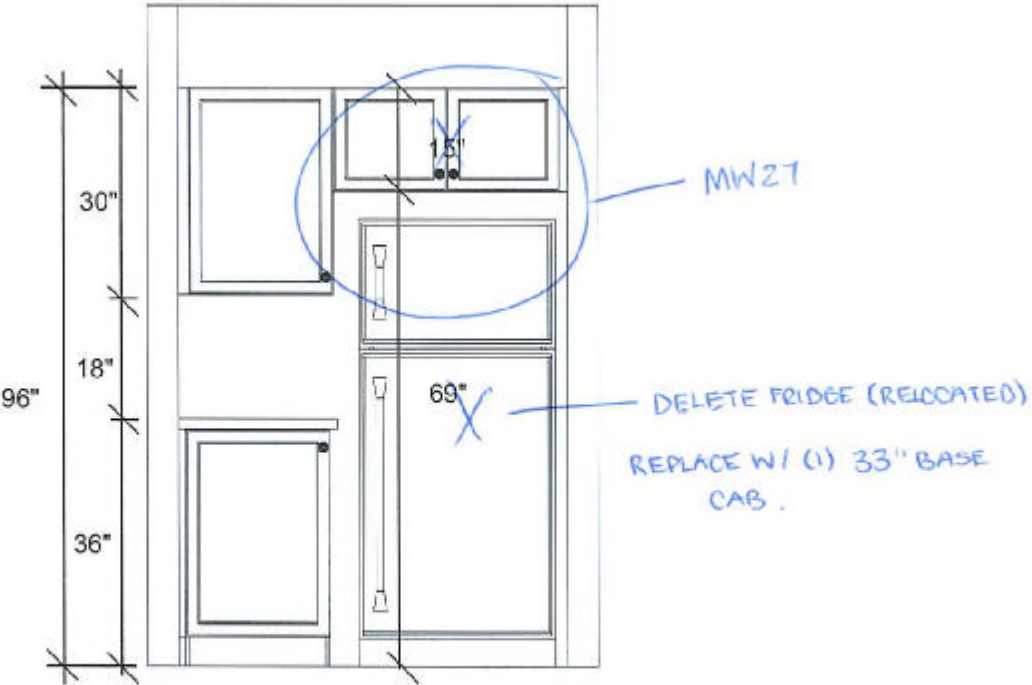DCR PHOENIX 517 RUTHERFORD ALT
FRIDGE WALL ELEVATION

Note: This drawing is an artistic interpretation of the general appearance of the design. It is not meant to be an exact rendition.



Designed: 4/19/2016
Printed: 4/19/2016




517 Rutherford ALT

All

Drawing #: 1

DS DS

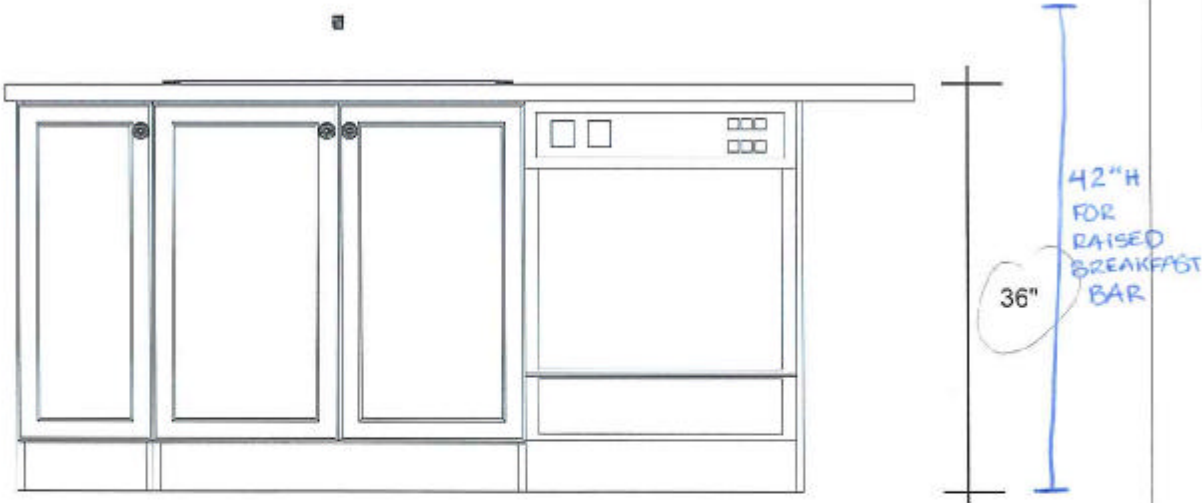

DCR PHOENIX 517 RUTHERFORD ALT
ISLAND ELEVATION

Note: This drawing is an artistic interpretation of the general appearance of the design. It is not meant to be an exact rendition.	 	Designed: 4/19/2016 Printed: 4/19/2016
517 Rutherford ALT	All	Drawing #: 1

DS DS
