


CONSTRUCTION NOTES

ALL CONSTRUCTION TO ADHERE TO THESE PLANS AND SPEC'S AND TO CONFORM TO THE ONTARIO BUILDING CODE AND ALL OTHER APPLICABLE CODES AND AUTHORITIES HAVING JURISDICTION. THESE REQUIREMENTS ARE TO BE TAKEN AS MINIMUM SPECIFICATIONS. ONT. REG. 332/12

1. **ROOF CONSTRUCTION**
NO.210 (10.25kg/m²) ASPHALT SHINGLES, 11.1mm (7/16") ASPENITE SHEATHING WITH 1" CLIPS.
APPROVED EAVES PROTECTION TO EXTEND 900mm (3'-0") FROM EDGE OF ROOF AND MIN. 300mm (12") PROTECTION NOT REQ'D. FOR ROOF R/12 OR GREATER)
38x89 (2"x4") TRUSS BRACING @ 1830mm (6'-0") O.C. AT BOTTOM CHORD, PREFIN. ALUM.
EAVESSTROUGH, FASCIA, RVL & VENTED SOFFIT. ATIC VENTILATION 1:500 OF INSULATED CEILING AREA WITH 25% AT EAVES. AND 25% AT RIDGE (OBC 9.19.1.2)
2. **FRAME WALL CONSTRUCTION (2"x6") [TYPE EXTERIOR]**
SIDING AS PER ELEVATION. APPROVED AIR BARRIER 11mm (7/16") EXTERIOR TYPE SHEATHING, 38x140 (2"x6") STUDS @ 400mm (16") O.C. RSI 3.87 (R22) INSULATION AND APPROVED VAPOUR BARRIER (R22) INSULATION. AIR BARRIER 13mm (1/2") INT. DRYWALL FINISH. SIDING TO BE MIN. 200mm (8") ABOVE FIN. GRADE
- 2A. **FRAME WALL CONSTRUCTION (2"x4")**
SIDING AS PER ELEVATION. APPROVED AIR BARRIER 9.3 (R5) EXTERIOR RIGID INSULATION BOARD 38x89 (2"x4") STUDS @ 400mm (16") O.C. WITH APPROVED DIAGONAL WALL BRACING, RSI 3.35 (R19) INSULATION AND APPROVED VAPOUR BARRIER AND APPROVED CONT. AIR BARRIER, 13mm (1/2") INT. DRYWALL FINISH. SIDING TO BE MIN. 200mm (8") ABOVE FIN. GRADE
3. **BRICK VENEER CONSTRUCTION (2"x6") [TYPE EXTERIOR]**
90mm (4") FACE BRICK 25mm (1") AIR SPACE, 22x180x76mm (7/8"x7"x0.03") GALV. METAL TIES @ 400mm (16") O.C. HORIZONTAL 600mm (24") O.C. VERTICAL APPROVED AIR BARRIER RSI 0.9 (R5) EXT. RIGID INSUL. BD., 38x89 (2"x4") STUDS @ 400mm (16") O.C. WITH APPROVED DIAGONAL WALL BRACING, RSI 3.35 (R19) INSULATION AND APPROVED VAPOUR BARRIER WITH APPROVED CONT. AIR BARRIER, 13mm (1/2") INT. DRYWALL FINISH. PROVIDE WEEP HOLES @ 800mm (32") O.C. BOTTOM COURSE AND OVER OPENINGS. PROVIDE THRU-WALL FLASHING UP MIN. 150mm (6") BEHIND BUILDING PAPER. BRICK TO BE MIN. 150mm (6") ABOVE FINISH GRADE.
- 3A. **BRICK VENEER CONSTRUCTION (2"x4")** 90mm (4") FACE BRICK 25mm (1") AIR SPACE, 22x180x76mm (7/8"x7"x0.03") GALV. METAL TIES @ 400mm (16") O.C. HORIZONTAL 600mm (24") O.C. VERTICAL APPROVED AIR BARRIER RSI 0.9 (R5) EXT. RIGID INSUL. BD., 38x89 (2"x4") STUDS @ 400mm (16") O.C. WITH APPROVED DIAGONAL WALL BRACING, RSI 3.35 (R19) INSULATION AND APPROVED VAPOUR BARRIER WITH APPROVED CONT. AIR BARRIER, 13mm (1/2") INT. DRYWALL FINISH. PROVIDE WEEP HOLES @ 800mm (32") O.C. BOTTOM COURSE AND OVER OPENINGS. PROVIDE THRU-WALL FLASHING UP MIN. 150mm (6") BEHIND BUILDING PAPER. BRICK TO BE MIN. 150mm (6") ABOVE FINISH GRADE.
4. **INTERIOR STUD PARTITIONS FOR BEARING PARTITIONS**
38x89 (2"x4") @ 400mm (16") O.C. FOR 2 STOREYS AND 300mm (12") O.C. FOR 3 STOREYS.
NON-BEARING PARTITIONS 38x89 (2"x4") @ 600mm (24") O.C. PROVIDE 38x89 (2"x4") BOTTOM PLATE AND 38x89 (2"x4") TOP PLATE. 13mm (1/2") INT. DRYWALL BOTH SIDES OF STUDS.
(2"x6") STUDS/PLATES WHERE NOTED.
5. **FOUNDATION WALL/FOOTINGS**—SEE OBC 9.15.3, 9.15.4, 200mm (8") REBAR CONC. FDN. WALL 20MPa (3000psi) c/w 2-15m (5'-0") EXTENDING 24" ABOVE FOOTINGS. REFER TO DETAILS ON SECTIONS' PAGE.
APPLY BITUMINOUS DAMPROOFING AND DRAINAGE LAYER TO WALL FACE FOUR HEIGHT TO BE 2692 (8'-10") ON 500x155 (20"x6") CONTINUOUS KEVED CONC. FTG.—BRACE FDN. WALL PRIOR TO BACKFILLING.
ALL FOOTINGS SHALL REST ON NATURAL UNDISTURBED SOIL OR COMPACTED ENGINEERED FILL WITH MIN. BEARING CAPACITY OF 100kPa OR GREATER. IF SOIL BEARING DOES NOT MEET MIN. CAPACITY, ENGINEERED FOOTINGS ARE REQUIRED. MAX. FLOOR LIVE LOAD OF 2.4kPa(50psf) PER FLOOR, AND MAX. LENGTH OF SUPPORTED JOISTS IS 4.9m (16'-1"). REFER TO SOILS REPORT FOR SOILS CONDITIONS AND BEARING CAPACITY.
6. 100mm (4") DIA. WEEP TILE 150mm (6") CRUSHED STONE OVER AND AROUND WEEPING TILES. (SLEEVE THROUGH FOOTINGS AS REQUIRED)
7. **BASEMENT SLAB OBC 9.3.1.6(1)(b) & 9.16.4.5(1)** 80mm (3") MIN. 25MPa (3600psi) CONC. SLAB ON 100mm (4") COARSE GRANULAR FILL OR 15MPa (2200psi) CONC. WITH 6mil POLY DAMPROOFING BELOW SLAB.
8. **EXPOSED FLOOR TO EXTERIOR** PROVIDE RSI 5.46 (R31) INSULATION, APPROVED VAPOUR BARRIER AND CONTINUOUS AIR BARRIER, FINISHED SOFFIT.
9. **ATTIC INSULATION**
(R60) BLOWN IN ROOF INSULATION AND APPROVED VAPOUR BARRIER, 13mm (1/2") INT. DRYWALL FINISH OR APPROVED EQUAL.
10. **ALL STAIRS/EXTERIOR STAIRS**—OBC. TABLE 9.8.4.1.—UNIFORMITY FOR RISERS & TREADS
—BETWEEN ADJACENT TREADS & LANDINGS = 5mm
—BETWEEN TALLEST & SHORTEST RISER IN FLIGHT=10mm
MAX. RISE = 200 (7'-7/8")
MIN. RUN = 210 (6'-11/4")
MIN. TREAD = 235 (9'-1/4")
MIN. NOSING = 25 (1")
MIN. HEADROOM = 1950 (6'-5")
RAIL @ LANDING = 1070 (3'-6")
RAIL @ STAIR = 865 (2'-11")
MIN. STAIR WIDTH = 860 (2'-10")
11. **FINISHED RAILING ON PICKETS SPACED MAXIMUM 100mm (4") BETWEEN PICKETS. CLEARANCE BET. HANDRAIL AND SURFACE BEHIND IT TO BE 50mm(2") MIN. HANDRAILS TO BE CONT. EXCEPT FOR NEWEL POST AT CHANGES OF DIRECTION.**
GUARDS—OBC. 9.8.8.3.—AND SB-7
INTERIOR GUARDS: =900mm (2'-11") MIN.
EXTERIOR GUARDS: =1070mm (3'-6") MIN.
STAIR/LANDING GUARDS =1500mm (4'-11") MIN.
(@10M ABOVE ADJ. GROUND)
12. 38x89 (2"x4") SILL PLATE WITH 13mm (1/2") DIA. ANCHOR BOLTS 200mm (8") LONG EMBEDDED MIN. 100mm (4") INTO CONC. @ 2400mm (7'-10") O.C. USE NON-SHRINK GROUT TO LEVEL SILL PLATE WHEN REQUIRED. (SEE OBC. 9.23.7)
- 12A. **MIN. R10w**
13. **R12 (3")** CONTINUOUS BATT INSULATION. 2"x4" STUD WALL PLACED 3" AWAY FROM WALL. FILL STUD CAVITY WITH BATT INSULATION. APPROVED VB TO 8" ABOVE FLOOR LEVEL. DAMPROOF WITH BUILDING PAPER BETWEEN THE FOUNDATION WALL AND INSULATION UP TO GRADE LEVEL. (SEE DETAIL ON "SB-12 DETAILS" PAGE).

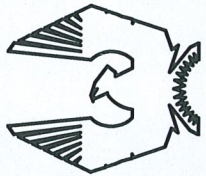

PHOENIX HOMES

LOT NUMBER:
CIVIC ADDRESS:
1906 CESSNA PRIVATE

CHESAPEAKE-2019-A/B

SITE: DIAMONDVIEW

2-49

14. **BEARING STUD PARTITION**
38x89 (2"x4") STUDS @ 400mm (16") O.C. 38x89 (2"x4") SILL PLATE ON DAMPROOFING MATERIAL, 13mm (1/2") DIA. ANCHOR BOLTS 200mm (8") LONG, EMBEDDED MIN. 100mm (4") INTO CONC. @ 2400mm (7'-10") O.C. 100mm (4") HIGH CONC. CURB ON 380x155 (14"x6") CONC. FOOTING. ADJ. HORIZ. BLOCKING AT MID-HEIGHT IF WALL IS UNFINISHED.

15. **RESERVED**
16. **BEAM POCKET OR 300x150 (12"x6") POURED CONC. NIB WALLS. MIN. BEARING 90mm (3'-1/2")**
17. 19x64 (1"x3") CONTINUOUS WOOD STRAPPING BOTH SIDES OF STEEL BEAM.
18. **GARAGE SLAB:** 100mm (4") 32MPa (4640psi) CONC. SLAB WITH 5-8% AIR ENTRAPMENT ON OPT. 100 (4") COARSE GRANULAR FILL WITH COMPACTED SUB-BASE OR COMPACTED NATIVE FILL SLOPE TO FRONT AT 1% MIN.
19. **INSULATION BETWEEN HOUSE AND GARAGE, RSI 3.87 (R22) IN WALLS, RSI 5.46 (R31) IN CEILING. PROVIDE APPROVED AIR BARRIER, TAPE AND SEAL ALL JOINTS AIR TIGHT.**

20. **DOOR AND FRAME GASPROOFED. DOOR EQUIPPED WITH SELF CLOSING DEVICE AND WEATHERSTRIPPING. PER OBC 9.10.13.15**
21. **WOOD STEP, C/W HANDRAIL & LANDING IF MORE THAN 3 RISERS, MAX. RISE 200mm (7'-7/8") MIN. TREAD 250mm (9'-1/2")** SEE OBC 9.8.9.2, 9.8.9.3 & 9.8.10

22. **CAPPED DRYER EXHAUST VENTED TO EXTERIOR. (USE 100mm(4") DIA. SMOOTH WALL VENT PIPE) OBC 6.2.3.8(7)**
23. **ATTIC ACCESS HATCH 545x610 (21.5"x24") WITH A MIN. AREA OF 3.44 SF WITH WEATHERSTRIPPING RSI 7.0 (R40) RIGID INSUL. BACKING OBC 9.19.2**
24. **FIREPLACE CHIMNEYS**—OBC. 9.21.—TOP OF FIREPLACE CHIMNEY SHALL BE 915mm (3'-0") ABOVE THE HIGHEST POINT AT WHICH IT COMES IN CONTACT WITH THE ROOF AND 610mm (2'-0") ABOVE THE ROOF SURFACE WITHIN A HORIZ. DISTANCE OF 3050mm (10'-0") FROM THE CHIMNEY.

25. **LINEN CLOSET, 4 SHELVES MIN. 350mm (14") DEEP.**
26. **MECHANICAL EXHAUST FAN, VENTED TO EXTERIOR, TO PROVIDE AT LEAST ONE AIR CHANGE PER HOUR.**

27. **STEEL BEARING PLATE FOR MASONRY WALLS**
280x280x16 (11"x11"x5/8") STL PLATE FOR STL BEAMS AND 280x280x12 (11"x11"x1/2") STL PLATE FOR WOOD BEAMS BEARING ON CONC. BLOCK PARTYWALL, ANCHORED WITH 2-19mm (3/4") x 200mm (8") LONG GALV. ANCHORS WITHIN SOLID BLOCK COURSE. LEVEL WITH NON-SHRINK GROUT.

28. **U.L.C. RATED CLASS "B" VENT 610mm (2'-0") ABOVE THE POINT IN CONTACT WITH THE ROOF FOR SLOPES UP TO 9/12. REFER TO THE ONTARIO GAS UTILIZATION CODE.**

29. **2-38x140 (2-2"x6") OR 3-38x90 (3-2"x4") BUILT-UP JOIST POST ON METAL BASE SHOE ANCHORED TO CONC. WITH 12.7 (1/2") DIA. BOLT, ON 610x610x200 (24"x24"x8") CONC. PAD FOOTING c/w 3-15m REBAR ON BOTTOM EACH WAY**

30. **3.5"x3.5"x5" HSS POST OVER 48"x48"x12" CONC. PAD c/w 6-15m BOTTOM EACH WAY**

31. **PORCH SLAB/STEPS: 130 mm (5") MIN. CONC. 32 MPa SLAB AIR ENTRAPMENT MIN. 5 TO 8% AT 28 DAYS, 10 M BARS @ 250 O/C EACH WAY 10M DOWELS @400 (16") O.C. 2-15m IN THICKENED AREA FROM WALL TO SLAB ALL SIDES (SEE DETAIL)**

32. **DIRECT VENT FURNACE TERMINAL MIN. 900mm (36") FROM A GAS REGULATOR, 300mm (12") ABOVE FIN. GRADE. FROM ALL OPENINGS EXHAUST AND INTAKE VENTS. HRY INTAKE TO BE A MIN. OF 1300mm (6'-0") FROM ALL EXHAUST TERMINALS. REFER TO GAS UTILIZATION CODE.**

33. **DIRECT VENT GAS FIREPLACE. VENT TO BE A MINIMUM 300mm (12") FROM ANY OPENING AND ABOVE FIN. GRADE. REFER TO GAS UTILIZATION CODE.**

34. **SUBFLOOR JOIST STRAPPING AND BRIDGING**
-19mm (3/4") T & G SUBFLOOR ON WOOD FLOOR JOISTS. FOR CERAMIC TILE APPLICATION (* SEE OBC 9.30.6.1 *) 6mm (1/4") PANEL TYPE UNDERLAY UNDER RESILIENT & PARQUET FLOORING. (*- SEE OBC 9.30.2 *) ALL JOISTS TO BE BRIDGED WITH 38x38 (2"x2") CROSS BRACING OR SOLID BLOCKING @ 2100mm (6'-11") O.C. MAX. ALL JOISTS TO BE STRAPPED WITH 19x64 (1"x3") @ 2100mm (6'-11") O.C. UNLESS A PANEL TYPE CEILING FINISH IS APPLIED. (SEE OBC 9.23.9.4)

35. **EXPOSED BUILDING FACE**—OBC. 9.10.14.5—EXTERIOR WALLS TO HAVE A FIRE RESISTANCE RATING OF NOT LESS THAN 45 min. WHERE LIMITING DISTANCE IS LESS THAN 1.2M (3'-11"). WHERE THE LIMITING DISTANCE IS LESS THAN 600mm (1'-11") THE EXPOSING FACE SHALL BE CLAD IN NON-COMBUSTIBLE MATERIAL.

36. **PARTY WALL W43b**
-12.7mm (1/2") TYPE 'X' GYPSUM BOARD
-2 ROWS OF 2x4 WOOD STUD @ MAX. 16" o.c. ON SEPARATE 2x4 BASE PLATES SET 1" APART (STAGGER STUDS IN EACH WALL)
-FILL BOTH FRAMED CAVITIES WITH MINERAL FIBRE INSULATION OF MIN. MASS OF 2.8kg/m² FOR 88mm -12.7mm (1/2") TYPE 'X' GYPSUM BOARD

- 36B. **PARTY WALL W44**
-SB-3 - W44 - 60min. F.R.R. - STC 53)
-12.7mm (1/2") TYPE 'X' GYPSUM BOARD
-2x4 WOOD STUD WALL @ 24" o.c.
-FILL FRAMED CAVITY WITH MINERAL FIBRE INSULATION OF MIN. MASS OF 2.8kg/m² FOR 88mm -RESILIENT CHANNELS @ 16" o.c.
-2 LAYERS OF 12.7mm (1/2") TYPE 'X' GYPSUM BOARD

37. **THE FDN. WALL SHALL NOT BE REDUCED TO LESS THAN 90mm (3'-1/2") THICK TO A MAX. DEPTH OF 350mm (13'-3/4") AND SHALL BE TIED TO THE FACING MATERIAL WITH METAL TIES SPACED 200mm (8") O.C. VERTICALLY AND 900mm (36") O.C. HORIZONTALLY. FILL SPACE BETWEEN WALL AND FACING SOLID WITH MORTAR. (SEE OBC 9.15.4.7)**
38. **CONVENTIONAL ROOF FRAMING 38x140 (2"x6") RAFTERS @ 400mm (16") O.C. FOR MAX. 11'-7" SPAN, 38x184 (2"x8") RIDGE BOARD, 38x89 (2"x4") COLLAR TIES AT MIDSPANS. CEILING JOISTS TO BE 38x89 (2"x4") @ 400mm (16") O.C. FOR MAX. 2830mm (9'-3") SPAN & 38x140 (2"x6") @ 400mm (16") O.C. FOR MAX. 4450mm (14'-7") SPAN. RAFTERS FOR BUILT-UP ROOF TO BE 38x89 (2"x4") @ 600mm (24") O.C. WITH 38x89 (2"x4") CENTRE POST TO THE TRUSS BELOW. EXTERIOR WALLS FOR WALK-OUT CONDITIONS THE EXTERIOR BASEMENT STUD WALL TO BE 38x140 (2"x6") STUDS @ 16" o.c. OR 38x89 (2"x4") STUDS @ 12" o.c.**

39. **TWO STOREY VOLUME SPACES**
FOR HIGH WALL UP TO 18'-0":
CONSTRUCTION: 2"x6" SPACING AS INDICATED BLOCKING: 3 ROWS @ 4'-6" O/C ±
SHEATHING: 7/16" ASPENITE
NAILING: 2" STAPLES BET. 4" AND 6" O/C ALONG STUDS
STUD SPACING WITH VARIOUS FINISHES:
1. SIDING-METAL OR VINYL- 2"x6" @16" O/C
2. STUCCO - 2"x6" @16" O/C
3. BRICK TO 4'-0" - 2"x6" @16" O/C
4. BRICK FULL HEIGHT - 2"x6" @12" O/C

- WINDOWS:
- 1) **MINIMUM BEDROOM WINDOW**—OBC. 9.9.10. AT LEAST ONE BEDROOM WINDOW ON A GIVEN FLOOR IS TO HAVE MIN. 0.35m² UNOBTSTRUCTED GLAZED OR OPENABLE AREA WITH MIN. CLEAR WIDTH OF 380 mm (1'-3").
- 2) **WINDOW GUARDS**—OBC. 9.8.8.1, A GUARD IS REQUIRED WHERE THE TOP OF THE WINDOW SILL IS LOCATED LESS THAN 480mm (1'-7") ABOVE FIN. FLOOR AND THE DISTANCE FROM THE FIN. FLOOR TO THE ADJACENT GRADE IS GREATER THAN 1800mm (5'-11")
- 3) **ALL WINDOWS TO COMPLY WITH THERMAL RESISTANCE REQUIREMENTS STATED IN OBC 12.3.5.6. AND SB12 PRESCRIPTIVE COMPLIANCE PACKAGE, AND OBC 9.5, 9.6, 9.7**

- GENERAL
- 1) **MECHANICAL VENTILATION IS REQUIRED TO PROVIDE 0.3 AIR CHANGES PER HOUR AVERAGED OVER 24 HOURS. SEE MECHANICAL DRAWINGS.**
- 2) **ALL DOWNSPOUTS TO DRAIN AWAY FROM THE BUILDINGS PER OBC 9.26.18.2 AND MUN. STANDARDS.**
- 3) **ALL WINDOW WELLS TO DRAIN TO FOOTING LEVEL PER OBC 9.14.6.3 CHECK WITH LOCAL AUTHORITY.**
- 4) **ALL WINDOW STUD WALL REINFORCEMENT FOR FUTURE GRAB BARS IN BATHROOMS. REINF. OF STUD WALLS SHALL BE INSTALLED ADJACENT TO WATER CLOSETS AND SHOWER OR BATHTUB IN MAIN BATHROOM. SEE OBC 9.5.2.3, 3.8.3.8.(1)(d) & 3.8.3.13.(1)(f).**

- LUMBER:
- 1) **ALL LUMBER SHALL BE SPRUCE NO.2 GRADE, UNLESS NOTED OTHERWISE.**
- 2) **STUDS SHALL BE STUD GRADE SPRUCE, UNLESS NOTED OTHERWISE.**
- 3) **LUMBER EXPOSED TO THE EXTERIOR TO BE SPRUCE NO.2 GRADE PRESSURE TREATED OR CEDAR, UNLESS NOTED OTHERWISE.**
- 4) **ALL LAMINATED VENEER LUMBER (L.V.L.) BEAMS, GIRDER TRUSSES, AND METAL HANGER CONNECTIONS SUPPORTING ROOF SHALL BE TO BE DESIGNED & CERTIFIED BY TRUSS MANUF.**
- 5) **L.V.L. BEAMS SHALL BE 2.0E NS MICRO-LAM LVL (Fb=2800psi MIN.) OR EQUIVALENT. NAIL EACH PLY OF LVL WITH 89mm (3 1/2") LONG COMMON WIRE NAILS @ 300mm (12") O.C. STAGGERED IN 2 ROWS FOR 184, 240 & 300mm (7 1/4", 9 1/2", 11 7/8") DEPTHS AND STAGGERED IN 3 ROWS FOR GREATER DEPTHS AND FOR 4 PLY MEMBERS. ADD 13mm (1/2") DIA. GALVANIZED BOLTS BOLTED AT MID-DEPTH OF BEAM @ 915mm (3'-0") O.C.**
- 6) **PROVIDE TOP MOUNT BEAM HANGERS TYPE "SC" MANUFACTURED BY MGA CONNECTOR LTD. Tel. (905) 642-5175 OR EQUAL FOR ALL LVL BEAM TO BEAM CONNECTIONS UNLESS OTHERWISE NOTED.**
- 7) **HANGER PROFILES OR METAL HANGERS FOR ALL JOISTS AND BUILT-UP WOOD MEMBERS INTERSECTING FLUSH BUILT-UP WOOD MEMBERS.**
- 8) **WOOD FRAMING NOT TREATED WITH A WOOD PRESERVATIVE. IN CONTACT WITH CONCRETE, SHALL BE SEPARATED FROM THE CONCRETE BY AT LEAST 2 mil. POLYETHYLENE FILM No. 50 (45lbs.) ROLL ROOFING OR OTHER DAMPROOFING MATERIAL, EXCEPT WHERE THE WOOD MEMBER IS ST LEAST 150mm (6") ABOVE THE GROUNDING.**

- STEEL:
1. **STRUCTURAL STEEL SHALL CONFORM TO CAN/CSA-G40-21 GRADE 300W.**
2. **HOLLOW STRUCTURAL SECTIONS SHALL CONFORM TO CAN/CSA-G40-21 GRADE 350W CLASS "H".**
3. **REINFORCING STEEL SHALL CONFORM TO CSA-G30-18M GRADE 400R.**

WOOD LINTELS AND BUILT-UP WOOD BEAMS	
L1	2/38 x 184 (2/2" x 8") SPR.#2
B1	3/38 x 184 (3/2" x 8") SPR.#2
B2	4/38 x 184 (4/2" x 8") SPR.#2
L3	2/38 x 235 (2/2" x 10") SPR.#2
B3	3/38 x 235 (3/2" x 10") SPR.#2
B4	4/38 x 235 (4/2" x 10") SPR.#2
L5	2/38 x 286 (2/2" x 12") SPR.#2
B5	3/38 x 286 (3/2" x 12") SPR.#2
B6	4/38 x 286 (4/2" x 12") SPR.#2

LOOSE STEEL LINTELS	
L7	90 x 90 x 6.0L (3-1/2" x 3-1/2" x 1/4")
L8	90 x 90 x 8.0L (3-1/2" x 3-1/2" x 5/16")
L9	100 x 90 x 8.0L (4" x 3-1/2" x 5/16")
L10	125 x 90 x 8.0L (5" x 3-1/2" x 5/16")
L11	125 x 90 x 10.0L (5" x 3-1/2" x 3/8")
L12	150 x 100 x 10.0L (6" x 4" x 3/8")

STEEL COLUMNS (UNLESS NOTED OTHERWISE)

TP = (1) 3" DIA. ADJ. ST. POST
(2) 3" DIA. ADJ. ST. POSTS
HSS = 3"x3" x 0.168" HSS POST

BRICK LUNTEL SCHEDULE [OBC2012] 9.20.5.2A	
MAXIMUM BEARING EACH END	BRICK LUNTEL SIZE
4'-0"	3 1/2" x 3 1/2" x 1/4"
5'-0"	3 1/2" x 3 1/2" x 5/16"
7'-0"	4" x 3 1/2" x 5/16"
8'-0"	5" x 3 1/2" x 5/16"
10'-0"	6" x 4" x 7/16"

WOOD LUNTEL SCHEDULE [OBC2012] 9.23.1.2	
SPF BEAM	MAX. OPENINGS
2- 2x8	2-STOREY
2- 2x10	58"
2- 2x12	68"
	77"

SOLID WOOD BEARING

2 MEMBER BUILT-UP STUD

3 MEMBER BUILT-UP STUD

4 MEMBER BUILT-UP STUD

City of Ottawa
Building Services Branch
EVA ONUFRAK
JAN 05 2022
city of Ottawa

SITE COPY

Building Code Reviewed

LEGEND

EXHAUST VENT/FAN

DUPLEX OUTLET

GROUND FAULT CIRCUIT

WEATHERPROOF DUPLEX OUTLET

HEAVY DUTY OUTLET

POT LIGHT

LIGHT FIXTURE (CEILING MOUNTED)

LIGHT FIXTURE (WALL MOUNTED)

SWITCH

DOUBLE HEADED ADJUSTABLE SPOTLIGHT

FLOOR DRAIN

HOSE BIB

DOUBLE JOIST

TRIPLE JOIST

LAMINATED VENEER LUMBER

POINT LOAD FROM ABOVE

PRESSURE TREATED LUMBER

GIRDER TRUSS

BY ROOF TRUSS MANUF.

FA

FLAT ARCH

CURVED ARCH

M.C.

M.C.

CONC. BLOCK WALL

FIRE RATED SEPARATION - 1 WALL THICK

NOTE ARROW DENOTES WHICH SIDE TO HAVE RESILIENT CHANNEL & DOUBLE DRYWALL

FIRE RATED SEPARATION - 2 WALLS THICK

TWO-STOREY HIGH WALLS

TO BE INSTALLED AS PER OBC. 9.10.19

CARBON MONOXIDE DETECTOR (OBC 9.33.4)

WHERE A FUEL-BURNING APPLIANCE IS INSTALLED IN A DWELLING UNIT, A CARBON MONOXIDE DETECTOR SHALL BE INSTALLED ADJACENT TO EACH SLEEPING AREA. WHERE SLEEPING AREAS ARE SEPARATED BY PERMANENTLY WELDED OR TIGHTLY JOINED WALLS, THE CARBON MONOXIDE DETECTORS AND BE EQUIPPED WITH AN ALARM THAT IS AUDIBLE WITHIN BEDROOMS WHEN THE INTERVENING DOORS ARE CLOSED.

CONTRACTOR MUST VERIFY ALL DIMENSIONS ON THE JOB AND REPORT ANY DISCREPANCY TO DCR/PHOENIX BEFORE PROCEEDING WITH THE WORK.
ALL DRAWINGS AND SPECIFICATIONS ARE INSTRUMENTS OF SERVICE AND THE PROPERTY OF THE DCR/PHOENIX WHICH MUST BE RETURNED AT THE COMPLETION OF THE WORK.
ALL DRAWINGS TO BE USED FOR CONSTRUCTION OF THE WORK AFTER BUILDING PERMIT HAS BEEN ISSUED.
DO NOT SCALE DRAWINGS, USE DIMENSIONS PROVIDED.

file number: 508

drawn by: A. FRANCOEUR


date: OCT. 2003

scale: 3/16"=1'

DCL-201

sheet no: 1/9

No.	Description	dd/mm/yy	By
4	FOR ENGINEERING REVIEW	12/11/21	GK
3	FOR LAYOUTS	20/10/21	GK
2	BEP BLACKLINES REV.	05/10/21	GK
1	BEP BLACKLINES	30/09/21	GK
REVISIONS			

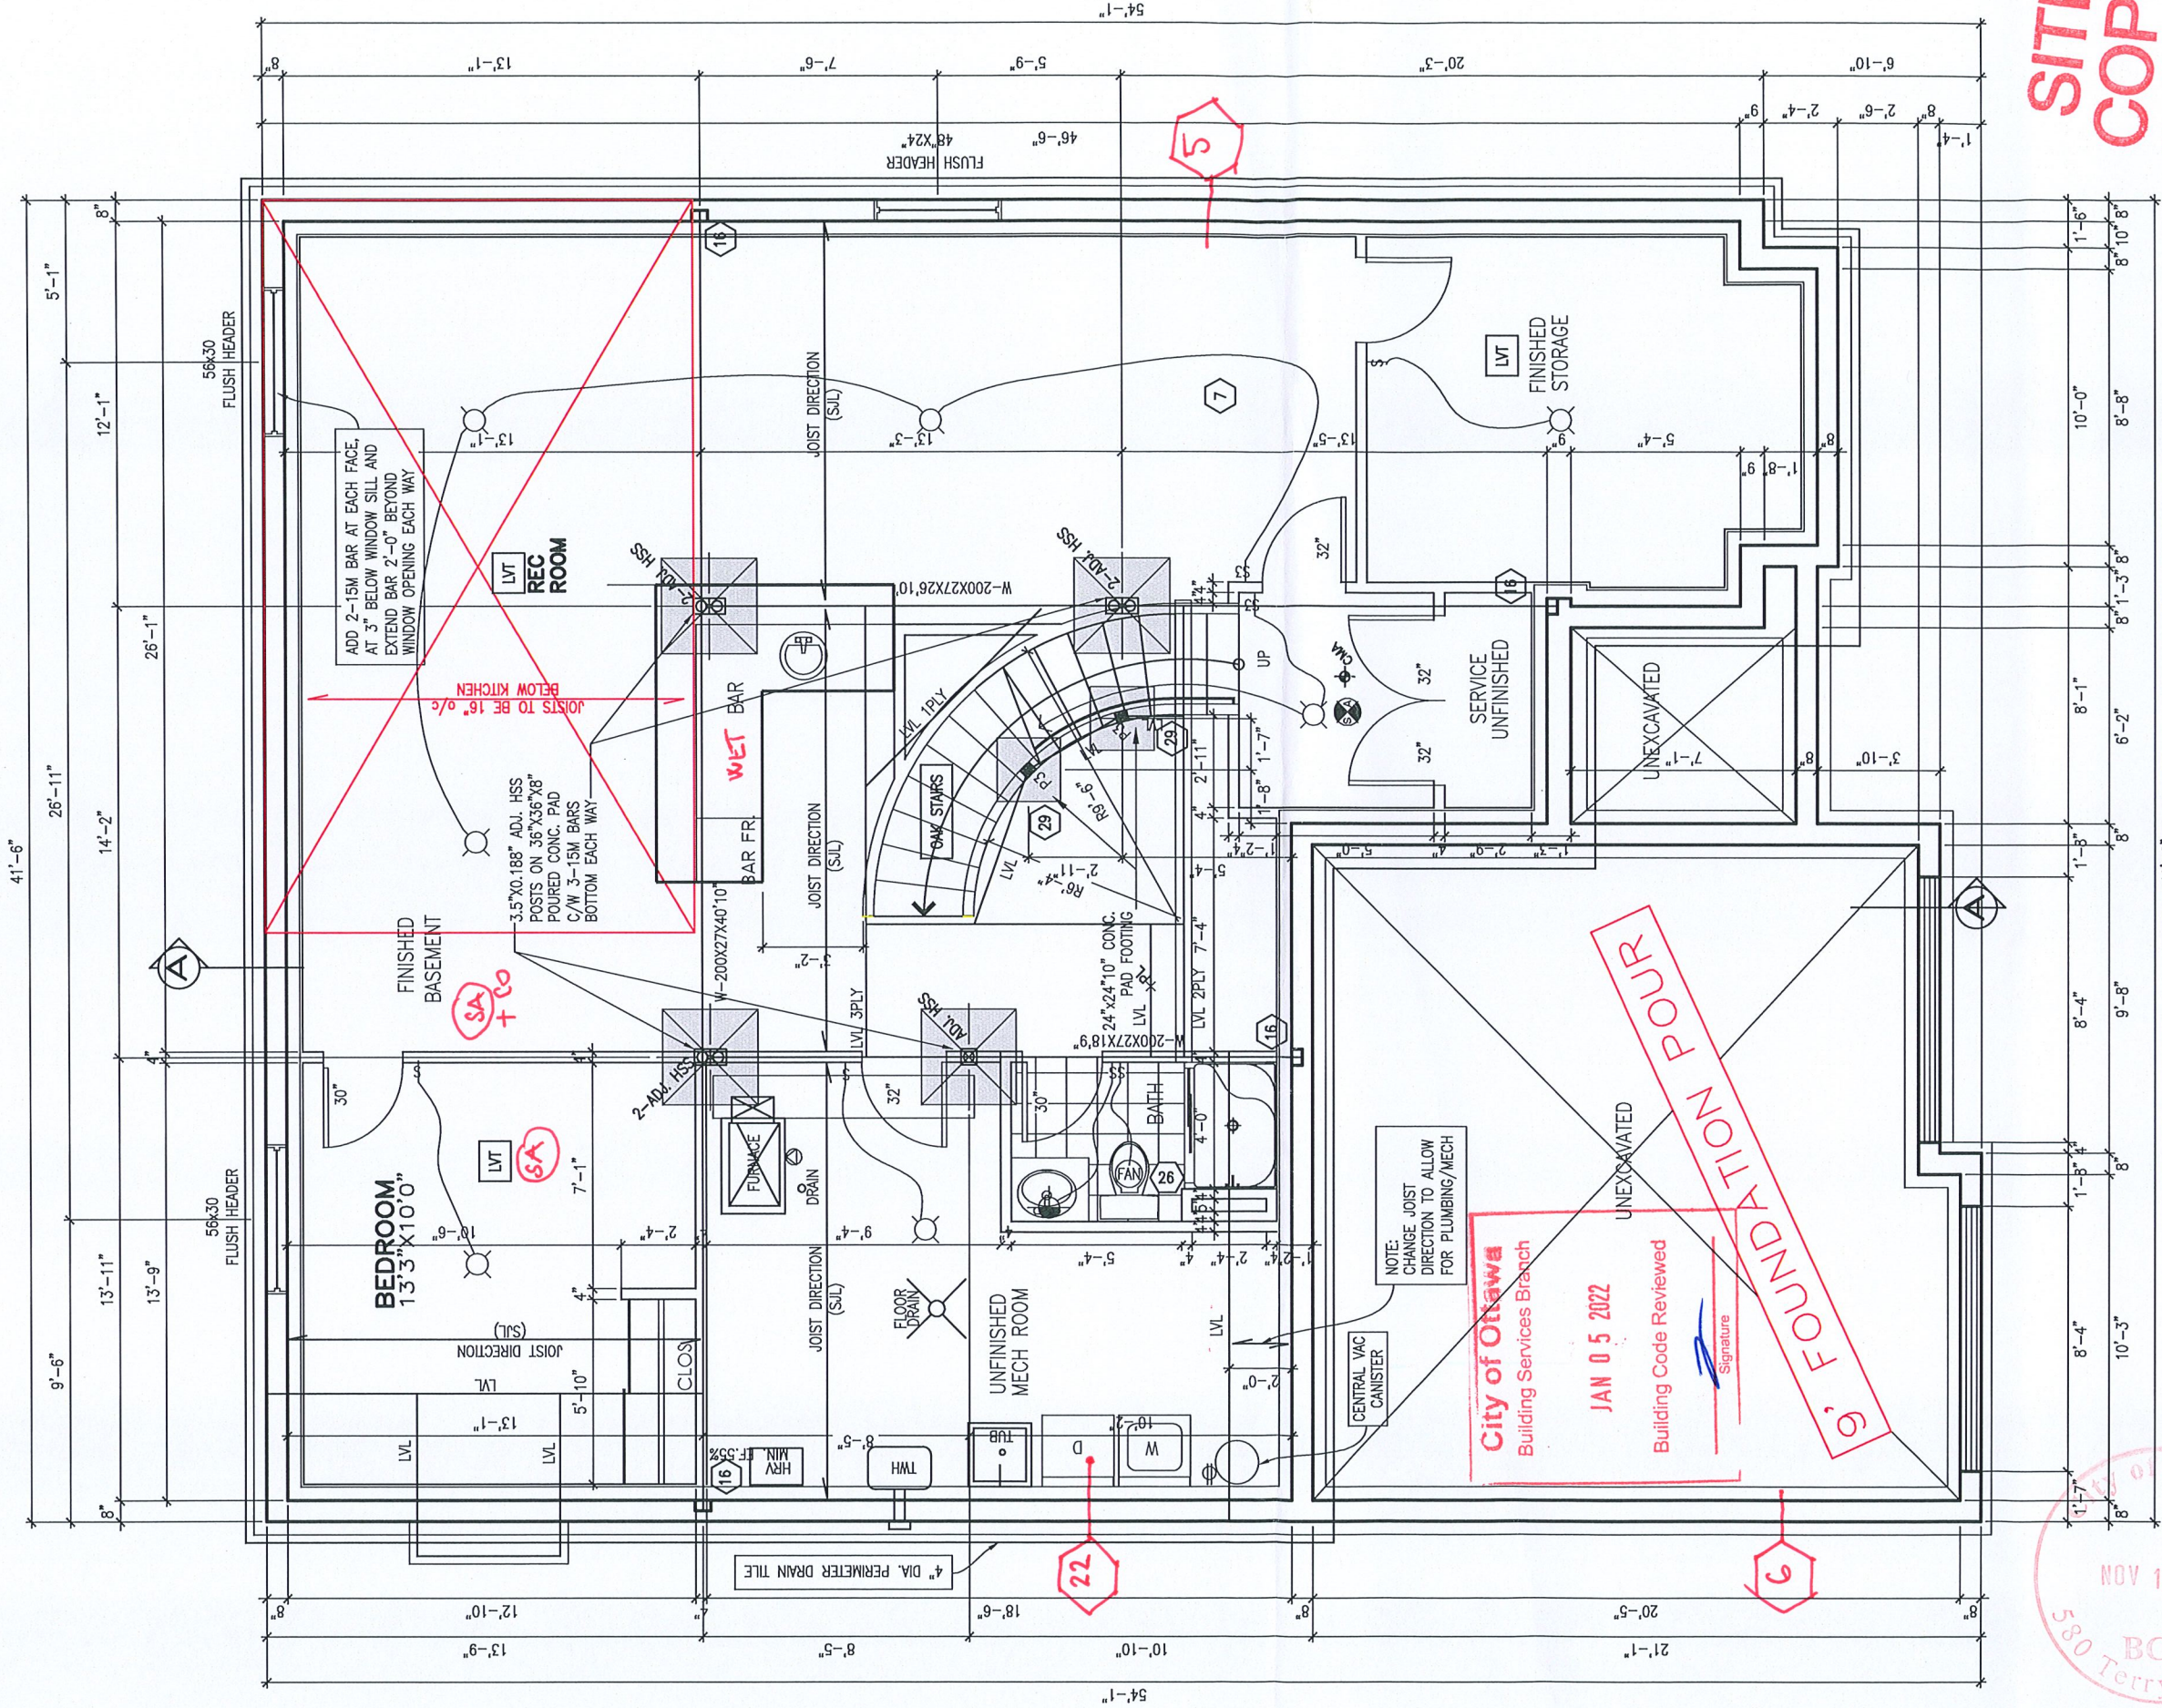


SITE COPY
City of Ottawa

FLAT CEILINGS THROUGHOUT
NO STIPPLE

20x6 STRIP FOOTINGS

9' FOUNDATION POUR

City of Ottawa
Building Services Branch
JAN 05 2022
Building Code Reviewed

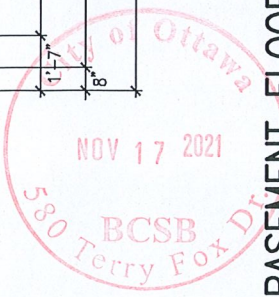

BASEMENT FLOOR PLAN ELEV. F
FINISHED BASEMENT- 1292 SQ.FT.

PHOENIX HOMES

CHESAPEAKE-2019-A/B

SITE: **DIAMONDVIEW**

LOT NUMBER: **2-49**

CIVIC ADDRESS: 1906 CESSNA PRIVATE

file number: **508**

drawn by: **A. FRANCOEUR**


date: **OCT. 2003**

scale: **3/16"=1'**

DCL-201 sheet no: **2**

No.	Description	By	dd/mm/yy
1	BEP BLACKLINES	GK	30/09/21
2	BEP BLACKLINES REV.	GK	05/10/21
3	FOR LAYOUTS	GK	20/10/21
4	FOR ENGINEERING REVIEW	GK	12/11/21

NOTE:
- ALL WINDOW LINTELS TO BE 2-2X10 W/ P2 POSTS ON EACH SIDE U.N.O.
- REFER TO GENERAL NOTES PAGE FOR BRICK LINTEL SIZES

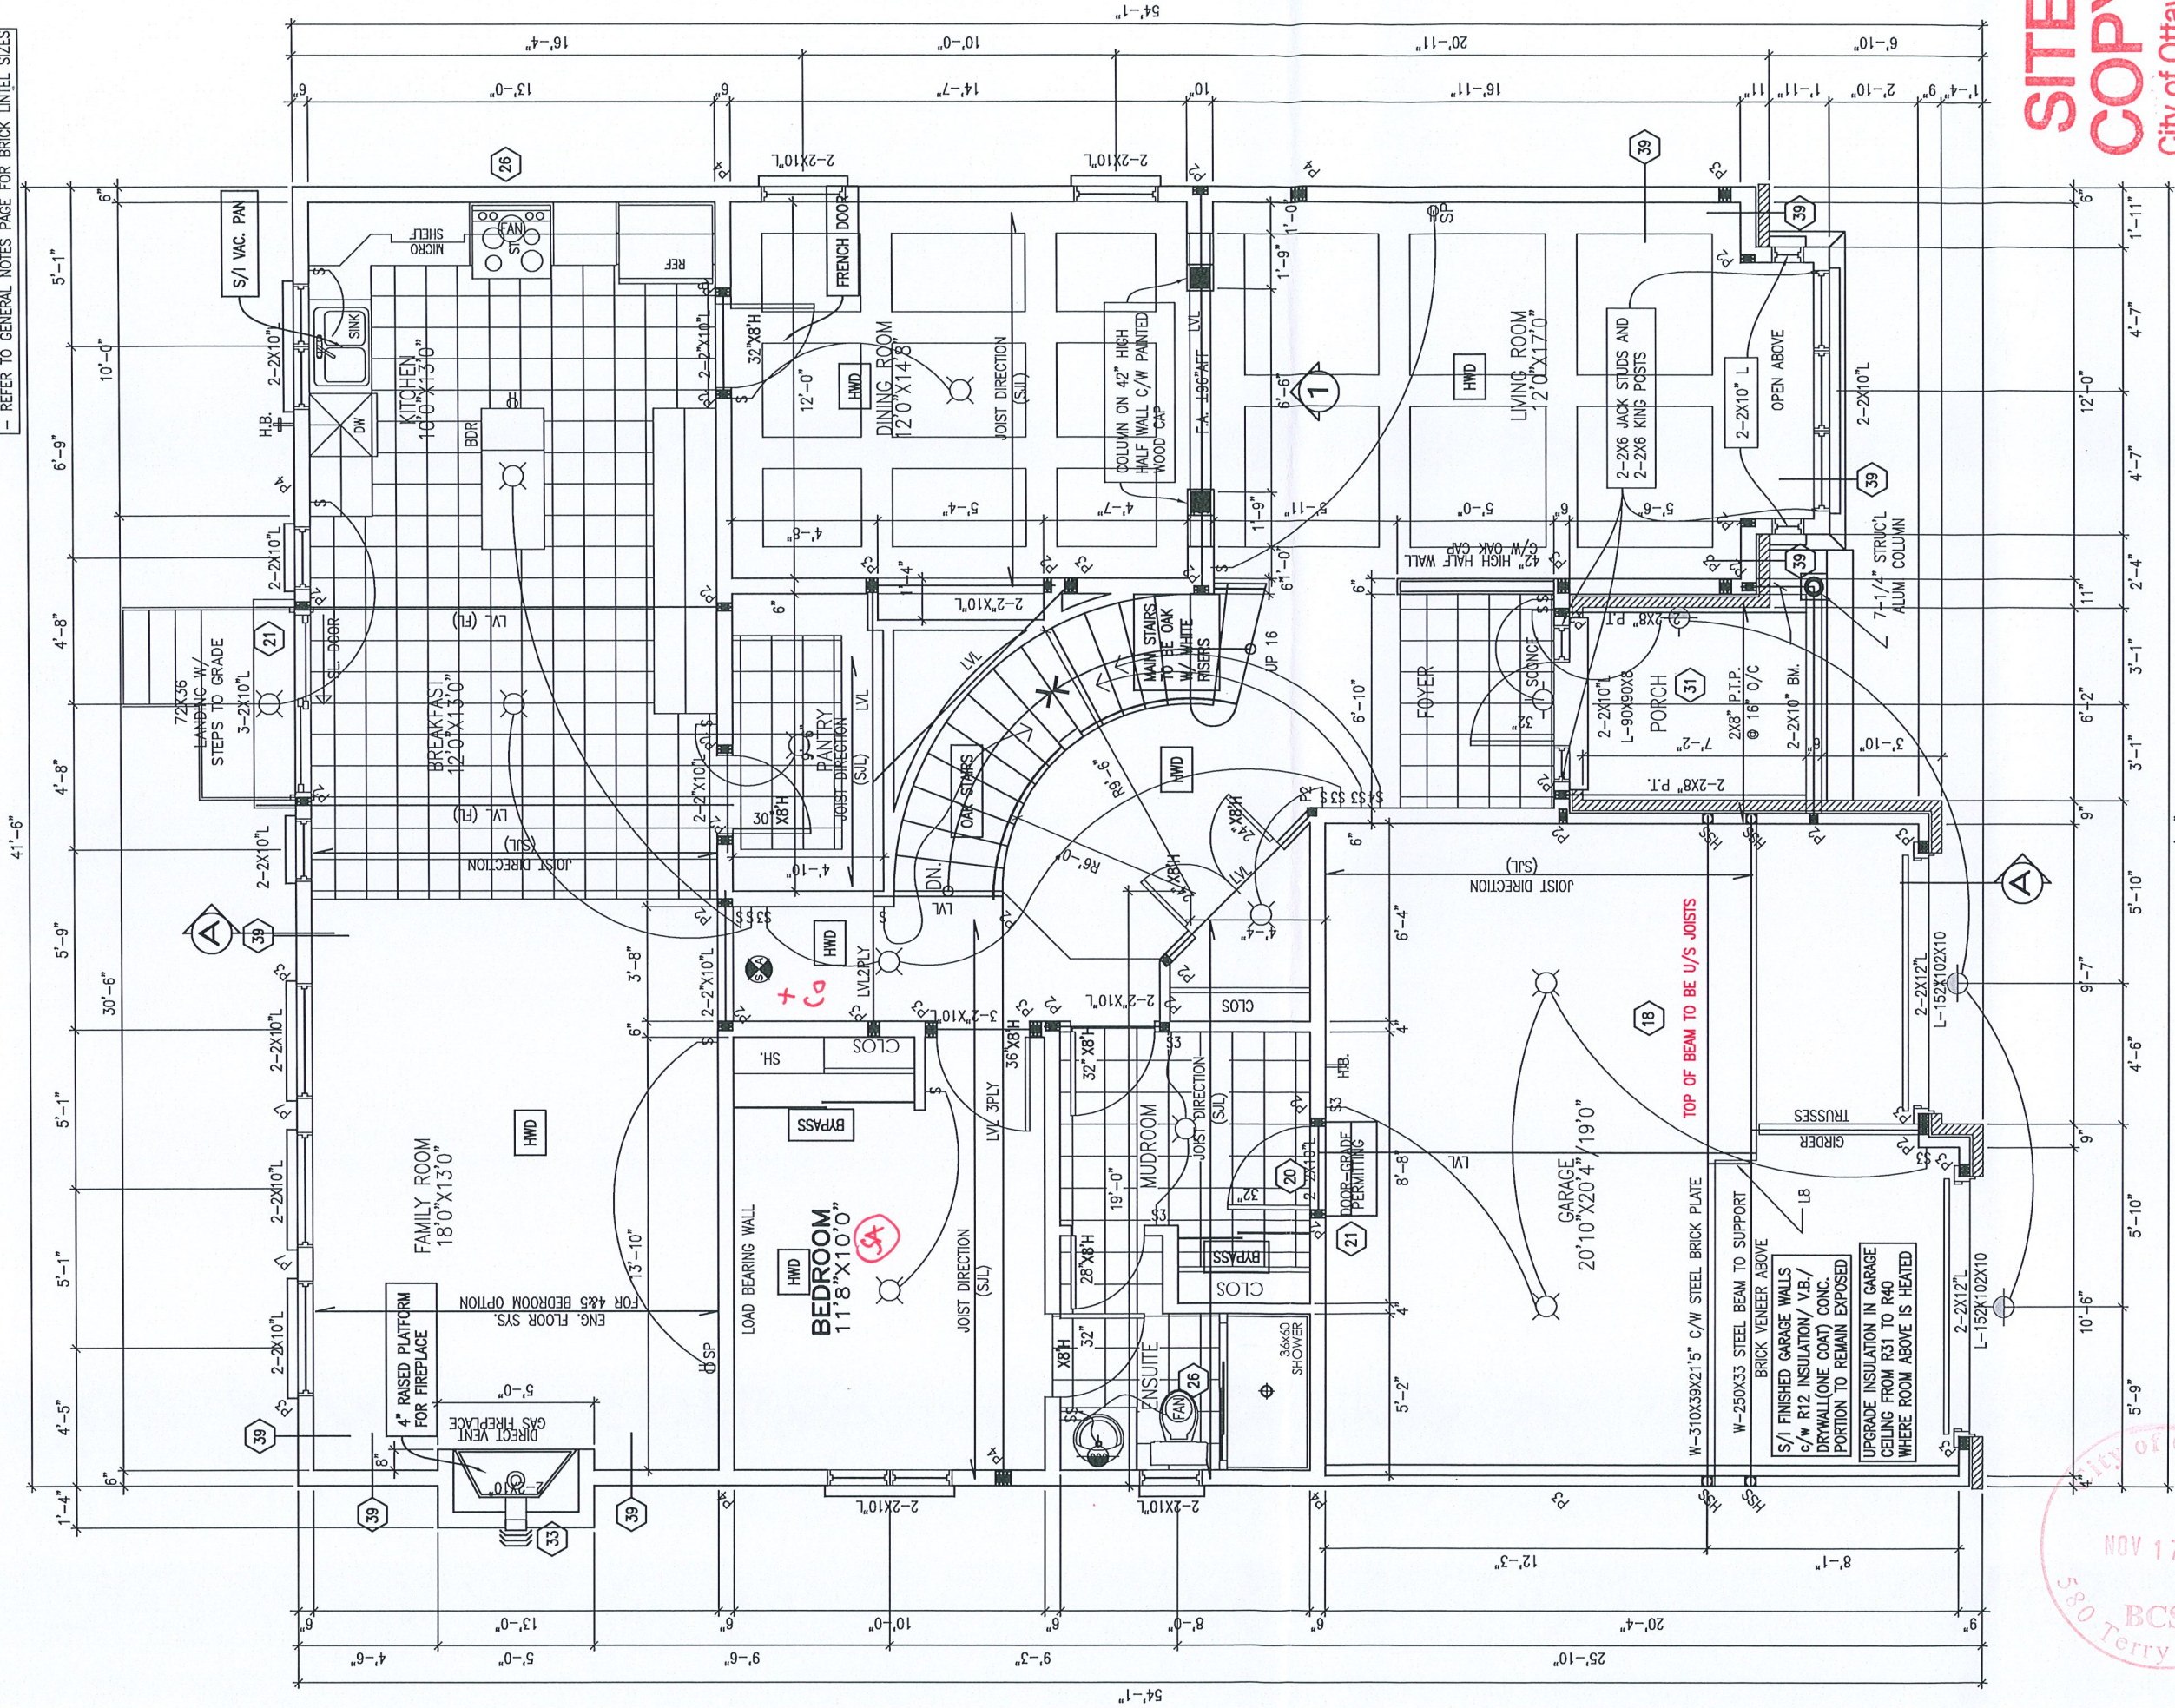


SITE COPY
City of Ottawa

FLAT CEILINGS THROUGHOUT
NO STIPPLE
City of Ottawa
Building Services Branch

****NOTE****
ALL WINDOW LINTELS TO BE 2-2X10
W/ P2 POSTS ON EACH SIDE U.N.O.

MAIN FLOOR PLAN ELEV. F - 1635 SF

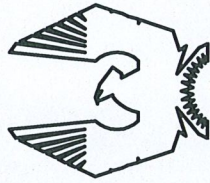

PHOENIX HOMES

CHESAPEAKE-2019-A/B

SITE: DIAMONDVIEW

2-49

LOT NUMBER:
CIVIC ADDRESS:
1906 CESSNA PRIVATE

file number:	508
drawn by:	A. FRANCOEUR
date:	OCT. 2003
scale:	3/16"=1'
DCL-201	sheet no:
3	9
Building Code Reviewed	
4 FOR ENGINEERING REVIEW	12/11/21 GK
3 FOR LAYOUTS	20/10/21 GK
2 BEP BLACKLINES REV.	05/10/21 GK
1 BEP BLACKLINES	30/09/21 GK
No. Description	dd/mm/yy By

JAN 05 2022

NOV 17 2021
BCSB
Terry Fox Dr.


JAN 05 2022

Building Code Reviewed

Signature

NOTE:
- ALL WINDOW LINTELS TO BE 2-2X10 W/ P2 POSTS ON EACH SIDE U.N.O.
- REFER TO GENERAL NOTES PAGE FOR BRICK LINTL SIZES

STUD WALL REINFORCEMENT FOR FUTURE GRAB BARS IN MAIN BATHROOM
REINFORCEMENT OF STUD WALLS SHALL BE INSTALLED ADJACENT TO WATER CLOSETS AND SHOWER OR BATHTUB IN MAIN BATHROOM. REFER TO CBC, 9.5.2.3, 3.8.3.8.(1)(d) & 3.8.3.13.(1)(f), AND DETAILS PROVIDED

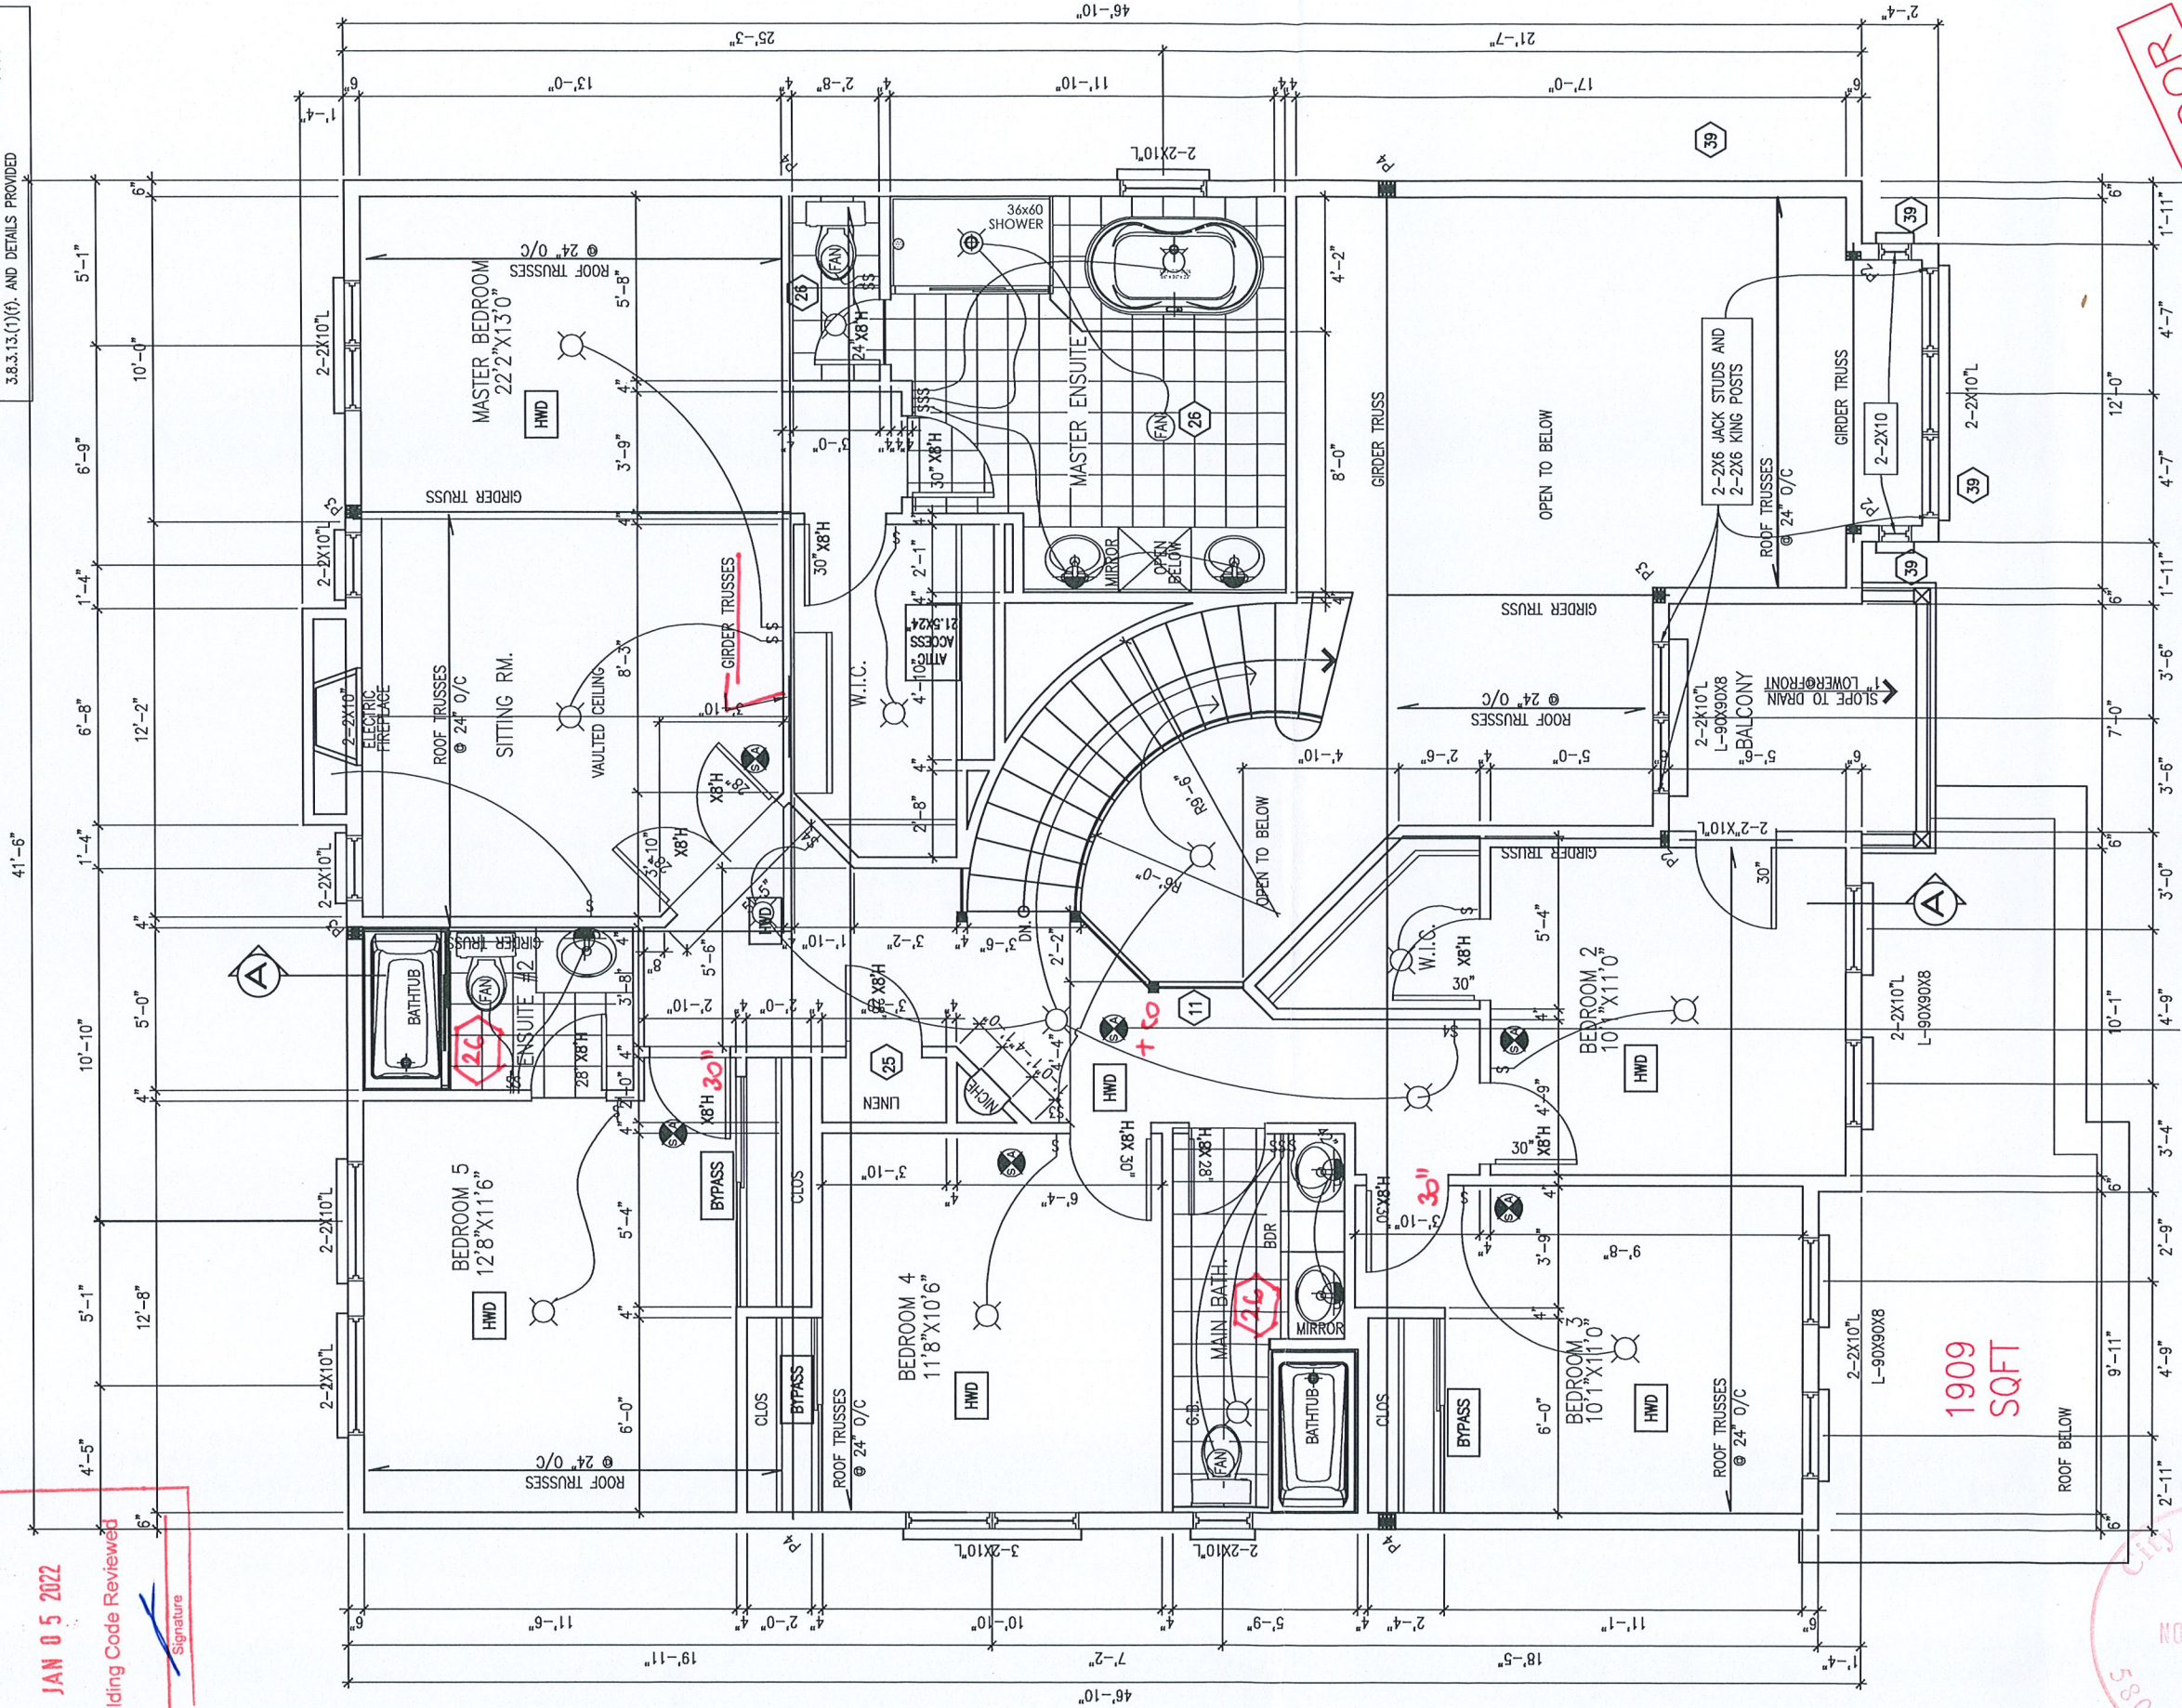


FLAT CEILINGS THROUGHOUT
NO STIPPLE

SECOND FLOOR PLAN ELEV. F - 1582 SF
(OPTIONAL 5 BEDROOM)

NOV 17 2021
BCSB
Terry Fox

9' SECOND FLOOR
SITE
COPY

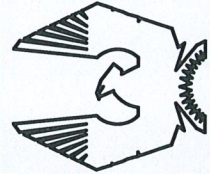

PHOENIX HOMES

CHEASAPEAKE-2012-F-5

SITE: DIAMONDVIEW

LOT NUMBER:


CIVIC ADDRESS:
1906 CESSNA PRIVATE

2-49

FOOTPRINT:	508
DRAWN BY:	S.D.
DATE:	AUG. 2012
SCALE:	3/16"=1'-0"
SHEET NO:	46
D.C.L.-	100

4	FOR ENGINEERING REVIEW	GK	12/11/21
3	FOR LAYOUTS	GK	20/10/21
2	BEP BLACKLINES REV.	GK	05/10/21
1	BEP BLACKLINES	GK	30/09/21
No.	Description	By	
REVISIONS			

4F.5
9

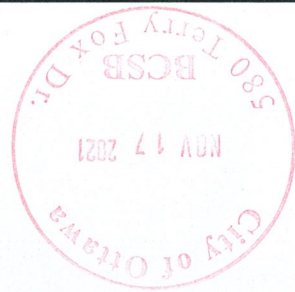



City of Ottawa
Building Services Branch

JAN 0 5 2022

Building Code Reviewed

Signature

SITE COPY
City of Ottawa

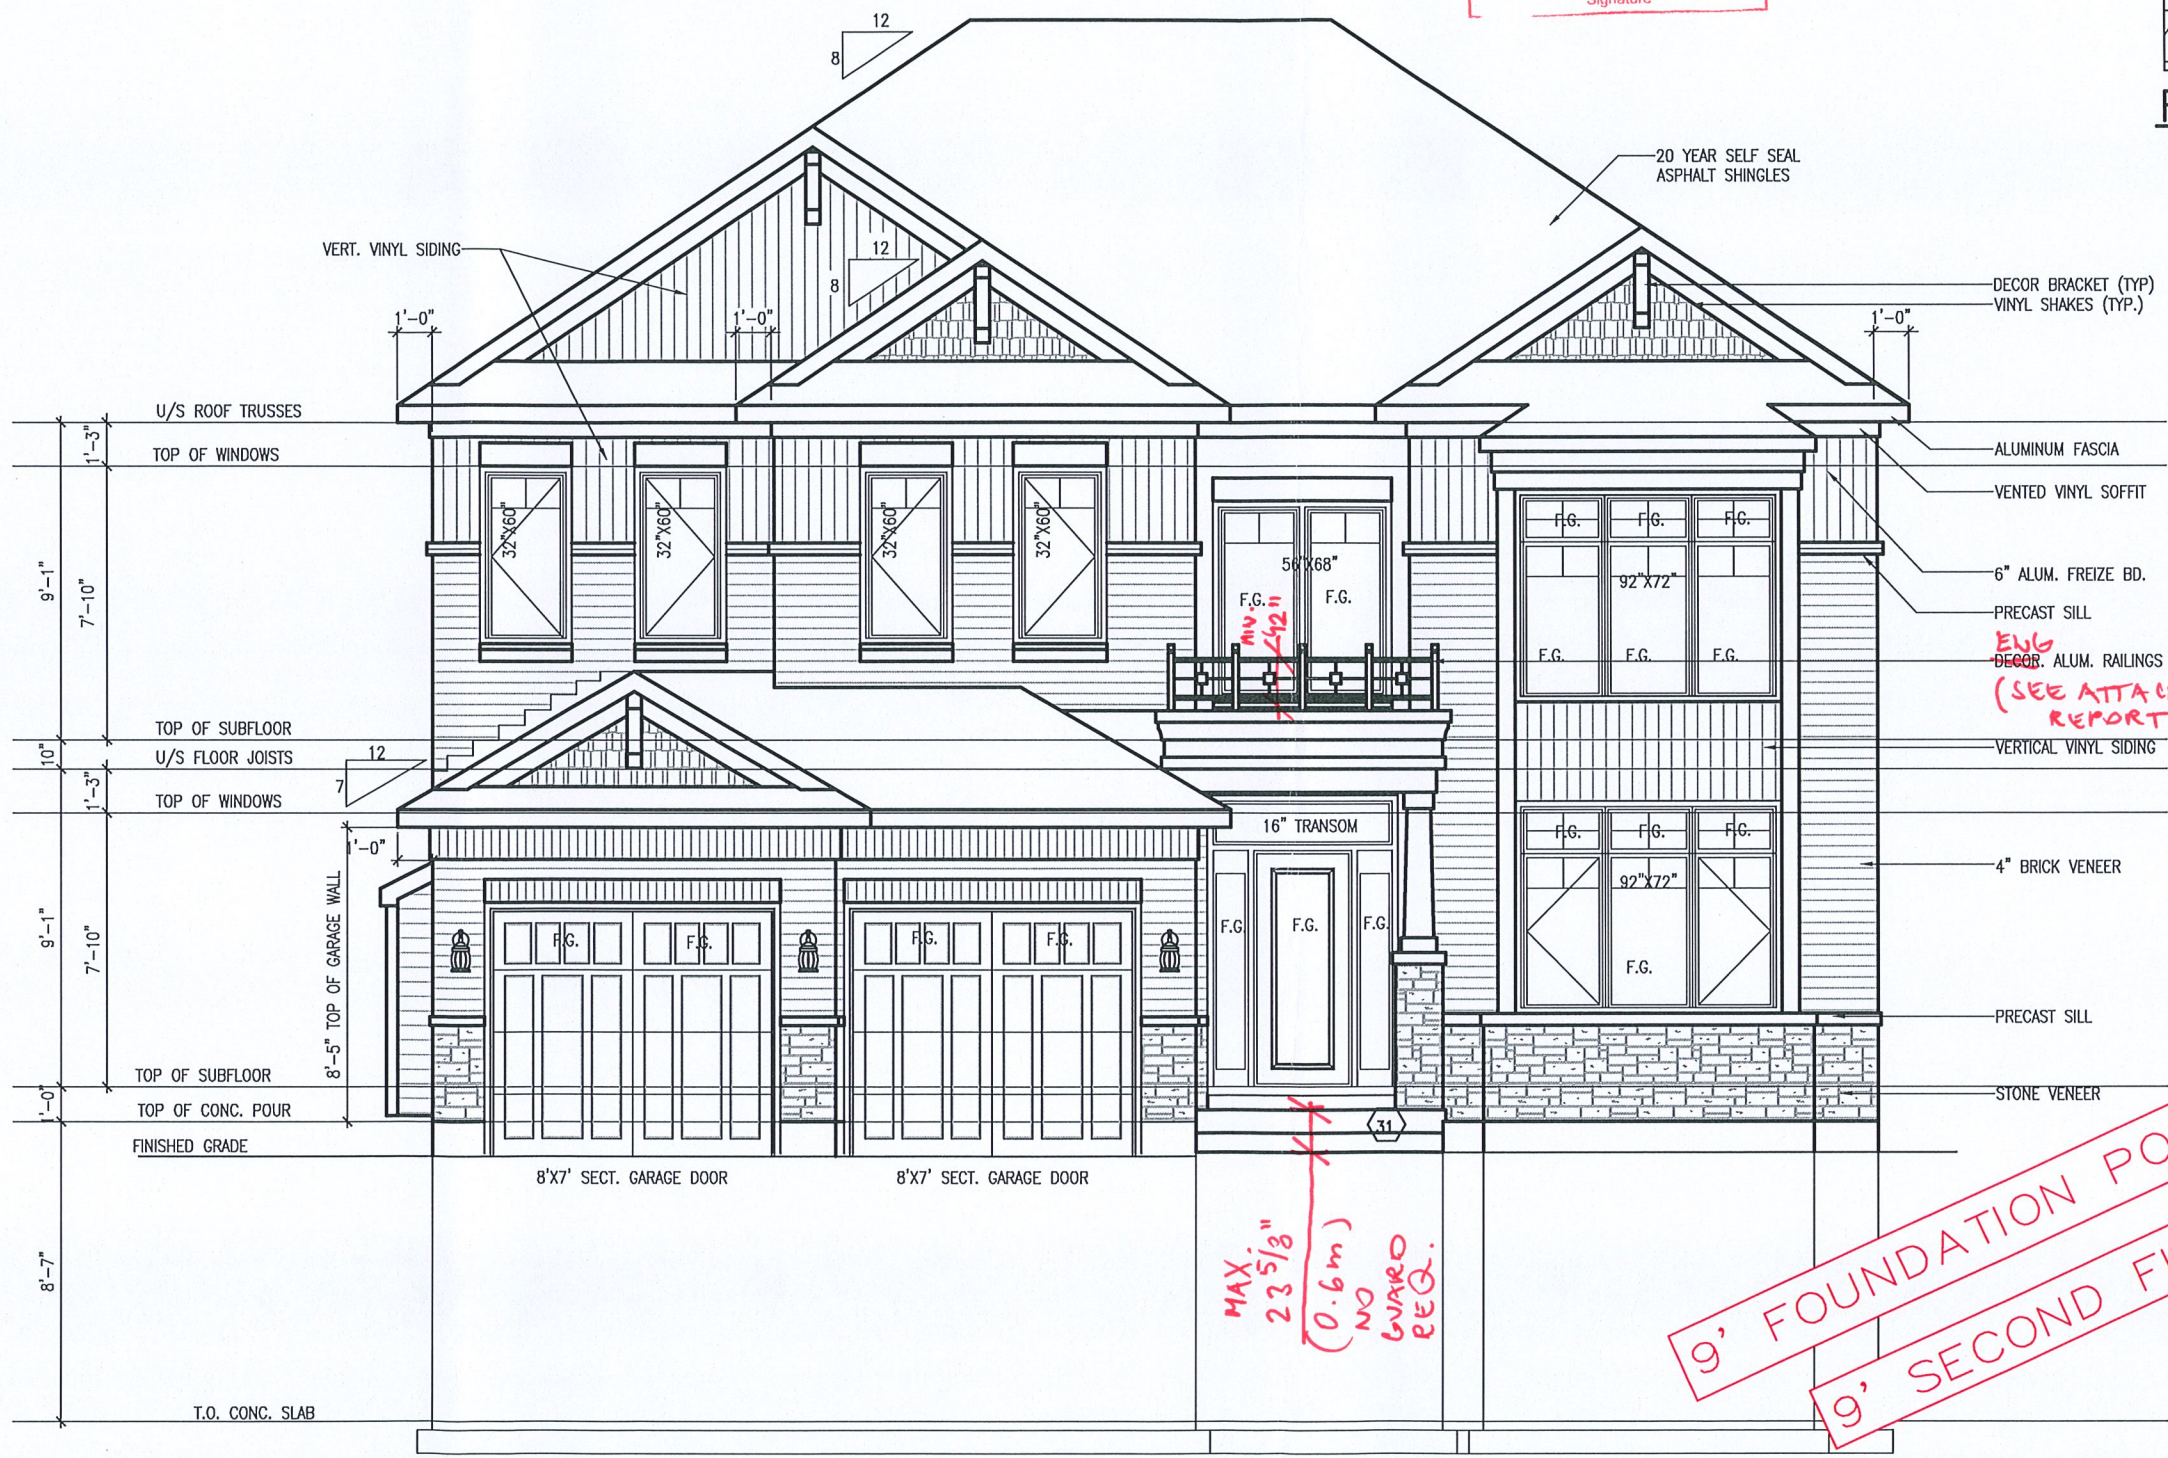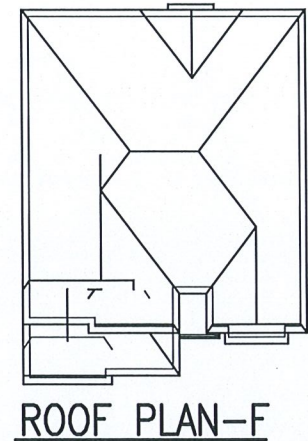

FRONT ELEVATION 'F'

9' FOUNDATION POUR
9' SECOND FLOOR

FOOTPRINT:	508
DRAWN BY:	S.D.
DATE:	AUG 2012
SCALE:	3/16"=1'-0"
SHEET NO:	47
D.C.L.:	100

No.	Description	REVISIONS
4	FOR ENGINEERING REVIEW	12/11/21 GK
3	FOR LAYOUTS	20/10/21 GK
2	BEP BLACKLINES REV.	05/10/21 GK
1	BEP BLACKLINES	30/09/21 GK
		dd/mm/yy

CHEASAPEAKE-2012-F

SITE: DIAMONDVIEW

LOT NUMBER: 2-49

CIVIC ADDRESS: 1906 CESSNA PRIVATE


PHOENIX HOMES

920.99 SQ.FT.
1.2 M (7%)
64.47 SQ.FT.
48.88 SQ.FT.



City of Ottawa
Building Services Branch
JAN 05 2022
Building Code Reviewed
Signature

**SITE
COPY**
City of Ottawa

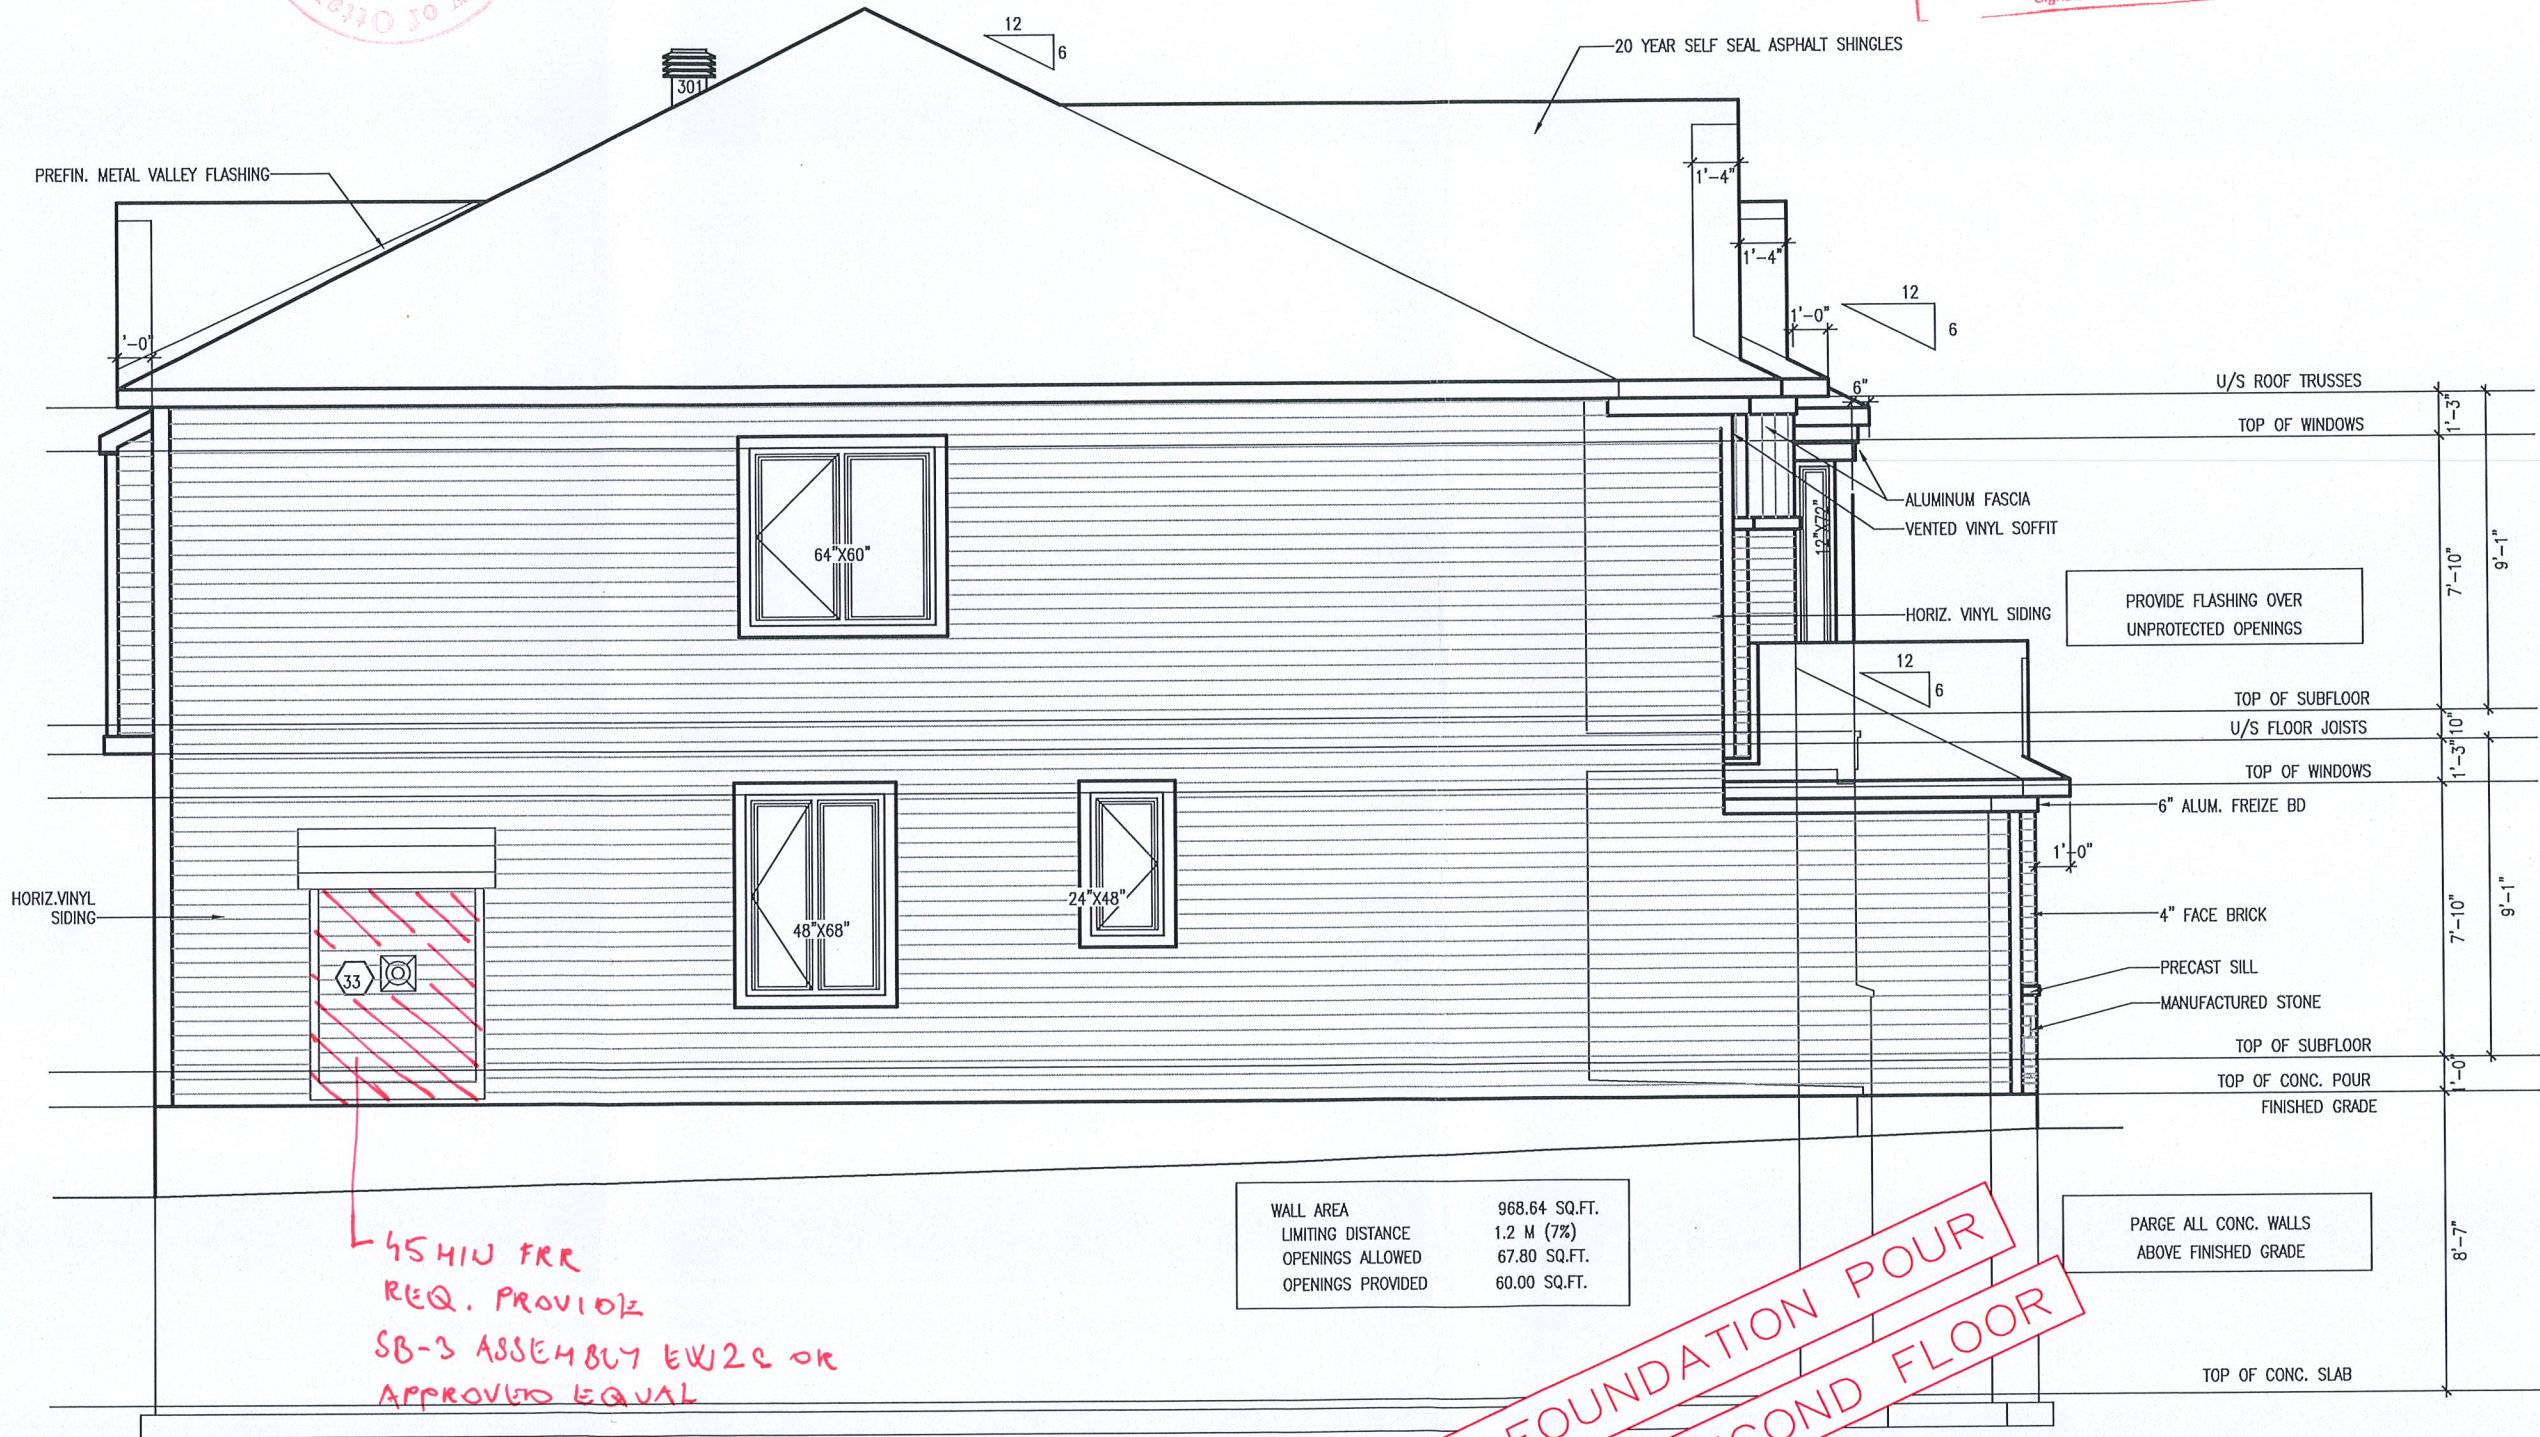

WALL AREA	968.64 SQ.FT.
LIMITING DISTANCE	1.2 M (7%)
OPENINGS ALLOWED	67.80 SQ.FT.
OPENINGS PROVIDED	60.00 SQ.FT.

45 MIN FRP
REQ. PROVIDE
SB-3 ASSEMBLY EW2C OR
APPROVED EQUAL

9' FOUNDATION POUR
9' SECOND FLOOR

LEFT SIDE ELEVATION 'F'

FOOTPRINT:	508
DRAWN BY:	S.D.
DATE:	AUG 2012
SCALE:	3/16"=1'-0"
SHEET NO:	49
D.C.L.-	100

No.	Description	dd/mm/yy	By
4	FOR ENGINEERING REVIEW	12/11/21	GK
3	FOR LAYOUTS	20/10/21	GK
2	BEP BLACKLINES REV.	05/10/21	GK
1	BEP BLACKLINES	30/09/21	GK

CHEASAPEAKE-2012-F

SITE: **DIAMONDVIEW**

LOT NUMBER: **2-49**

CIVIC ADDRESS: 1906 CESSNA PRIVATE

PHOENIX HOMES