

DCR PHOENIX HOMES


LOT #299
PATHWAYS 2
NEWINGTON
CHEF'S KITCHEN
GARAGE RIGHT

MOUNTING HEIGHT: 106

33"H UPPERS @ 18" ABOVE COUNTER
+ 18" H STACKED ABOVE + FILLER TO CEILING
C/W 1" SQAURE MOULDING BETWEEN

FRIDGE UPPER & OVEN CABINET
INCREASED TO REACH 106"H.

- CABINETS -
HARDWARE -
STANDARD WHITE INTERIOR
METAL DRAWER BOX
6 PCS - 5/8" KICK - FIN. BOTH ENDS
2 PCS - 90 DEG. CORNER MOULD
1 PCS - T-MOULD
8 PCS - FLAT MOULDING

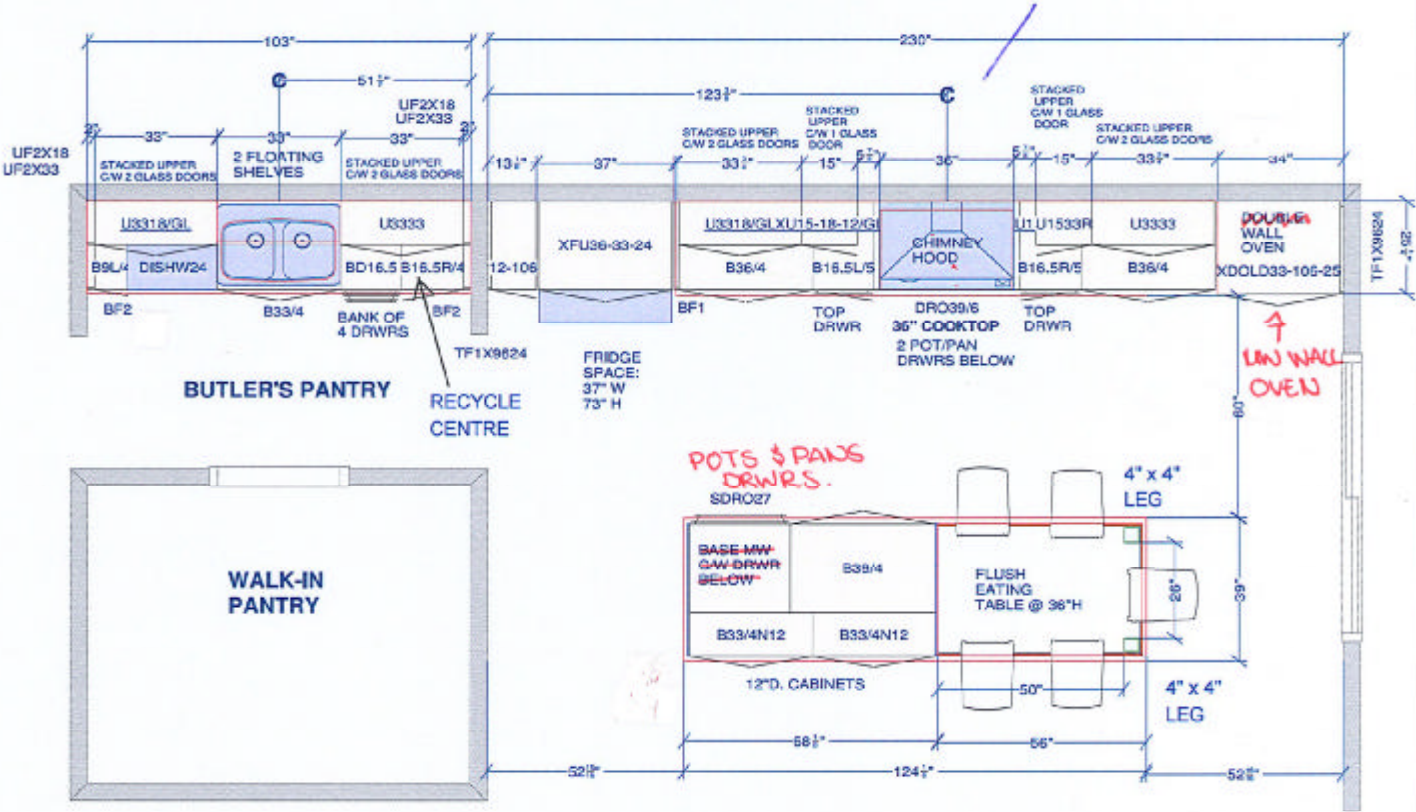

CUSTOMER APPROVAL


I have reviewed these drawings and understand the details of the design and the CARTIER KITCHENS specifications.

Signature: _____

Date: _____

All dimensions, size designations given are subject to verification on job site and adjustment to fit job conditions.		This is an original design and must not be released or copied unless applicable fee has been paid or job order placed.	Designed: 2021-07-13 Printed: 2021-07-13	
SPECTRUM KITCHEN and BATH DESIGN		DRAWN BY: LORI DISAVERIO, B.I.D		
DCR #299 Pathways 2 - Newington Chef's Kitchen.kit		All	Drawing #: 1	No Scale.

DS
caly

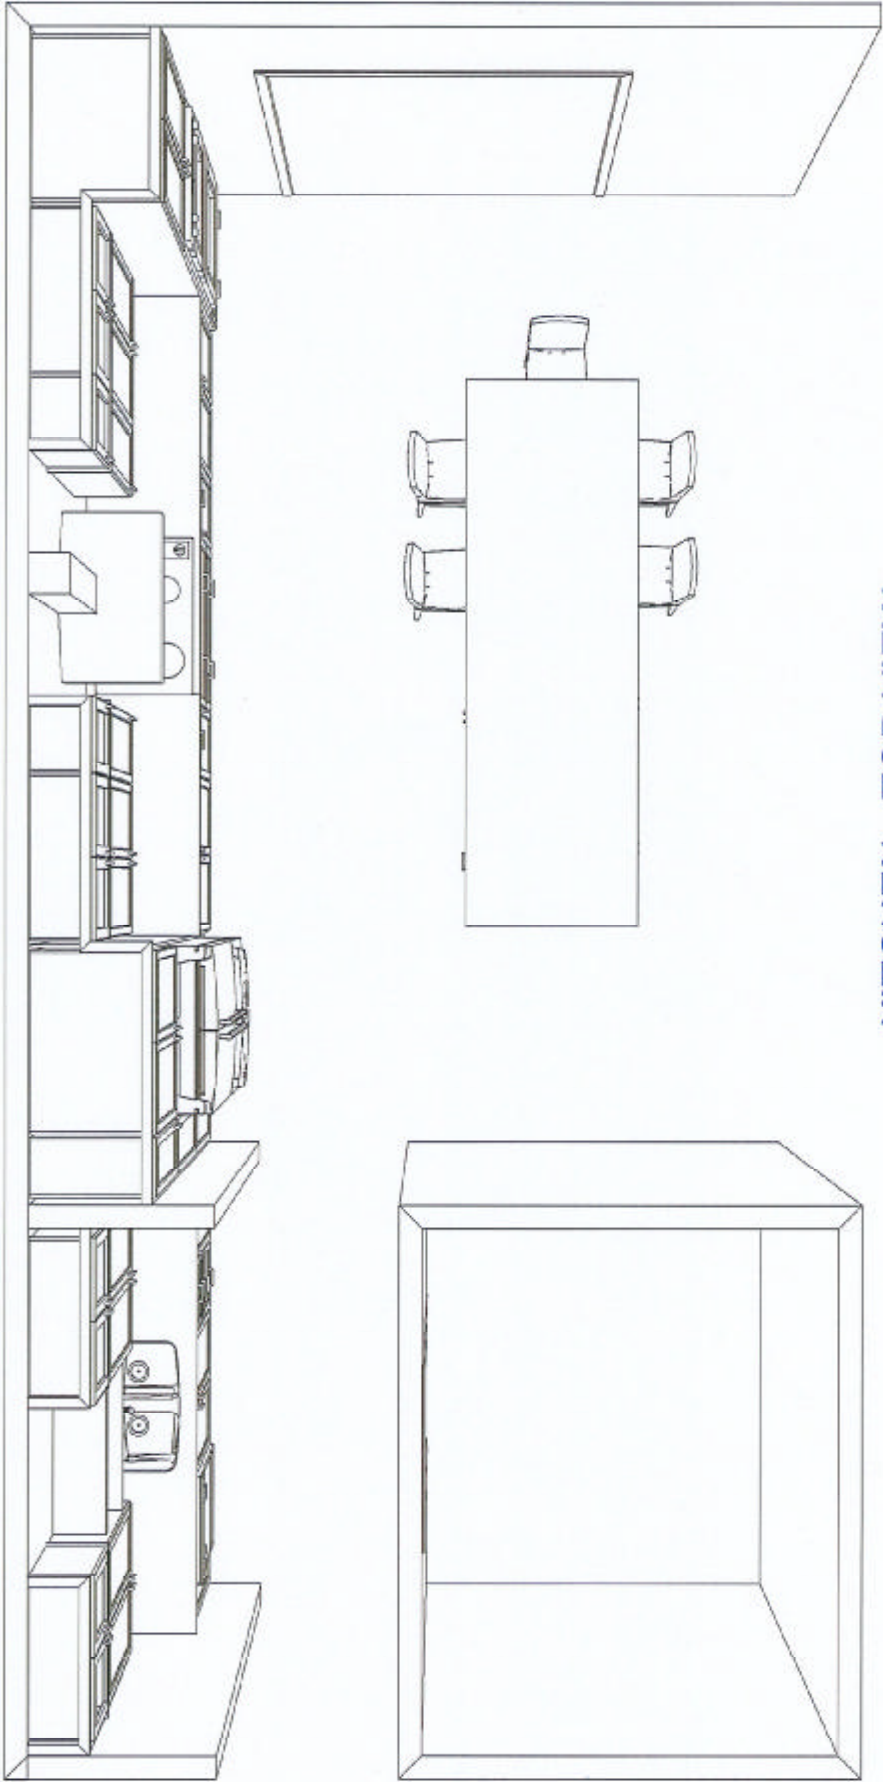

KITCHEN - TOP VIEW

CUSTOMER APPROVAL

I have reviewed these drawings and understand the details of the design and the CARTIER KITCHENS specifications.

Signature _____

Date _____

Designed: 2021-07-13
Printed: 2021-07-13




Note: This drawing is an artistic interpretation of the general appearance of the design. It is not meant to be an exact rendition.

SPECTRUM KITCHEN and BATH
DESIGN

DCR #299 Pathways 2 - Newington Chef's Kitchen.kit All

Drawing #: 1

DS
calg

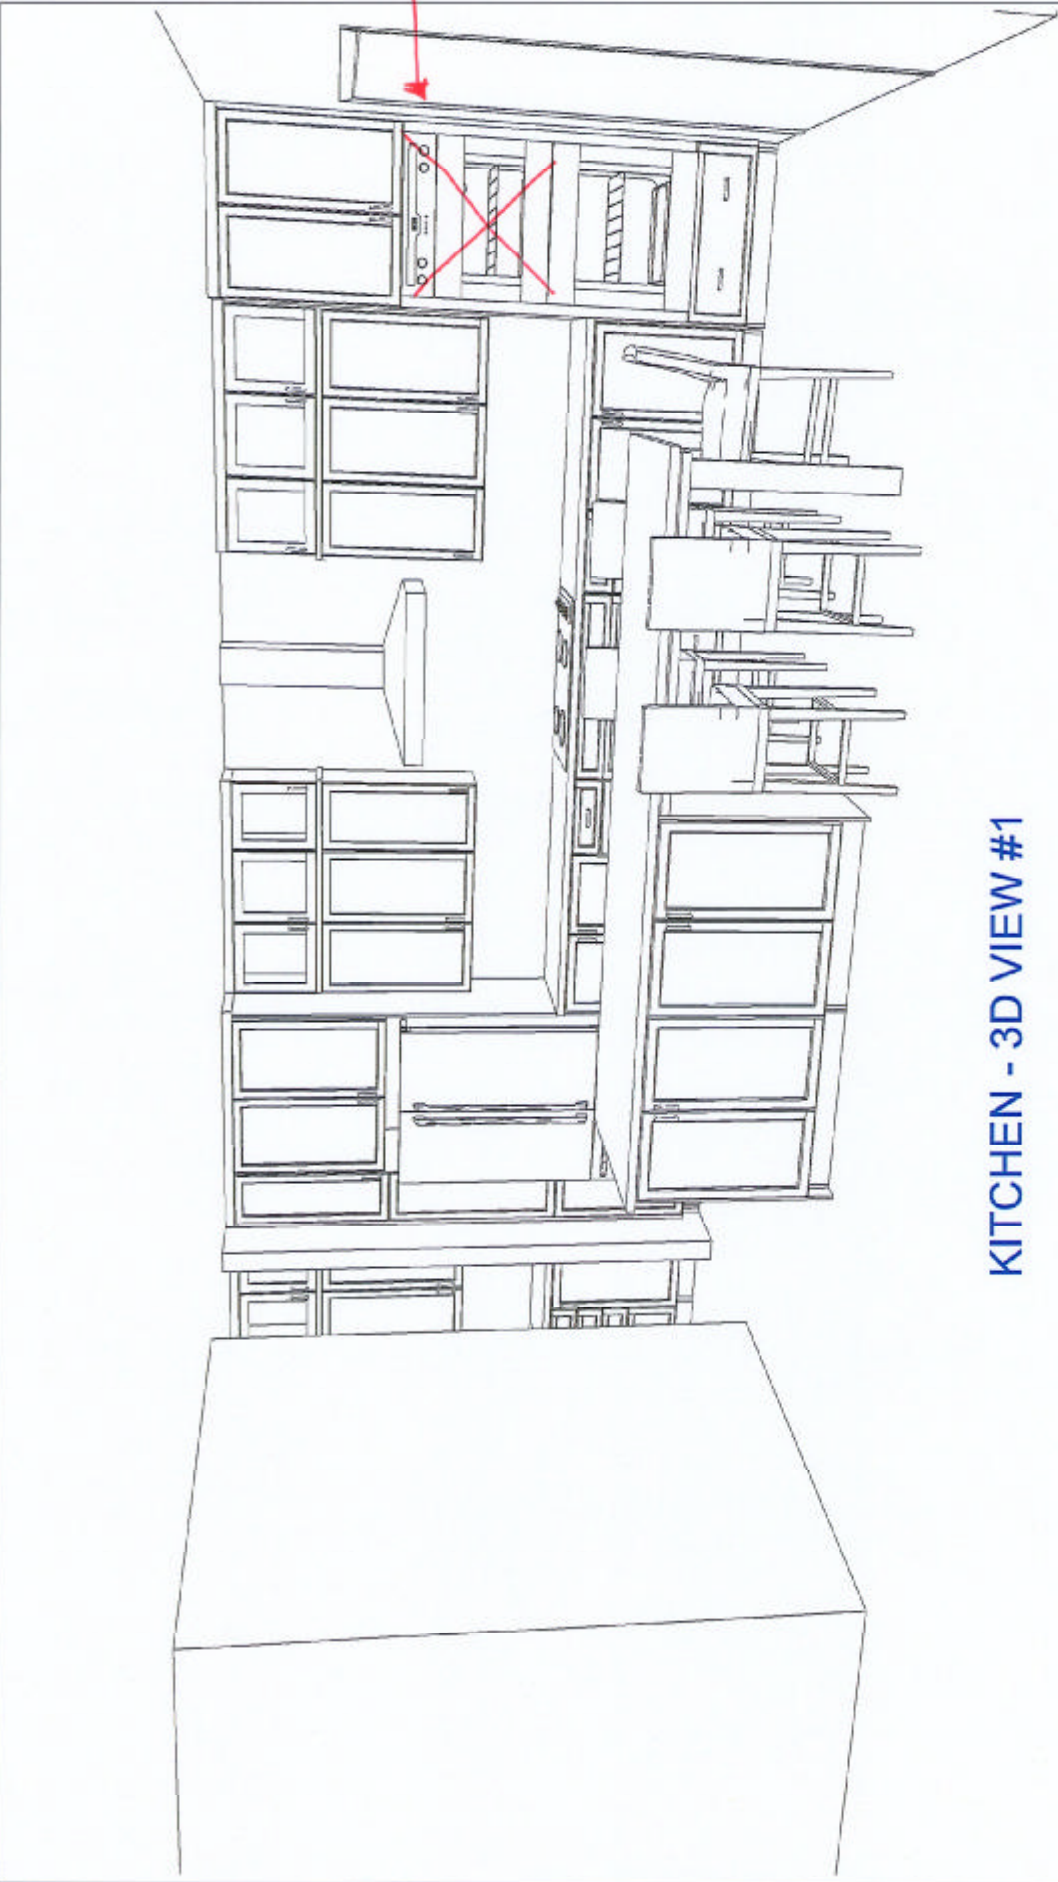

KITCHEN - 3D VIEW #1

CUSTOMER APPROVAL

I have reviewed these drawings and understand the details of the design and the CARTIER KITCHENS specifications.

Signature _____

Date _____

Designed: 2021-07-13
Printed: 2021-07-13




Note: This drawing is an artistic interpretation of the general appearance of the design. It is not meant to be an exact rendition.

SPECTRUM KITCHEN and BATH DESIGN

DCR #299 Pathways 2 - Newington Chef's Kitchen.kit | All

Drawing #: 1

DS
CALY

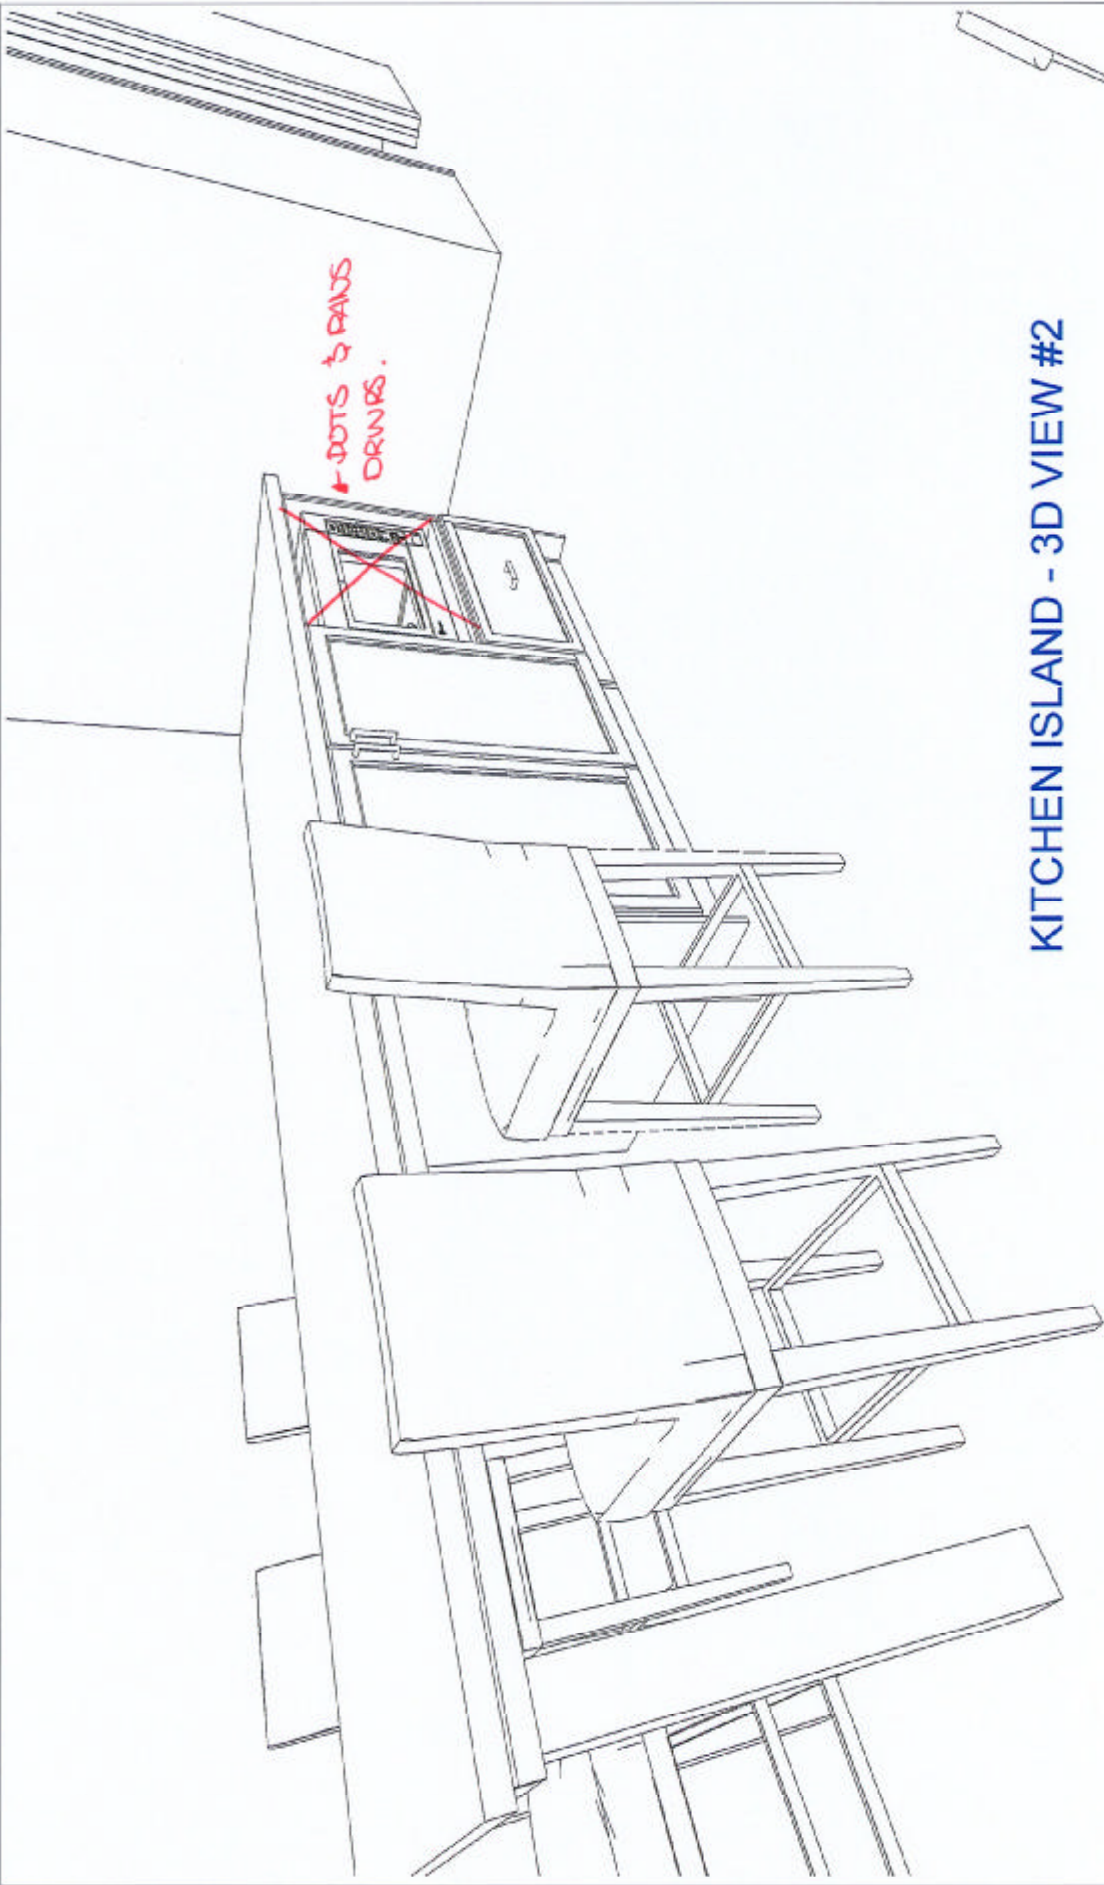

KITCHEN ISLAND - 3D VIEW #2

CUSTOMER APPROVAL

I have reviewed these drawings and understand the details of the design and the CARTIER KITCHENS specifications.

Signature _____

Date _____

Note: This drawing is an artistic interpretation of the general appearance of the design. It is not meant to be an exact rendition.

SPECTRUM KITCHEN and BATH DESIGN

DCR #299 Pathways 2 - Newington Chef's Kitchen.kit



Designed: 2021-07-13
Printed: 2021-07-13

Drawing #: 1



BUTLER'S PANTRY
3D VIEW #3

CUSTOMER APPROVAL

I have reviewed these drawings and understand the details of the design and the CARTIER KITCHENS specifications.

Signature _____

Date _____

Note: This drawing is an artistic interpretation of the general appearance of the design. It is not meant to be an exact rendition.



SPECTRUM KITCHEN and BATH DESIGN

DCR #299 Pathways 2 - Newington Chef's Kitchen.kit

All


Designed: 2021-07-13
Printed: 2021-07-13

Drawing #: 1

DS

calg

DS

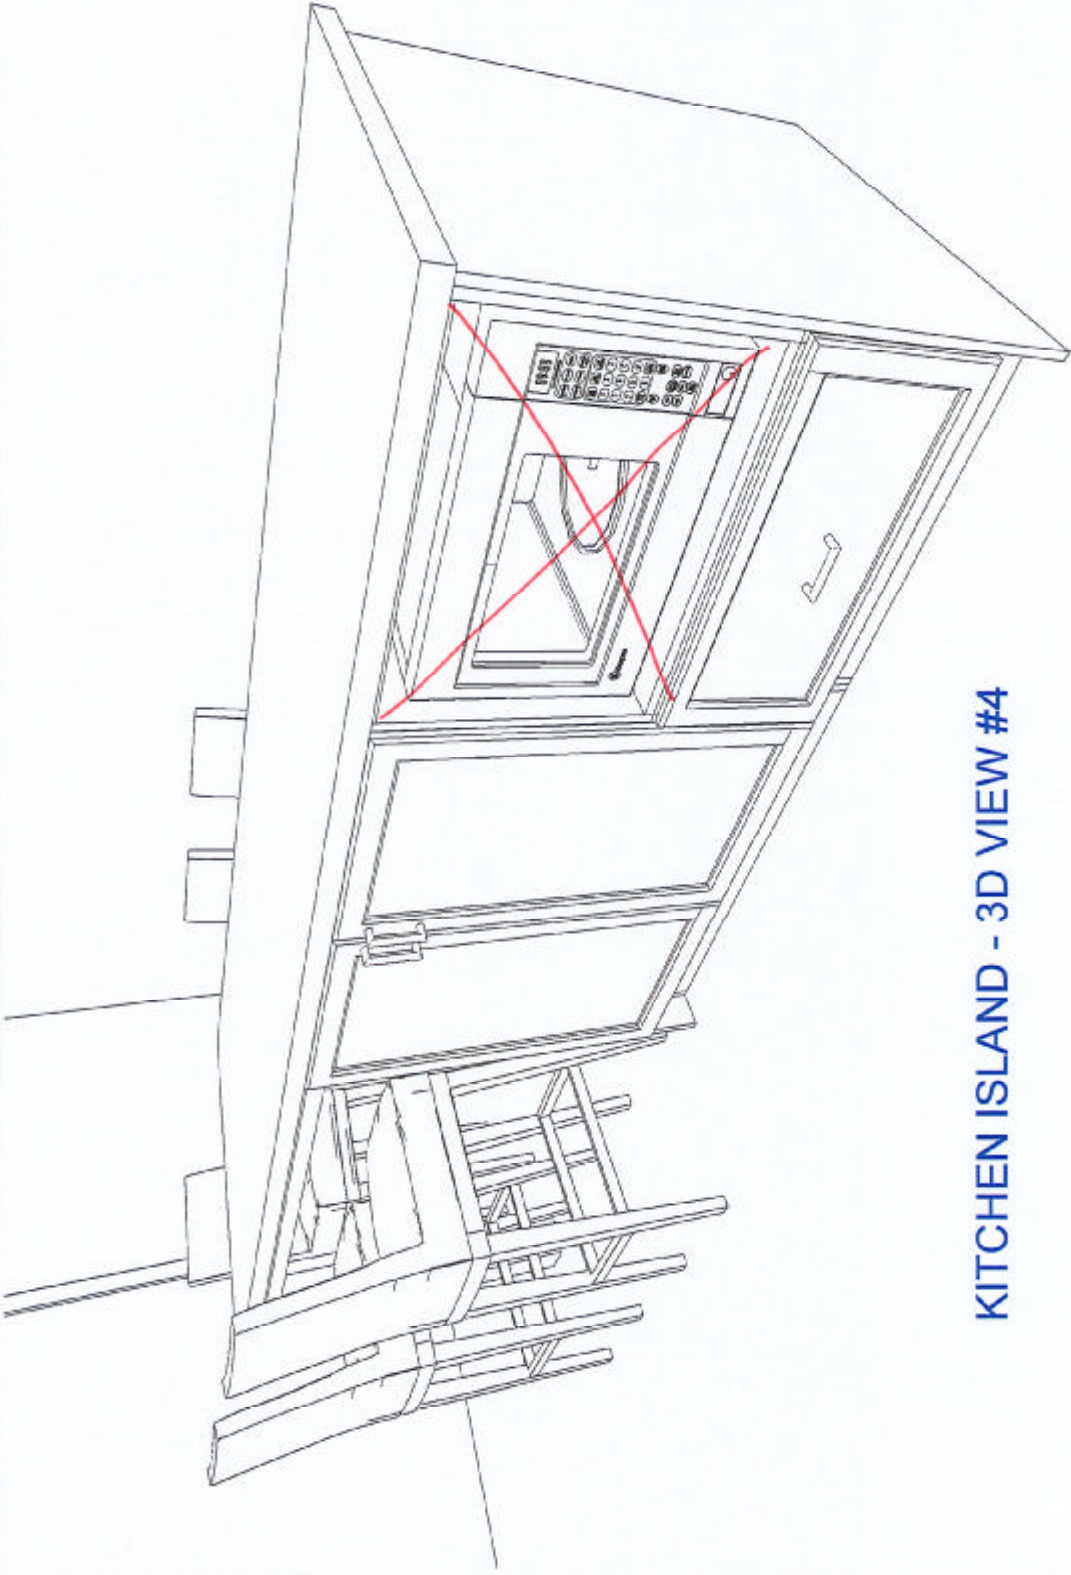

KITCHEN ISLAND - 3D VIEW #4

CUSTOMER APPROVAL

I have reviewed these drawings and understand the details of the design and the CARTIER KITCHENS specifications.

Signature _____

Date _____

Note: This drawing is an artistic interpretation of the general appearance of the design. It is not meant to be an exact rendition.


SPECTRUM KITCHEN and BATH DESIGN



DCR #299 Pathways 2 - Newington Chef's Kitchen.kit All

Designed: 2021-07-13
Printed: 2021-07-13

Drawing #: 1

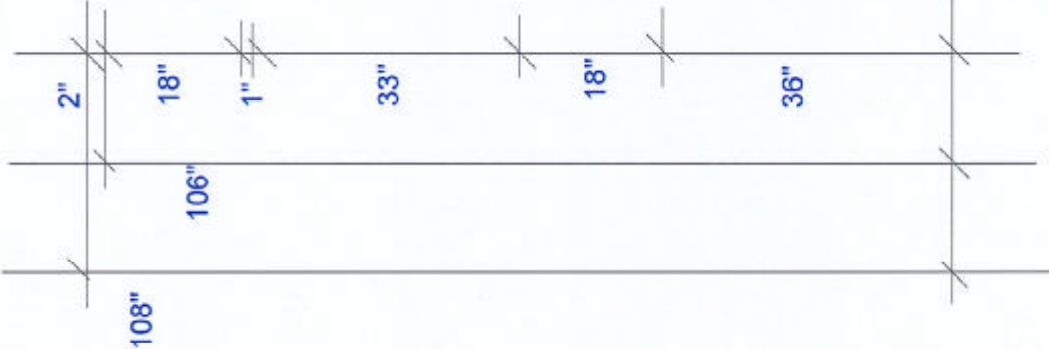

BUTLER'S PANTRY - ELEVATION

CUSTOMER APPROVAL

I have reviewed these drawings and understand the details of the design and the CARTIER KITCHENS specifications.

Signature _____

Date _____

Note: This drawing is an artistic interpretation of the general appearance of the design. It is not meant to be an exact rendition.



SPECTRUM
INTERIORS

Designed: 2021-07-13
Printed: 2021-07-13


SPECTRUM KITCHEN and BATH DESIGN
DCR #299 Pathways 2 - Newington Chef's Kitchen.kit

Drawing #: 1

DS

colly

DS

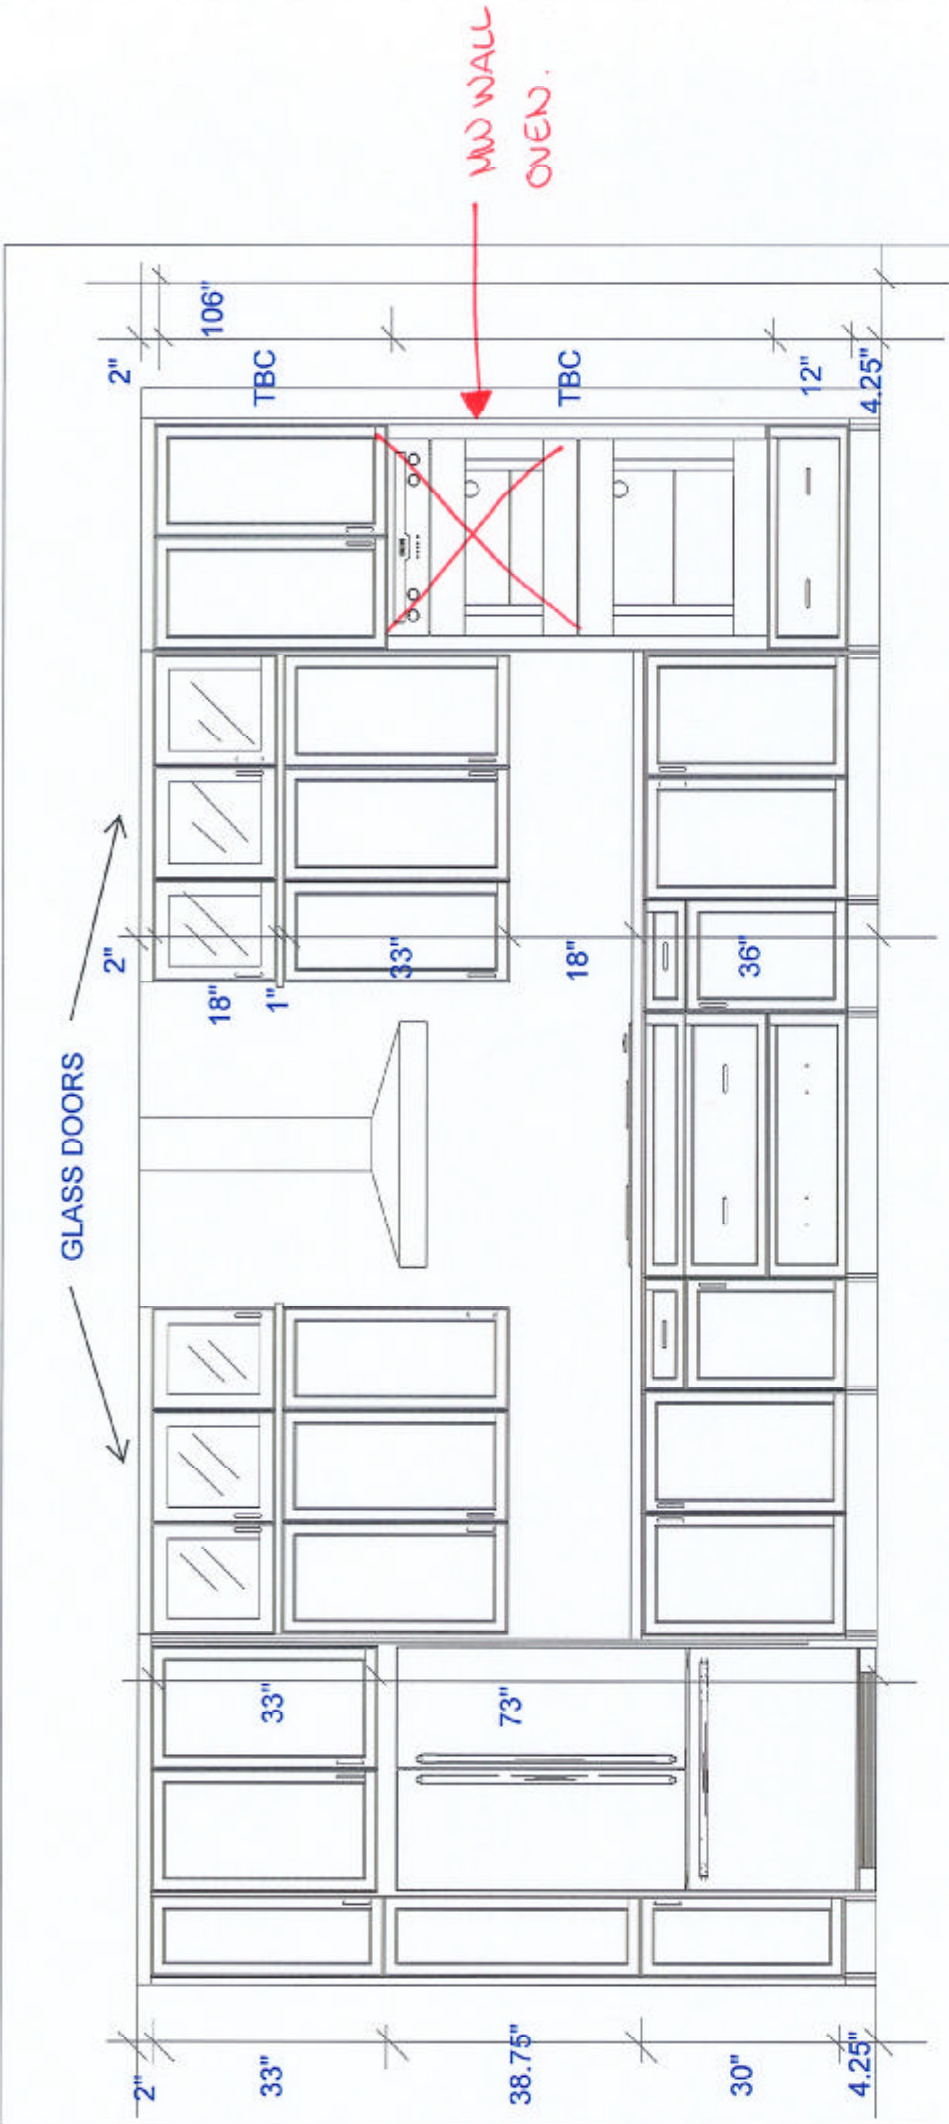

FRIDGE / COOKTOP / OVEN WALL ELEVATION

CUSTOMER APPROVAL

I have reviewed these drawings and understand the details of the design and the CARTIER KITCHENS specifications.

Signature _____

Date _____

Note: This drawing is an artistic interpretation of the general appearance of the design. It is not meant to be an exact rendition.

SPECTRUM KITCHEN and BATH DESIGN

DCR #299 Pathways 2 - Newington Chef's Kitchen.kit / All



Designed: 2021-07-13
Printed: 2021-07-13

Drawing #: 1

DS
coly