

DCR PHOENIX HOMES

LOT #311


PATHWAYS 2

520 - KLONDIKE


MAIN FLOOR KITCHEN

MOUNTING HT : 96

CABINETS -
HARDWARE -
STANDARD WHITE INTERIOR
METAL DRAWER BOX
6 PCS - 5/8" KICK - FIN. BOTH ENDS
2 PCS - 90 DEG. CORNER MOULD
1 PCS - T-MOULD
7 PCS - FLAT MOULD

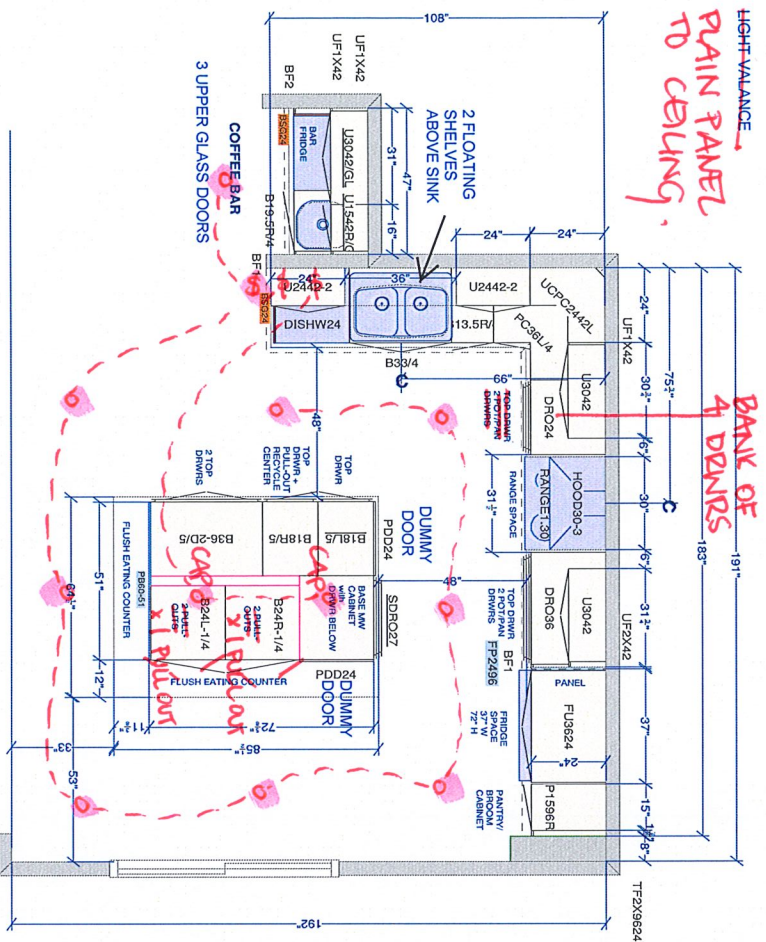


2ND FLOOR VANITIES

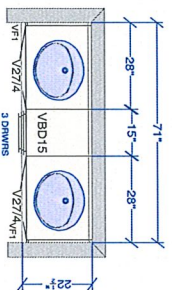


MAIN BATH

NOTE:
CABINETS MODIFIED
TO ACCOMMODATE SECOND SINK.

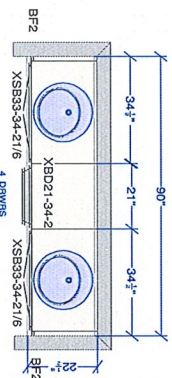


ENSUITE

NOTE:
ENSUITE RE-DESIGNED.
VANITY LENGTH INCREASED BY APPROX. 18"
VANITY HEIGHT INCREASED TO 34.5" H. + COUNTER TOP

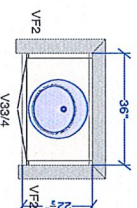

ADDED BATHROOM VANITY

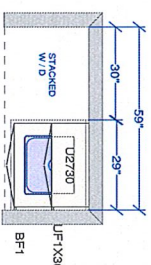

LAUNDRY ROOM
BASE CABINET,
LAMINATE COUNTERTOP,
30", UPPER CABINET

CUSTOMER APPROVAL

I have reviewed these drawings and understand the details of the design and the CARTIER KITCHENS specifications.

Signature,

All dimensions-size designations given are subject to verification on job site and adjustment to fit job conditions.



This is an original design and must not be released or copied unless applicable fee has been paid or job order placed.

DRAWN BY: LORI DISAVERIO, B.I.D


DCR #311 Pathways 2 - Klondike Main Floor Kitchen, 2nd floor vanities.kit

<p> AII </p>

Drawing #: 1	No Scale.
--------------	-----------

Designed: 2021-10-20
Printed: 2021-10-20

Printed: 2021-10-20

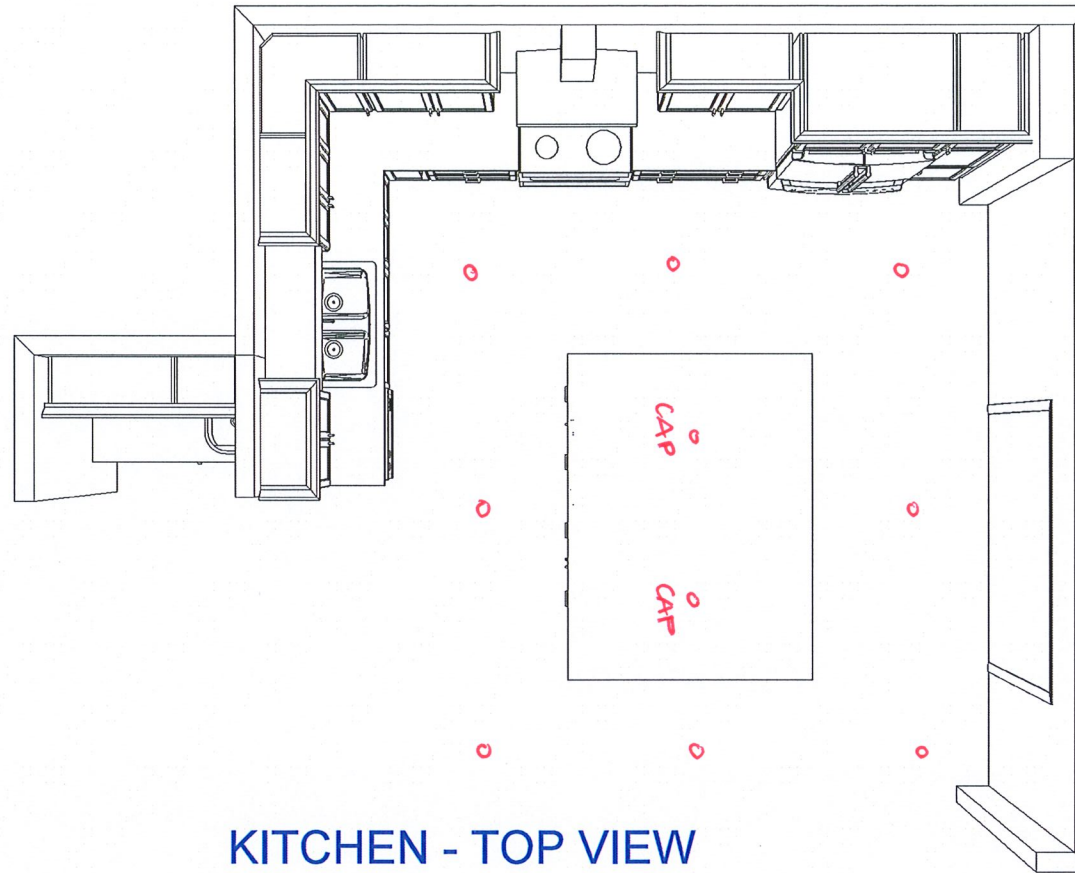

KITCHEN - TOP VIEW

CUSTOMER APPROVAL

I have reviewed these drawings and understand the details of the design and the CARTIER KITCHENS specifications.


Signature _____

Date _____

Note: This drawing is an artistic interpretation of the general appearance of the design. It is not meant to be an exact rendition.



Designed: 2021-10-19
Printed: 2021-10-19

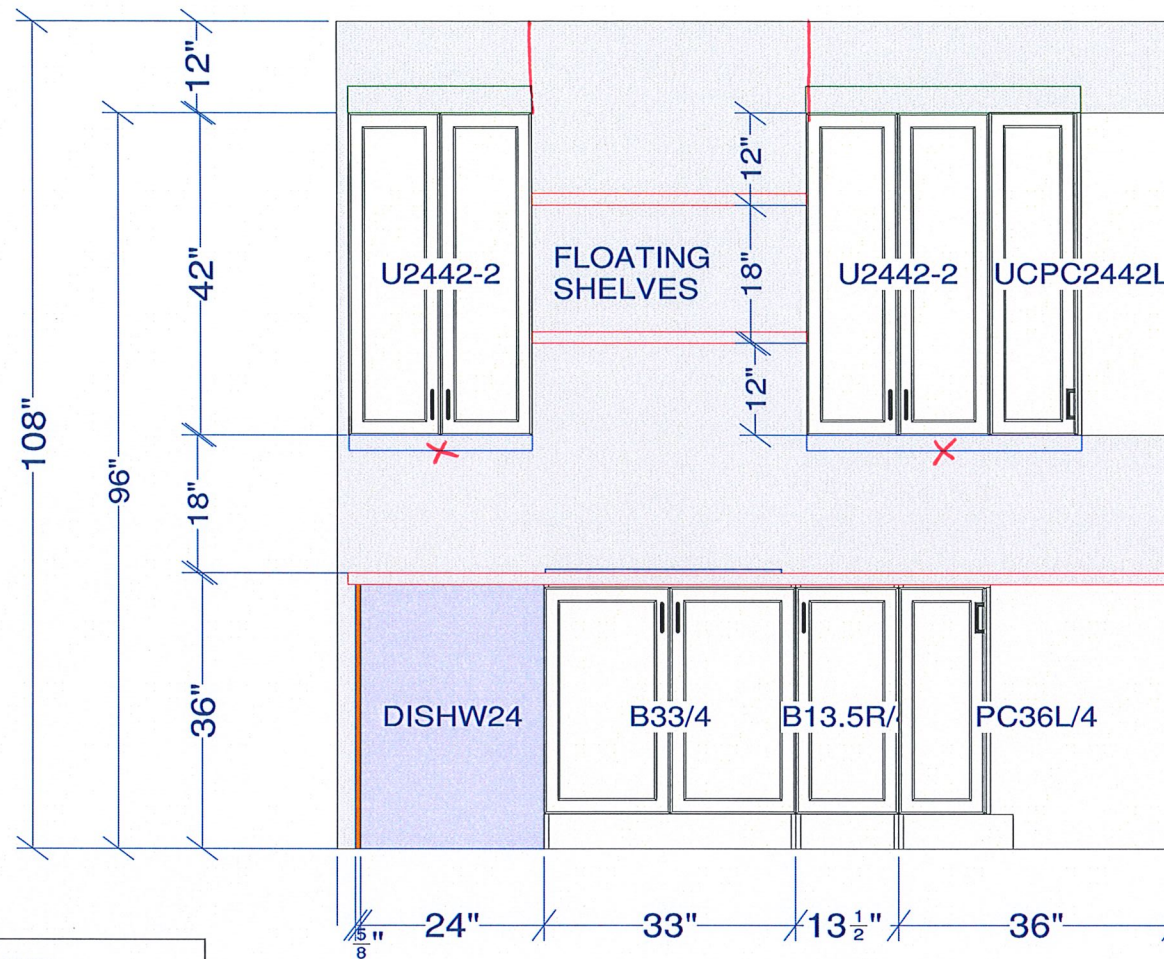

CUSTOMER APPROVAL

I have reviewed these drawings and understand the details of the design and the CARTIER KITCHENS specifications.

Signature _____

Date _____


SINK WALL ELEVATION

All dimensions size designations given are subject to verification on job site and adjustment to fit job conditions.



This is an original design and must not be released or copied unless applicable fee has been paid or job order placed.

Designed: 2021-10-19
Printed: 2021-10-19

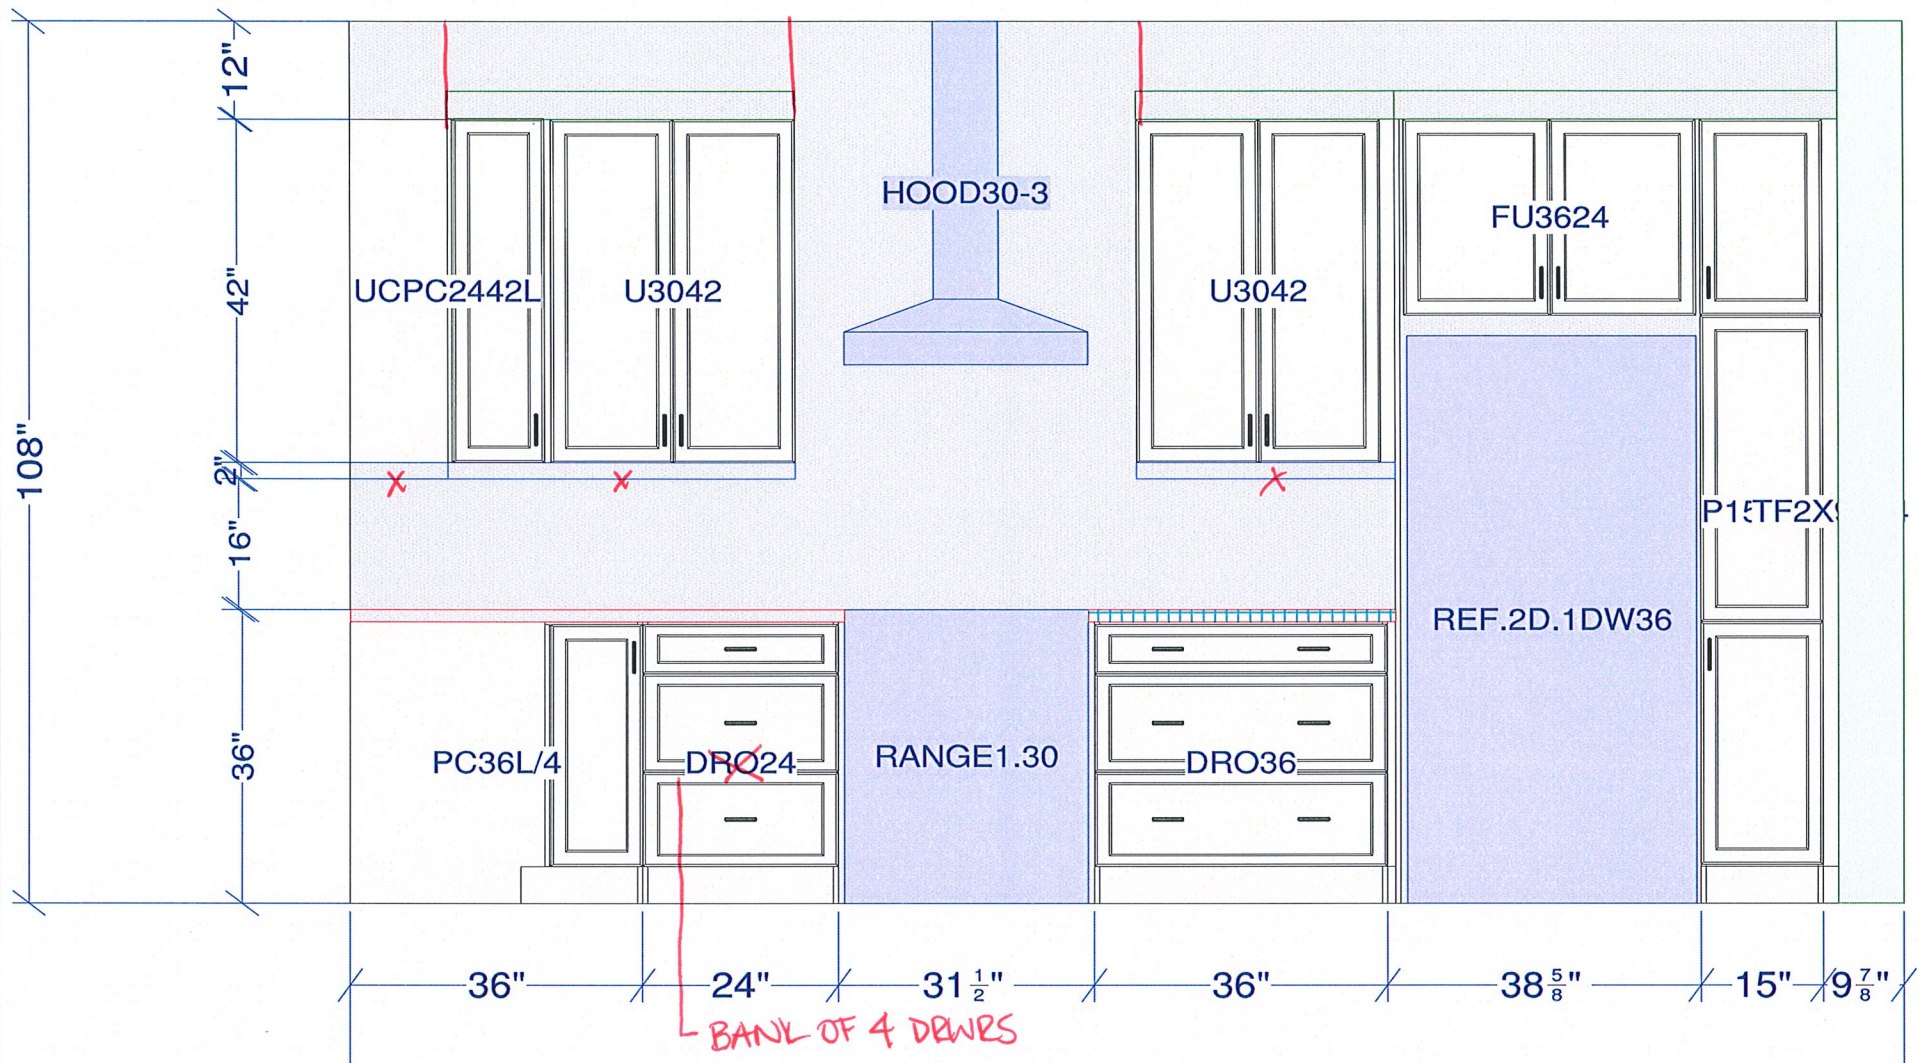

RANGE / FRIDGE WALL ELEVATION

CUSTOMER APPROVAL
 I have reviewed these drawings and understand the details of the design and the CARTIER KITCHENS specifications.

Signature _____


Date _____

All dimensions size designations given are subject to verification on job site and adjustment to fit job conditions.



This is an original design and must not be released or copied unless applicable fee has been paid or job order placed.

Designed: 2021-10-19
 Printed: 2021-10-19

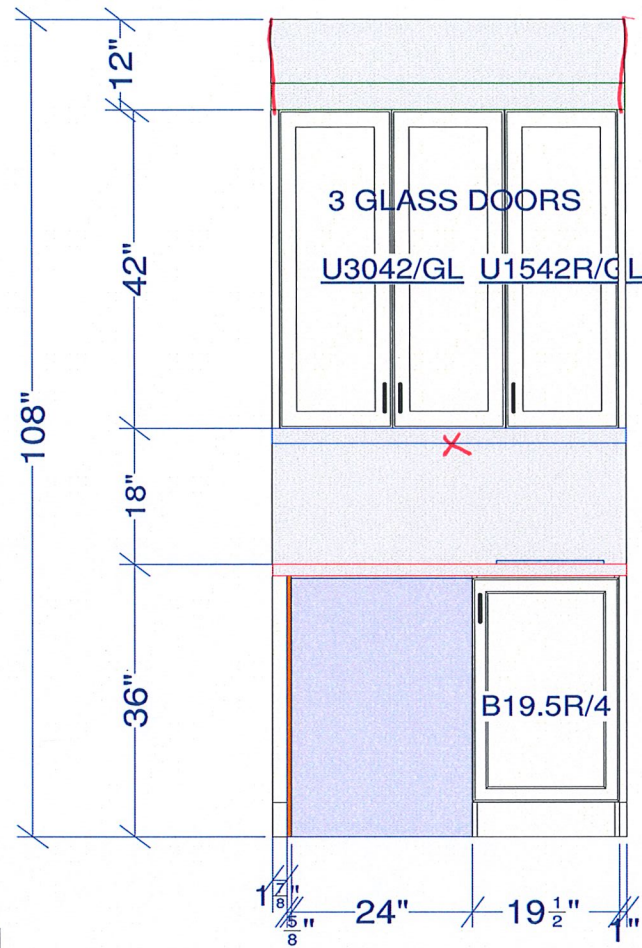

COFFEE BAR ELEVATION

CUSTOMER APPROVAL

I have reviewed these drawings and understand the details of the design and the CARTIER KITCHENS specifications.

Signature _____


Date _____

All dimensions size designations given are subject to verification on job site and adjustment to fit job conditions.



This is an original design and must not be released or copied unless applicable fee has been paid or job order placed.

Designed: 2021-10-19
Printed: 2021-10-19

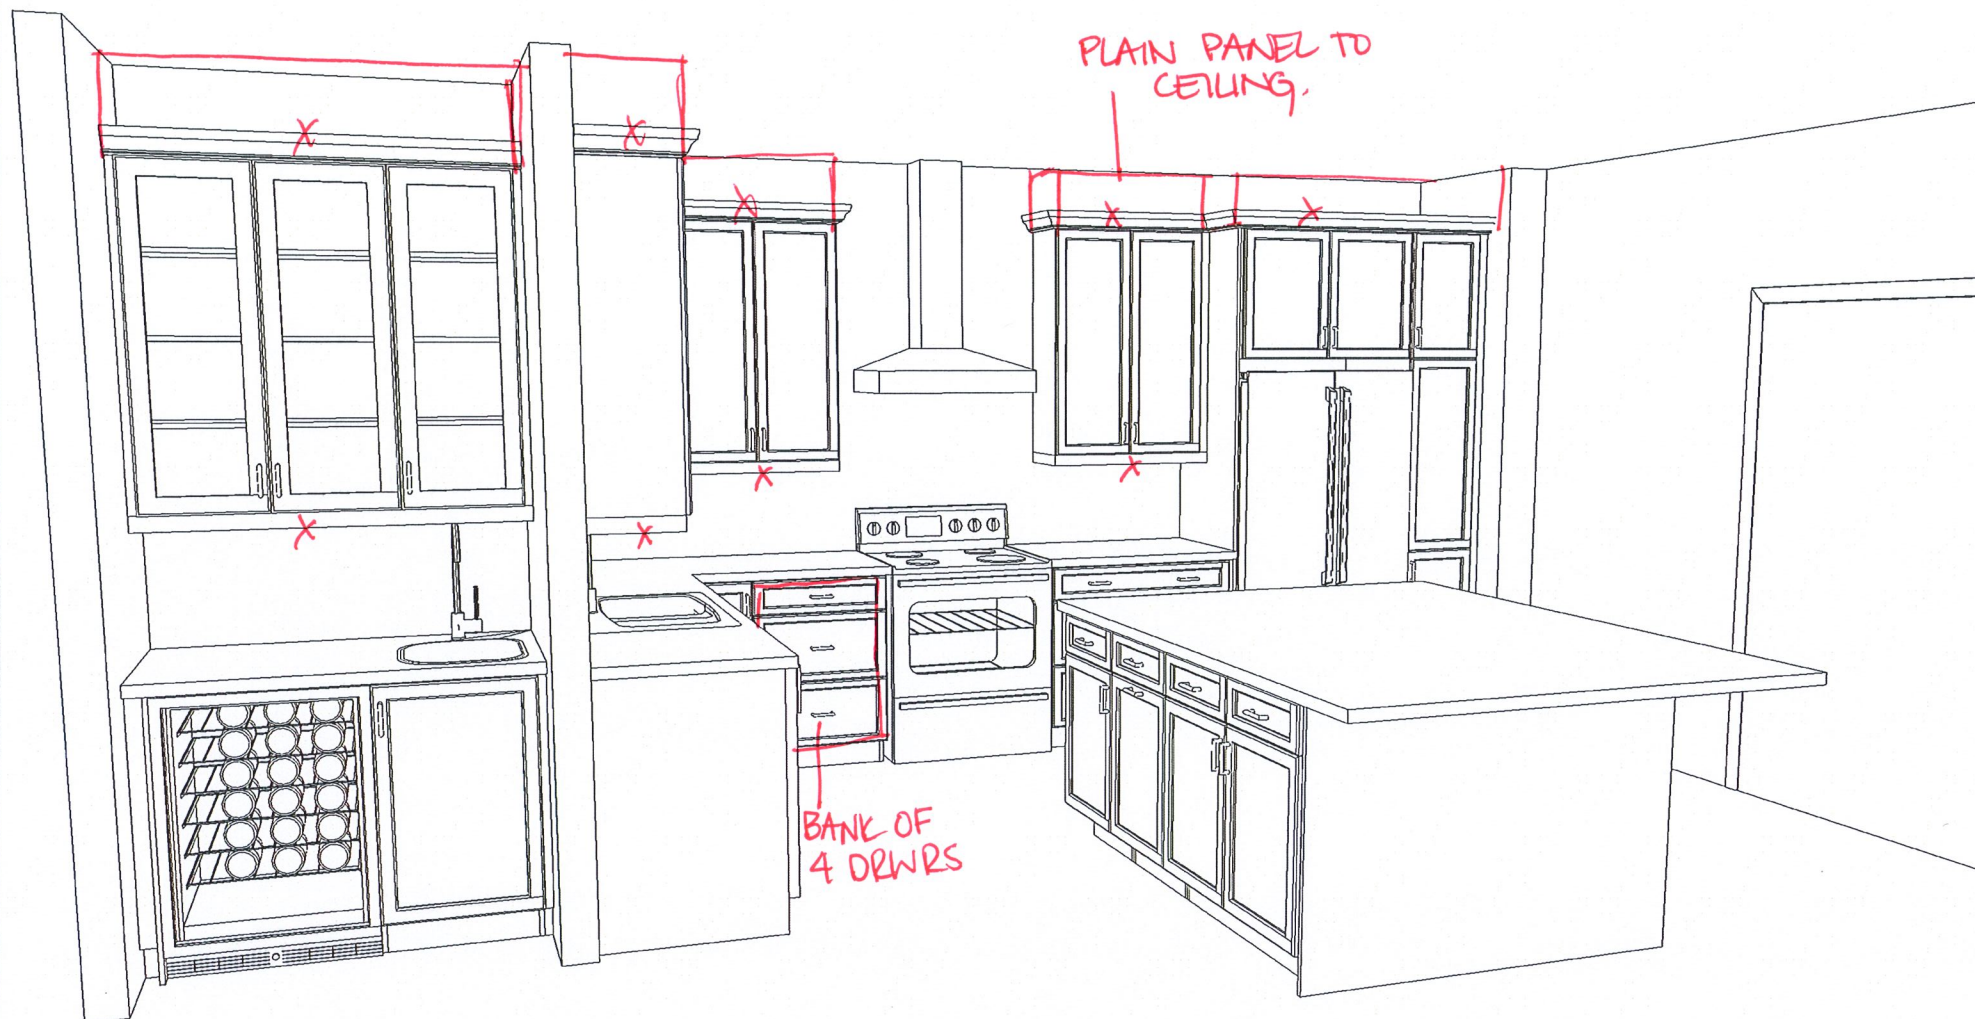

KITCHEN - 3D VIEW #1

CUSTOMER APPROVAL

I have reviewed these drawings and understand the details of the design and the CARTIER KITCHENS specifications.


Signature _____

Date _____

Note: This drawing is an artistic interpretation of the general appearance of the design. It is not meant to be an exact rendition.



Designed: 2021-10-19
Printed: 2021-10-19

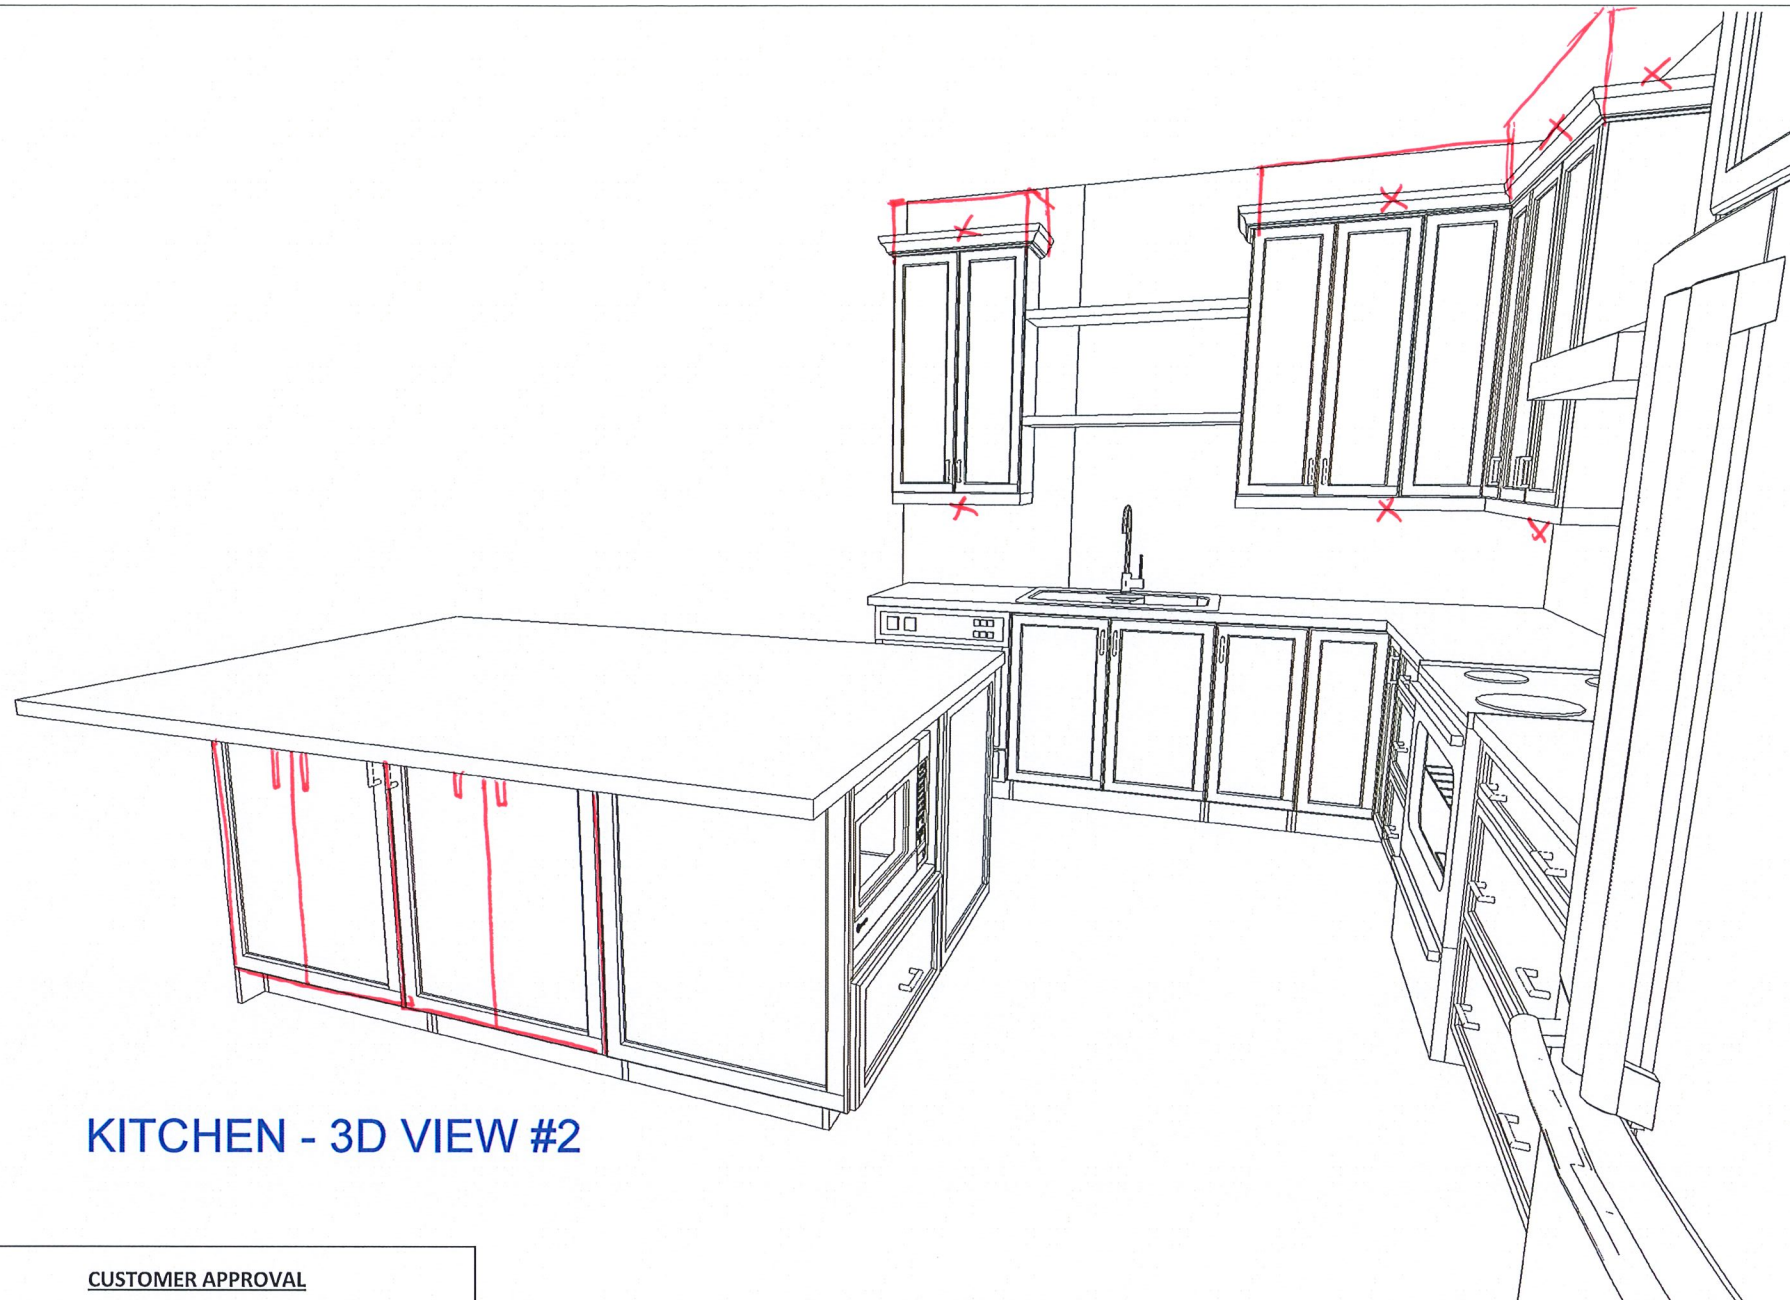

KITCHEN - 3D VIEW #2

CUSTOMER APPROVAL

I have reviewed these drawings and understand the details of the design and the CARTIER KITCHENS specifications.


Signature _____

Date _____

Note: This drawing is an artistic interpretation of the general appearance of the design. It is not meant to be an exact rendition.



Designed: 2021-10-19
Printed: 2021-10-19

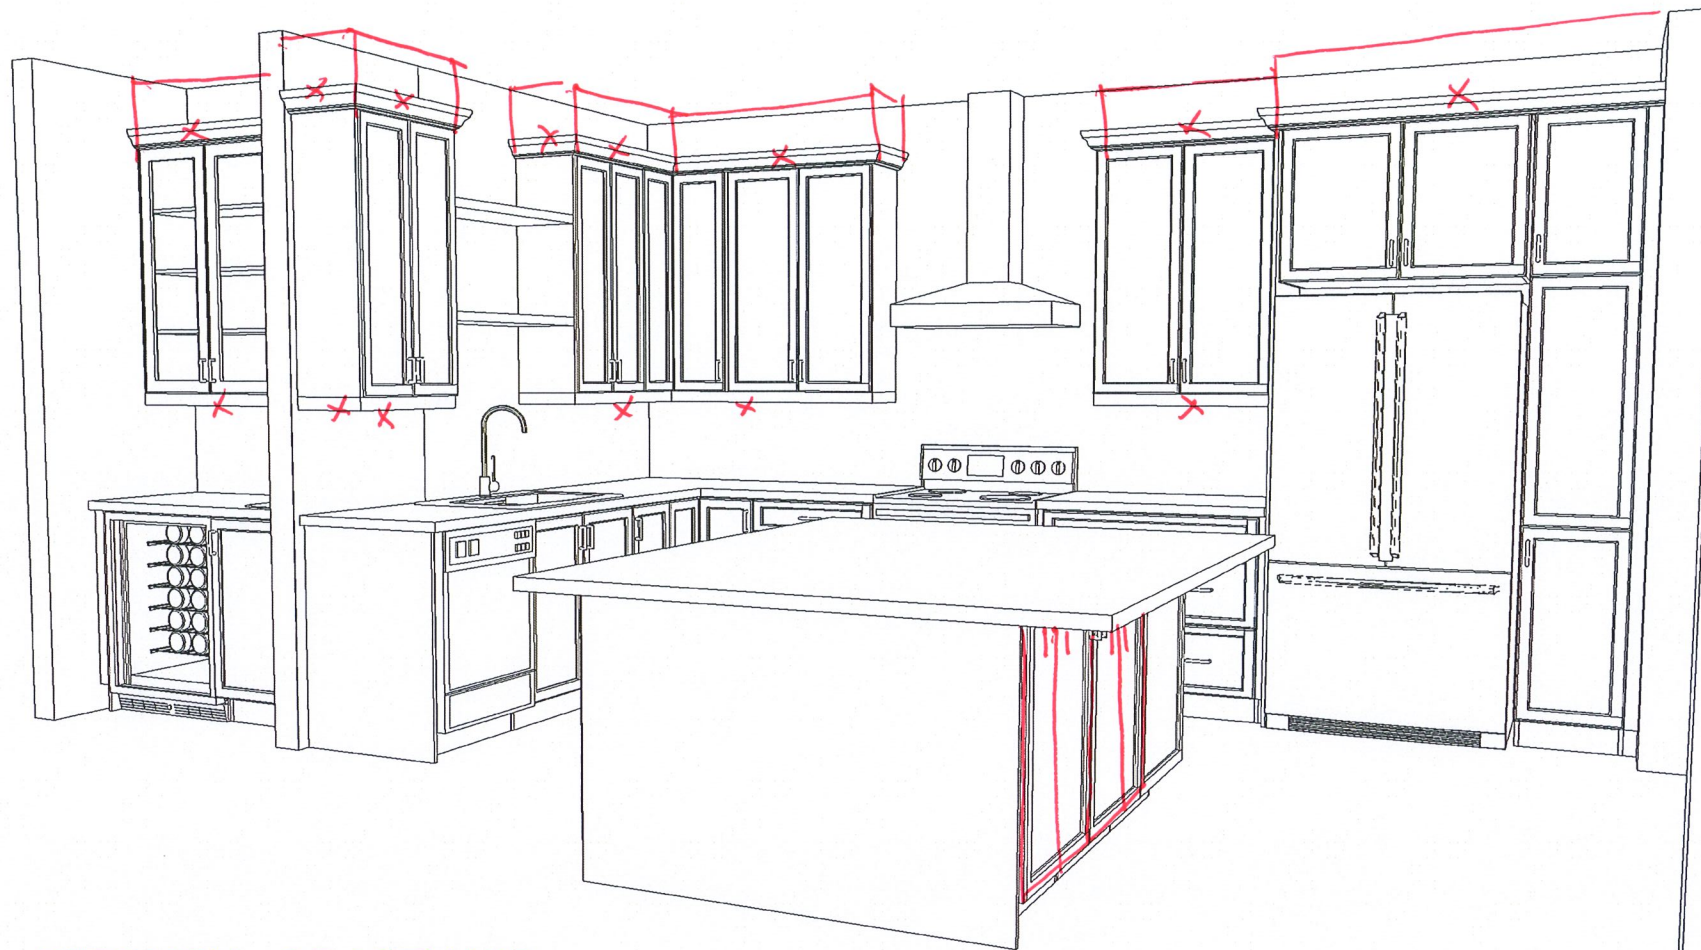

KITCHEN - 3D VIEW #3

CUSTOMER APPROVAL

I have reviewed these drawings and understand the details of the design and the CARTIER KITCHENS specifications.


Signature _____

Date _____


Note: This drawing is an artistic interpretation of the general appearance of the design. It is not meant to be an exact rendition.




Designed: 2021-10-19
Printed: 2021-10-19

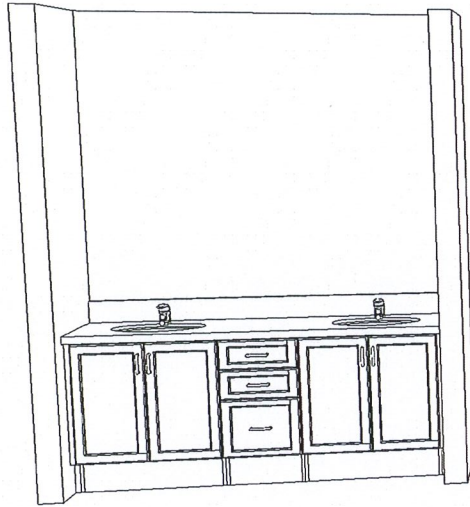


MAIN BATH VANITY

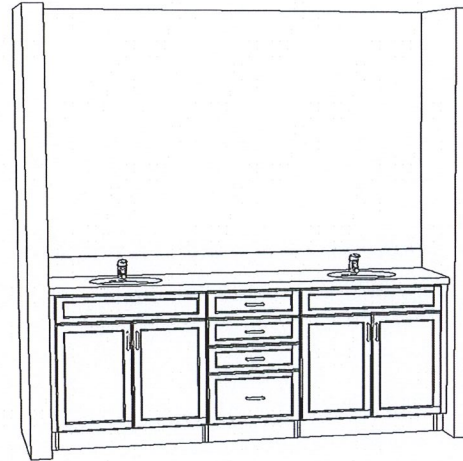

ENSUITE VANITY

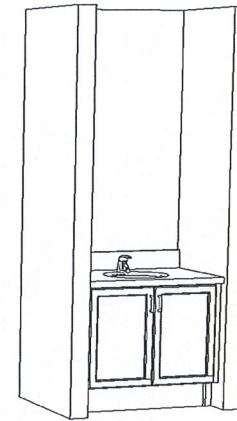

ADDED BATHROOM
VANITY

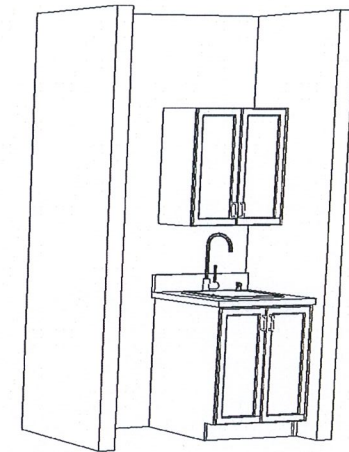

LAUNDRY
ROOM

CUSTOMER APPROVAL

I have reviewed these drawings and understand the details of the design and the CARTIER KITCHENS specifications.

Signature _____

Date _____

Note: This drawing is an artistic interpretation of the general appearance of the design. It is not meant to be an exact rendition.

SPECTRUM KITCHEN and BATH
DESIGN



Designed: 2021-10-20
Printed: 2021-10-20

DCR #311 Pathways 2 - Klondike Main Floor Kitchen, All

Drawing #: 1