


DCR PHOENIX HOMES

LOT #19
DIAMONDVIEW ESTATES 2
NEWINGTON
OPTIONAL CHEF'S KITCHEN
MOUNTING HEIGHT: 96

42"H UPPERS @ 18" ABOVE COUNTER

REGULAR 2" CROWN MOULDING → IN FRONT
OF PANEL TOP OF
CABINETS

- CABINETS -
HARDWARE - S
STANDARD WHITE INTERIOR
METAL DRAWER BOX
4 PCS - 5/8" KICK - FIN. BOTH ENDS
2 PCS - 90 DEG. CORNER MOULD
1 PCS - T-MOULD
5 PCS - FLAT MOULDING

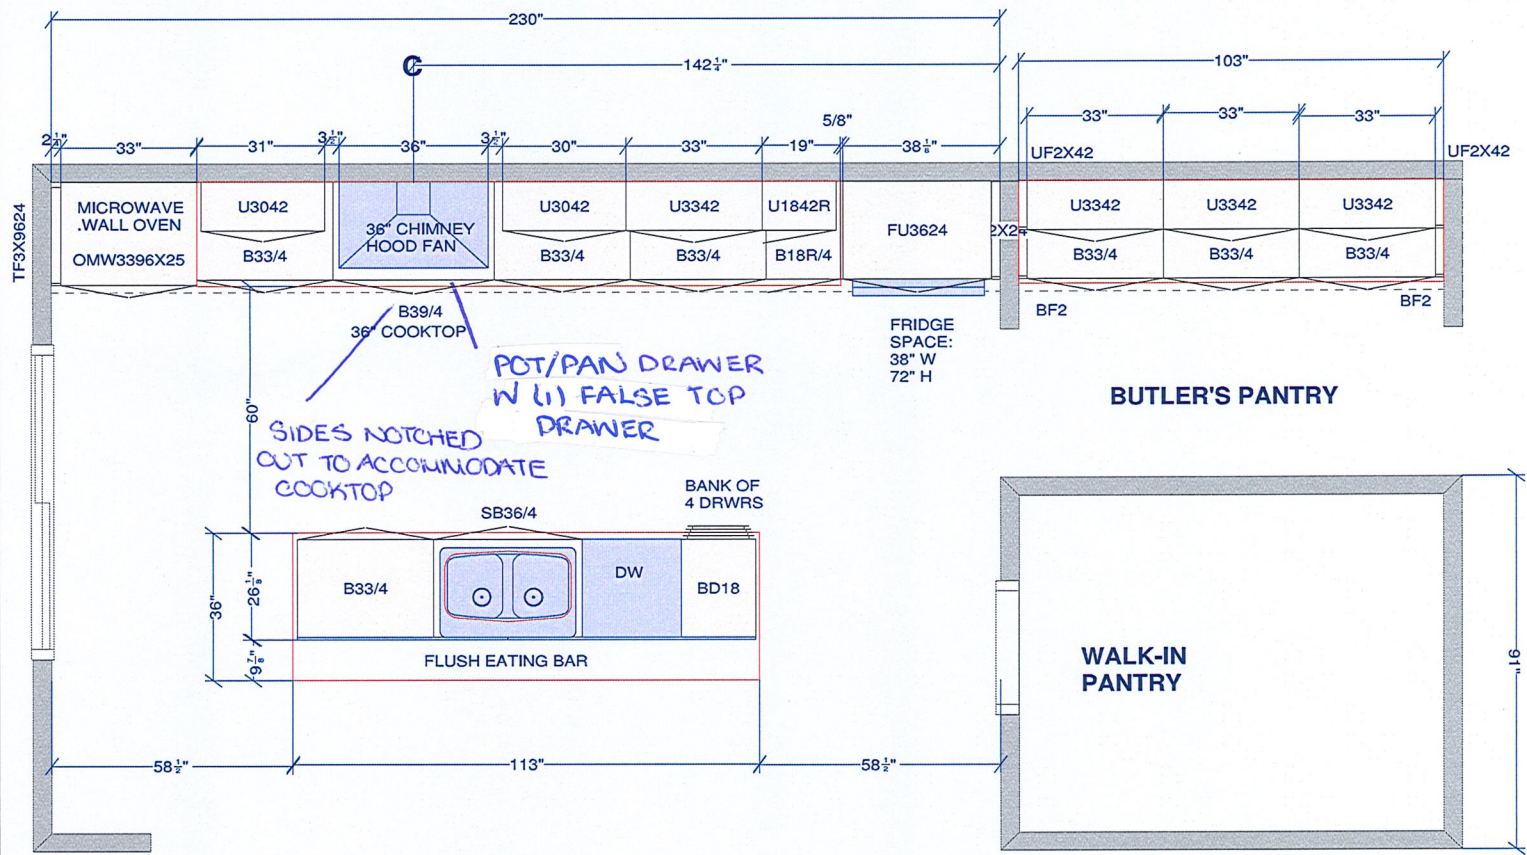

* PANEL - FILL TO CEILING RECESSED
APPROX. 1" FROM FRONT OF CABINETS

All dimensions & size designations given are subject to verification on job site and adjustment to fit job conditions.



This is an original design and must not be released or copied unless applicable fee has been paid or job order placed.

Designed: 2022-03-06
Printed: 2022-03-06