
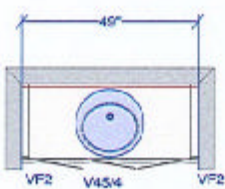



DCR PHOENIX HOMES

MODEL - STRATHMORE
ALTERNATE KITCHEN
GARAGE LEFT
KITCHEN / VANITIES
MOUNTING HEIGHT - 84


- CABINETS -
HARDWARE -
STANDARD WHITE INTERIOR
STANDARD METAL DRAWER BOX
4 PCS - 5/8" KICK - FIN. BOTH ENDS
1 PCS - 90 DEG. CORNER MOULD
1 PCS - T-MOULD
4 PCS - FLAT MOULD

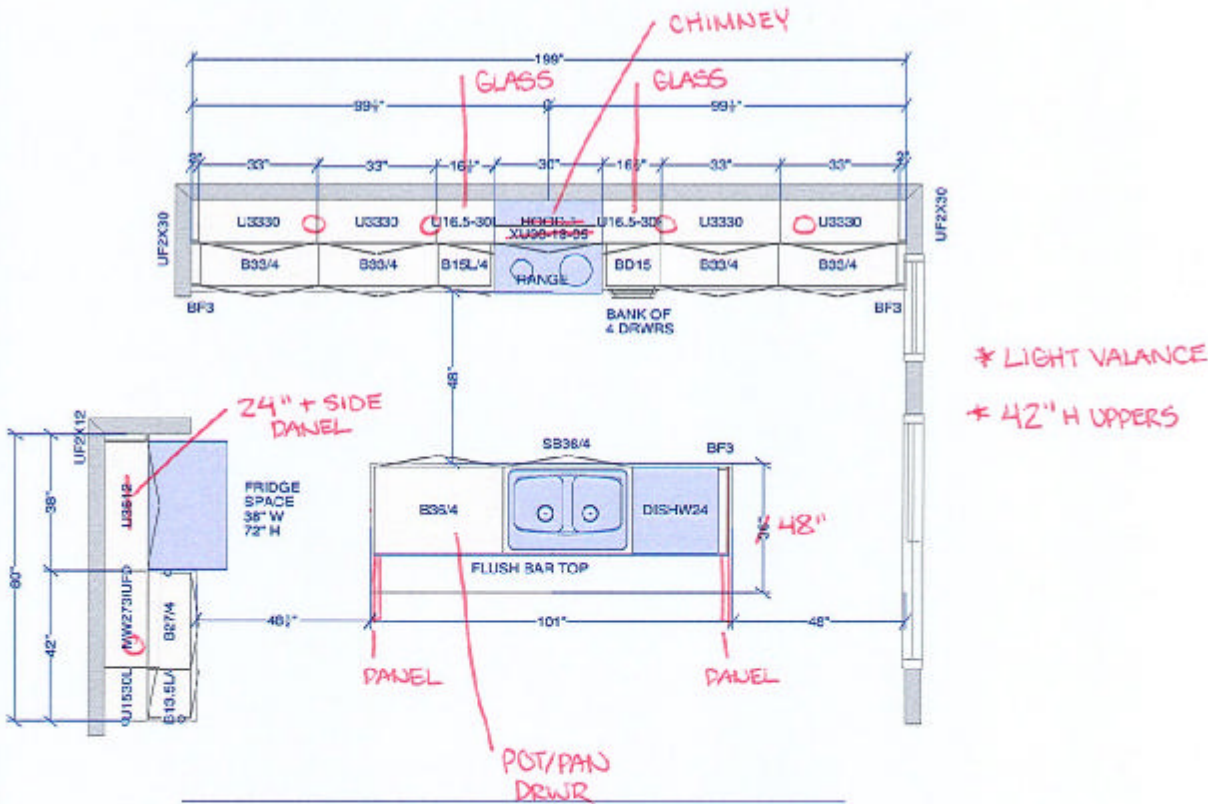

POWDER ROOM

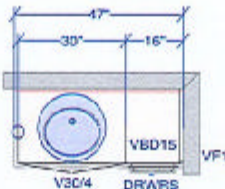

MAIN BATH

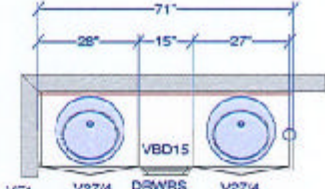

ENSUITE

SIGNATURE
I have reviewed these drawings and authorized the details of the design and the (OWNER) KITCHEN specifications.
Signature: _____
Date: _____

All dimensions ,size designations given are subject to verification on job site and adjustment to fit job conditions.

SPECTRUM KITCHEN and BATH DESIGN

DCR - STRATHMORE Alt Kitchen .(LEFT).kit




This is an original design and must not be released or copied unless applicable fee has been paid or job order placed.

DRAWN BY: LORI DISAVERIO, B.L.D

Designed: 2021-07-28
Printed: 2021-07-28

All Drawing #: 1 No Scale.

DS
M3

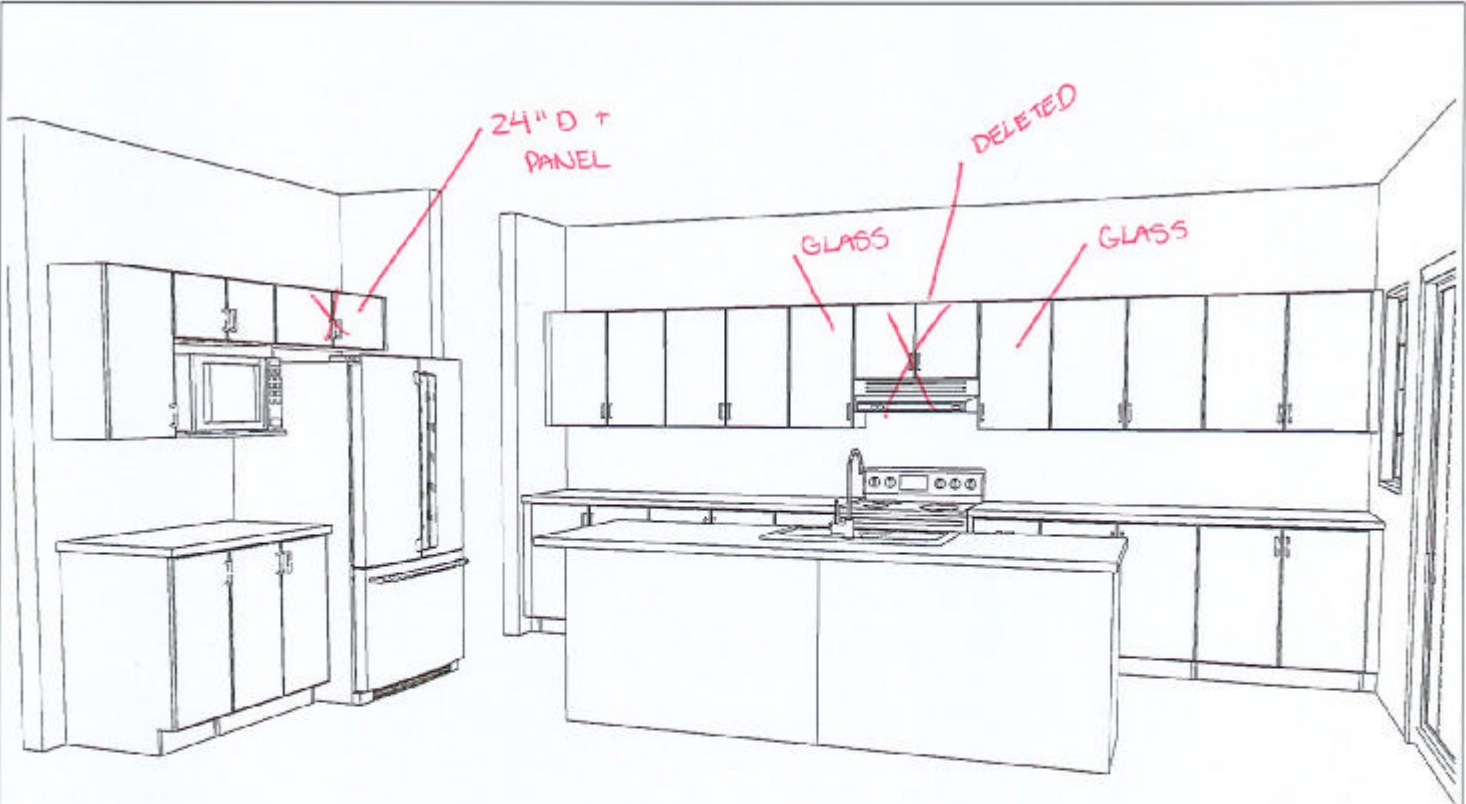


KITCHEN - 3D VIEW #1

CUSTOMER APPROVAL	
I have reviewed these drawings and understand the details of the design and the CARTIER KITCHENS specifications.	
Signature _____	
Date _____	

Note: This drawing is an artistic interpretation of the general appearance of the design. It is not meant to be an exact rendition.		Designed: 2021-07-28
		Printed: 2021-07-28
SPECTRUM KITCHEN and BATH DESIGN		
DCR - STRATHMORE Alt Kitchen (LEFT).kit	All	Drawing #: 1

DS

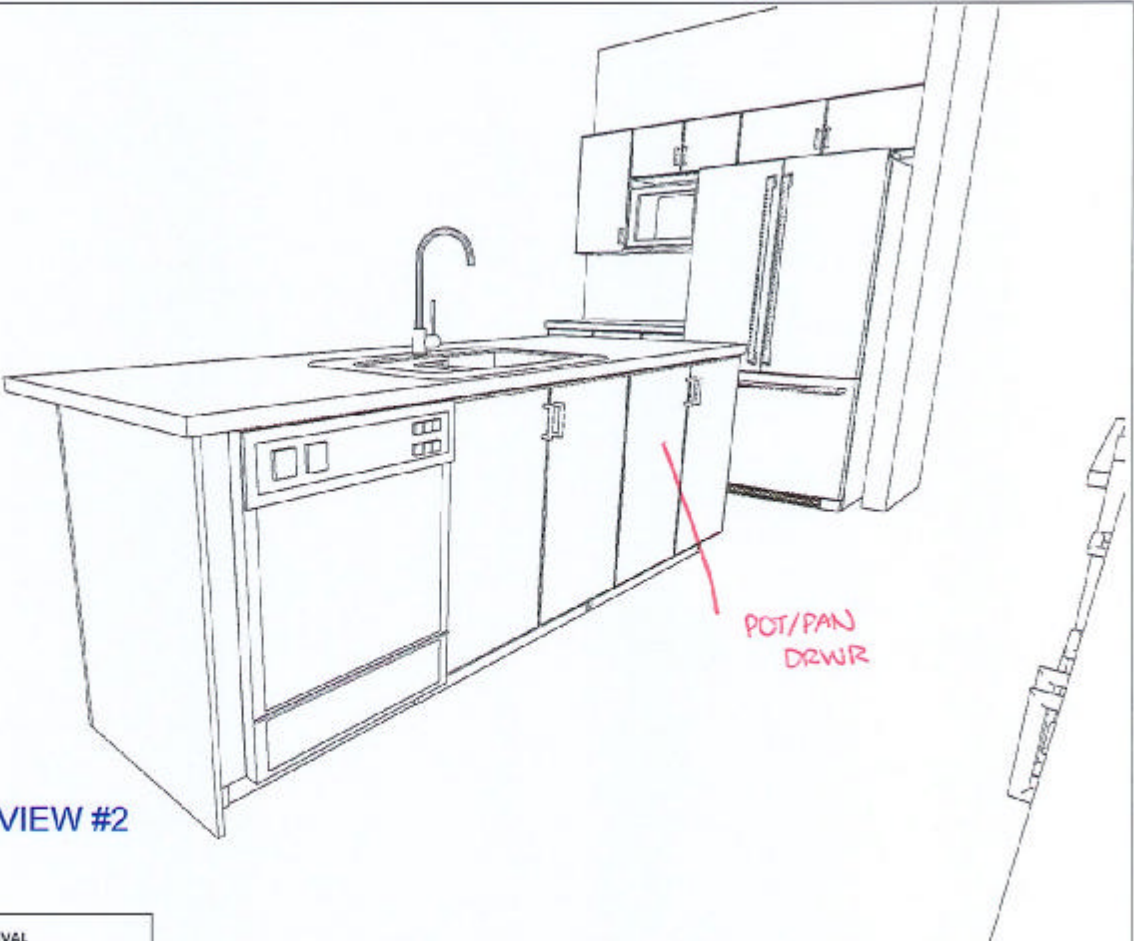



KITCHEN - 3D VIEW #2

CUSTOMER APPROVAL	
I have reviewed these drawings and understand the details of the design and the CANTIER KITCHENS specifications.	
Signature _____	
Date _____	

Note: This drawing is an artistic interpretation of the general appearance of the design. It is not meant to be an exact rendition. SPECTRUM KITCHEN and BATH DESIGN DCR - STRATHMORE Alt Kitchen .(LEFT).kit		Designed: 2021-07-28
		Printed: 2021-07-28
All		Drawing #: 1

^{DS}

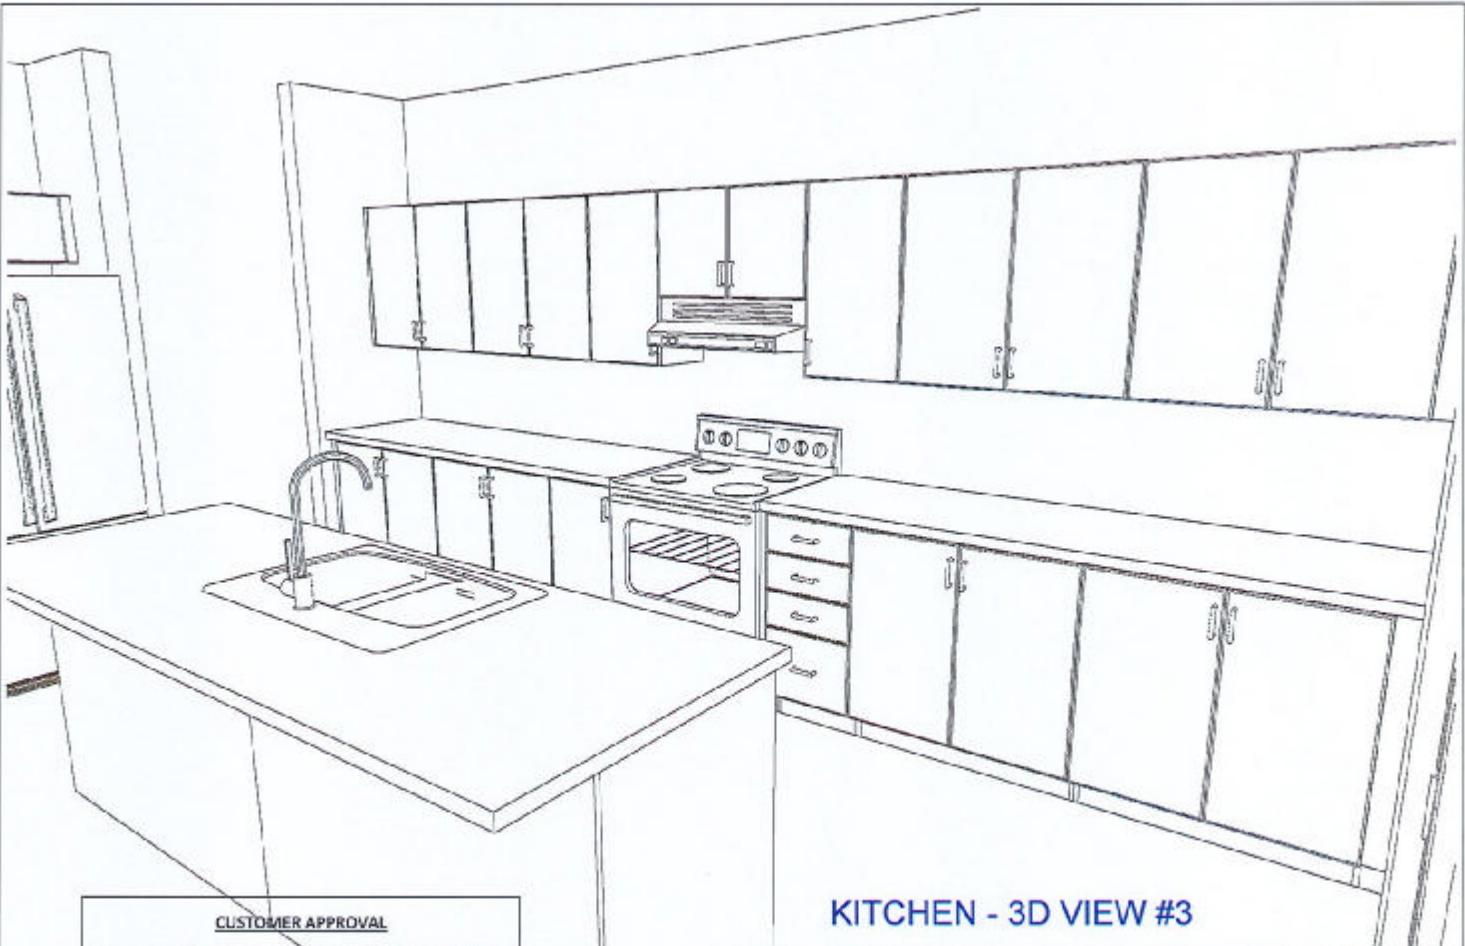KITCHEN - 3D VIEW #3

CUSTOMER APPROVAL	
I have reviewed these drawings and understand the details of the design and the CARTIER KITCHENS specifications.	
Signature _____	
Date _____	

Note: This drawing is an artistic interpretation of the general appearance of the design. It is not meant to be an exact rendition.

SPECTRUM KITCHEN and BATH
DESIGN


DCR - STRATHMORE Alt Kitchen (LEFT).kit




Designed: 2021-07-28
Printed: 2021-07-28

All	Drawing #: 1
-----	--------------


DS
M3

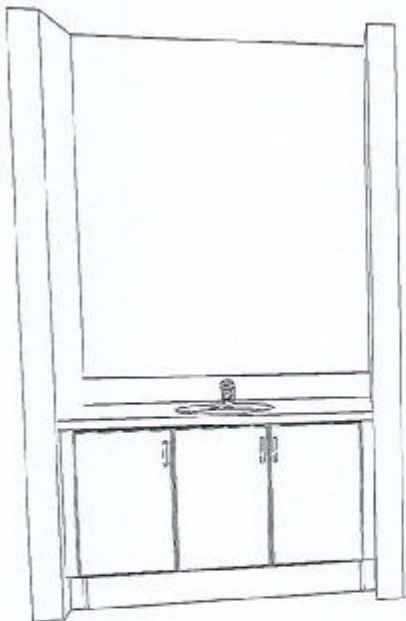

POWDER ROOM

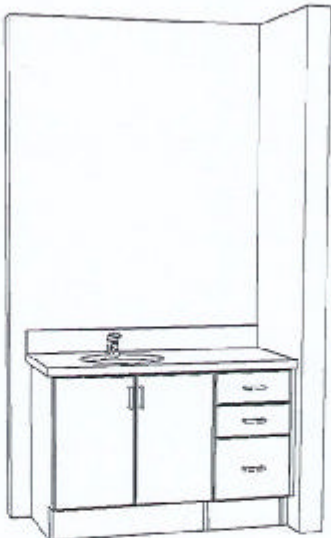

MAIN BATH

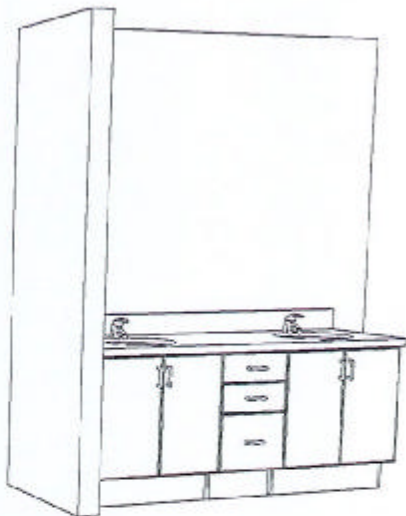

ENSUITE

CUSTOMER APPROVAL

I have reviewed these drawings and understand the details of the design and the CARTIER KITCHENS specifications.

Signature _____

Date _____

Note: This drawing is an artistic interpretation of the general appearance of the design. It is not meant to be an exact rendition.

SPECTRUM KITCHEN and BATH DESIGN

DCR - STRATHMORE Alt Kitchen (LEFT).kit



Designed: 2021-07-28
Printed: 2021-07-28

All

Drawing #: 1

DS
M3