

# DCR PHOENIX HOMES

## DIAMONDVIEW ESTATES 2

LOT #18

MODEL - ANNAPOLIS (509)

### KITCHEN

MOUNTING HEIGHT - 96

CABINETS -

HARDWARE -

STANDARD WHITE INTERIOR

METAL DRAWER BOX

4 PCS - 5/8" KICK - FIN. BOTH ENDS


2 PCS - 90 DEG. CORNER MOULD

1 PCS - T-MOULD

5 PCS - FLAT SHOW MOULDING

~~42" H UPPERS @ 18" ABOVE COUNTER~~ STANDARD 30" HIGH CABINETS

~~LIGHT VALLANCE / CROWN MOULDING~~ NO LIGHT VALLANCE OR CROWN MOULDING

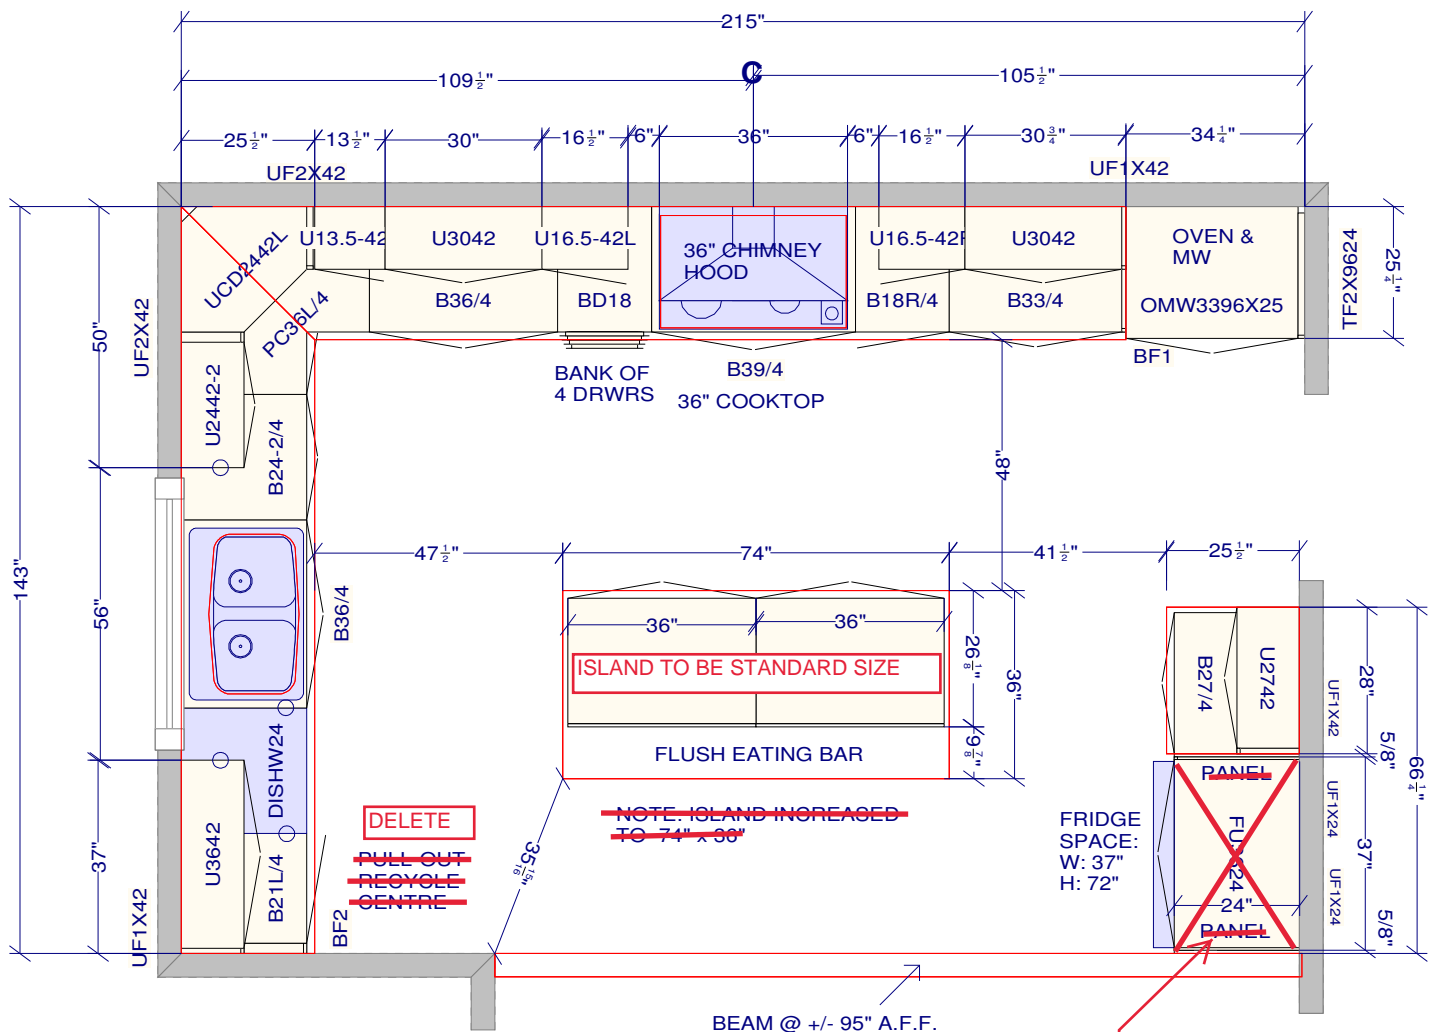

#### CUSTOMER APPROVAL

I have reviewed these drawings and understand the details of the design and the CARTIER KITCHENS specifications.

Signature \_\_\_\_\_

Date \_\_\_\_\_

All dimensions size designations given are subject to verification on job site and adjustment to fit job conditions.

SPECTRUM KITCHEN and BATH DESIGN



This is an original design and must not be released or copied unless applicable fee has been paid or job order placed.

DRAWN BY: LORI DISAVERIO, B.I.D

Designed: 2021-10-07  
Printed: 2021-10-07