

DCR PHOENIX HOMES



LOT # 223

SITE - PATHWAYS 2


MODEL - ANNAPOLIS (509)

VANITIES


- CABINETS -
- HARDWARE -
- STANDARD WHITE INTERIOR
- METAL DRAWER BOX
- 4 PCS - 5/8" KICK - FIN. BOTH ENDS
- 4 PCS - FLAT MOULDING

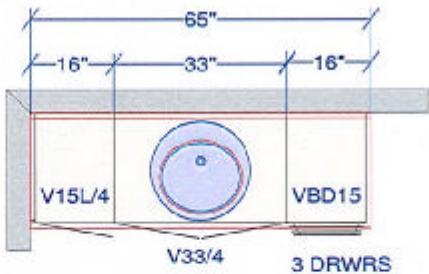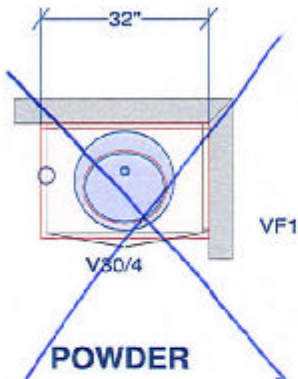

ENSUITE #2

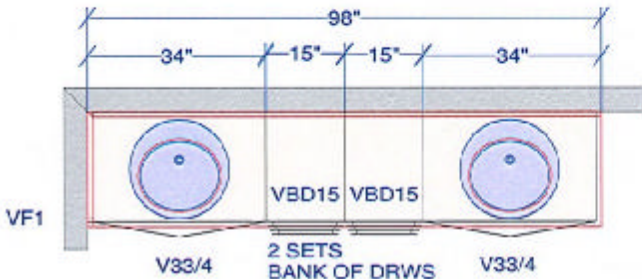

MASTER ENSUITE

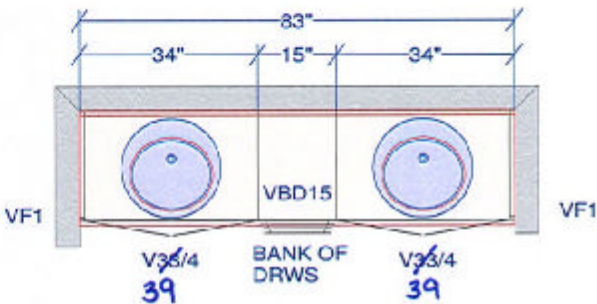

SHARED BATH
BDRM 3 & 4

CUSTOMER APPROVAL

I have reviewed these drawings and understand the details of the design and the CAXTER KITCHENS specifications.

Signature _____

Date _____

All dimensions, size designations given are subject to verification on job site and adjustment to fit job conditions.



This is an original design and must not be released or copied unless applicable fee has been paid or job order placed.

Designed: 2021-12-10
Printed: 2021-12-12





223 PWYS 2 - Vanities.kit

All

Drawing #: 1 No Scale.

DS SL DS U

VANITIES

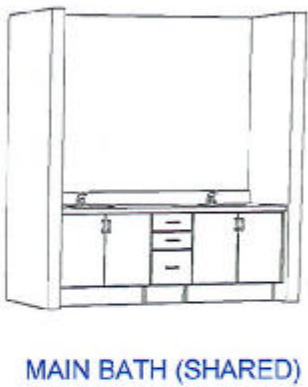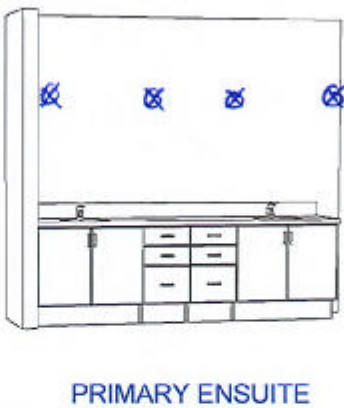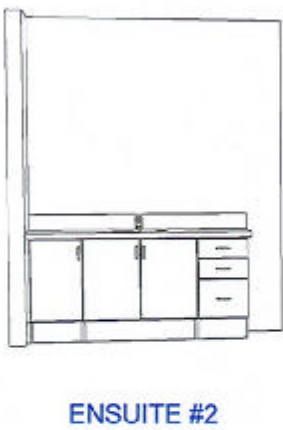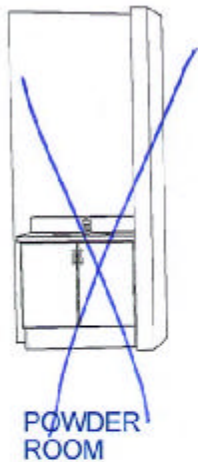

CUSTOMER APPROVAL

I have reviewed these drawings and understand the details of the design and the CARTIER KITCHENS specifications.

Signature _____

Date _____

Note: This drawing is an artistic interpretation of the general appearance of the design. It is not meant to be an exact rendition.




Designed: 2021-12-10
Printed: 2021-12-12

223 PWYS 2 - Vanities.kit

All

Drawing #: 1

DS SL DS U

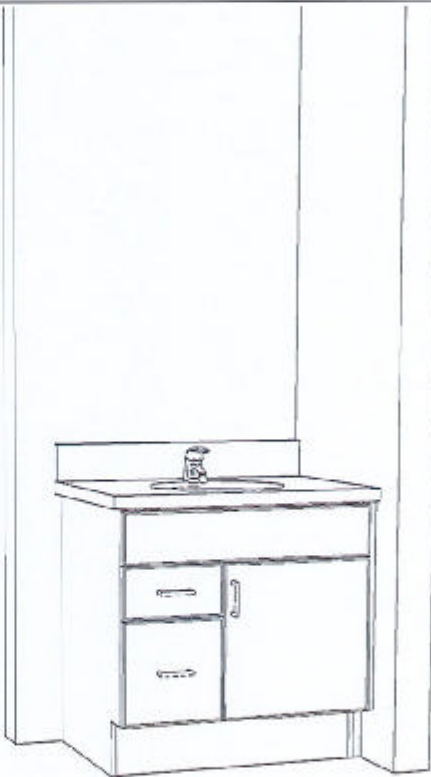

MAIN FLOOR ENSUITE

Note: This drawing is an artistic interpretation of the general appearance of the design. It is not meant to be an exact rendition.		Designed: 2021-12-10
		Printed: 2022-01-10
223 PWYS 2 - Vanities.kit	All	Drawing #: 1

DS

Sl

DS

U