

DCR PHOENIX HOMES

SPRINGFIELD
STANDARD KITCHEN

MOUNTING HEIGHT - 84

KITCHEN

LINE 1 & 2

HARDWARE - STD & 1st UPGRADE

STANDARD WHITE INTERIOR

METAL DRAWER BOX

3 PCS - 5/8" KICK - FIN, BOTH ENDS




3 PCS - LOOSE FILLER - 3 x 96

2 PCS - 90 DEG. CORNER MOULD

1 PCS - T-MOULD

1 PCS - FLAT MOULDING

See page 2 for correct layout

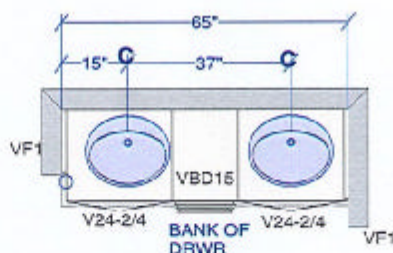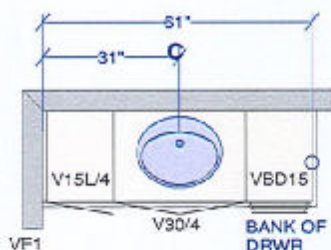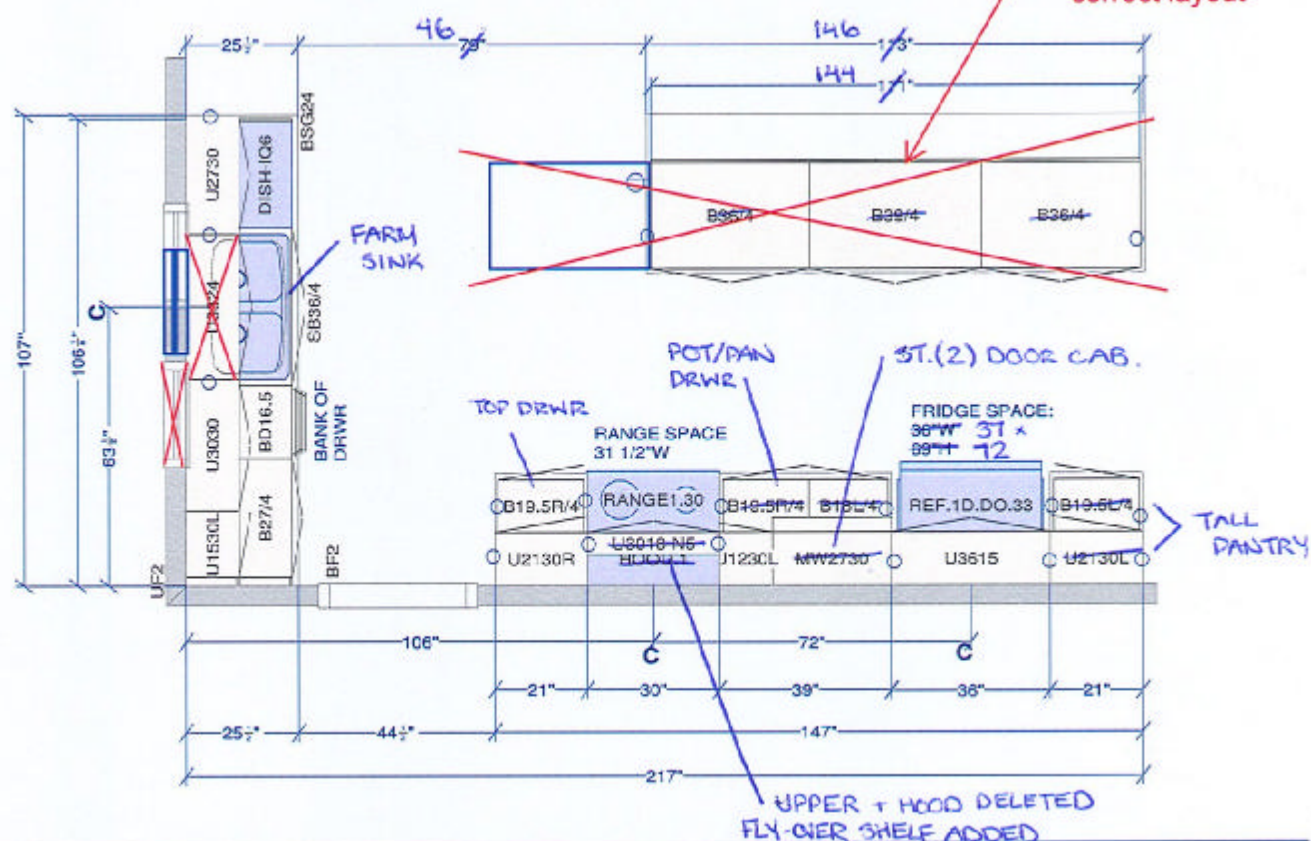

MAIN BATH

ENSUITE

CUSTOMER APPROVAL

I have reviewed these drawings and understand the details of the design and the Carter-Kilbuck conditions.

Signature _____
Date _____

All dimensions & size designations given are subject to verification on job site and adjustment to fit job conditions.



This is an original design and must not be released or copied unless applicable fee has been paid or job order placed.

Designed: 2017-11-15
Printed: 2017-11-29

Springfield Standard

All

Drawing #: 1	No Scale.
--------------	-----------

DS DS

18" **33"** **27"** **33"** **33"**

MW unit with bottom drawer

FARM SINK

(2) DOOR CAB.

FLY-OVER SHELF

24" D FRIDGE UPPER + SIDE PANEL

KITCHEN TOP VIEW
DCR - SPRINGFIELD STANDARD KITCHEN

CUSTOMER APPROVAL

I have reviewed these drawings and understand the details of the design and the Centler Kitchens specifications


Signature _____

Date _____

Note: This drawing is an artistic interpretation of the general appearance of the design. It is not meant to be an exact rendition.

Designed: 2017-11-15
Printed: 2017-11-29

Springfield Standard	All	Drawing #: 1
----------------------	-----	--------------

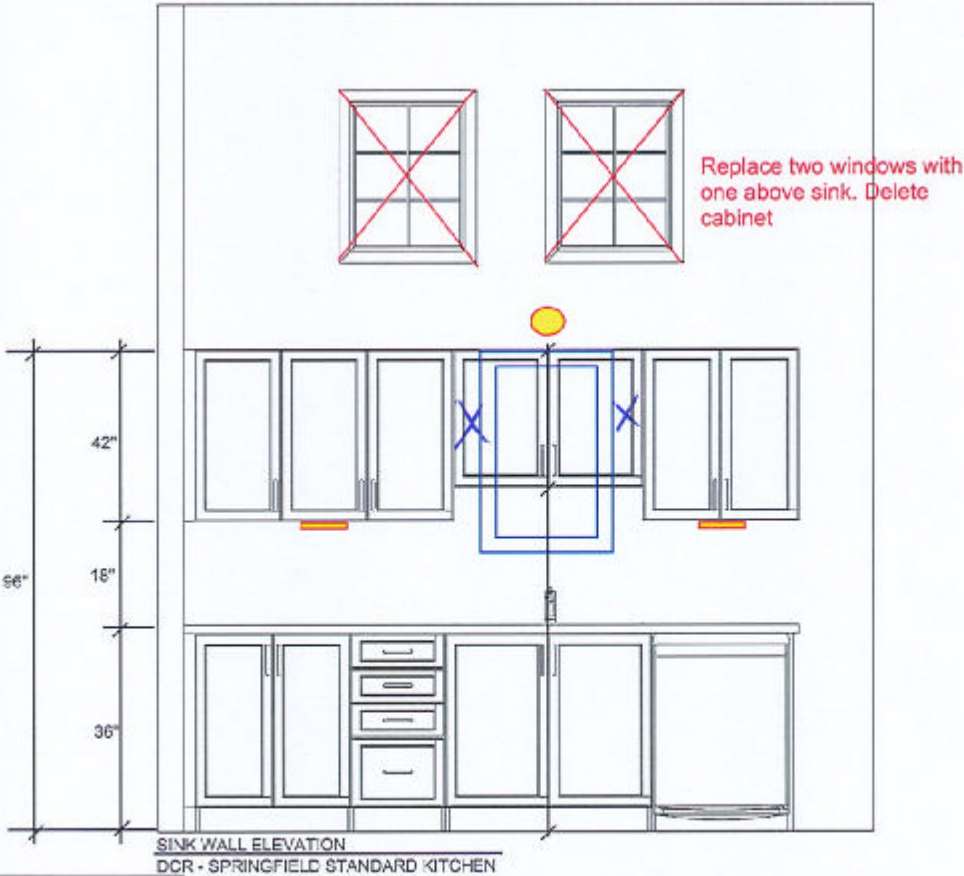

SINK WALL ELEVATION
DCR - SPRINGFIELD STANDARD KITCHEN

CUSTOMER APPROVAL
I have reviewed these drawings and understand the details of the design and the Carde® Cabinets specifications.


Signature _____
Date _____


Note: This drawing is an artistic interpretation of the general appearance of the design. It is not meant to be an exact rendition.


	Designed: 2017-11-15 Printed: 2017-11-29

DS
AF

DS
M

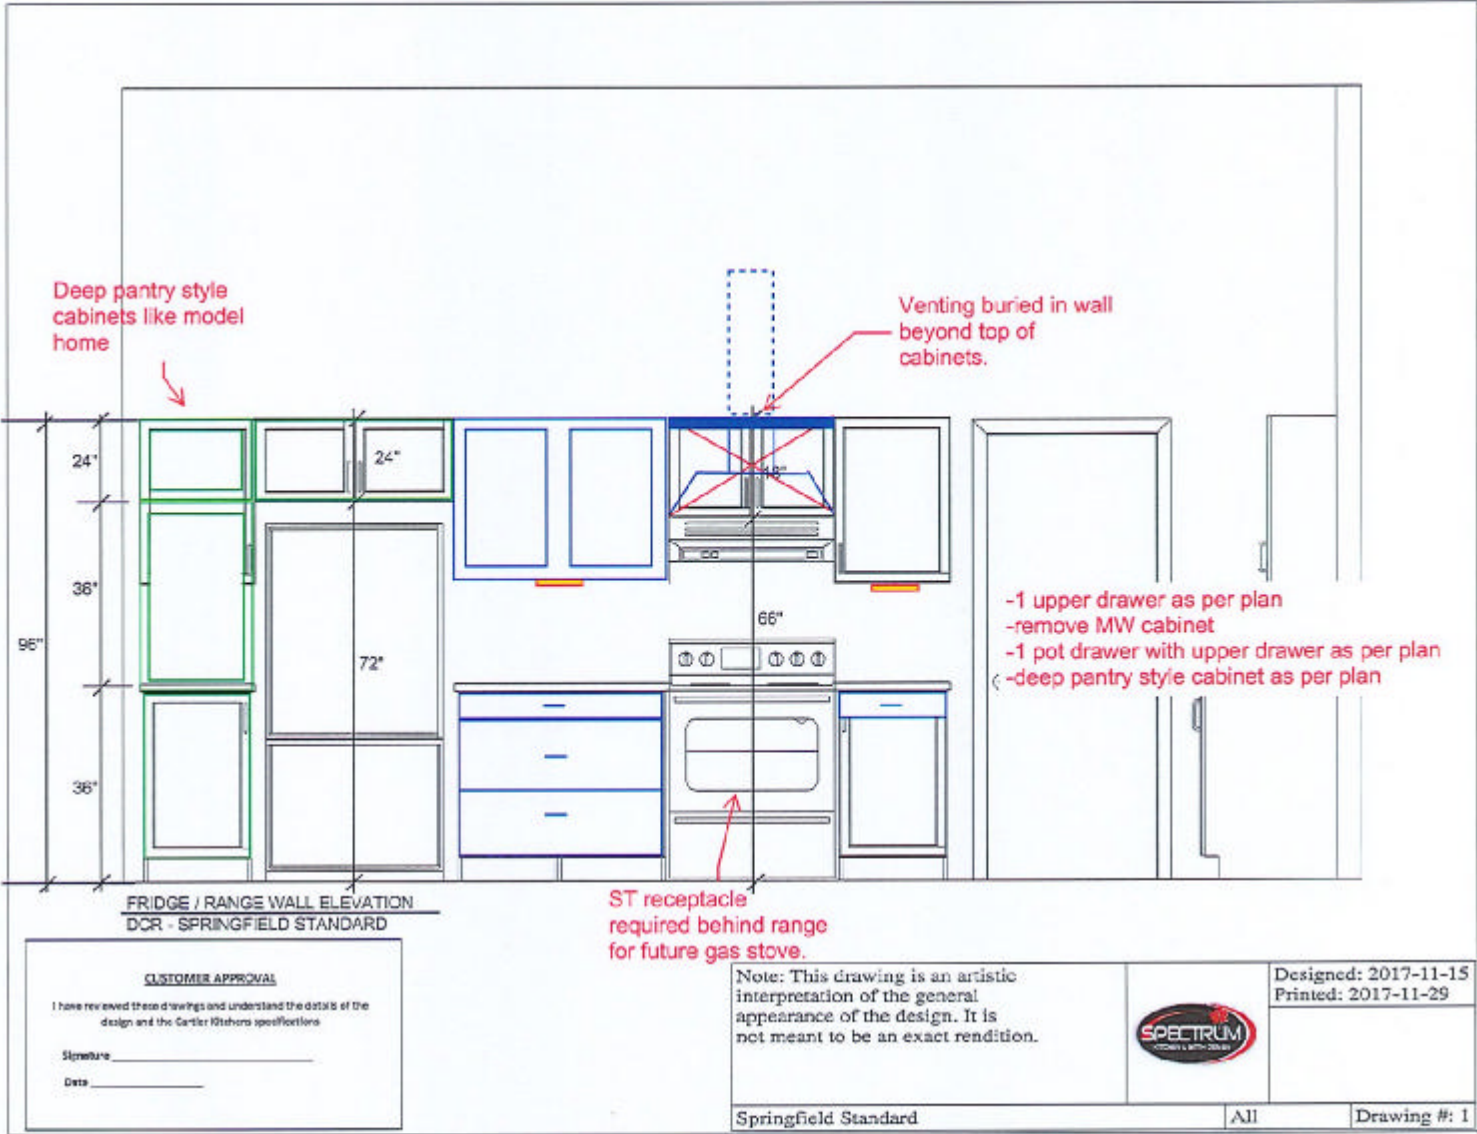

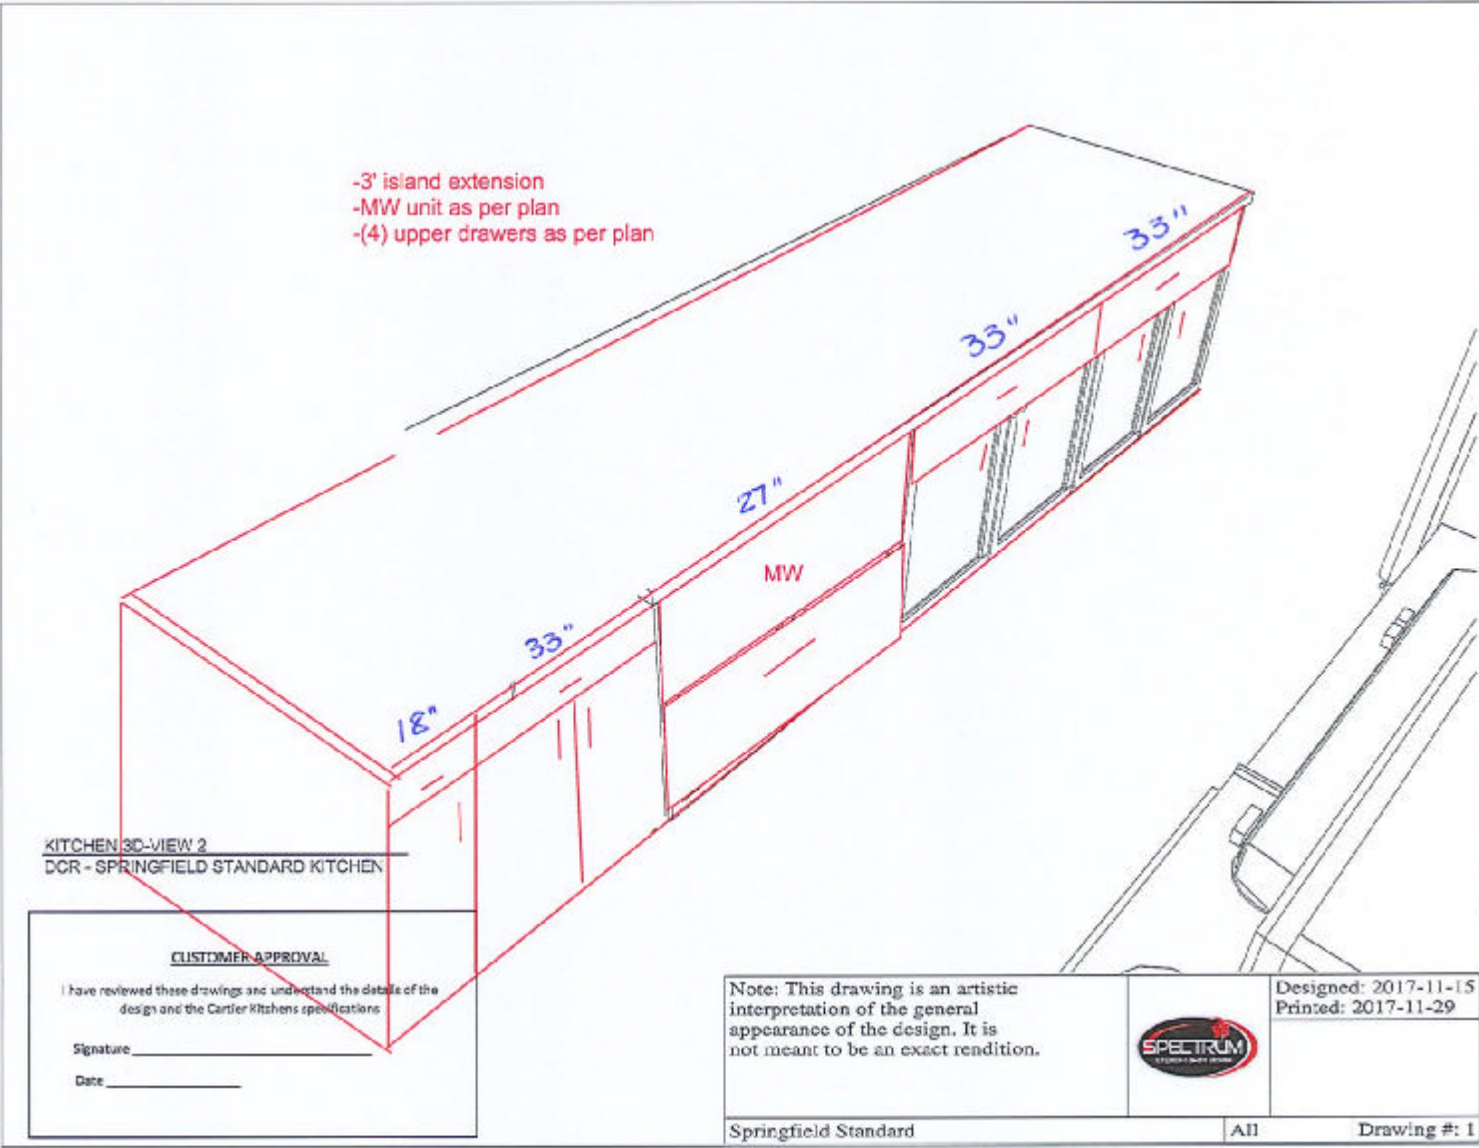

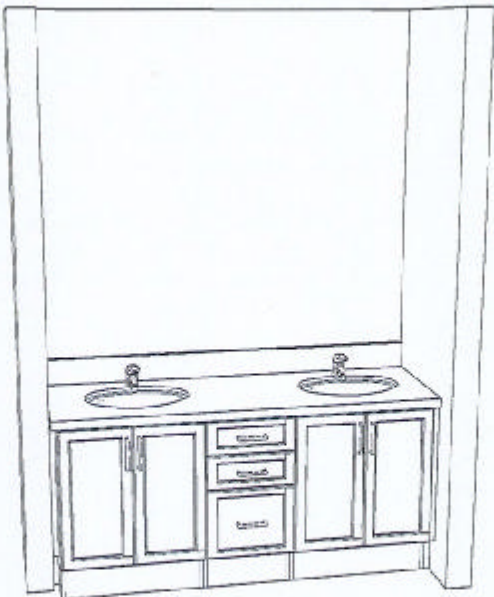

Remain as per plan

ENSUITE 3D-VIEW
DCR - SPRINGFIELD STANDARD

CUSTOMER APPROVAL

I have reviewed these drawings and understand the details of the design and the Cartier Kitchens specifications.

Signature _____

Date _____

Note: This drawing is an artistic interpretation of the general appearance of the design. It is not meant to be an exact rendition.



Designed: 2017-11-15
Printed: 2017-11-29


Springfield Standard

All

Drawing #: 1

DS
AF

DS
M

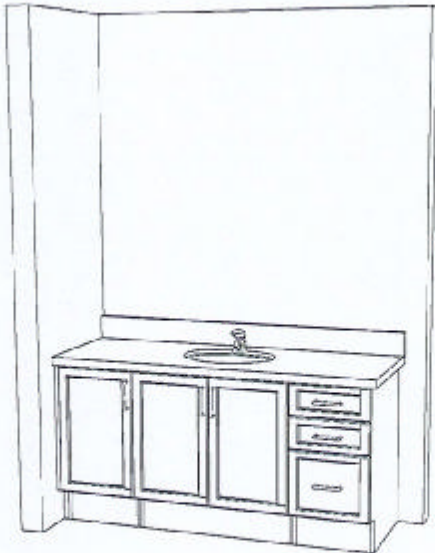

Remain as per plan

MAIN BATH 3D-VIEW
DCR - SPRINGFIELD STANDARD

CUSTOMER APPROVAL

I have reviewed these drawings and understand the details of the design and the Cartier Kitchens specifications

Signature _____

Date _____

Note: This drawing is an artistic interpretation of the general appearance of the design. It is not meant to be an exact rendition.



Designed: 2017-11-15
Printed: 2017-11-29

Springfield Standard

All

Drawing #: 1