


DCR PHOENIX HOMES

LOT #3-54
WHITE TAIL RIDGE 3
MODEL - RUTHERFORD (517)

KITCHEN
MOUNTING HEIGHT - 84

- CABINETS -
- HARDWARE -
- STANDARD WHITE INTERIOR
- METAL DRAWER BOX
- 4 PCS - 5/8" KICK - FIN. BOTH ENDS
- 1 PCS - 90 DEG. CORNER MOULD
- 1 PCS - T-MOULD
- 4 PCS - FLAT MOULD

ADD APPROX. 24"
TO LENGTH OF KITCHEN
& ACCOMODATE FOR PREP SINK

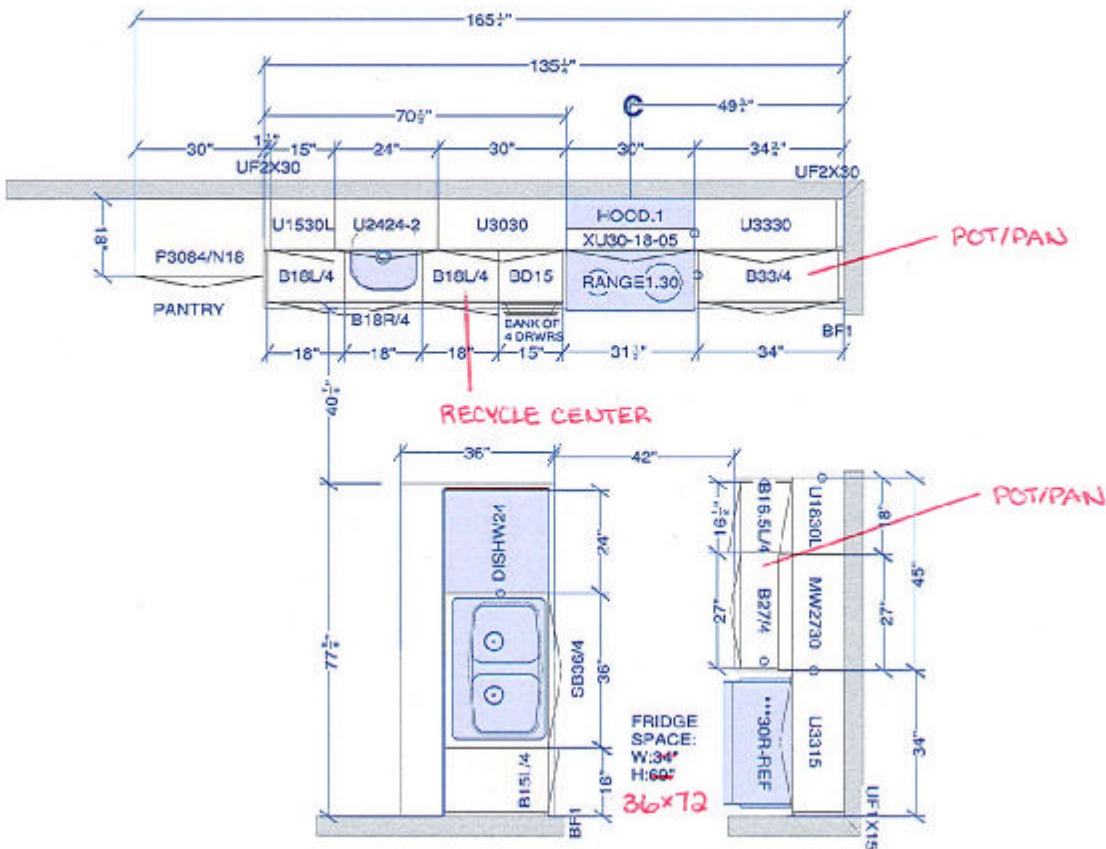

CUSTOMER APPROVAL


I have reviewed these drawings and understand the details of the design and the CARTIER KITCHENS specifications.

Signature _____

Date _____

All dimensions ,size designations given are subject to verification on job site and adjustment to fit job conditions.		This is an original design and must not be released or copied unless applicable fee has been paid or job order placed.	Designed: 2022-07-22 Printed: 2022-07-27	
3-54 White Tail Ridge 3 - Rutherford .klt		All	Drawing #: 1	No Scale.

DS DS
D S n s k e

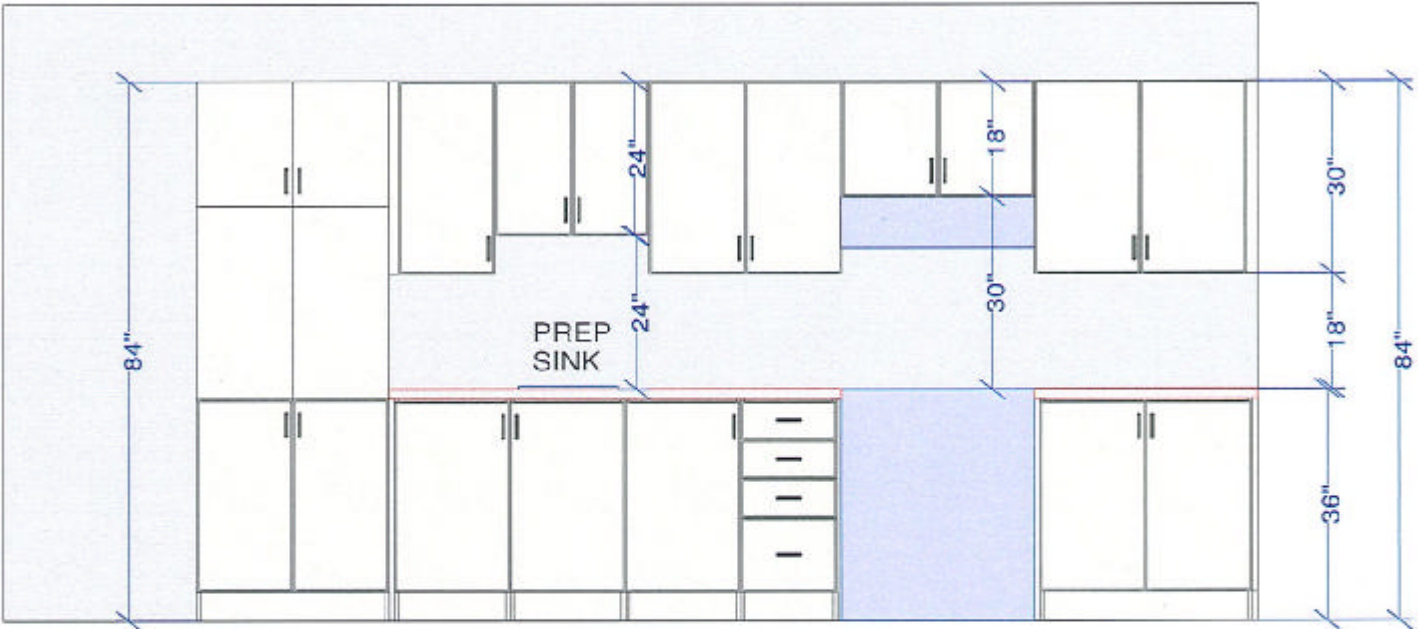

CUSTOMER APPROVAL
I have reviewed these drawings and understand the details of the design and the CARTIER KITCHENS specifications.

Signature _____
Date _____

RANGE WALL ELEVATION


All dimensions ,size designations given are subject to verification on job site and adjustment to fit job conditions.



This is an original design and must not be released or copied unless applicable fee has been paid or job order placed.

Designed: 2022-07-22
Printed: 2022-07-27

DS DS
D S K E

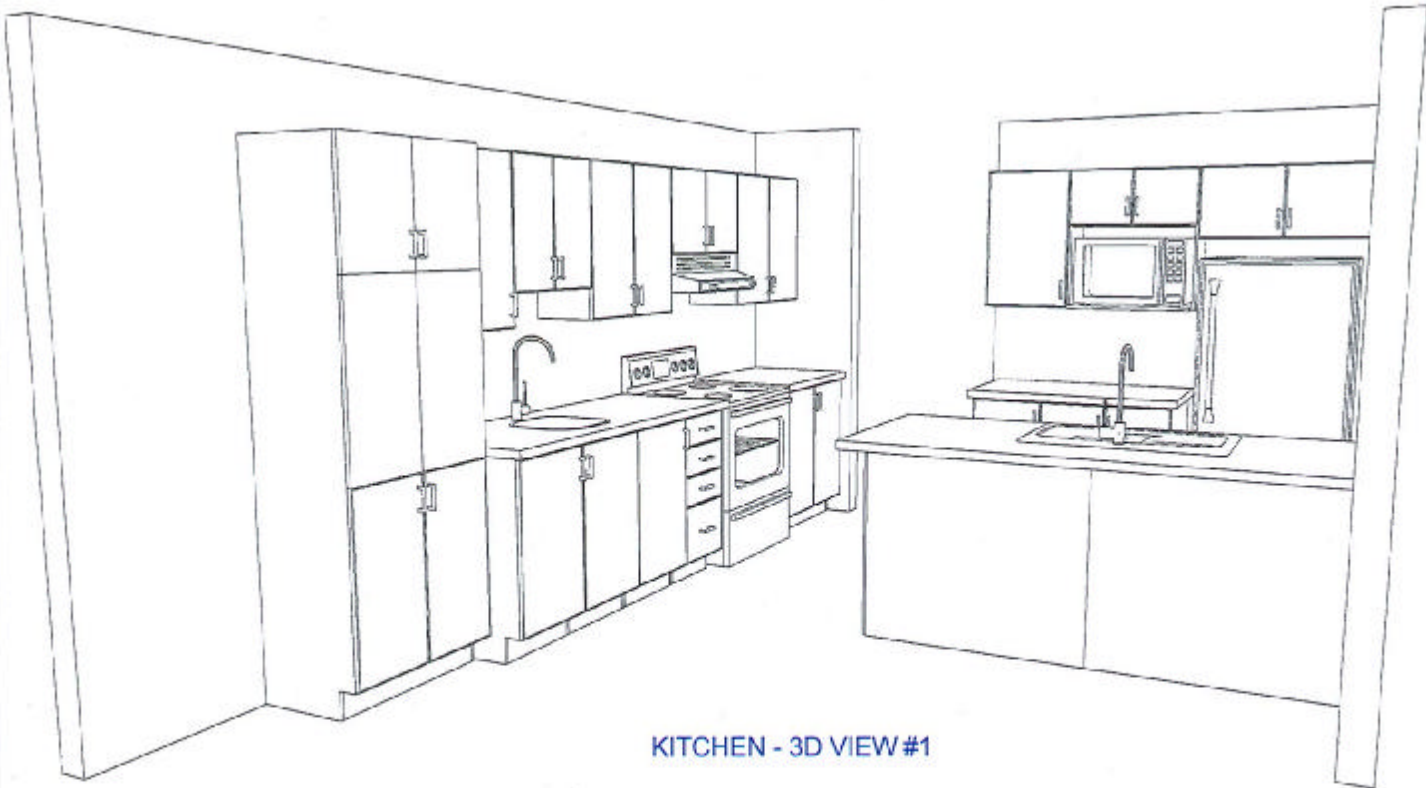

KITCHEN - 3D VIEW #1

CUSTOMER APPROVAL	
have reviewed these drawings and understand the details of the design and the CARTIER KITCHENS specifications.	
Signature _____	
Date _____	

Note: This drawing is an artistic interpretation of the general appearance of the design. It is not meant to be an exact rendition.		Designed: 2022-07-22
		Printed: 2022-07-22
3-54 White Tail Ridge 3 - Rutherford .kit		Drawing #: 1



Designed: 2022-07-22
Printed: 2022-07-22

DS DS
D S ny s x E