

CUSTOMER APPROVAL

I have reviewed these drawings and understand the details of the design and the CARTIER KITCHENS conditions.


Signature: _____


Date: _____

FRIDGE WALL ELEVATION

All dimensions & size designations given are subject to verification on job site and adjustment to fit job conditions.		This is an original design and must not be released or copied unless applicable fee has been paid or job order placed.	Designed: 2021-12-09 Printed: 2021-12-09
DCR # 258 Pwys 2 - MIRAPOSA (right)- .kit		El 2	Drawing #: 1 No Scale.

DS
15
DS

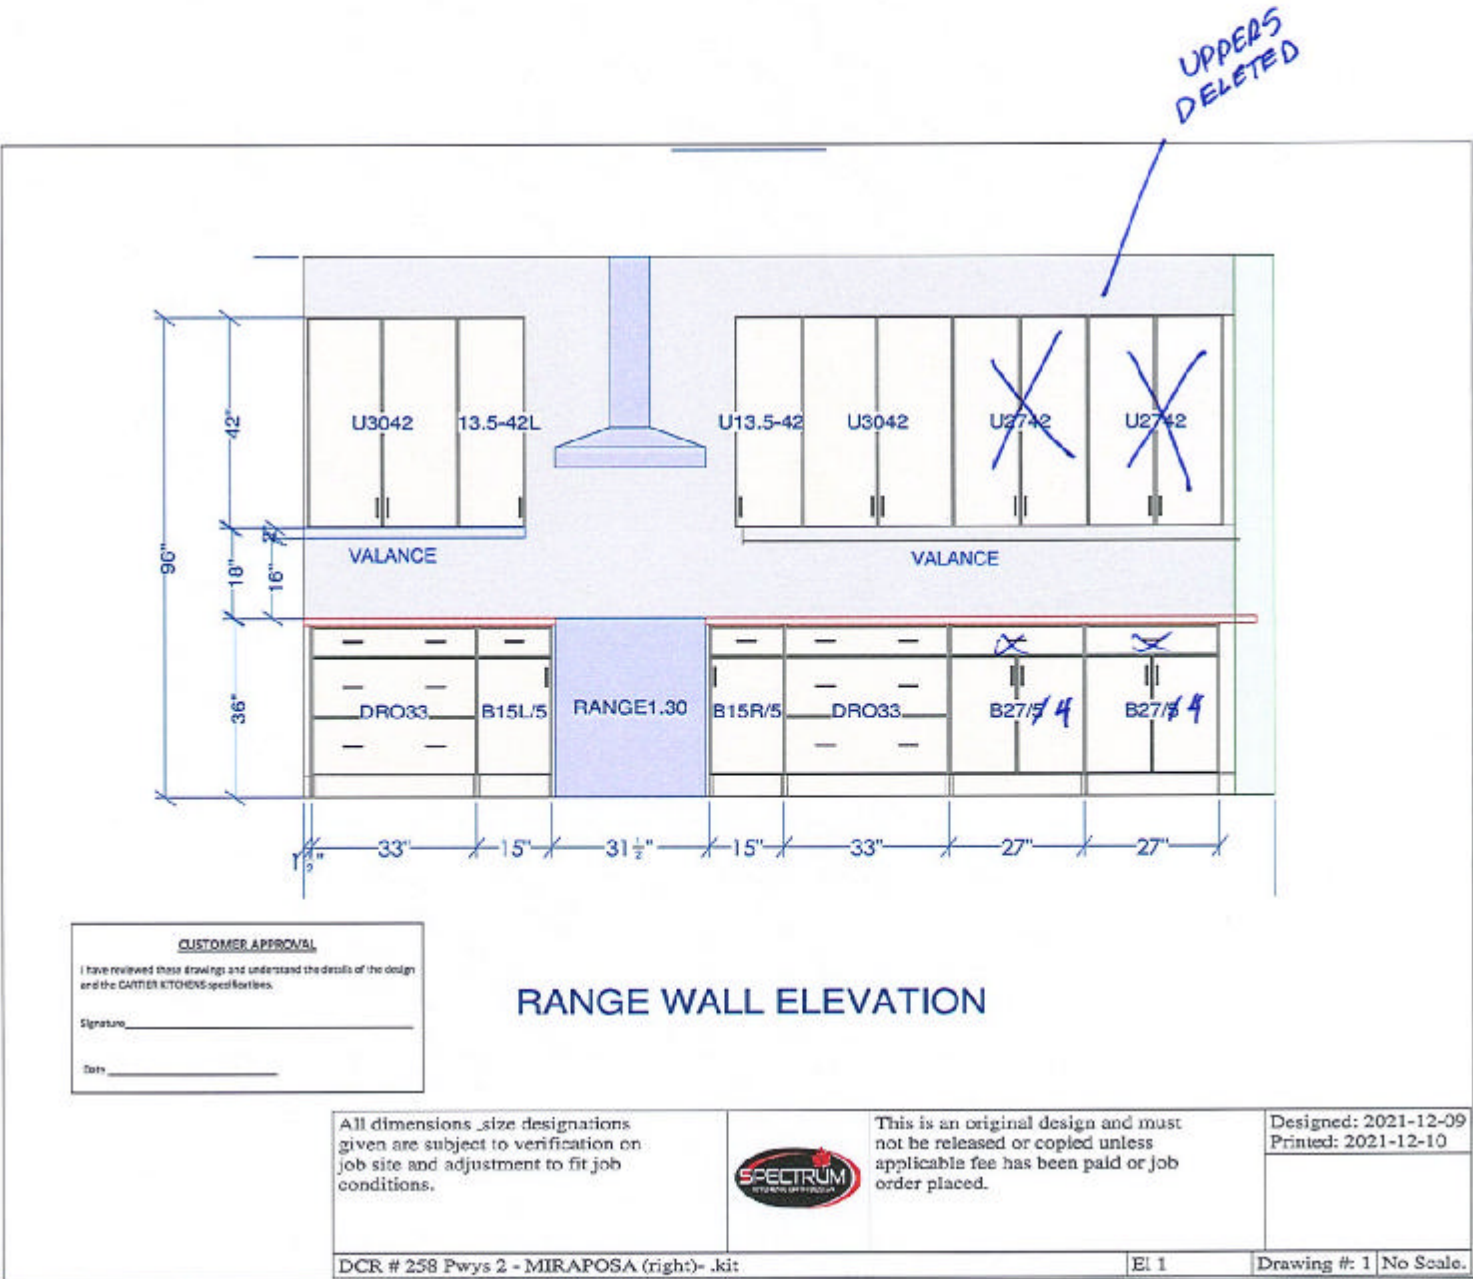

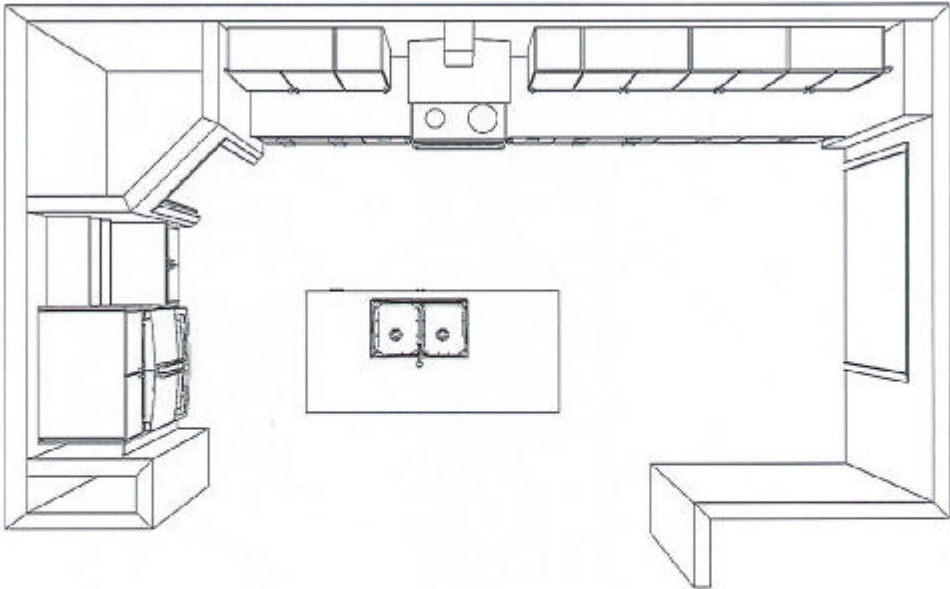


KITCHEN - TOP VIEW

CUSTOMER APPROVAL	
I have reviewed these drawings and understand the details of the design and the CARTIER KITCHENS specifications.	
Signature _____	
Date _____	

Note: This drawing is an artistic interpretation of the general appearance of the design. It is not meant to be an exact rendition.		Designed: 2021-12-09
		Printed: 2021-12-10
DCR # 258 Pwys 2 - MIRAPOSA (right)- .kit	All	Drawing #: 1


DS DS
15 JN

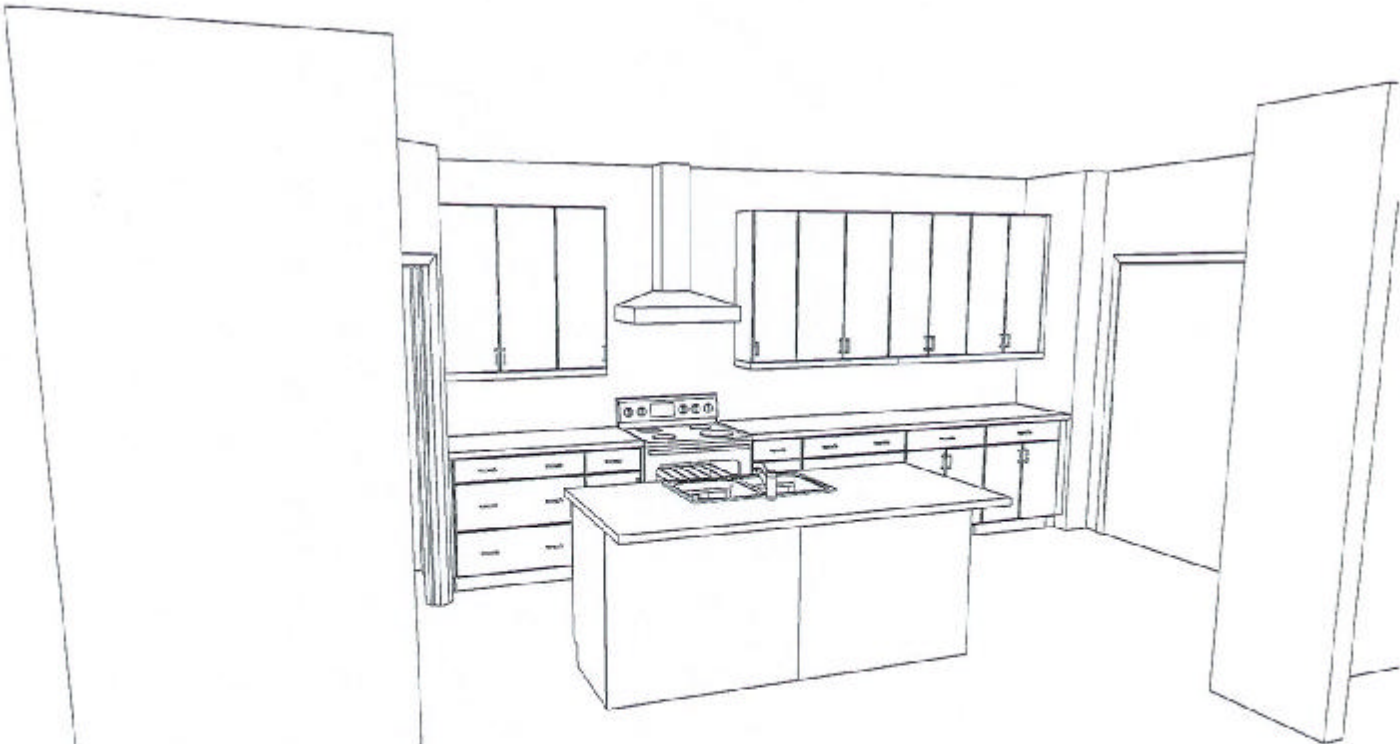

KITCHEN - 3D VIEW #1

CUSTOMER APPROVAL	
I have reviewed these drawings and understand the details of the design and the CARTIER KITCHENS specifications.	
Signature _____	
Date _____	

Note: This drawing is an artistic interpretation of the general appearance of the design. It is not meant to be an exact rendition.		Designed: 2021-12-09
		Printed: 2021-12-10
DCR # 258 Pwys 2 - MIRAPOSA (right)- .kit	All	Drawing #: 1

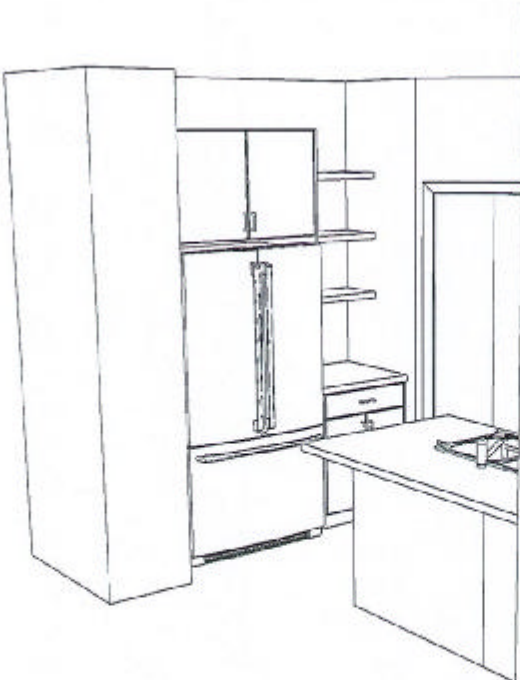


KITCHEN - 3D VIEW #2

CUSTOMER APPROVAL	
I have reviewed these drawings and understand the details of the design and the CARRIER KITCHENS specifications.	
Signature _____	
Date _____	

Note: This drawing is an artistic interpretation of the general appearance of the design. It is not meant to be an exact rendition.		Designed: 2021-12-09
		Printed: 2021-12-09
DCR # 258 Pwys 2 - MIRAFOSA (right)- .kit	All	Drawing #: 1

DS DS
15 JN

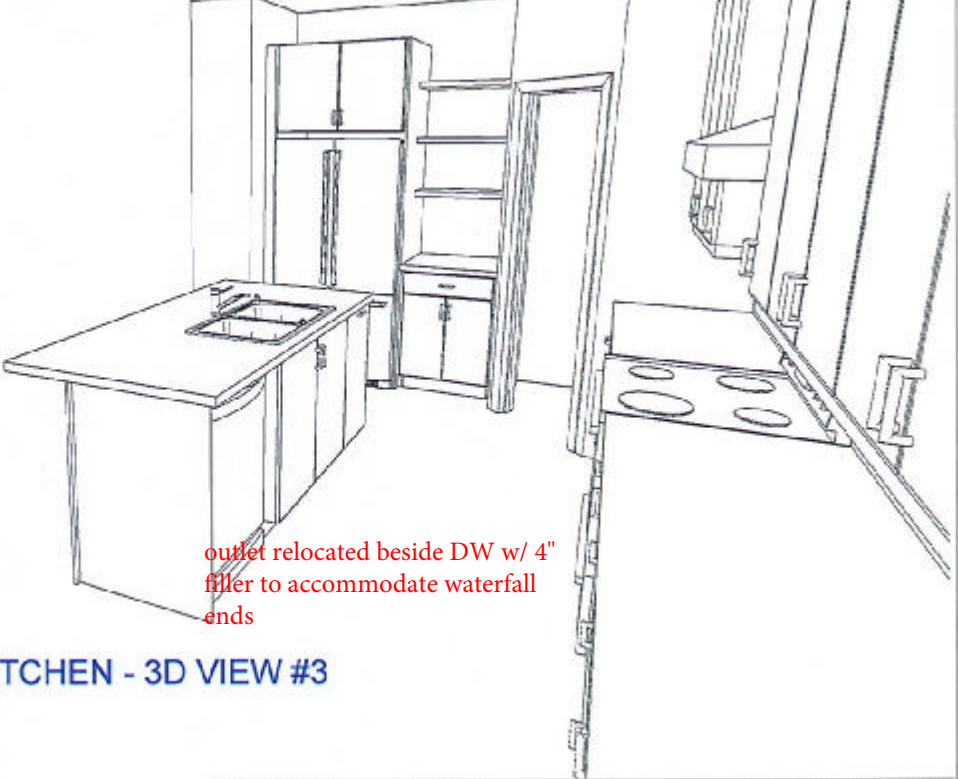

outlet relocated beside DW w/ 4" filler to accommodate waterfall ends

KITCHEN - 3D VIEW #3


CUSTOMER APPROVAL

I have reviewed these drawings and understand the details of the design and the CARTIER KITCHENS specifications.

Signature: _____

Date: _____

Note: This drawing is an artistic interpretation of the general appearance of the design. It is not meant to be an exact rendition.




Designed: 2021-12-09
Printed: 2021-12-09

DCR # 258 Pwys 2 - MIRAPOSA (right)- .kit


All

Drawing #: 1


VANITIES

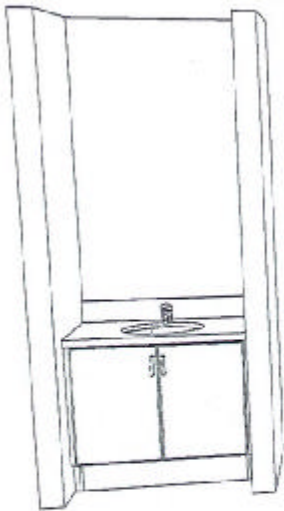

POWDER ROOM

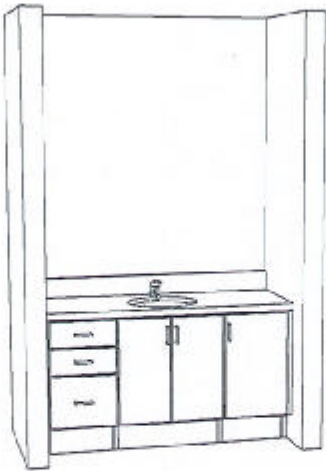

MAIN BATH

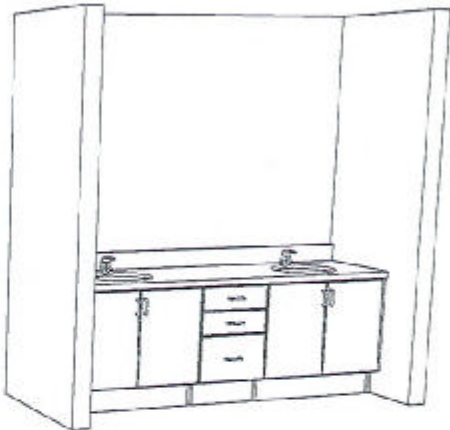

ENSUITE

CUSTOMER APPROVAL

I have reviewed these drawings and understand the details of the design and the CARTIER KITCHENS specifications.

Signature _____

Date _____

Note: This drawing is an artistic interpretation of the general appearance of the design. It is not meant to be an exact rendition.



Designed: 2021-12-09
Printed: 2021-12-10

DCR # 258 Pwys 2 - MIRAPOSA (right)- .kit

All

Drawing #: 1