



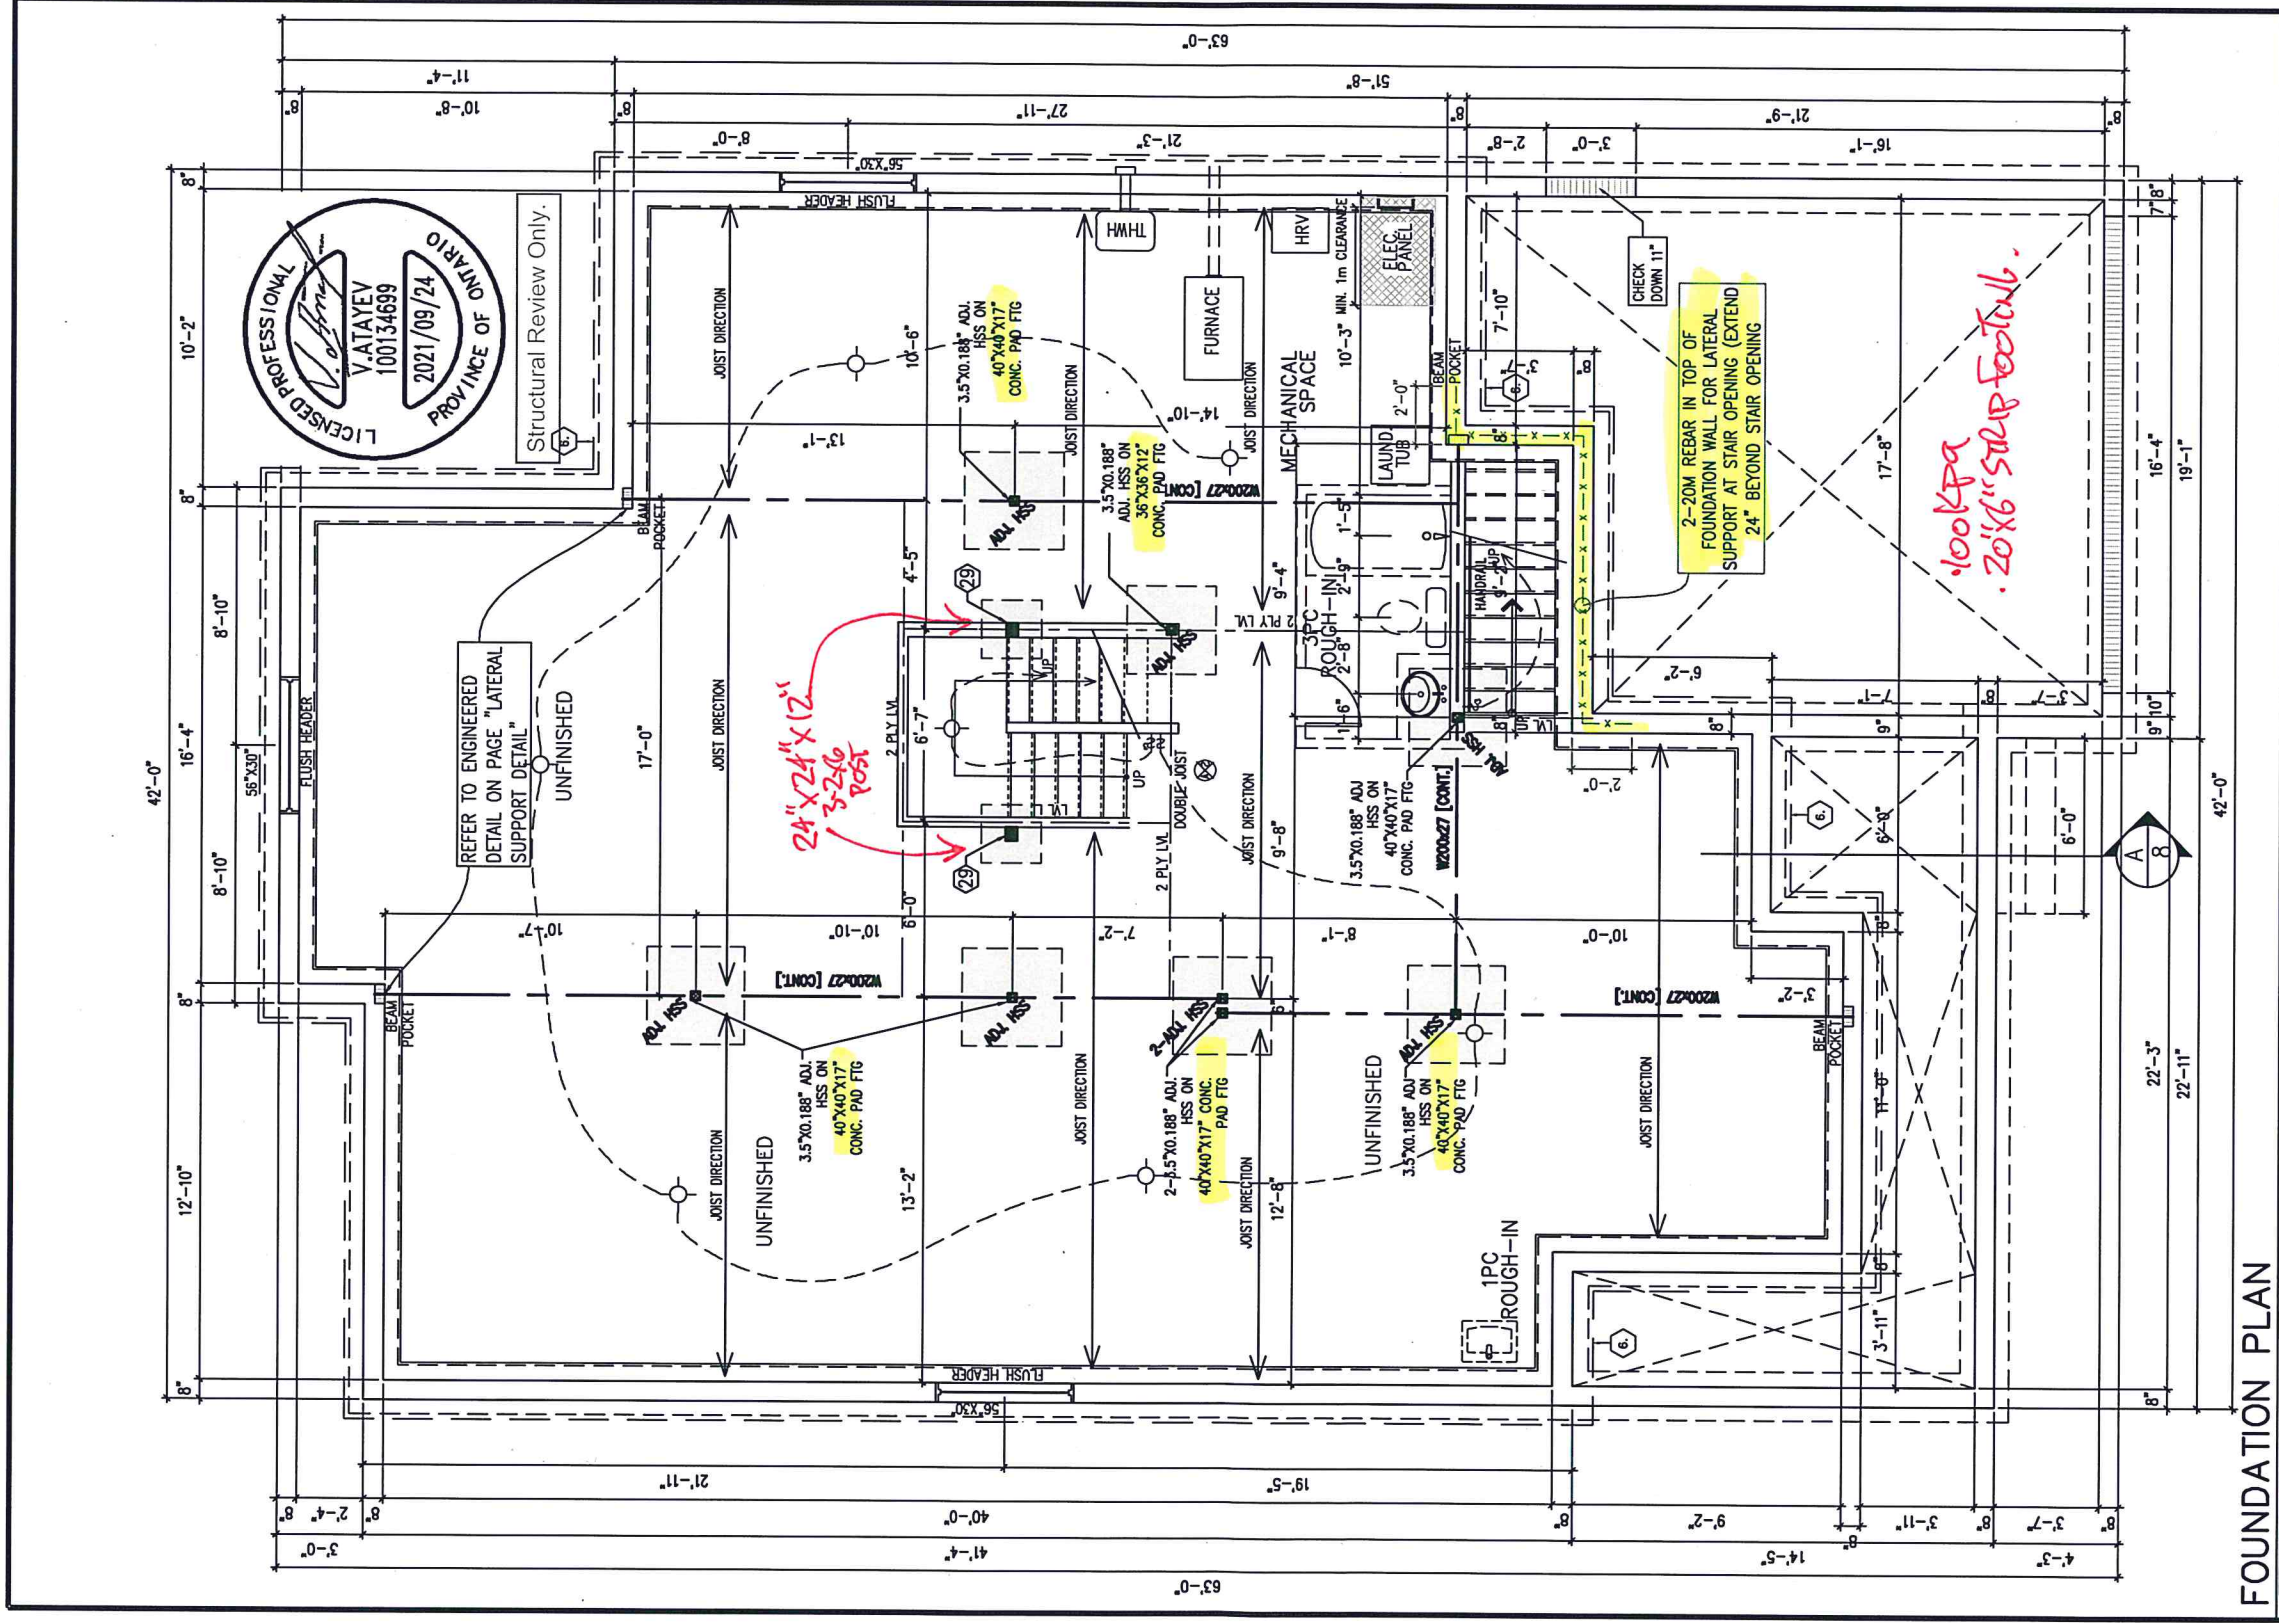

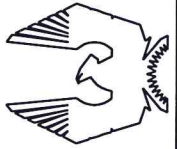

PHOENIX HOMES

NEWINGTON – 2018

SITE: PATHWAYS

LOT NUMBER:
CIVIC ADDRESS:
51 DUN SKIPPER DRIVE

299

8	STRUCTURAL REVIEW	22/09/21	SP
7	FINAL BLACKLINES	3/09/21	SP
6	ENGINEERING REVIEW	18/08/21	CB
5	BEP BLACKLINES	24/06/21	CB
4	ENSUITE TUB CHANGED TO EXHIBIT 6636	09/02/21	CB
3	STRUCTURAL REVIEW	24/11/17	SP
No. Description		dd/mm/yy	By
REVISIONS			

footprint: 518
drawn by: SP
date: JUN 12/16
scale: 3/16"=1'-0"
D.C.L. – 187
sheet no: 2 of 8

City of Ottawa
Building Services Branch

SEP 2 4 2021

Building Code Reviewed

Signature


City of Ottawa
Building Services Branch

SEP 2 4 2021

Zoning Reviewed


Signature

City of Ottawa
SEP 2 4 2021
BCSB
Centrale D.L.

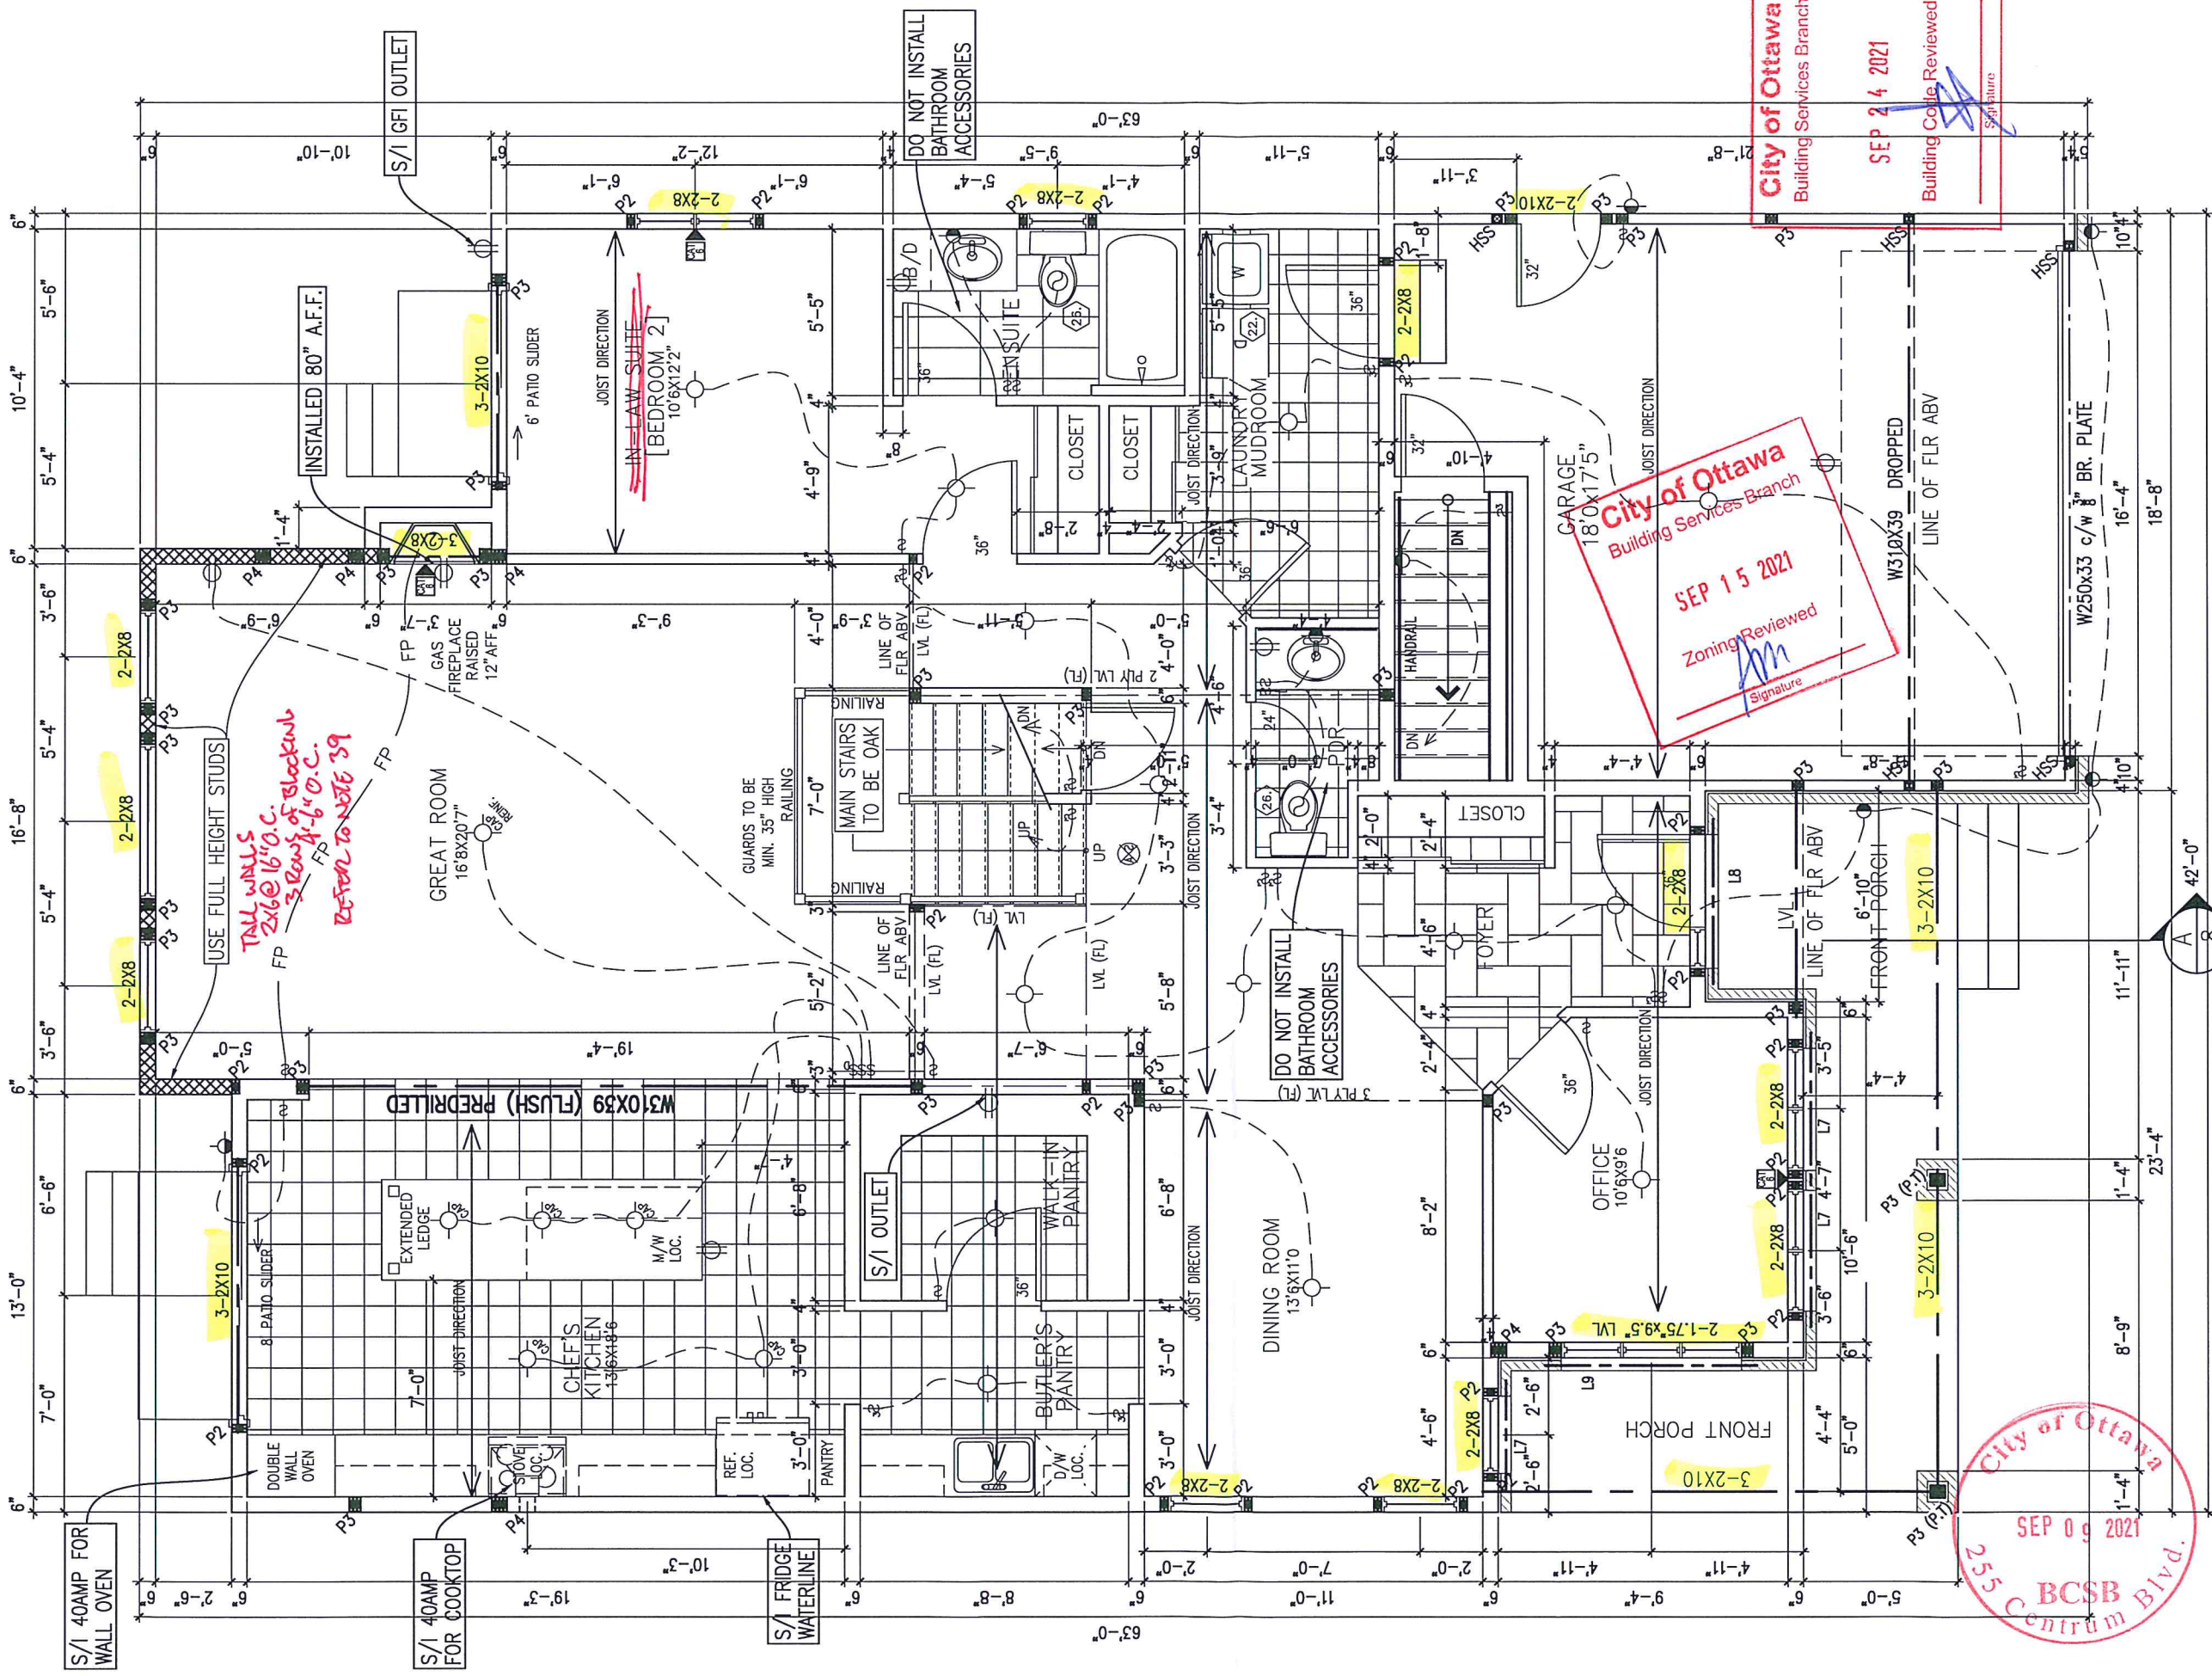

GROUND FLOOR PLAN (ELEVATION C)

SITE COPY

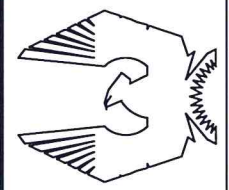

PHOENIX HOMES

NEWINGTON - 2018

SITE: PATHWAYS

LOT NUMBER: 299

CIVIC ADDRESS:
51 DUN SKIPPER DRIVE

7	FINAL BLACKLINES	3/09/21	SP
6	ENGINEERING REVIEW	18/08/21	CB
5	BEP BLACKLINES	24/06/21	CB
4	ENSUITE TUB CHANGED TO EXHIBIT 6636	09/02/21	CB
3	STRUCTURAL REVIEW	24/11/17	SP
No. Description		dd/mm/yy	By
REVISIONS			


footprint:	518
drawn by:	SP
date:	JUN 12/16
scale:	3/16"=1'-0"
D.C.L. -	187
sheet no:	3 of 8

City of Ottawa
BCSB
SEP 09 2021
255 Centre Blvd.

City of Ottawa
Building Services Branch
SEP 15 2021
Zoning Reviewed
Signature

City of Ottawa
Building Services Branch
SEP 24 2021
Building Code Reviewed
Signature


6/12

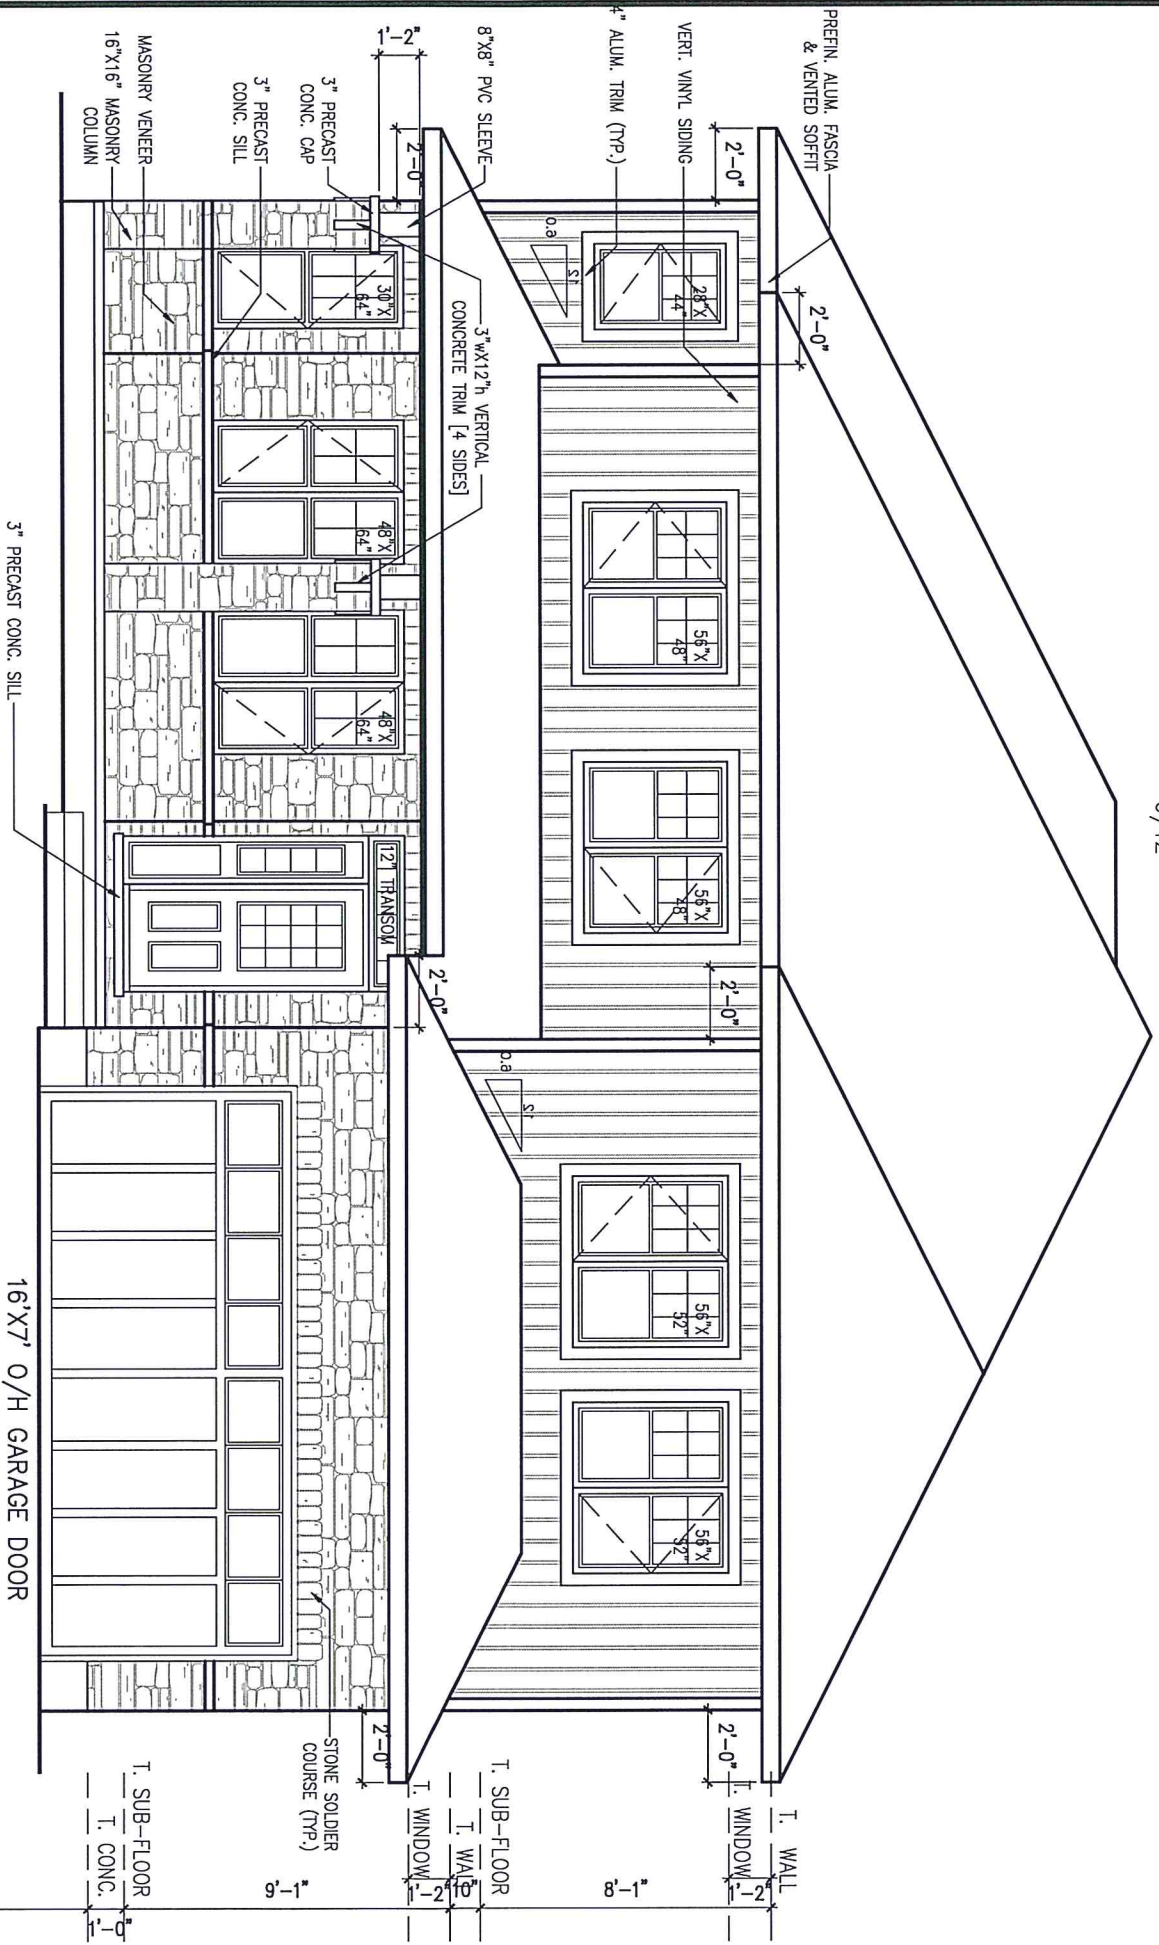

S/I EXTERIOR
LIGHTING AS
PER PLAN

City of Ottawa
Building Services Branch
6/12
SEP 24 2021
Building Code Reviewed
Signature


City of Ottawa
Building Services Branch
SEP 15 2021
Zoning Reviewed
Signature

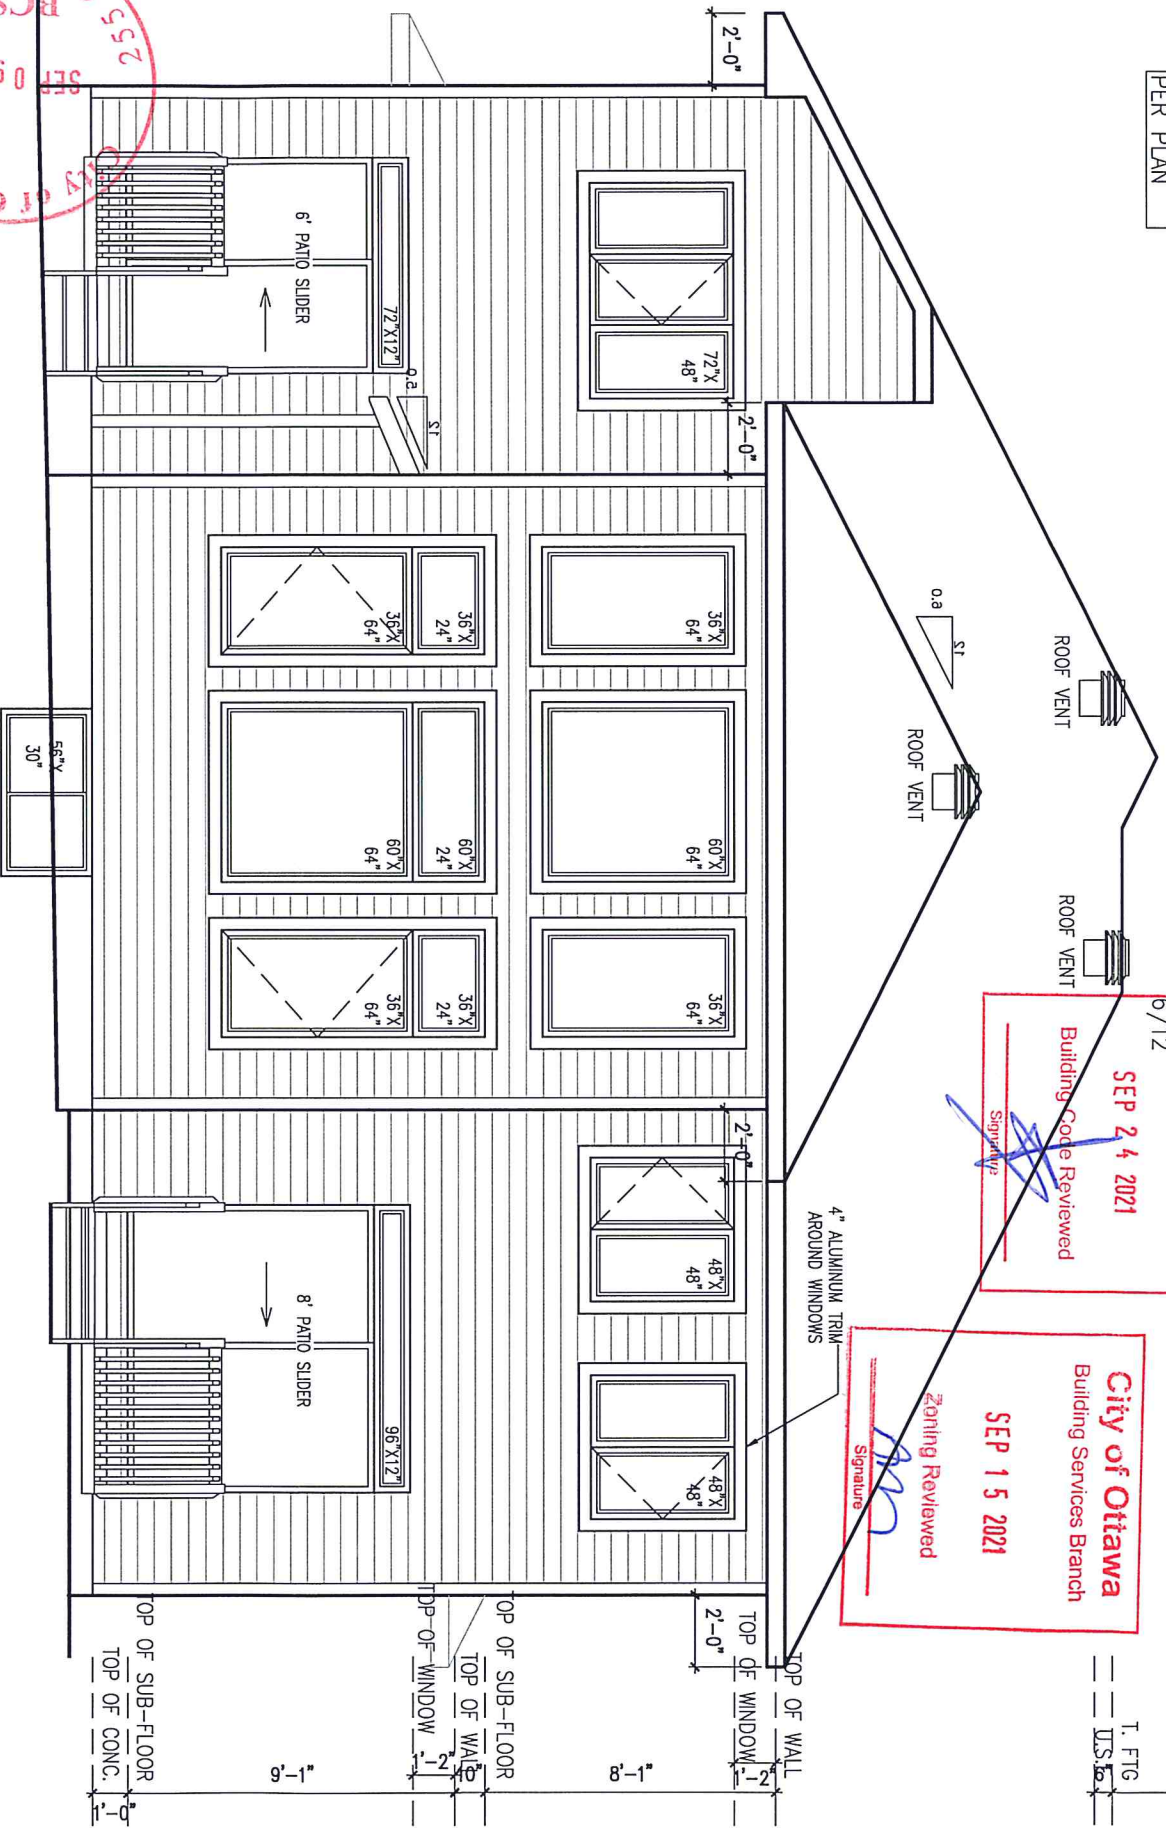

ELEVATION C

GUARDS TO CONFORM
TO O.B.C. 9.8.8, AND
SP-7 GUIDELINES

SITE COPY

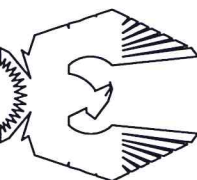

PHOENIX HOMES

NEWINGTON – 2018

SITE: PATHWAYS

LOT NUMBER: 299

CIVIC ADDRESS: 51 DUN SKIPPER DRIVE

7	FINAL BLACKLINES	3/09/21	SP
6	ENGINEERING REVIEW	18/08/21	CB
5	BEP BLACKLINES	24/06/21	CB
4	ENSURE TUB CHANGED TO EXHIBIT 6636	09/02/21	CB
3	STRUCTURAL REVIEW	24/11/17	SP
No.	Description	dd/mm/yy	By

Revisions

footprint: 518

drawn by: SP

date: JUN 12/16

scale: 3/16"=1'-0"

D.C.L. – 187

sheet no: 5 of 8



NEWINGTON – 2018

SITE: PATHWAYS

LOT NUMBER:

CIVIC ADDRESS:
51 DUN SKIPPER DRIVE


2006

7	FINAL BLACKLINES	3/09/21
6	ENGINEERING REVIEW	18/08/21
5	BEP BLACKLINES	24/06/21
4	ENSURE TUB CHANGED TO EXHIBIT 6636	09/02/21
3	STRUCTURAL REVIEW	24/11/17
No.	Description	dd/mm/yy
REVISIONS		By

footprint:	518
drawn by:	SP
date:	JUN 12/16
scale:	3/16" = 1'-0"
D.C.L. - 187	
sheet no:	



RIGHT SIDE ELEVATION C

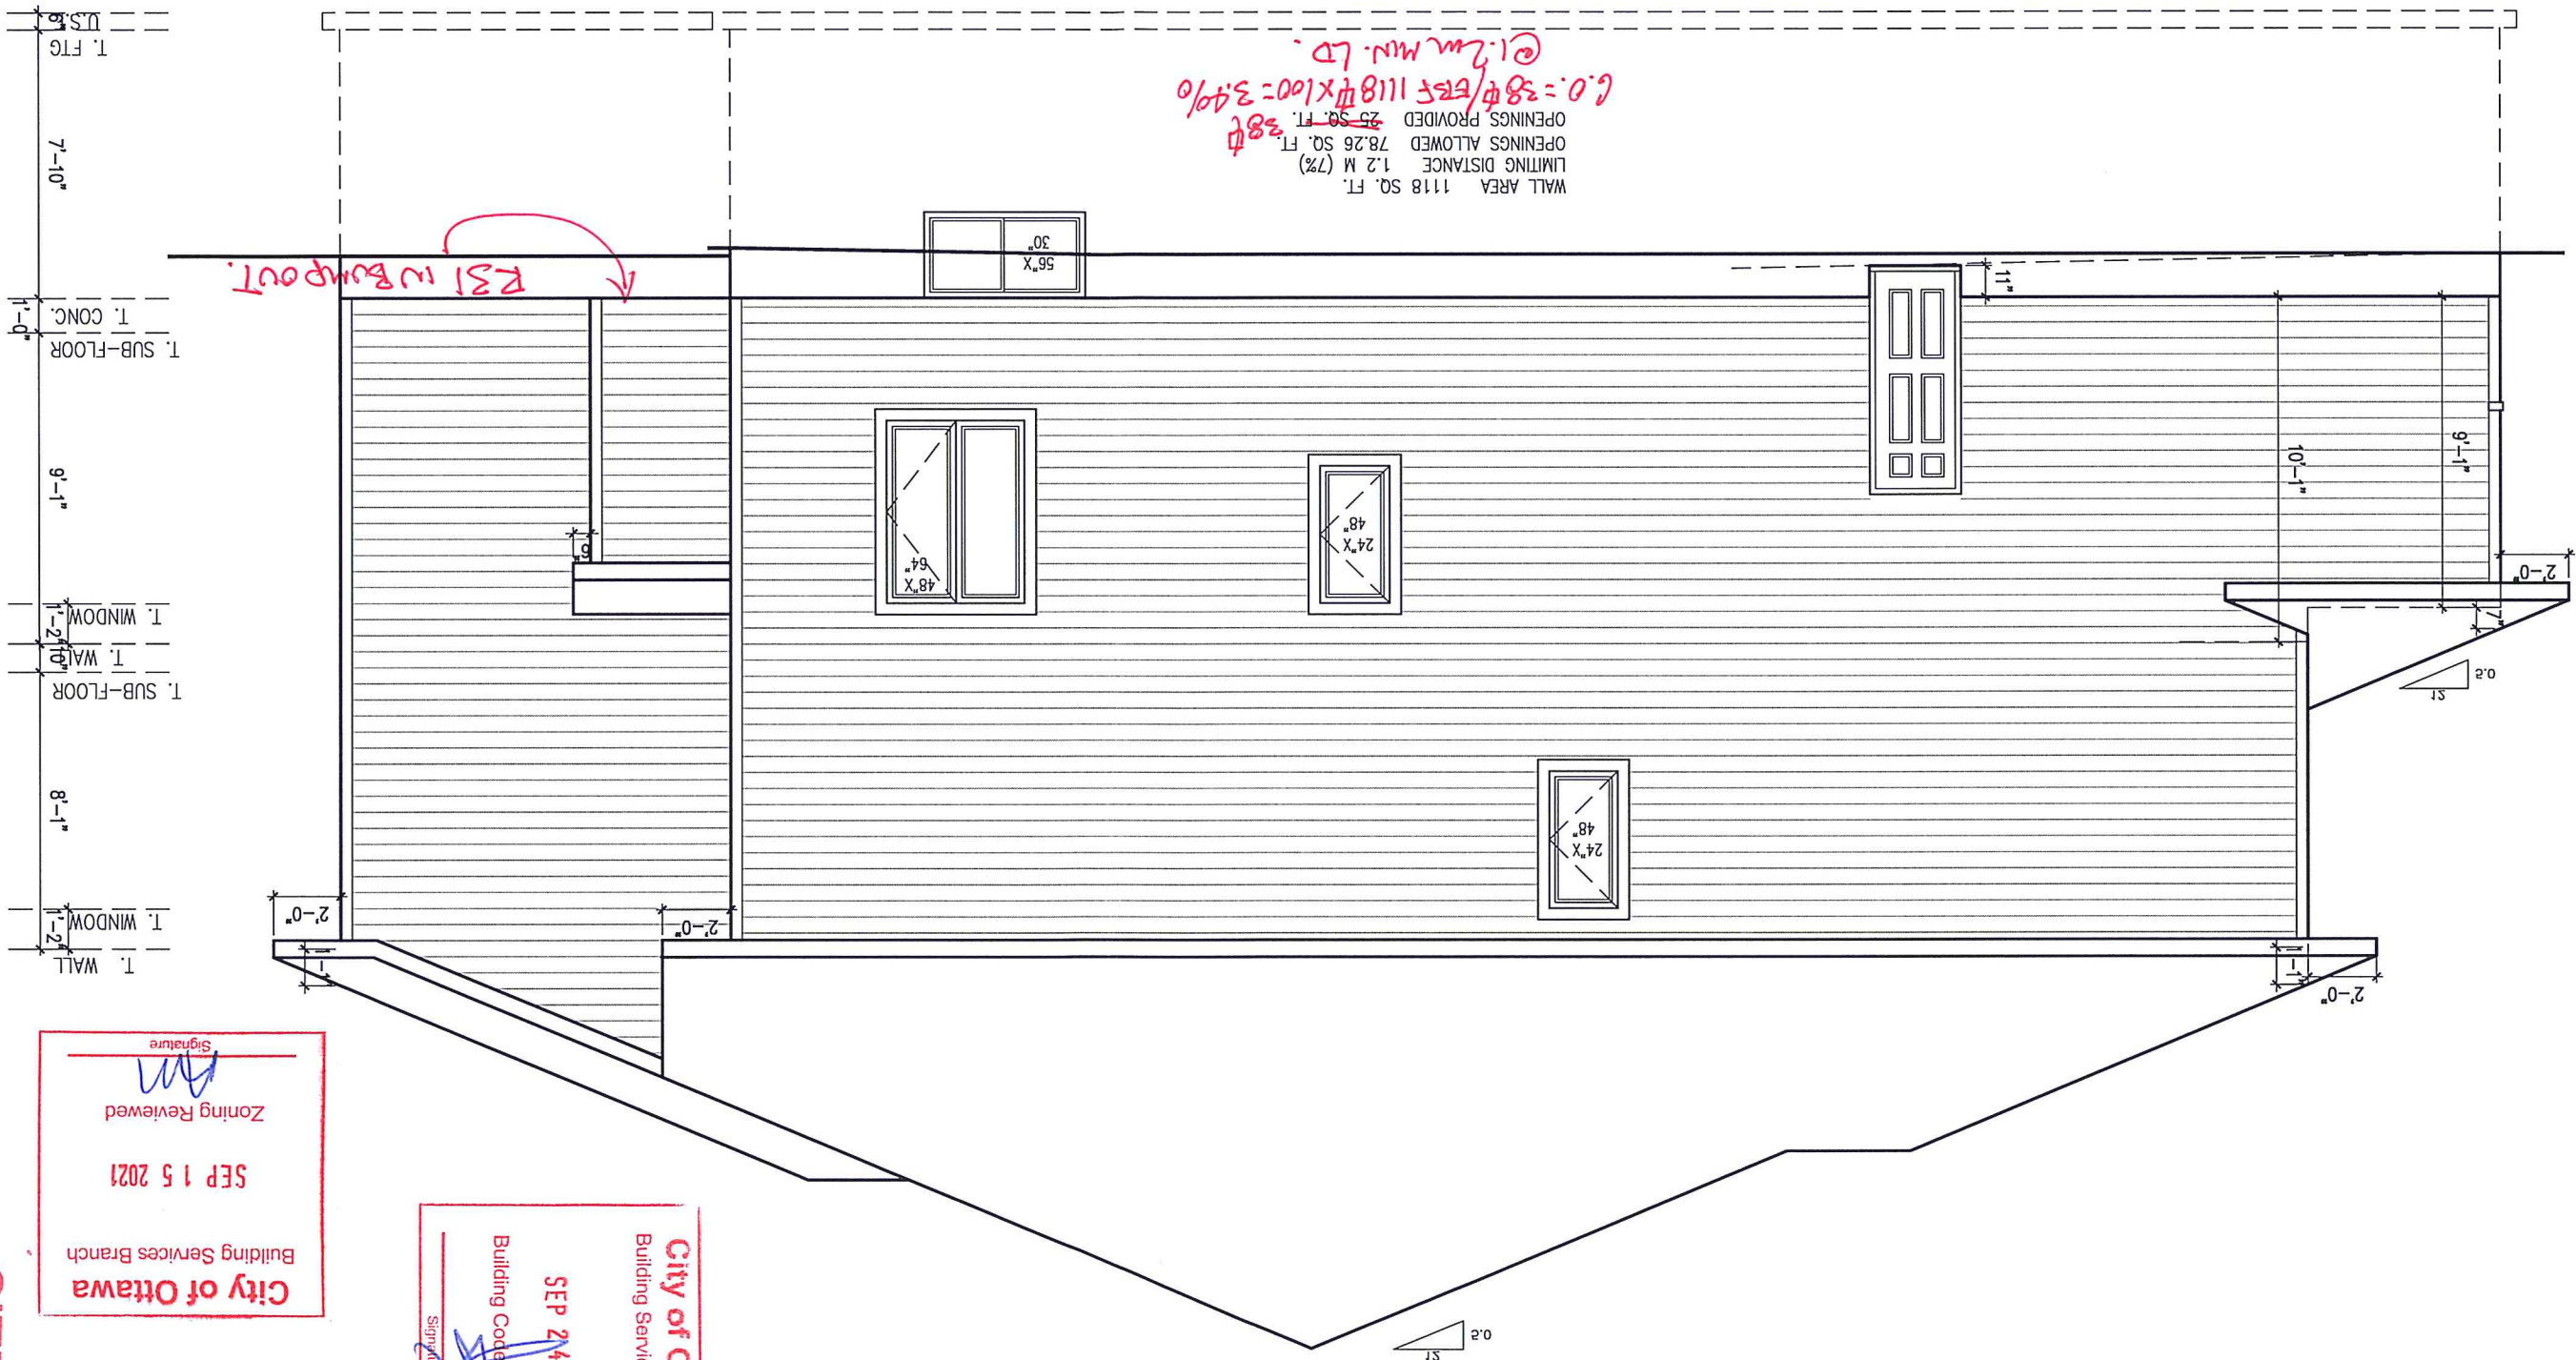

City of Ottawa
Building Services Branch
SEP 15 2021
Zoning Reviewed
Signature

City of Ottawa
Building Services Branch

SEP 24 2021

Building Code Reviewed

Signature _____

SITE COPY



SITE: PATHWAYS

LOT NUMBER:

CIVIC ADDRESS:
51 DUN SKIPPER DRIVE

2000

7	FINAL BLACKLINES	3/09/21	SP
6	ENGINEERING REVIEW	18/08/21	CB
5	BEP BLACKLINES	24/06/21	CB
4	ENSUITE TUB CHANGED TO EXHIBIT 6636	09/02/21	CB
3	STRUCTURAL REVIEW	24/11/17	SP
No.	Description	dd/mm/yy	By
REVISIONS			


footprint:	518
drawn by:	SP
date:	JUN 12/16
scale:	$3/16" = 1'-0"$
D.C.L. - 187	
sheet no:	



LEFT SIDE ELEVATION C

$$60 = 62 \frac{1}{2} / 855 = 1087 \frac{1}{2} \times 100 = 5.7\%$$

WALL AREA 1087 SQ. FT.
LIMITING DISTANCE 12-M (7%)
OPENINGS ALLOWED 76.09 SQ. FT.
OPENINGS PROVIDED 48.3 SQ. FT.

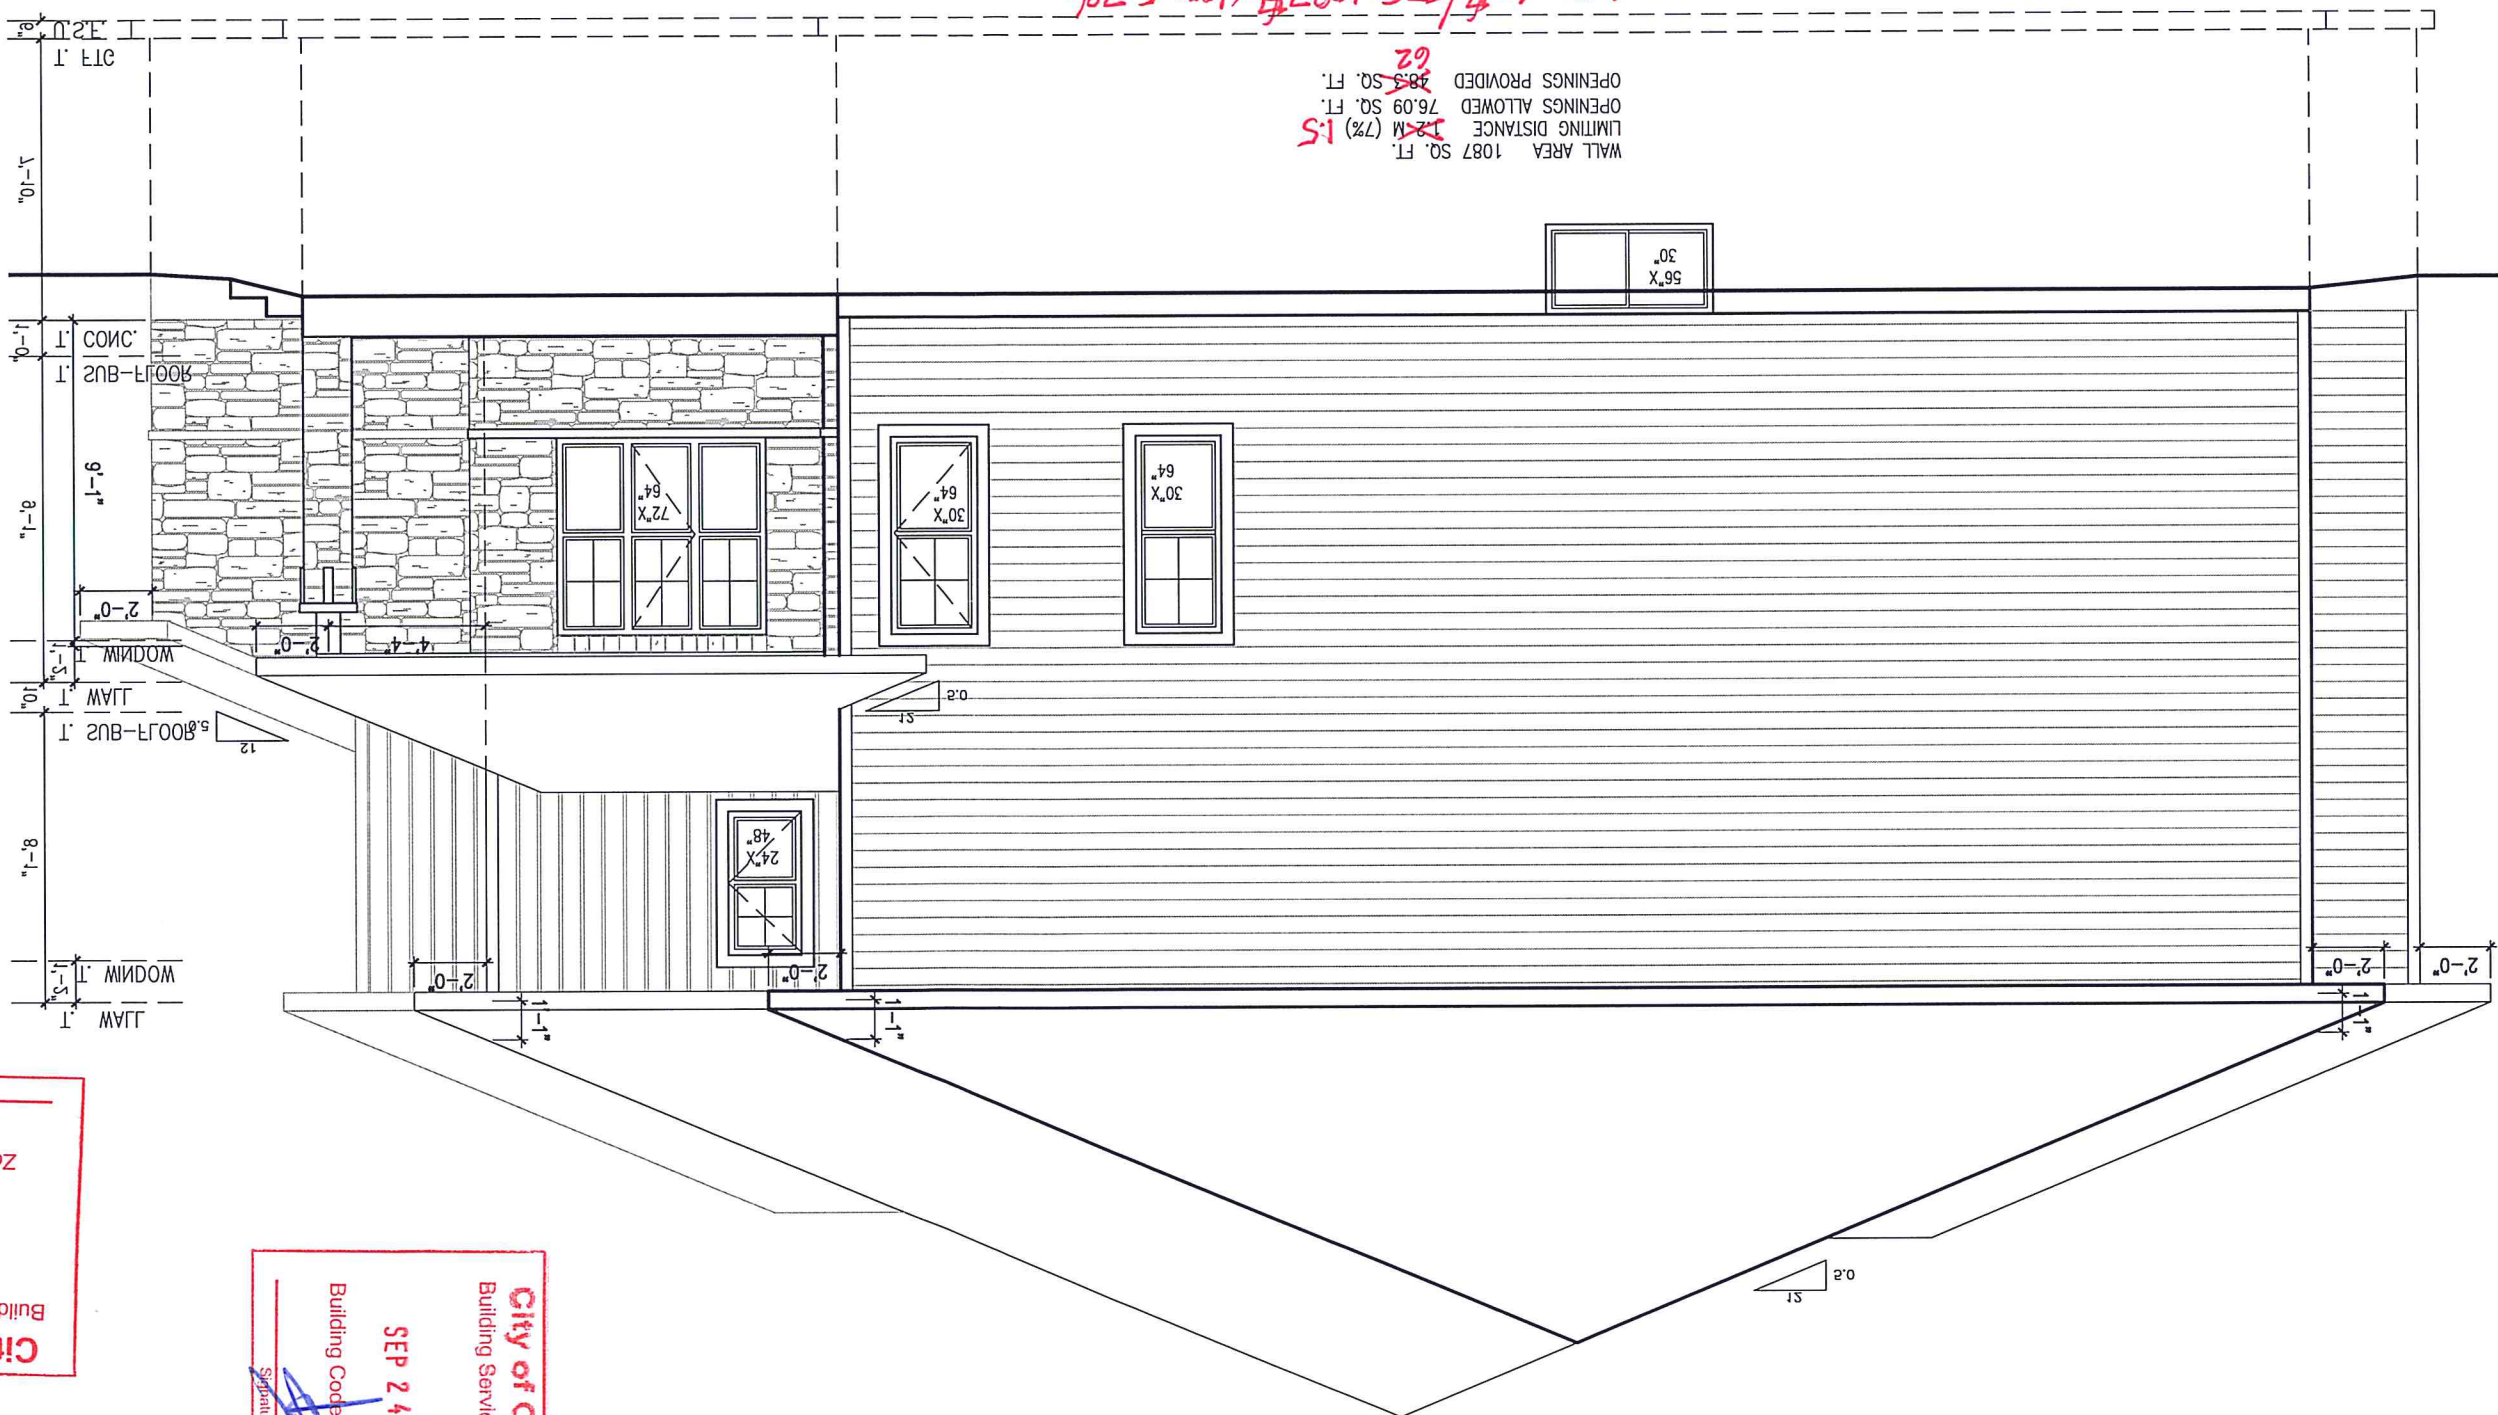

Signature

SEP 15 2021

City of Ottawa
Building Services Branch

SITE COPY

City of Ottawa
Building Services Branch

SEP 24 2021

Building Code Reviewed

Signature _____

Architectural drawing showing a cross-section of a building with a steel beam section detail. The drawing includes a roof plan, a steel beam section detail, and a floor plan. The floor plan shows a front foyer, a great room, and a bedroom. The steel beam section detail shows a cross-section of a steel beam with a concrete slab on top. The roof plan shows the layout of the roof with various dimensions and labels.

This diagram shows a cross-section of the second floor joist hanger assembly. The main components are labeled as follows:

- FACE MOUNT**: Points to the top flange of the W310X39 beam.
- JOIST HANGER**: Points to the vertical plate connecting the beam to the joists.
- THRU BOLTS @ 1/2" A307 GRADE**: Points to the bolts passing through the hanger and beam.
- 24" c.c. STAGGERED**: Indicates the staggered center-to-center spacing of the bolts.
- SOLID BLOCKING BETWEEN BEAM FLANGES**: Points to the blocking between the top and bottom flanges of the beam.
- (SHIM TIGHT)**: Points to the shims used to ensure a tight fit between the blocking and the beam flanges.

The diagram also includes a dimension of **9 1/2"** for the height of the blocking and the label **SECOND FLOOR** at the bottom.

City of Ottawa
Building Services Branch

SEP 24 2021

Building Code Reviewed

Signature _____

7	FINAL BLACKLINES	3/09/21	SP
6	ENGINEERING REVIEW	18/08/21	CB
5	BEP BLACKLINES	24/06/21	CB
4	ENSUITE TUB CHANGED TO EXHIBIT 6636	09/02/21	CB
3	STRUCTURAL REVIEW	24/11/17	SP
No.	Description	dd/mm/yy	By
REVISIONS			

footprint:	518
drawn by:	SP
date:	JUN 12/16
scale:	3/16"=1'-0"
D.C.L. - 187	
sheet no:	

POST COPY



NEWINGTON - 2018


SITE: PATHWAYS

LOT NUMBER:

CIVIC ADDRESS:
51 NUN SKIPPER DRIVE

299

NEWINGTON – 2018

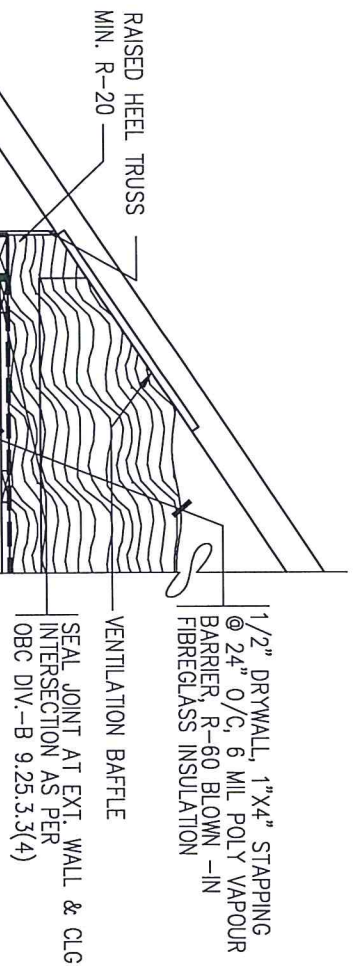

HEADER WRAP TO BE SEALED OR LAPPED TO THE WALL AIR BARRIER ABOVE AND BELOW AS PER OBC DIV.-B 9.25.3.3(8)

AIR BARRIER @ OPENINGS TO BE SEALED TO WINDOW/DOOR FRAME WITH COMPATIBLE TAPE OR SPRAY FOAM INSULATION AS PER OBC DIV.-B 9.25.3.3(11)

SIDING AS PER ELEVATION, CONT. SHEATHING MEMBRANE, 7/16" ASPENITE SHEATHING, 2X6" WOOD STUDS @ 16" O.C., R22 BATT INSULATION AND APPROVED VAPOUR BARRIER AND APPROVED CONT. AIR BARRIER 1/2" INT. DRYWALL FINISH.

SEAL JOINT AT SUBFLOOR & AROUND FLOOR JOIST AS PER OBC DIV.-B 9.25.3.3(4)

3/4" ASPENITE SUBFLOOR

ENG. FLOOR JOISTS

HEADER WRAP TO BE SEALED OR LAPPED TO THE WALL AIR BARRIER ABOVE AND BELOW AS PER OBC DIV.-B 9.25.3.3(8)

INSULATE JOIST CAVITY TO MIN. R22 AS PER SB-12 [3.1.1.1 (14)]

SEAL JOINT AT EXT. WALL & CEILING INTERSECTION AS PER OBC DIV.-B 9.25.3.3(4)

1/2" DRYWALL

6 MILL POLY VAPOUR BARRIER 2"x6" STUDS @ 16" O/C R-22 FIBREGLASS BATT INSULATION 7/16" ASPENITE SHEATHING HOUSE WRAP AIR BARRIER VINYL SIDING

INSULATE JOIST CAVITY TO MIN. R22 AS PER SB-12 [3.1.1.1 (14)]

SEAL JOINT AT SUBFLOOR & AROUND FLOOR JOIST AS PER OBC DIV.-B 9.25.3.3(4)


3/4" ASPENITE SUBFLOOR
HEADER WRAP TO BE SEALED OR LAPPED TO THE WALL AIR BARRIER ABOVE AND BELOW AS PER OBC DIV.-B 9.25.3.3(8)
ENG. FLOOR JOISTS

FOUNDATION WALLS ENCLOSING HEATED SPACE SHALL BE INSULATED FROM THE UNDERSIDE OF THE SUBFLOOR TO NOT MORE THAN 8" ABOVE THE FINISHED FLOOR OF THE BASEMENT.


MINIMUM EFFECTIVE RSI VALUE FOR BASEMENT WALLS
ASSEMBLY CALCULATED AS FOLLOWS:

APPROVED DAMPROOFING= 8" CONCRETE WALL (*)= 0.0 RSI
FELT PAPER BARRIER= 0.0 RSI
3 1/2" OF CONTINUOUS R12 BATT INSULATION (*)= 2.11 RSI
2X4 WALL @ 24" o/c w/ R10 BATT (**) = 1.5 RSI
6mil POLY VAPOUR BARRIER= 0.0 RSI
AIR FILM (*)= 0.12 RSI
TOTAL CALCULATED RSI VALUE= 3.81 RSI


(*) VALUE FROM NRCAN TABLE CM-1
(**) VALUE FROM NRCAN TABLE WB-1

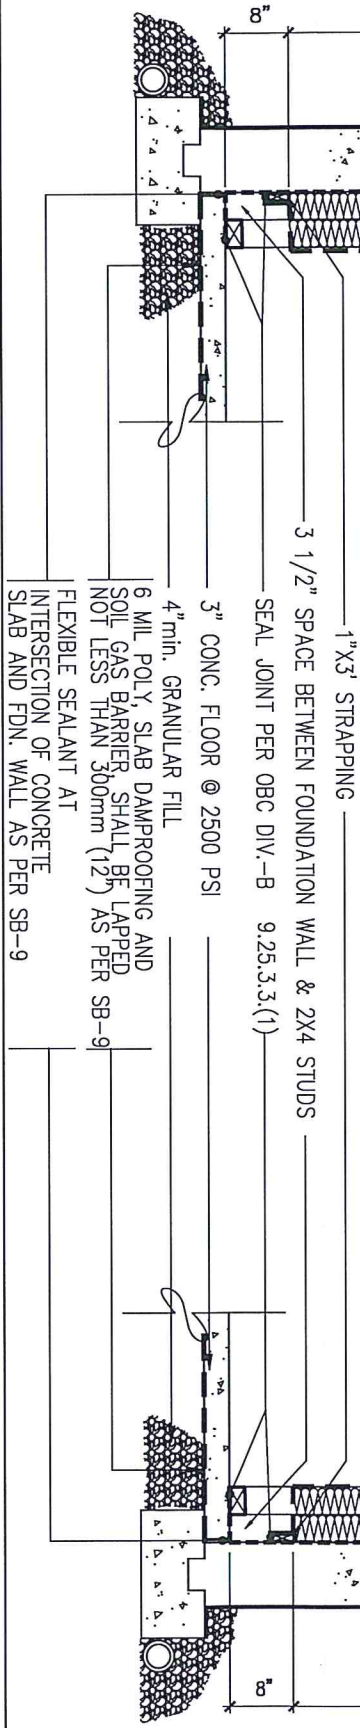

NOTES:
MECHANICAL SPACE HEATING EQUIPMENT AS PER COMPLIANCE PACKAGE A1 OF SB-12 [TABLE 3.1.2.A(IP)]
AIR BARRIERS AS PER OBC 9.25.3
ALL JOINTS TO HAVE A MIN. OVERLAP OF 4"
ALL JOINTS TAPED TO MANUFACTURER'S SPECIFICATIONS
ALL FASTENERS AS PER MANUFACTURER'S SPECIFICATIONS
ALL PENETRATIONS SEALED TO MAINTAIN A CONTINUOUS AIR BARRIER
NOTES FROM OBC SB-9 SECTION 3.3 (SEALING THE PERIMETER & PENETRATIONS)
(1) A FLOOR-ON-GROUND SHALL BE SEALED AROUND ITS PERIMETER TO THE INNER SURFACES OF ADJACENT WALL USING FLEXIBLE SEALANT.
(2) ALL PENETRATIONS OF A FLOOR-ON-GROUND BY PIPES OR OTHER OBJECTS SHALL BE SEALED AGAINST SOIL GAS LEAKAGE.
(3) ALL PENETRATIONS OF A FLOOR-ON-GROUND THAT ARE REQUIRED TO DRAIN WATER FROM THE FLOOR SURFACE SHALL BE SEALED IN A MANNER THAT PREVENTS THE UPWARD FLOW OF SOIL GAS WITHOUT PREVENTING THE DOWNWARD FLOW OF LIQUID WATER.

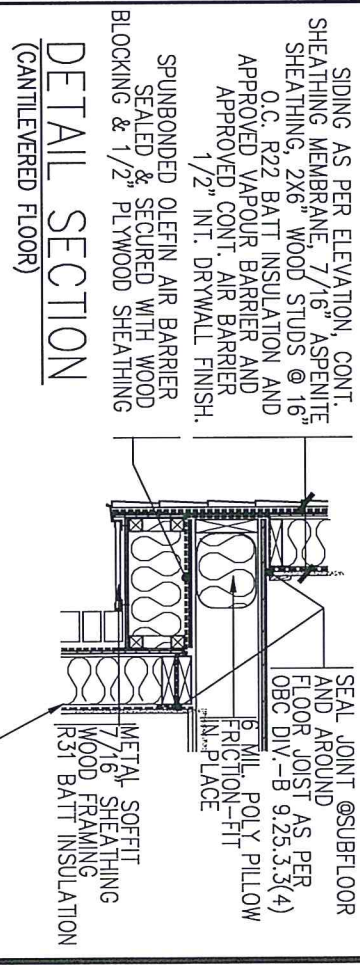

DETAIL SECTION
(CANTILEVERED FLOOR)

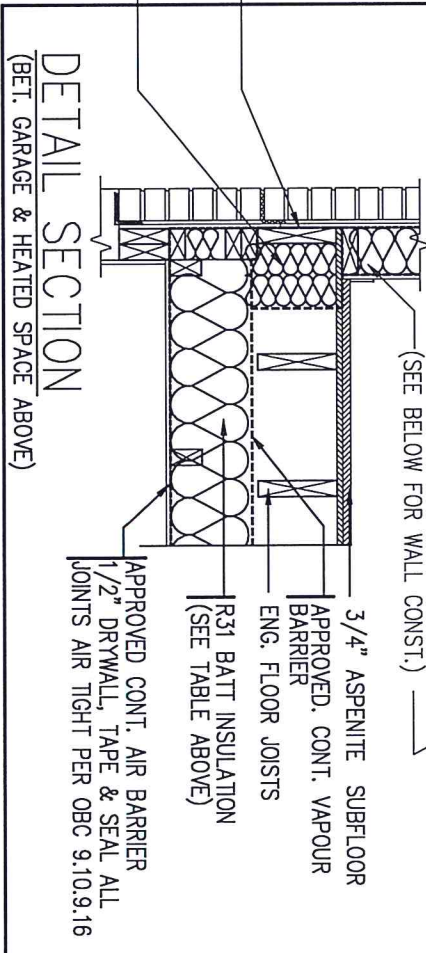


DETAIL SECTION
(TYP. GARAGE & HEATED SPACE ABOVE)

City of Ottawa
Building Services Branch
SEP 24 2021
Building Code Reviewed
Signature

TYP. DETAIL SECTION
FOR SIDING APPLICATION


SB-12 COMPLIANCE PACKAGE
DETAILS (ALL MODELS)

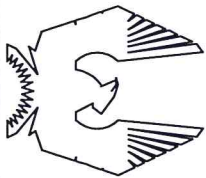


PHOENIX HOMES

No.	Description	Date	By
1	OBC SB-9 & SB-12 COMPLIANCE PACKAGE	JAN22-12	TL
2	ADDED CANTILEVERED FLOOR DETAIL	MAR28-12	TL
3	SB-12 - 2017 UPDATE	JAN - 2017	SP

footprint:	SP
drawn by:	SP
date:	
scale:	N/A
sheet no:	SB-12 DETAILS

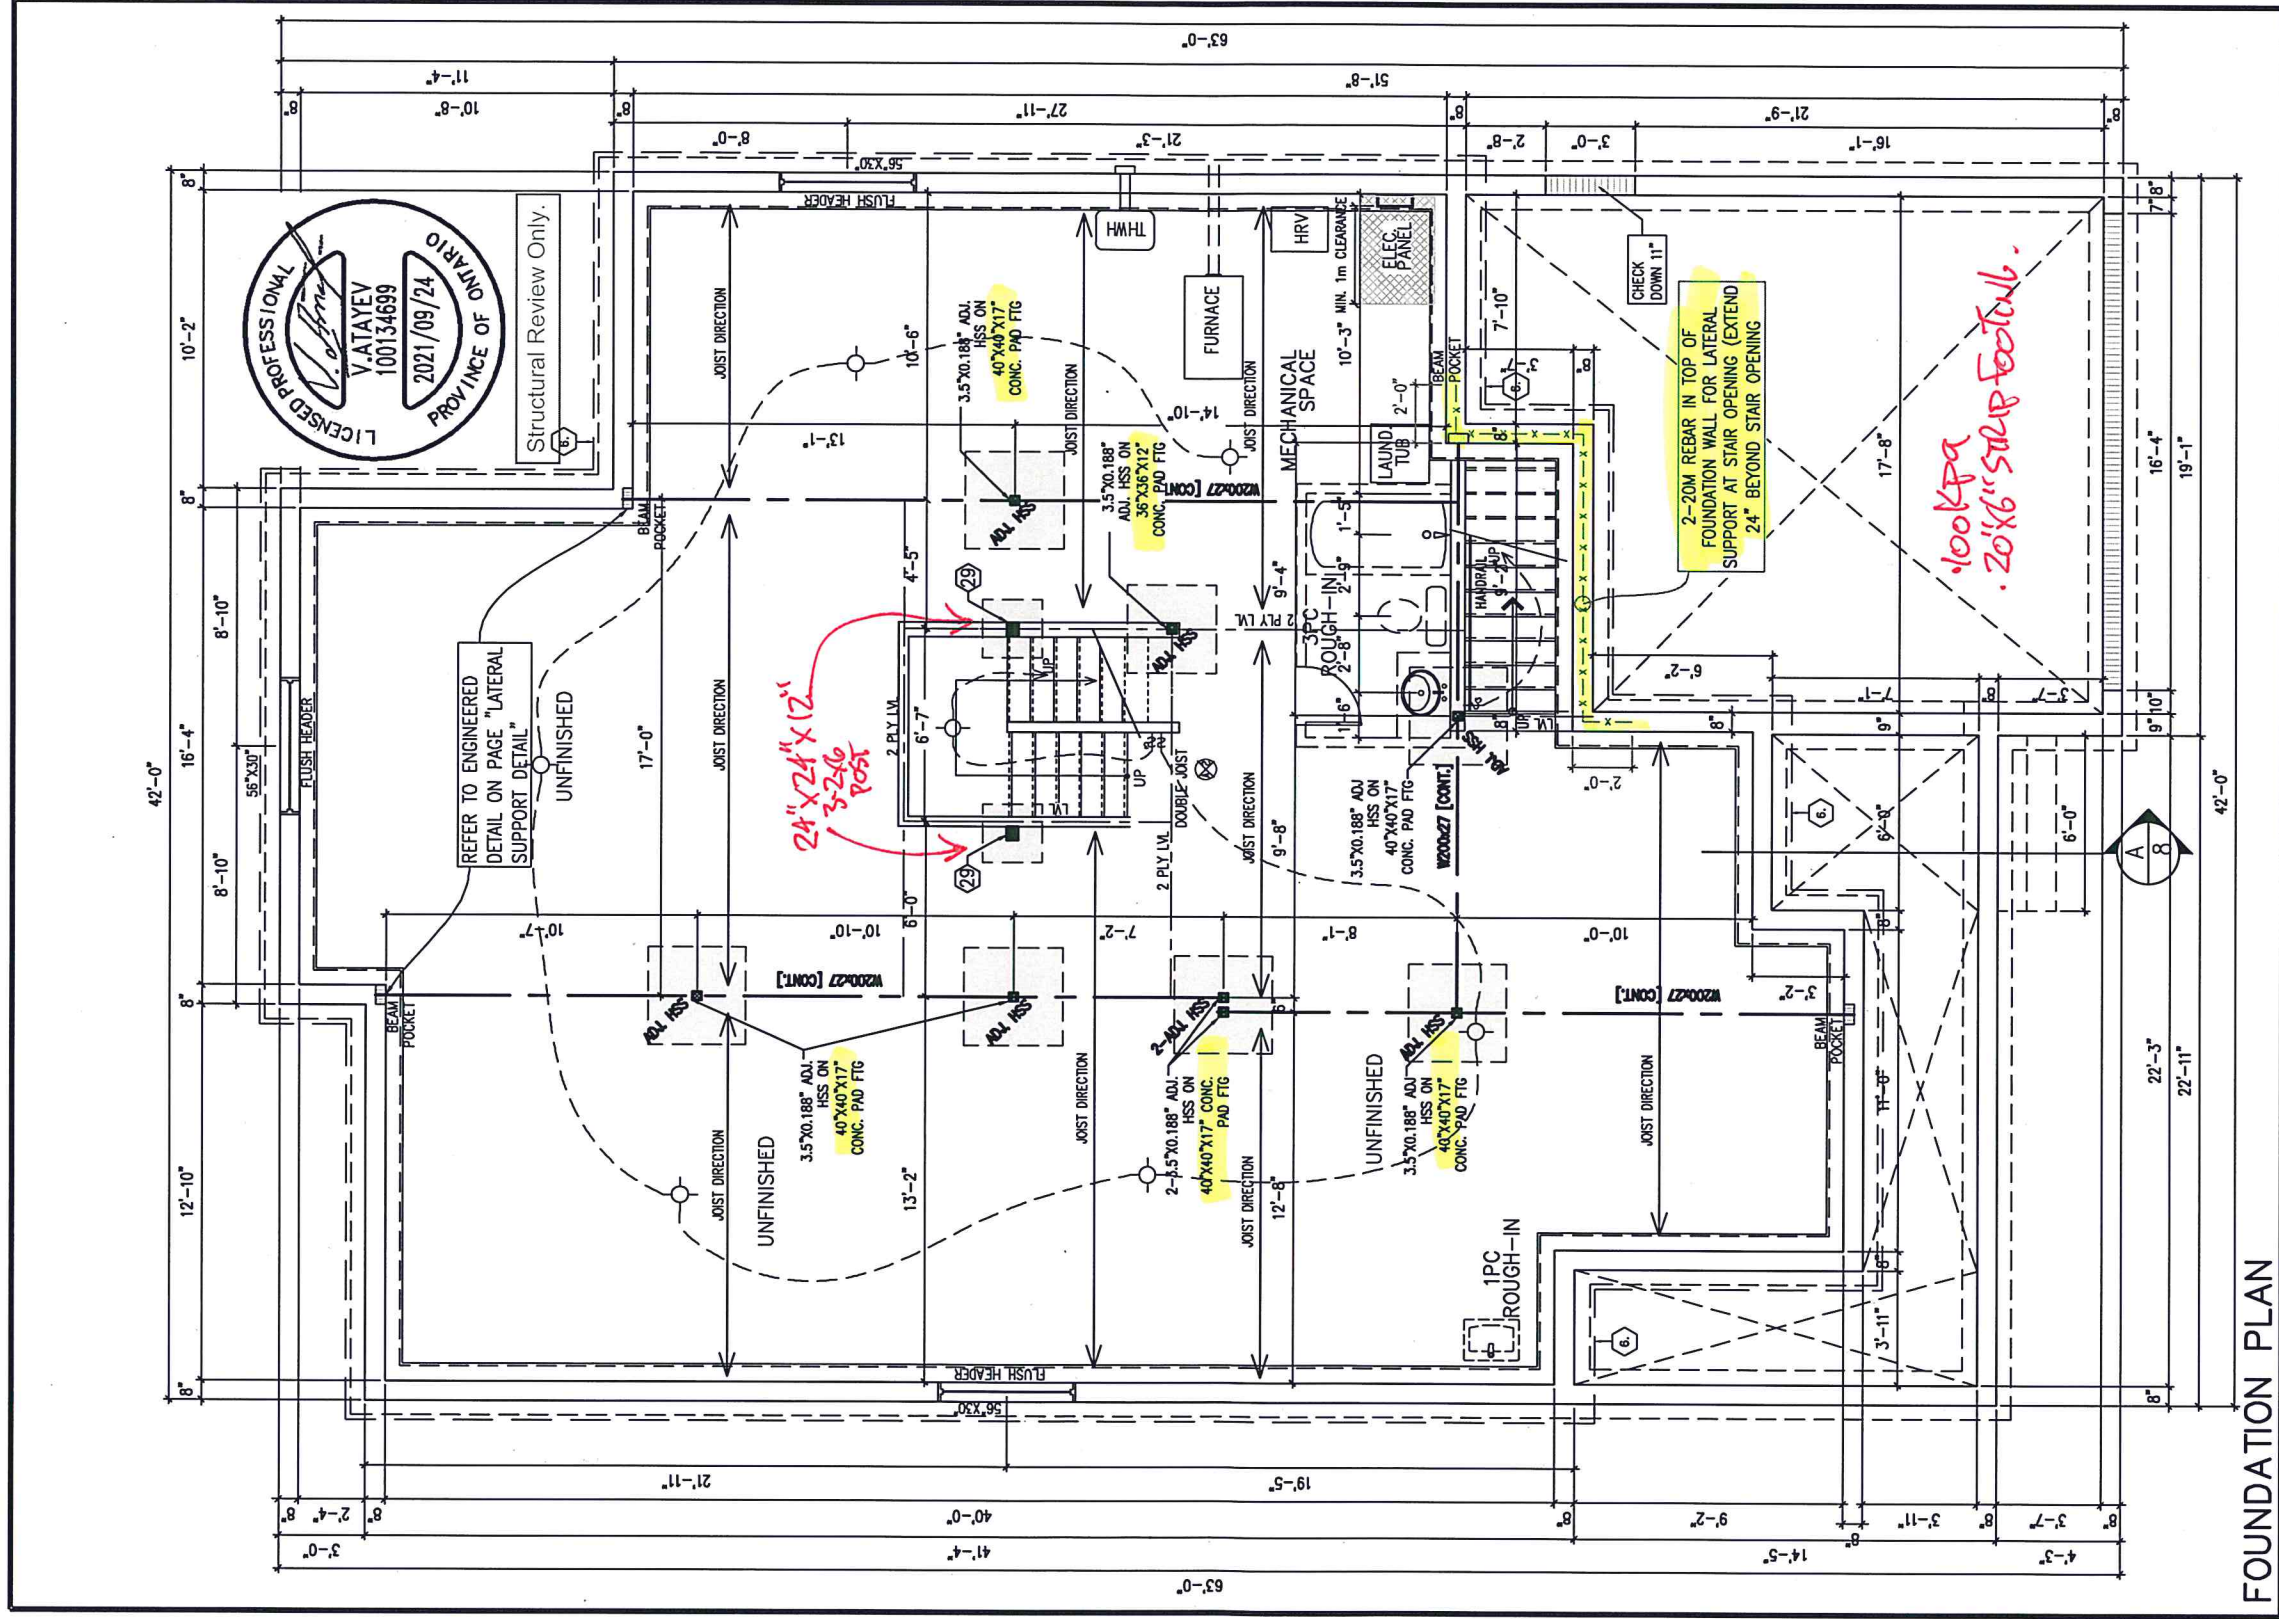

FOUNDATION PLAN

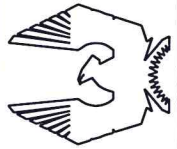

PHOENIX HOMES

NEWINGTON – 2018

SITE: PATHWAYS

LOT NUMBER:
CIVIC ADDRESS:
51 DUN SKIPPER DRIVE

299

8	STRUCTURAL REVIEW	22/09/21	SP
7	FINAL BLACKLINES	3/09/21	SP
6	ENGINEERING REVIEW	18/08/21	CS
5	BEP BLACKLINES	24/06/21	CS
4	ENSUITE TUB CHANGED TO EXHIBIT 6636	09/02/21	CS
3	STRUCTURAL REVIEW	24/11/17	SP
No. Description		dd/mm/yy	By
REVISIONS			
footprint:		518	
drawn by:		SP	
date:		JUN 12/16	
scale:		3/16"=1'-0"	
D.C.L. – 187		2 of 8	
sheet no:			

City of Ottawa
Building Services Branch

SEP 2 4 2021

Building Code Reviewed

Signature

City of Ottawa
Building Services Branch

SEP 2 4 2021


Zoning Reviewed

Signature

City of Ottawa
Centrepointe Dr.


SEP 2 4 2021

BCSB

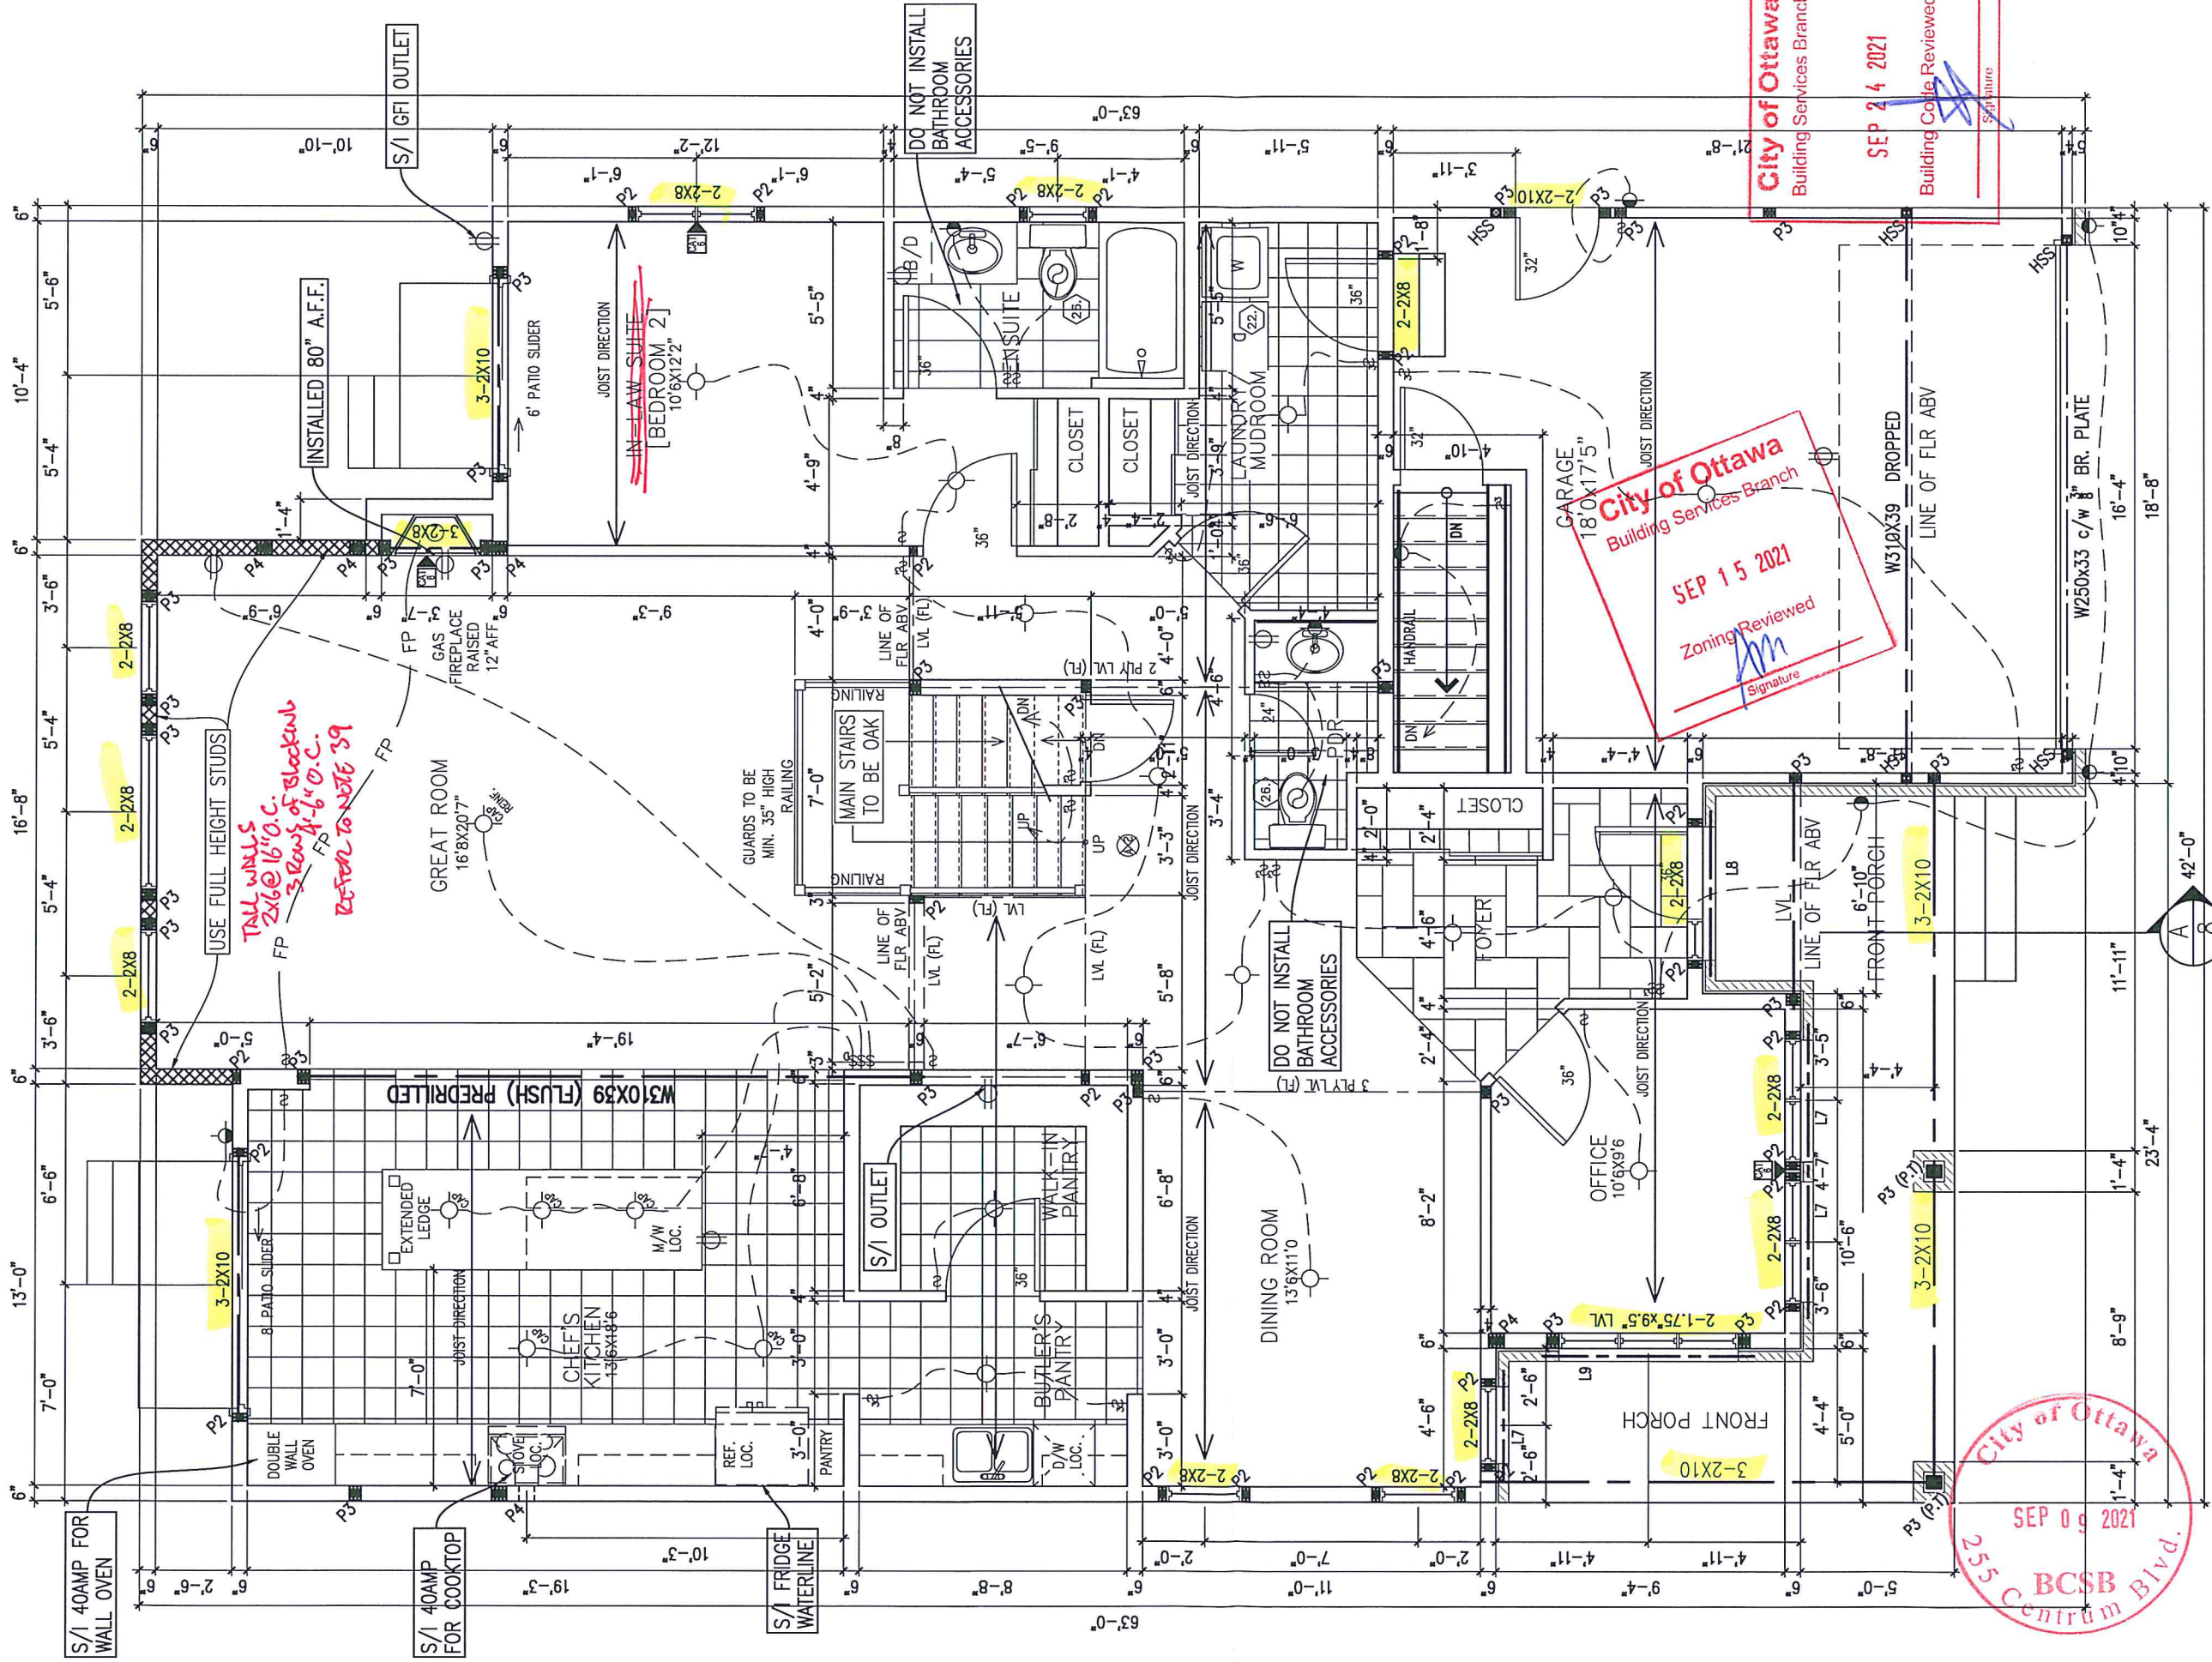

GROUND FLOOR PLAN (ELEVATION C)

SITE COPY

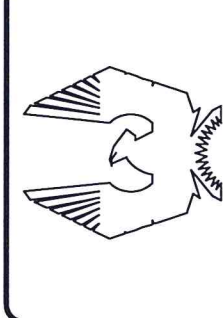


PHOENIX HOMES

NEWINGTON - 2018
SITE: PATHWAYS
LOT NUMBER: 299
CIVIC ADDRESS: 51 DUN SKIPPER DRIVE

7	FINAL BLACKLINES	3/09/21	SP
6	ENGINEERING REVIEW	18/08/21	CB
5	BEP BLACKLINES	24/06/21	CB
4	ENSUITE TUB CHANGED TO EXHIBIT 6636	09/02/21	CB
3	STRUCTURAL REVIEW	24/11/17	SP
No.	Description	dd/mm/yy	By
REVISIONS			

footprint:	518
drawn by:	SP
date:	JUN 12/16
scale:	3/16"=1'-0"
D.C.L. - 187	
sheet no:	3 of 8

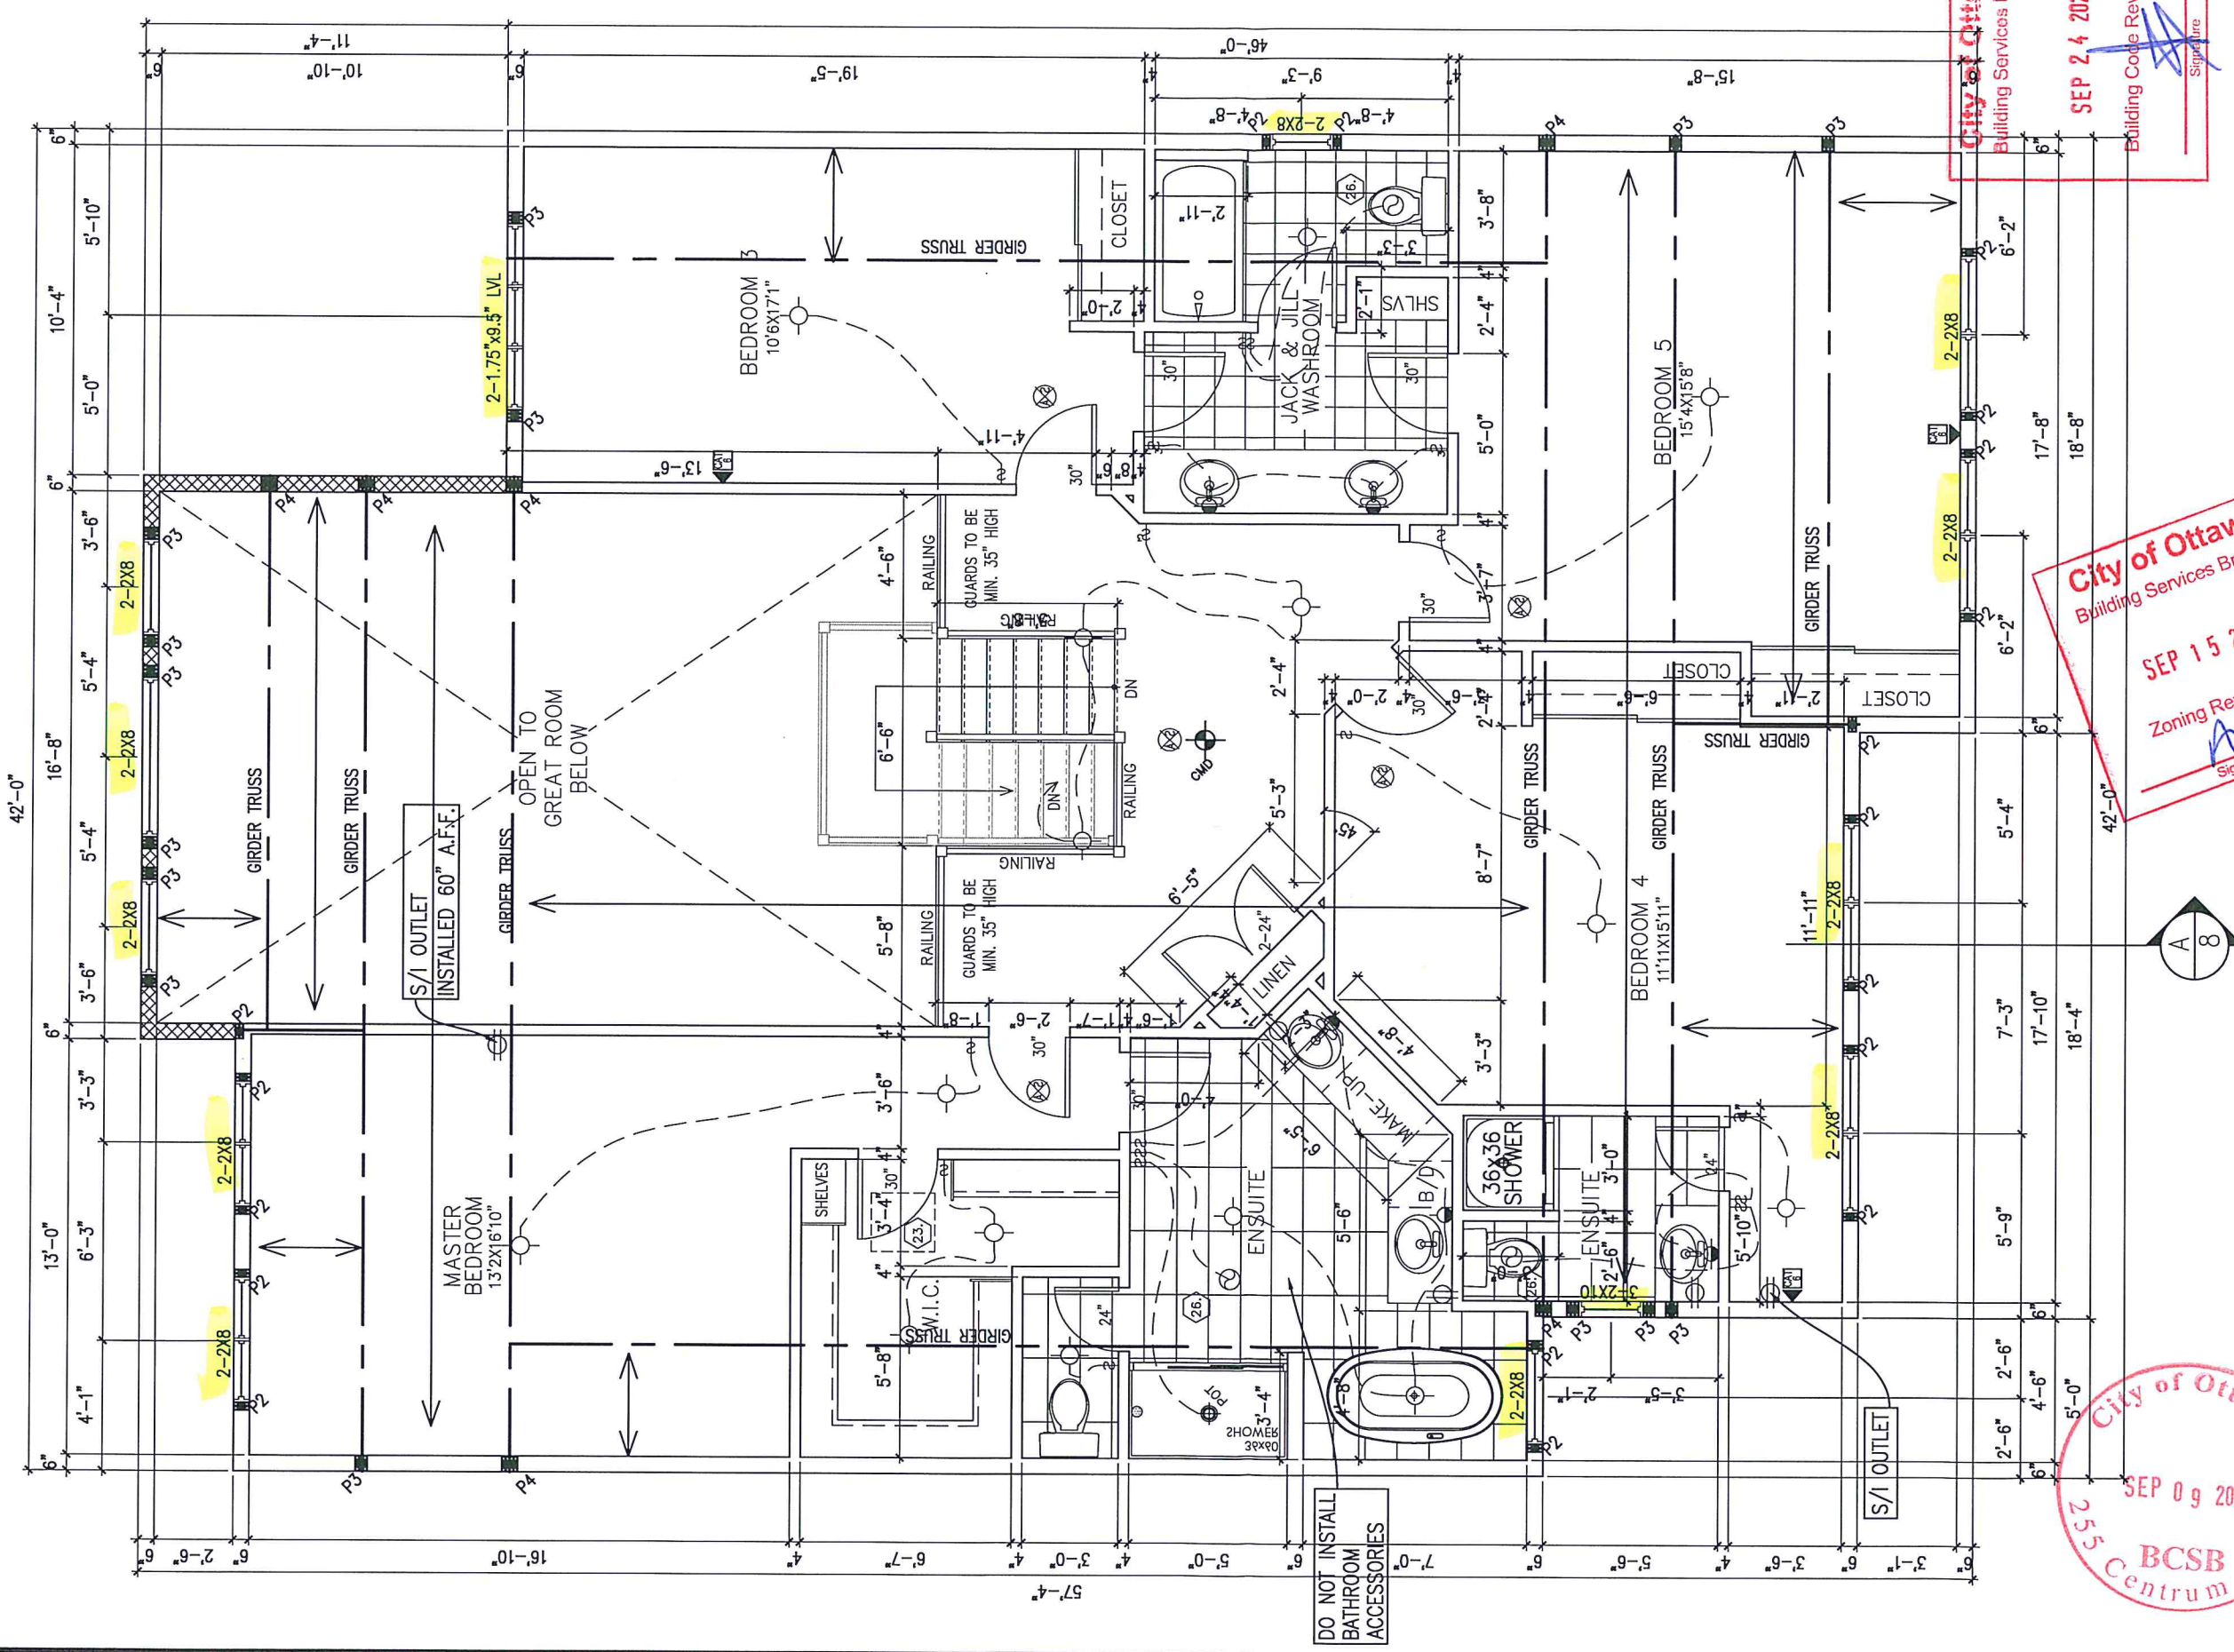

City of Ottawa
Building Services Branch
SEP 24 2021
Building Code Reviewed

City of Ottawa
Building Services Branch
SEP 15 2021
Zoning Reviewed

SECOND FLOOR PLAN (ELEVATION C)

SITE COPY

footprint:	518
drawn by:	SP
date:	JUN 12/16
scale:	3/16"=1'-0"
D.C.L. - 187	
sheet no:	4 of 8

No.	Description	dd/mm/yy	By
7	FINAL BLACKLINES	3/09/21	SP
6	ENGINEERING REVIEW	18/08/21	CB
5	BEP BLACKLINES	24/06/21	CB
4	ENSUITE TUB CHANGED TO EXHIBIT 6636	09/02/21	CB
3	STRUCTURAL REVIEW	24/11/17	SP
REVISIONS			

NEWINGTON - 2018

SITE: PATHWAYS

LOT NUMBER: 299

CIVIC ADDRESS: 51 DUN SKIPPER DRIVE

PHOENIX HOMES

SEP 09 2021

BCSB