




in-law ensuite tile
example - for shower

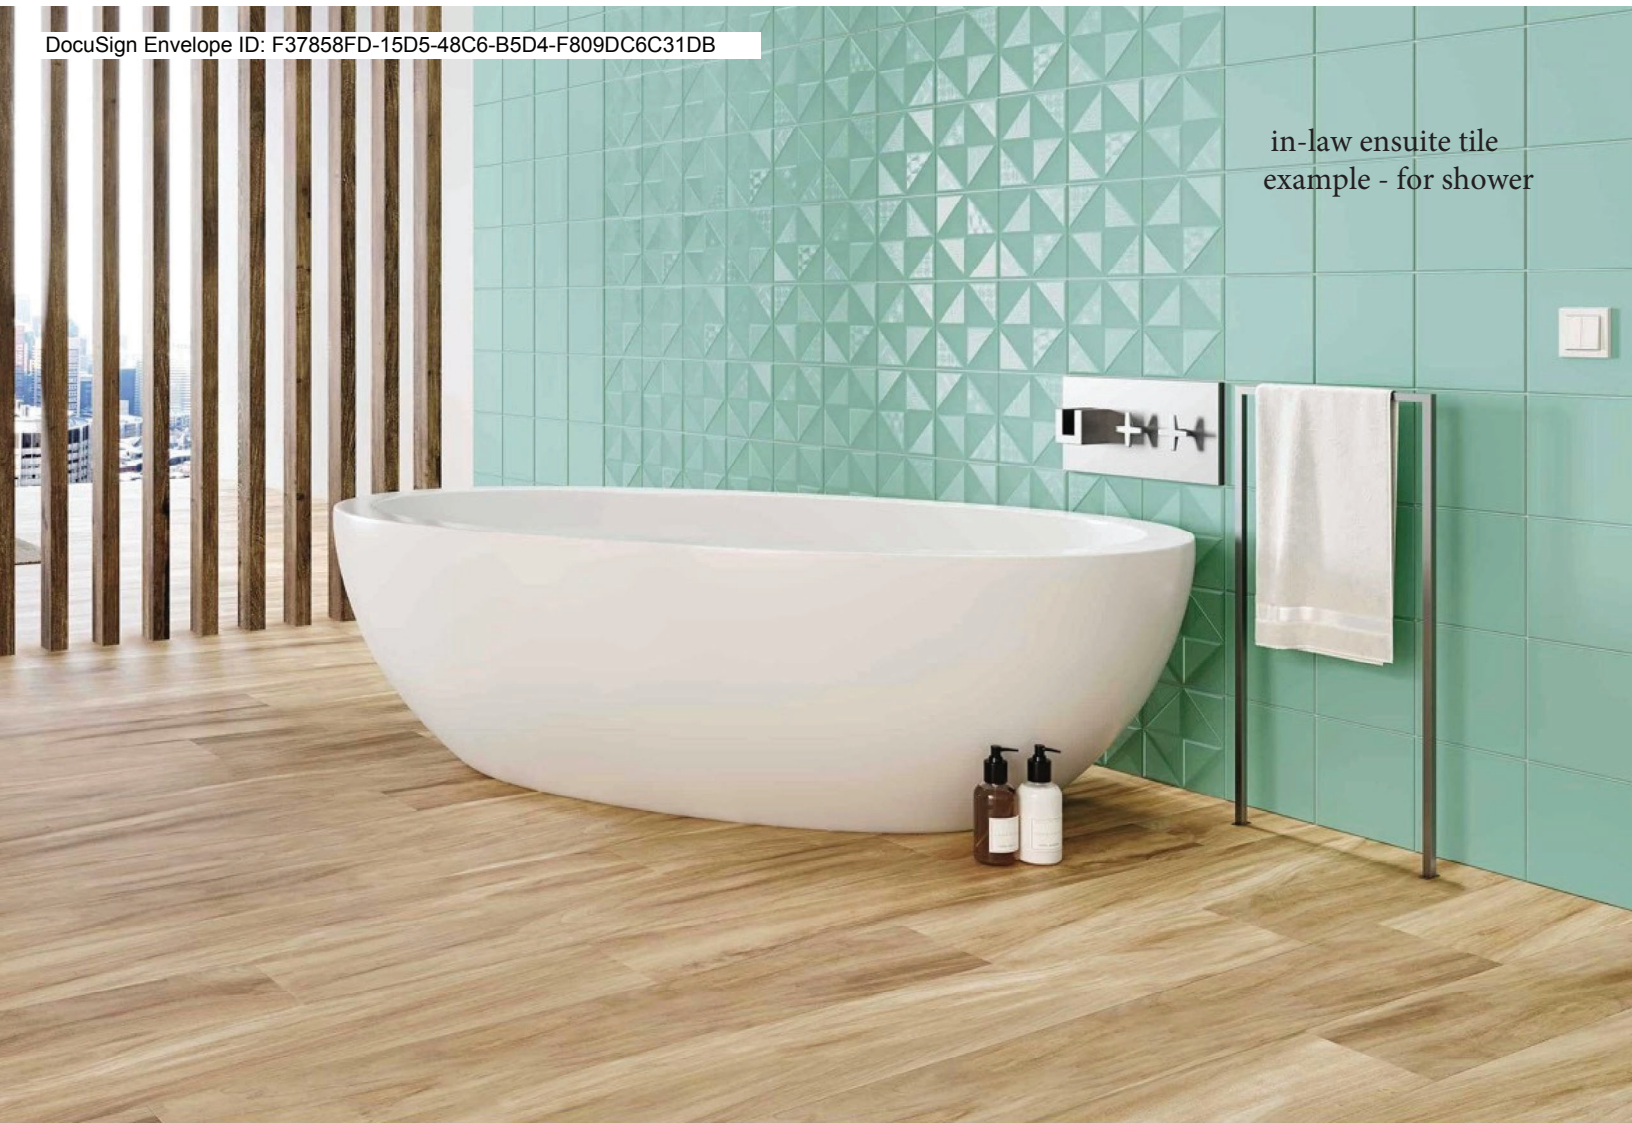


Visit

Ceratec Surfaces. Prisma


Images may be subject to copyright. **Learn More**

→ Show all images of prisma decor prat...

Related images

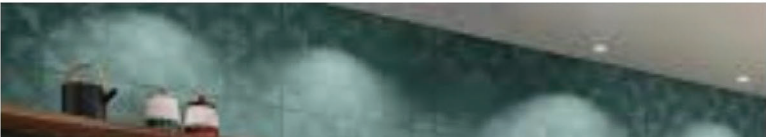

Mudroom Tile Pattern - *Border
tiles -Olympia-Marrakesh series
7.32 x 7.32 -Matte Anthracite.
*Center tiles - Marrakesh series
7.32 x 7.32 -matte decor mix 1 -
stacked

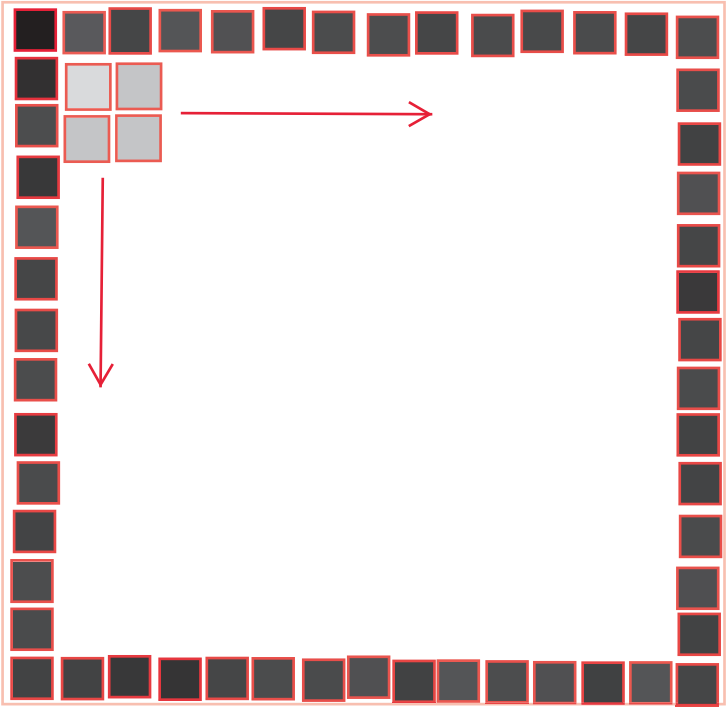

DS
MJD

DS
[Signature]

FOR BEP
B.E.P.

9' SECOND FLOOR

two-headed spotlight

two-headed spotlight

Additional - 2-Light cylinder wall sconce

DS
M.J.L. DS

9' FOUNDATION PC

SIDE ELEVATION M

FOR BEP ONLY
- D

E.& O.E. / FOR REFERENCE ONLY
SUBJECT TO CHANGES

9' FLOOR