


City of Ottawa
Building Services Branch

REVIEWED
By Nicholas Winn at 9:37 am, May 26, 2022

[Handwritten Signature]
Signature

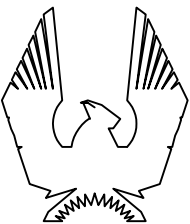

256

9	STRUCTURAL REVIEW	MAY-2-22	SP
8	FINAL BLACKLINES	FEB-9-22	GK
7	BEP BLACKLINES	NOV-25-21	KE
6	STRUCTURAL REVIEW	JUN-25-19	SP
5	ADD GARAGE WALL HEIGHTS	SEP-20-18	SP
No.	Description	Date	By
REVISIONS			

2


9

City of Ottawa
Building Services Branch

REVIEWED
By Nicholas Winn at 9:37 am, May 26, 2022


Building Code Reviewed


Signature

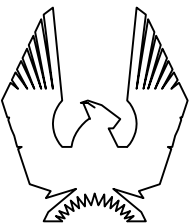

9	STRUCTURAL REVIEW	MAY-2-22	SP
8	FINAL BLACKLINES	FEB-9-22	GK
7	BEP BLACKLINES	NOV-25-21	KE
6	STRUCTURAL REVIEW	JUN-25-19	SP
5	ADD GARAGE WALL HEIGHTS	SEP-20-18	SP
No.	Description	Date	By
REVISIONS			

$$\frac{3B}{9}$$

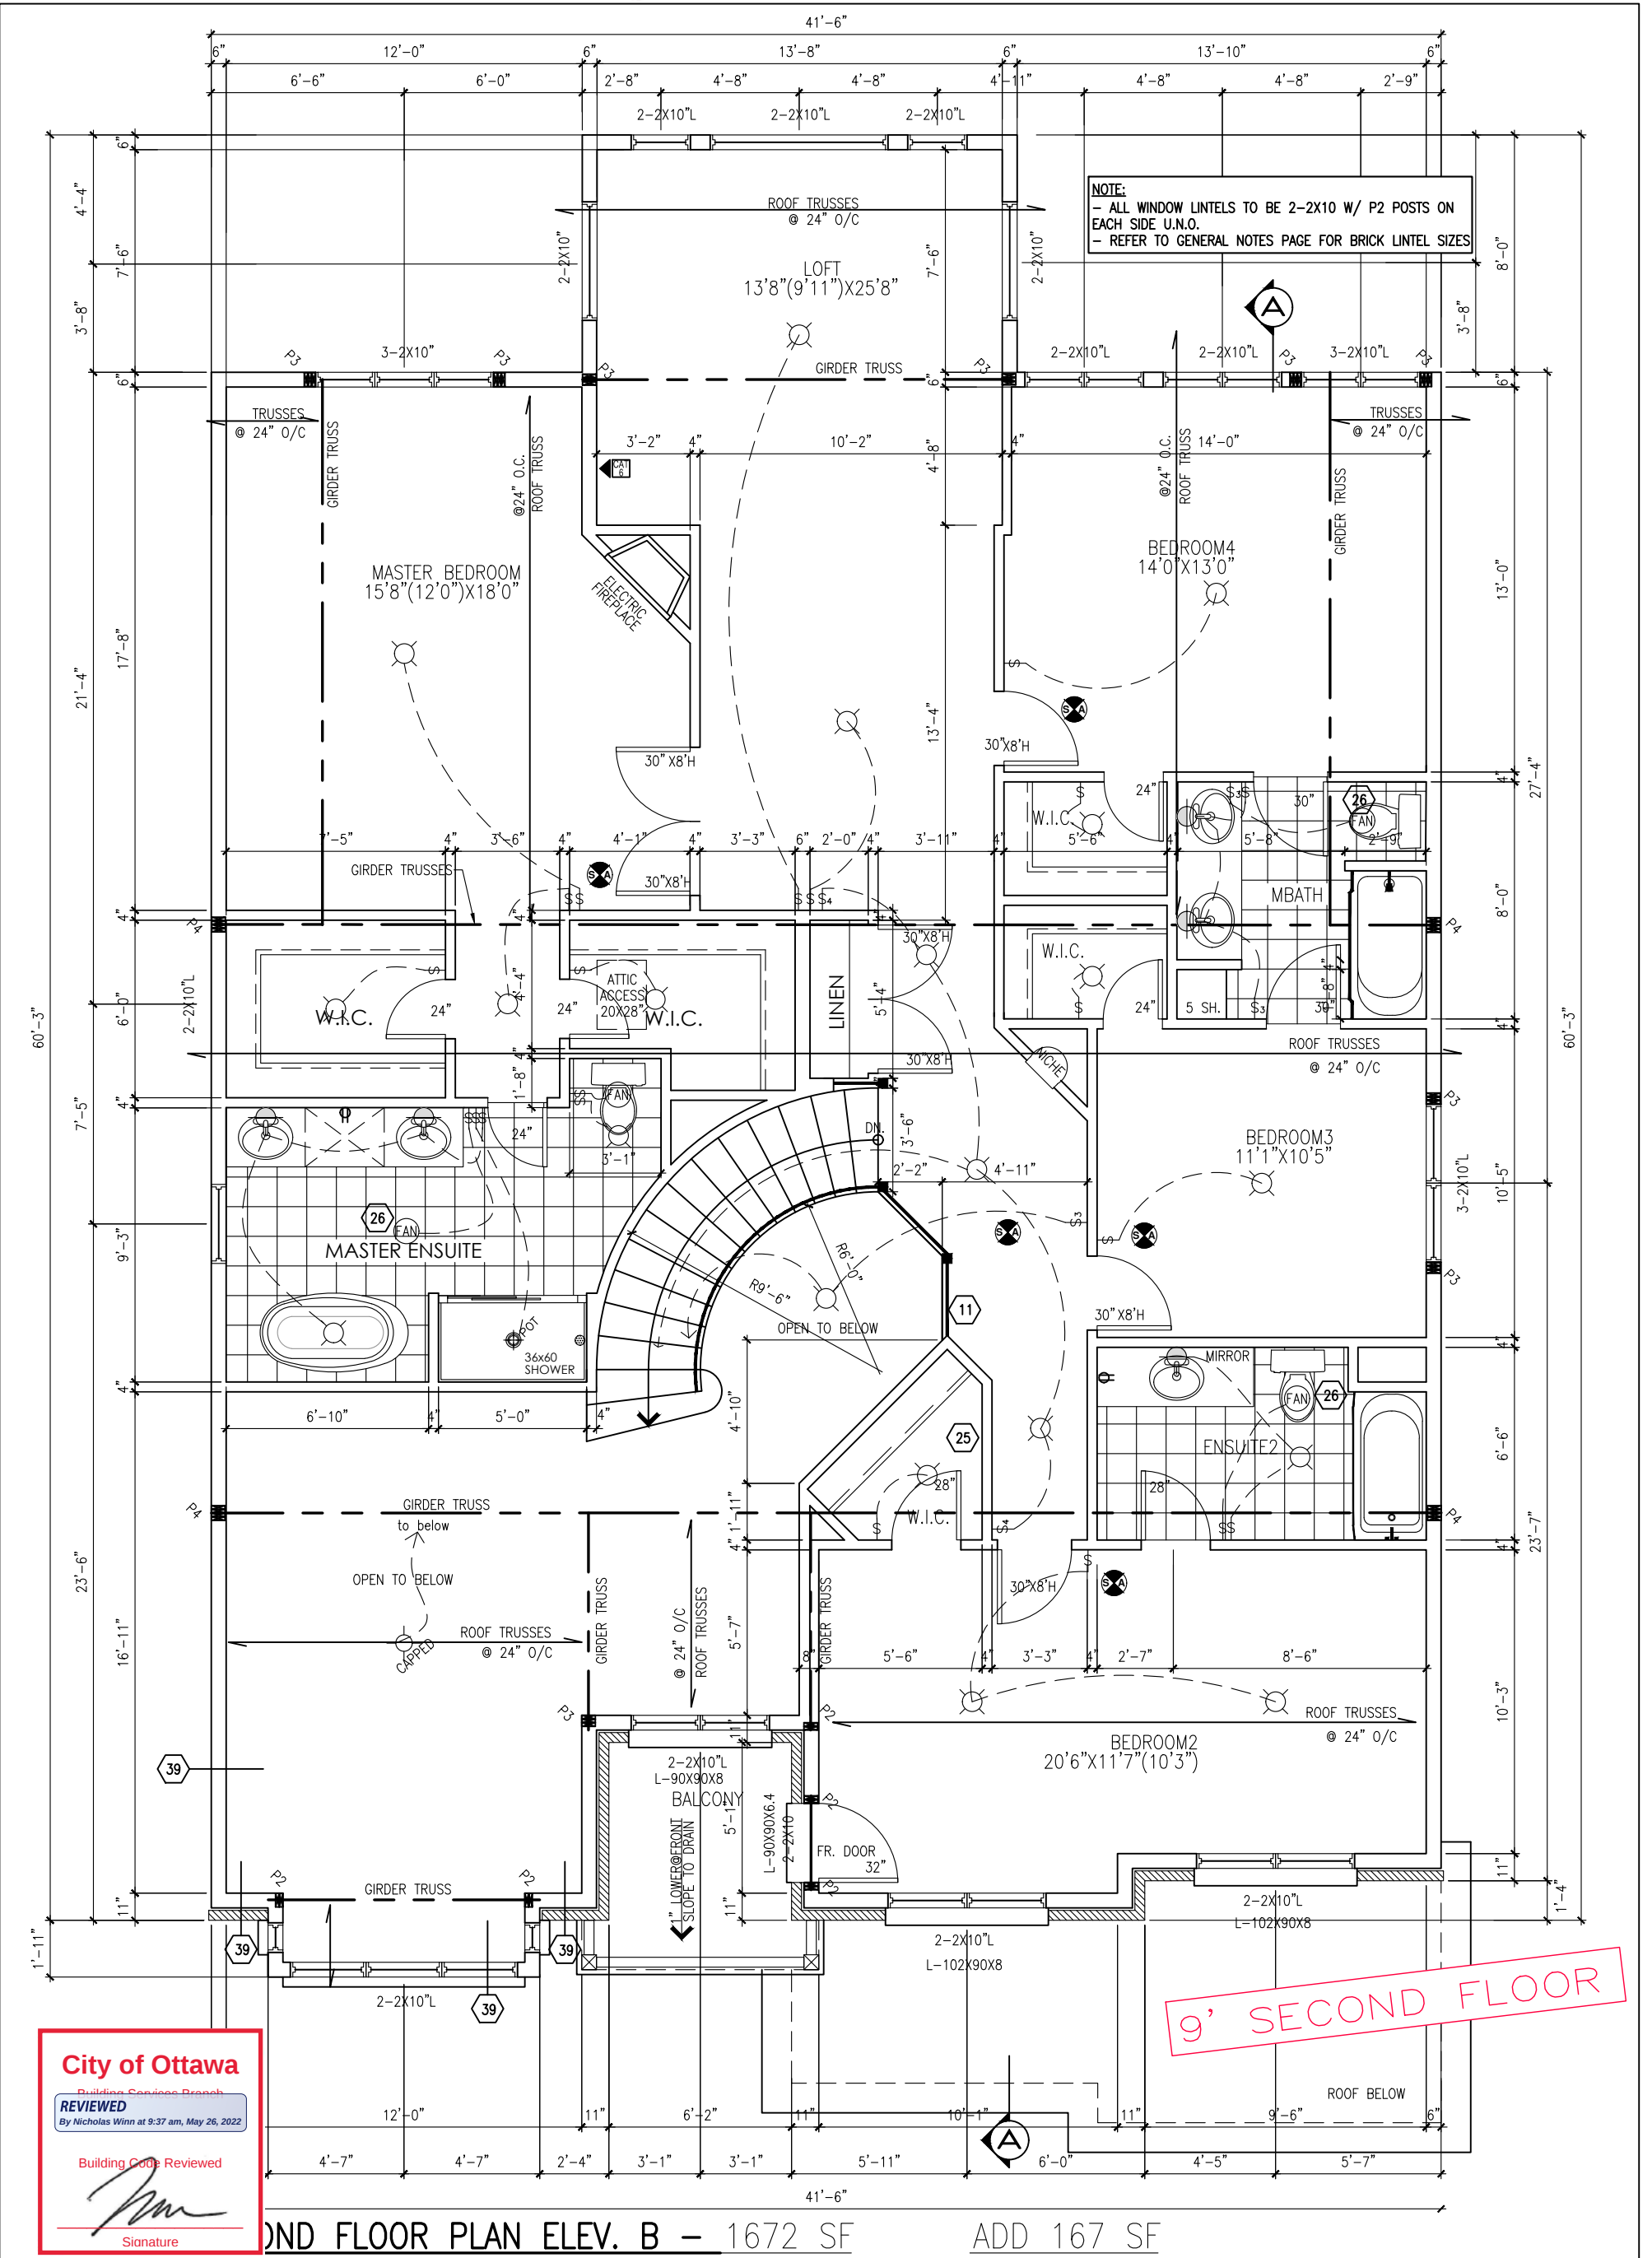

City of Ottawa

Building Services Branch

REVIEWED

By Nicholas Winn at 9:37 am, May 26, 2022

Building Code Reviewed

Signature

SECOND FLOOR PLAN ELEV. B – 1672 SF

ADD 167 SF



ANNAPOLIS-2019-B

SITE:PATHWAYS PH2

LOT NUMBER:

256

CIVIC ADDRESS:

306 SPREADING WAY

9	STRUCTURAL REVIEW	MAY-2-22	SP
8	FINAL BLACKLINES	FEB-9-22	GK
7	BEP BLACKLINES	NOV-25-21	KE
6	STRUCTURAL REVIEW	JUN-25-19	SP
5	ADD GARAGE WALL HEIGHTS	SEP-20-18	SP
No.	Description	Date	By
REVISIONS			

file number: 509

drawn by: T.L.

date: DEC. 2012

scale: 3/16"=1'


DCL-192 sheet no:

11

4B

9

TO BE READ IN CONJUNCTION WITH MASTER FOOTPRINTED PLANS

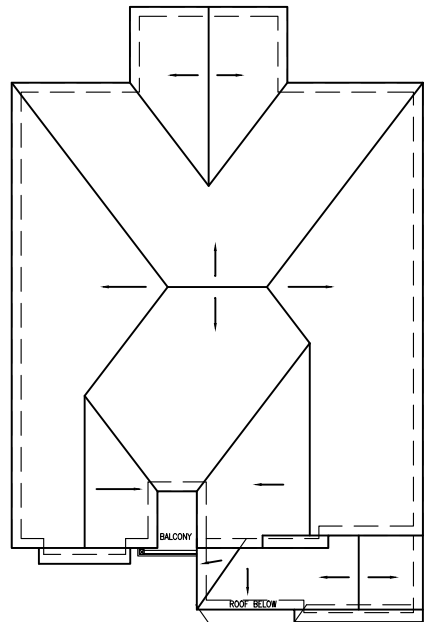

ROOF PLAN-B NTS

9' SECOND FLOOR

CONTRACTOR MUST VERIFY ALL DIMENSIONS ON THE JOB AND REPORT ANY DISCREPANCY TO DCR/PHOENIX BEFORE PROCEEDING WITH THE WORK. ALL DRAWINGS AND SPECIFICATIONS ARE INSTRUMENTS OF SERVICE AND THE PROPERTY OF THE DCR/PHOENIX WHICH MUST BE RETURNED AT THE COMPLETION OF THE WORK. ALL DRAWINGS TO BE USED FOR CONSTRUCTION ONLY AFTER BUILDING PERMIT HAS BEEN ISSUED. DO NOT SCALE DRAWINGS, USE DIMENSIONS PROVIDED.



FRONT ELEVATION 'B'



ANNAPOLIS-2019-B

SITE:PATHWAYS PH2

LOT NUMBER:

256

CIVIC ADDRESS:

306 SPREADWING WAY

No.	Description	Date	By
9	STRUCTURAL REVIEW	MAY-2-22	SP
8	FINAL BLACKLINES	FEB-9-22	GK
7	BEP BLACKLINES	NOV-25-21	KE
6	STRUCTURAL REVIEW	JUN-25-19	SP
5	ADD GARAGE WALL HEIGHTS	SEP-20-18	SP
REVISIONS			

file number: 509

drawn by: T.L.

date: DEC. 2012

scale: 3/16"=1'

DCL-192

sheet no:

12

5B

9

City of Ottawa

Building Services Branch

REVIEWED


By Nicholas Winn at 9:37 am, May 26, 2022

Building Code Reviewed

Signature

TO BE READ IN CONJUNCTION WITH MASTER FOOTPRINTED PLANS

9' SECOND FLOOR

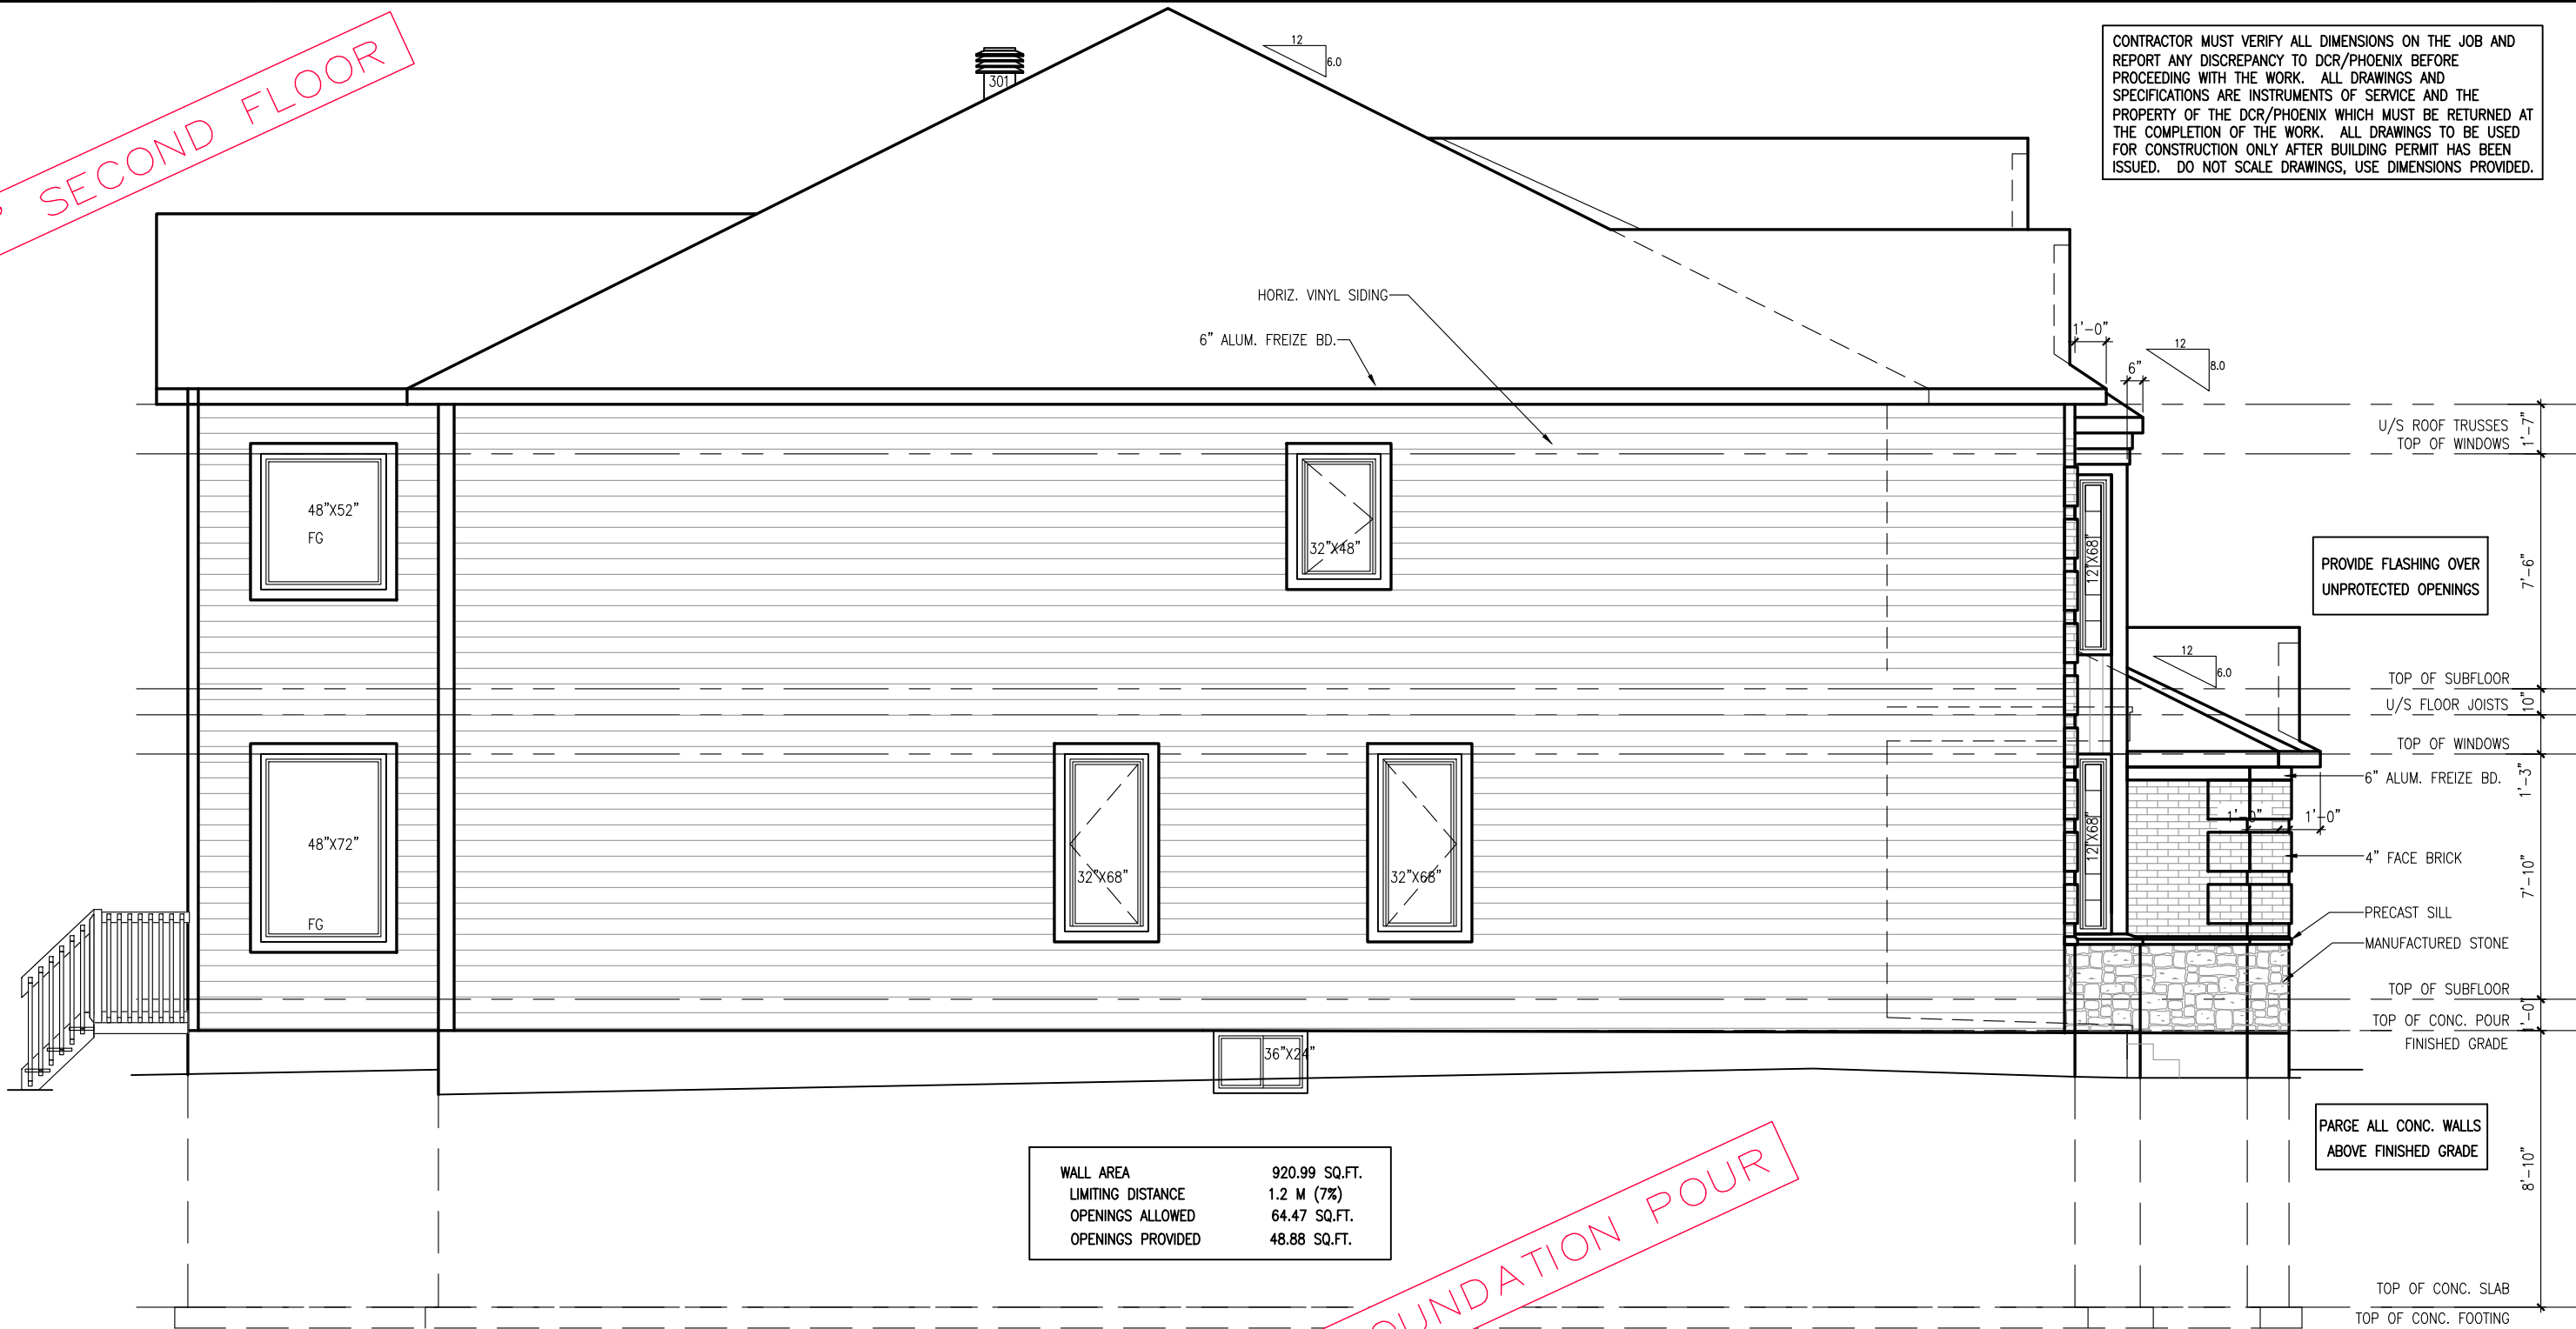

LEFT SIDE ELEVATION 'B'

9' FOUNDATION POUR



ANNAPOLIS-2019-B

SITE: PATHWAYS PH2

LOT NUMBER: 256

CIVIC ADDRESS: 306 SPREADWING WAY

9	STRUCTURAL REVIEW	MAY-2-22	SP
8	FINAL BLACKLINES	FEB-9-22	GK
7	BEP BLACKLINES	NOV-25-21	KE
6	STRUCTURAL REVIEW	JUN-25-19	SP
5	ADD GARAGE WALL HEIGHTS	SEP-20-18	SP
No.	Description	Date	By
REVISIONS			

file number: 509

drawn by: T.L.

date: DEC. 2012


scale: 3/16"=1'

DCL-192 sheet no: 13

6B 9



TO BE READ IN CONJUNCTION WITH MASTER FOOTPRINTED PLANS

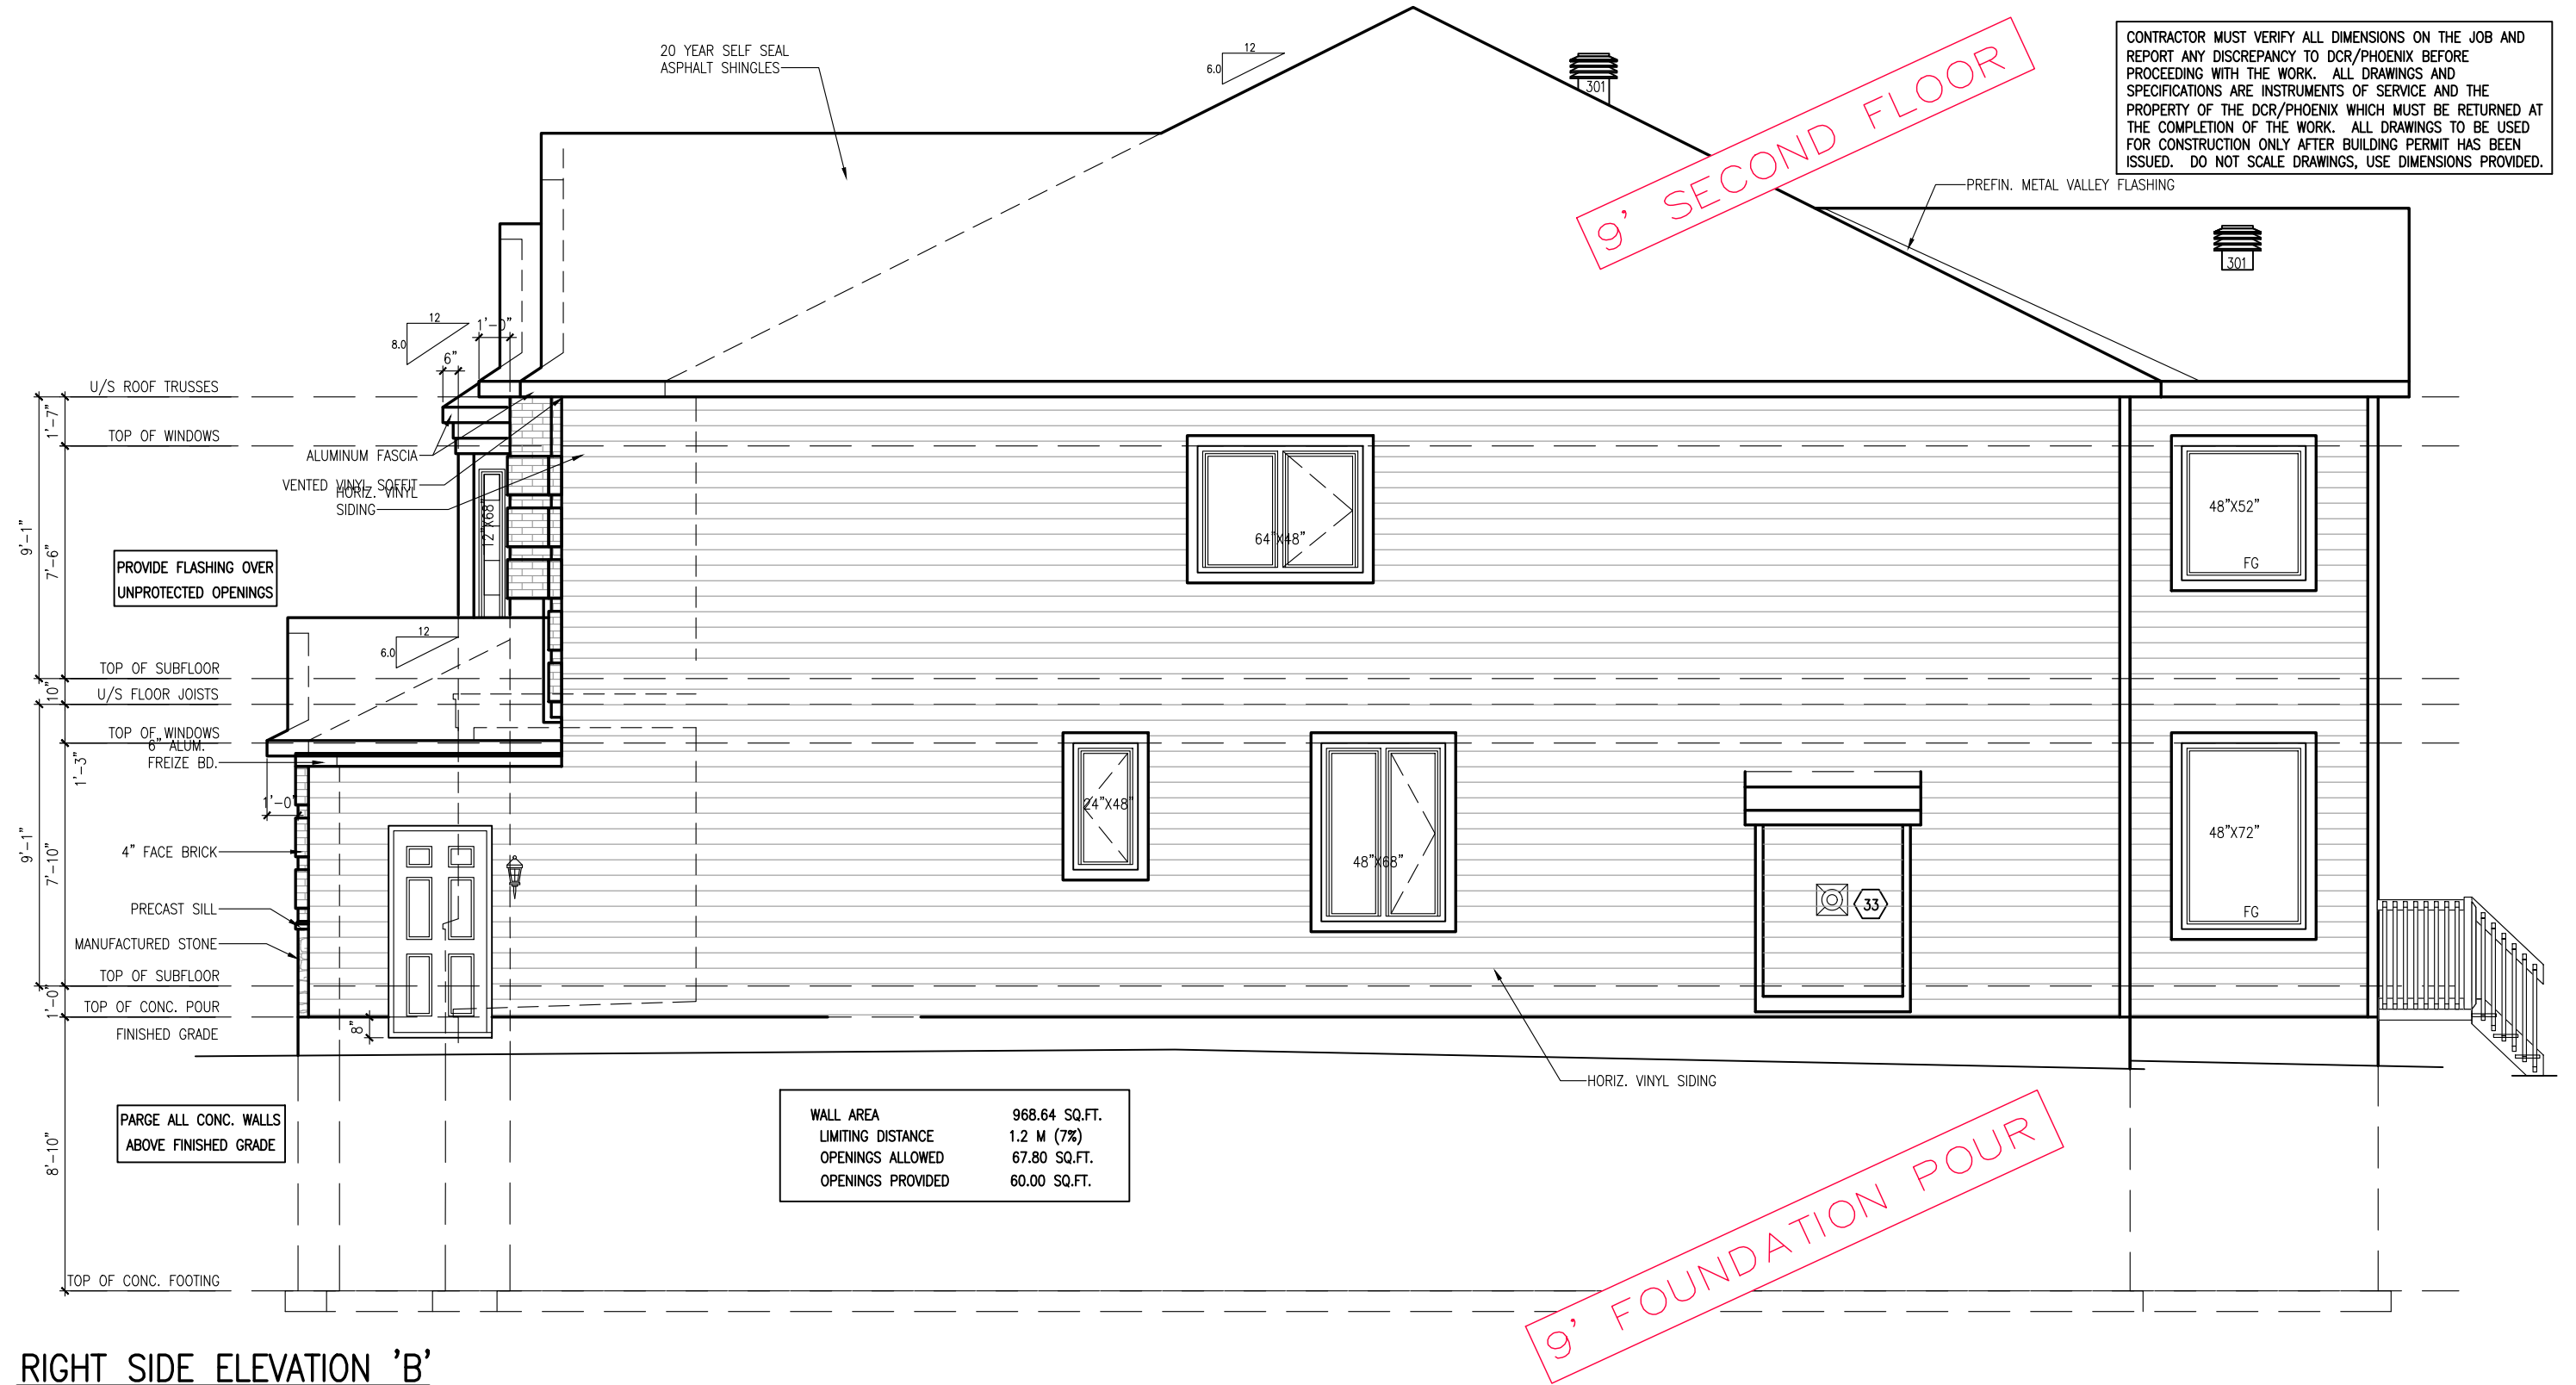

RIGHT SIDE ELEVATION 'B'



ANNAPOLIS-2019-B

SITE:PATHWAYS PH2

LOT NUMBER:

256


CIVIC ADDRESS:
306 SPREADING WAY

9	STRUCTURAL REVIEW	MAY-2-22	SP
8	FINAL BLACKLINES	FEB-9-22	GK
7	BEP BLACKLINES	NOV-25-21	KE
6	STRUCTURAL REVIEW	JUN-25-19	SP
5	ADD GARAGE WALL HEIGHTS	SEP-20-18	SP
No.	Description	Date	By
REVISIONS			

file number:	509
drawn by:	T.L.
date:	DEC. 2012
scale:	3/16"=1'
DCL-192	
sheet no:	7B
	9
14	




TO BE READ IN CONJUNCTION WITH MASTER FOOTPRINTED PLANS

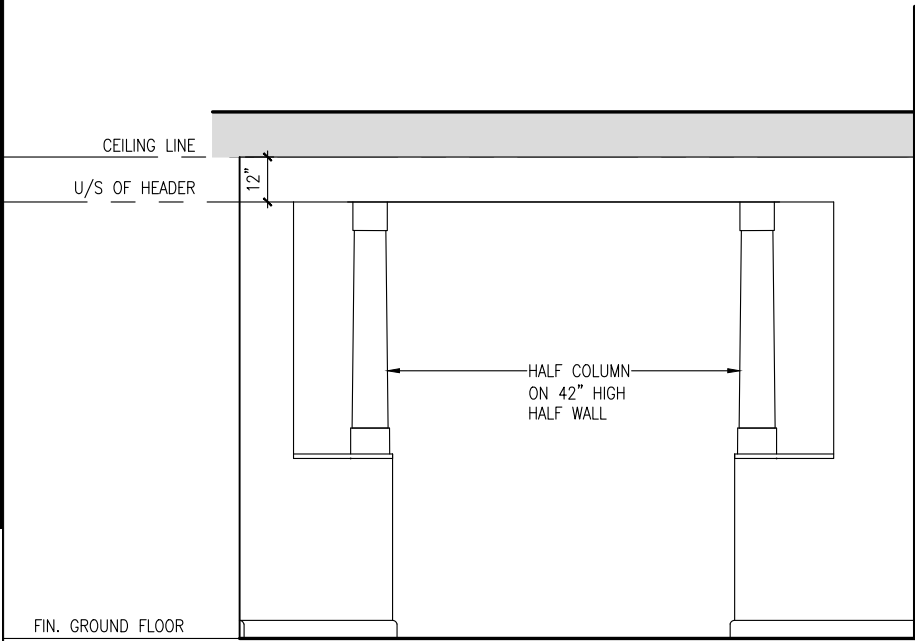

ELEVATION-1


LIVING-DINING ROOM

9' SECOND FLOOR

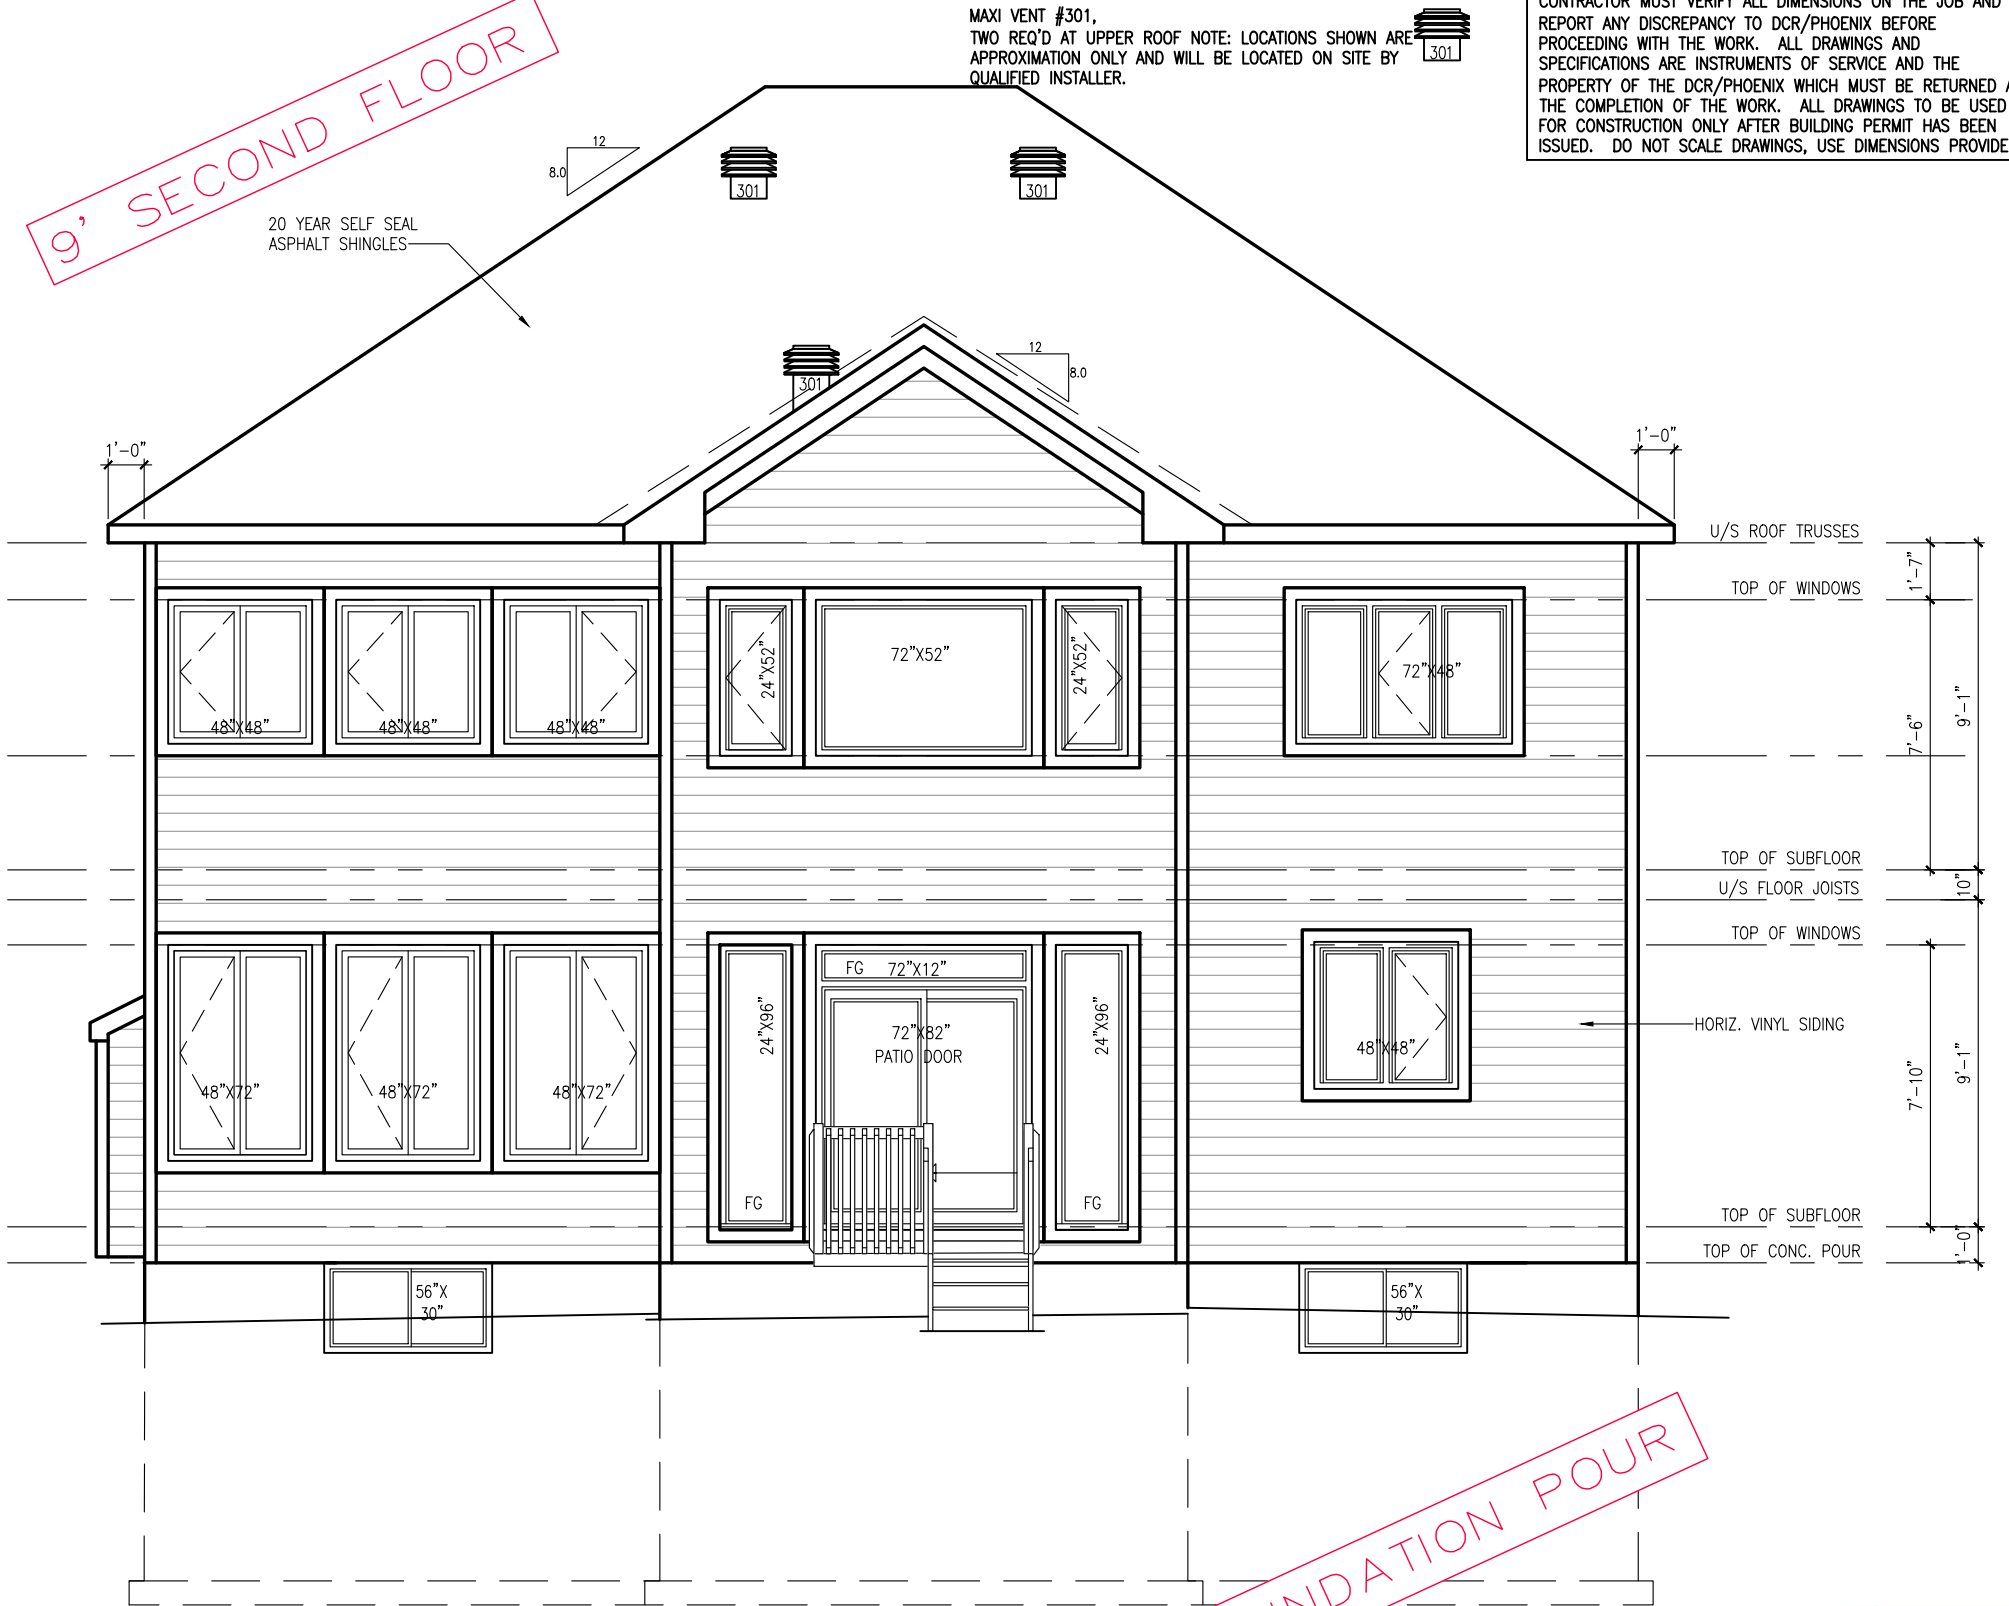

REAR ELEVATION A&B

9' FOUNDATION POUR

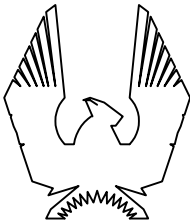

PHOENIX HOMES

ANNAPOLIS-2019-A/B

SITE:PATHWAYS PH2

LOT NUMBER:

256

CIVIC ADDRESS:
306 SPREADWING WAY

9	STRUCTURAL REVIEW	MAY-2-22	SP
8	FINAL BLACKLINES	FEB-9-22	GK
7	BEP BLACKLINES	NOV-25-21	KE
6	STRUCTURAL REVIEW	JUN-25-19	SP
5	ADD GARAGE WALL HEIGHTS	SEP-20-18	SP
No.	Description	Date	By
REVISIONS			

file number: 509

drawn by: T.L.

date: DEC. 2012

scale: 3/16"=1'

DCL-192
sheet no:

8

8AB
9

City of Ottawa

Building Services Branch

REVIEWED

By Nicholas Winn at 9:37 am, May 26, 2022

Building Code Reviewed


Signature

NOTE:

- ALL WINDOW LINTELS TO BE 2-2X10 W/ P2 POSTS ON EACH SIDE U.N.O.
- REFER TO GENERAL NOTES PAGE FOR BRICK LINTEL SIZES

9' SECOND FLOOR

The diagram shows a rectangular area representing a floor plan. A pink rectangular stamp with the text "9' SECOND FLOOR" is placed diagonally across the top left corner. Below the stamp, a grid of vertical lines represents columns, with a horizontal line above them representing the floor slab.

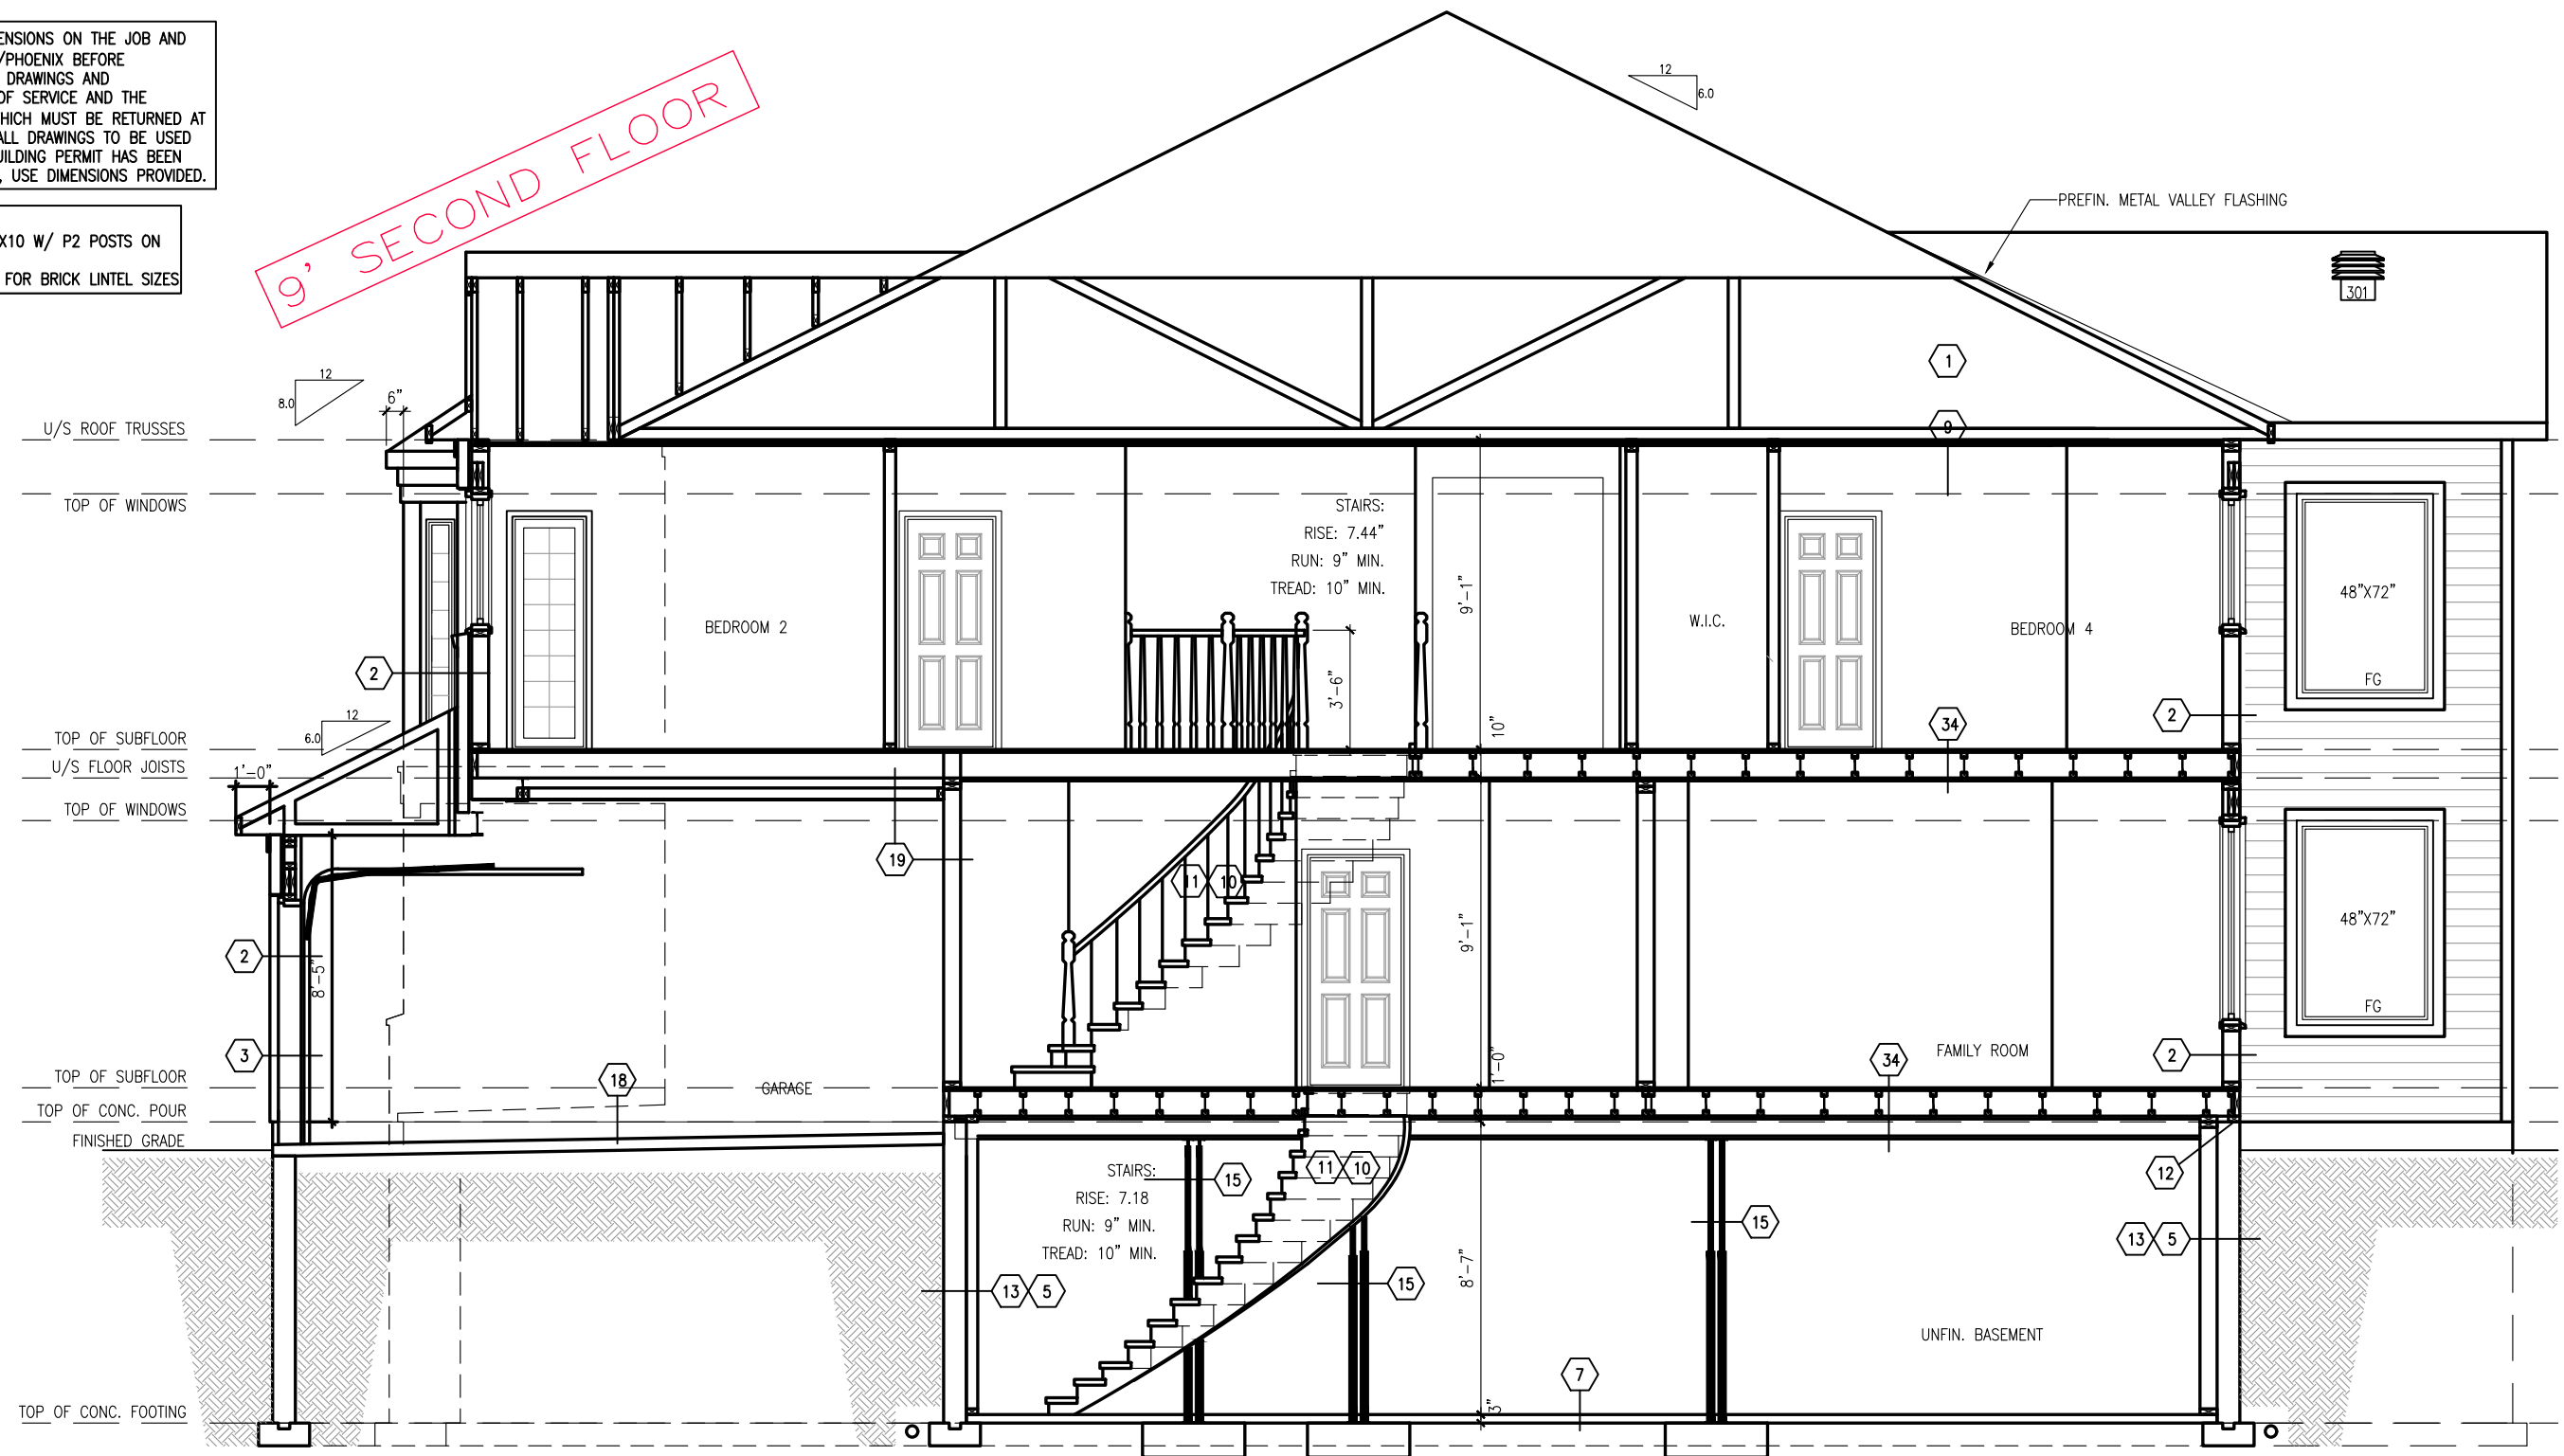

SECTION @ STAIRS



ANNAPOLIS-2019-B

SITE:PATHWAYS PH2

LOT NUMBER:

CIVIC ADDRESS:
306 SPREADWING WAY

256

9	STRUCTURAL REVIEW	MAY-2-22	SP
8	FINAL BLACKLINES	FEB-9-22	GR
7	BEP BLACKLINES	NOV-25-21	KE
6	STRUCTURAL REVIEW	JUN-25-19	SP
5	ADD GARAGE WALL HEIGHTS	SEP-20-18	SP
No.	Description	Date	By
REVISIONS			

file number: 509

drawn by: T.L.

date: DEC. 2012

scale: $3/16"=1'$

DCL-192
sheet no:

$$\frac{9B}{9}$$

9' FOUNDATION POLE

City of Ottawa
Building Services Branch

Building Services Branch

REVIEWED
by Nicholas Winn at 9:37 am, May 26, 2022

Building Code Reviewed

Building Code Reviewed

Signature