


DCR PHOENIX HOMES


LOT # 256
SITE - PATHWAYS 2
MODEL - ANNAPOLIS (509)
VANITIES

- CABINETS -
- HARDWARE -
- STANDARD WHITE INTERIOR
- METAL DRAWER BOX
- 4 PCS - 5/8" KICK - FIN. BOTH ENDS
- 4 PCS - FLAT MOULDING


REVISED: JAN 10 -22

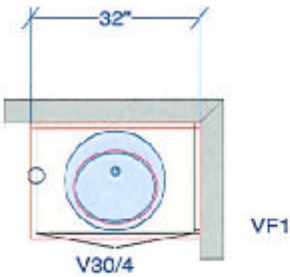

POWDER

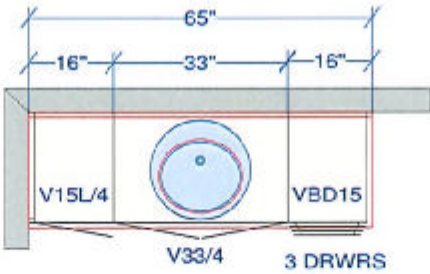


ENSUITE #2

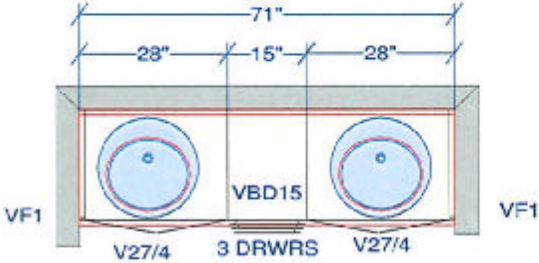

OPTIONAL MAIN (SHARED) BATH
BDRM 3 & 4

REVISED: JAN 10-21

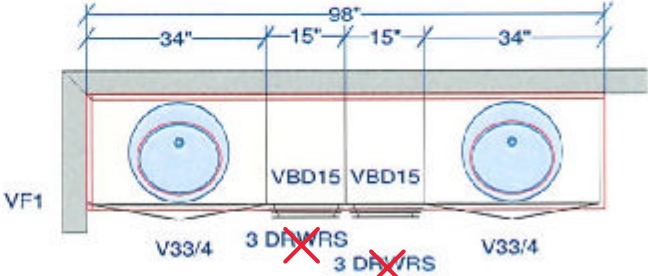

PRIMARY ENSUITE

REVERT TO
STANDARD
MAKEUP
VANITY W/ 2
TOP
DRAWERS

CUSTOMER APPROVAL

I have reviewed these drawings and understand the details of the design and the CARTIER KITCHENS specifications.

Signature _____

Date _____

All dimensions size designations given are subject to verification on job site and adjustment to fit job conditions.



This is an original design and must not be released or copied unless applicable fee has been paid or job order placed.


Designed: 2021-12-14
Printed: 2022-01-10

256 PWYS 2 - Vanities.kit

All

Drawing #: 1 No Scale.

DS
HSR
DS
JK

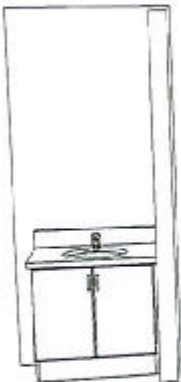

POWDER ROOM




ENSUITE #2



OPT. MAIN BATH (SHARED)

REVISED: JAN 10-22

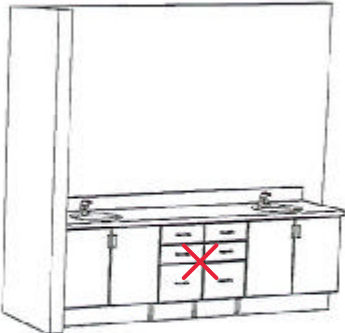

PRIMARY ENSUITE

CUSTOMER APPROVAL

I have reviewed these drawings and understand the details of the design and the CARTIER KITCHENS specifications.

Signature _____

Date _____

Note: This drawing is an artistic interpretation of the general appearance of the design. It is not meant to be an exact rendition.



Designed: 2021-12-14
Printed: 2022-01-10

256 PWYS 2 - Vanities.kit

All

Drawing #: 1