


OVERSIZE PAD DETAIL



FOUNDATION PLAN
ELEVATION M

832 sq. ft.

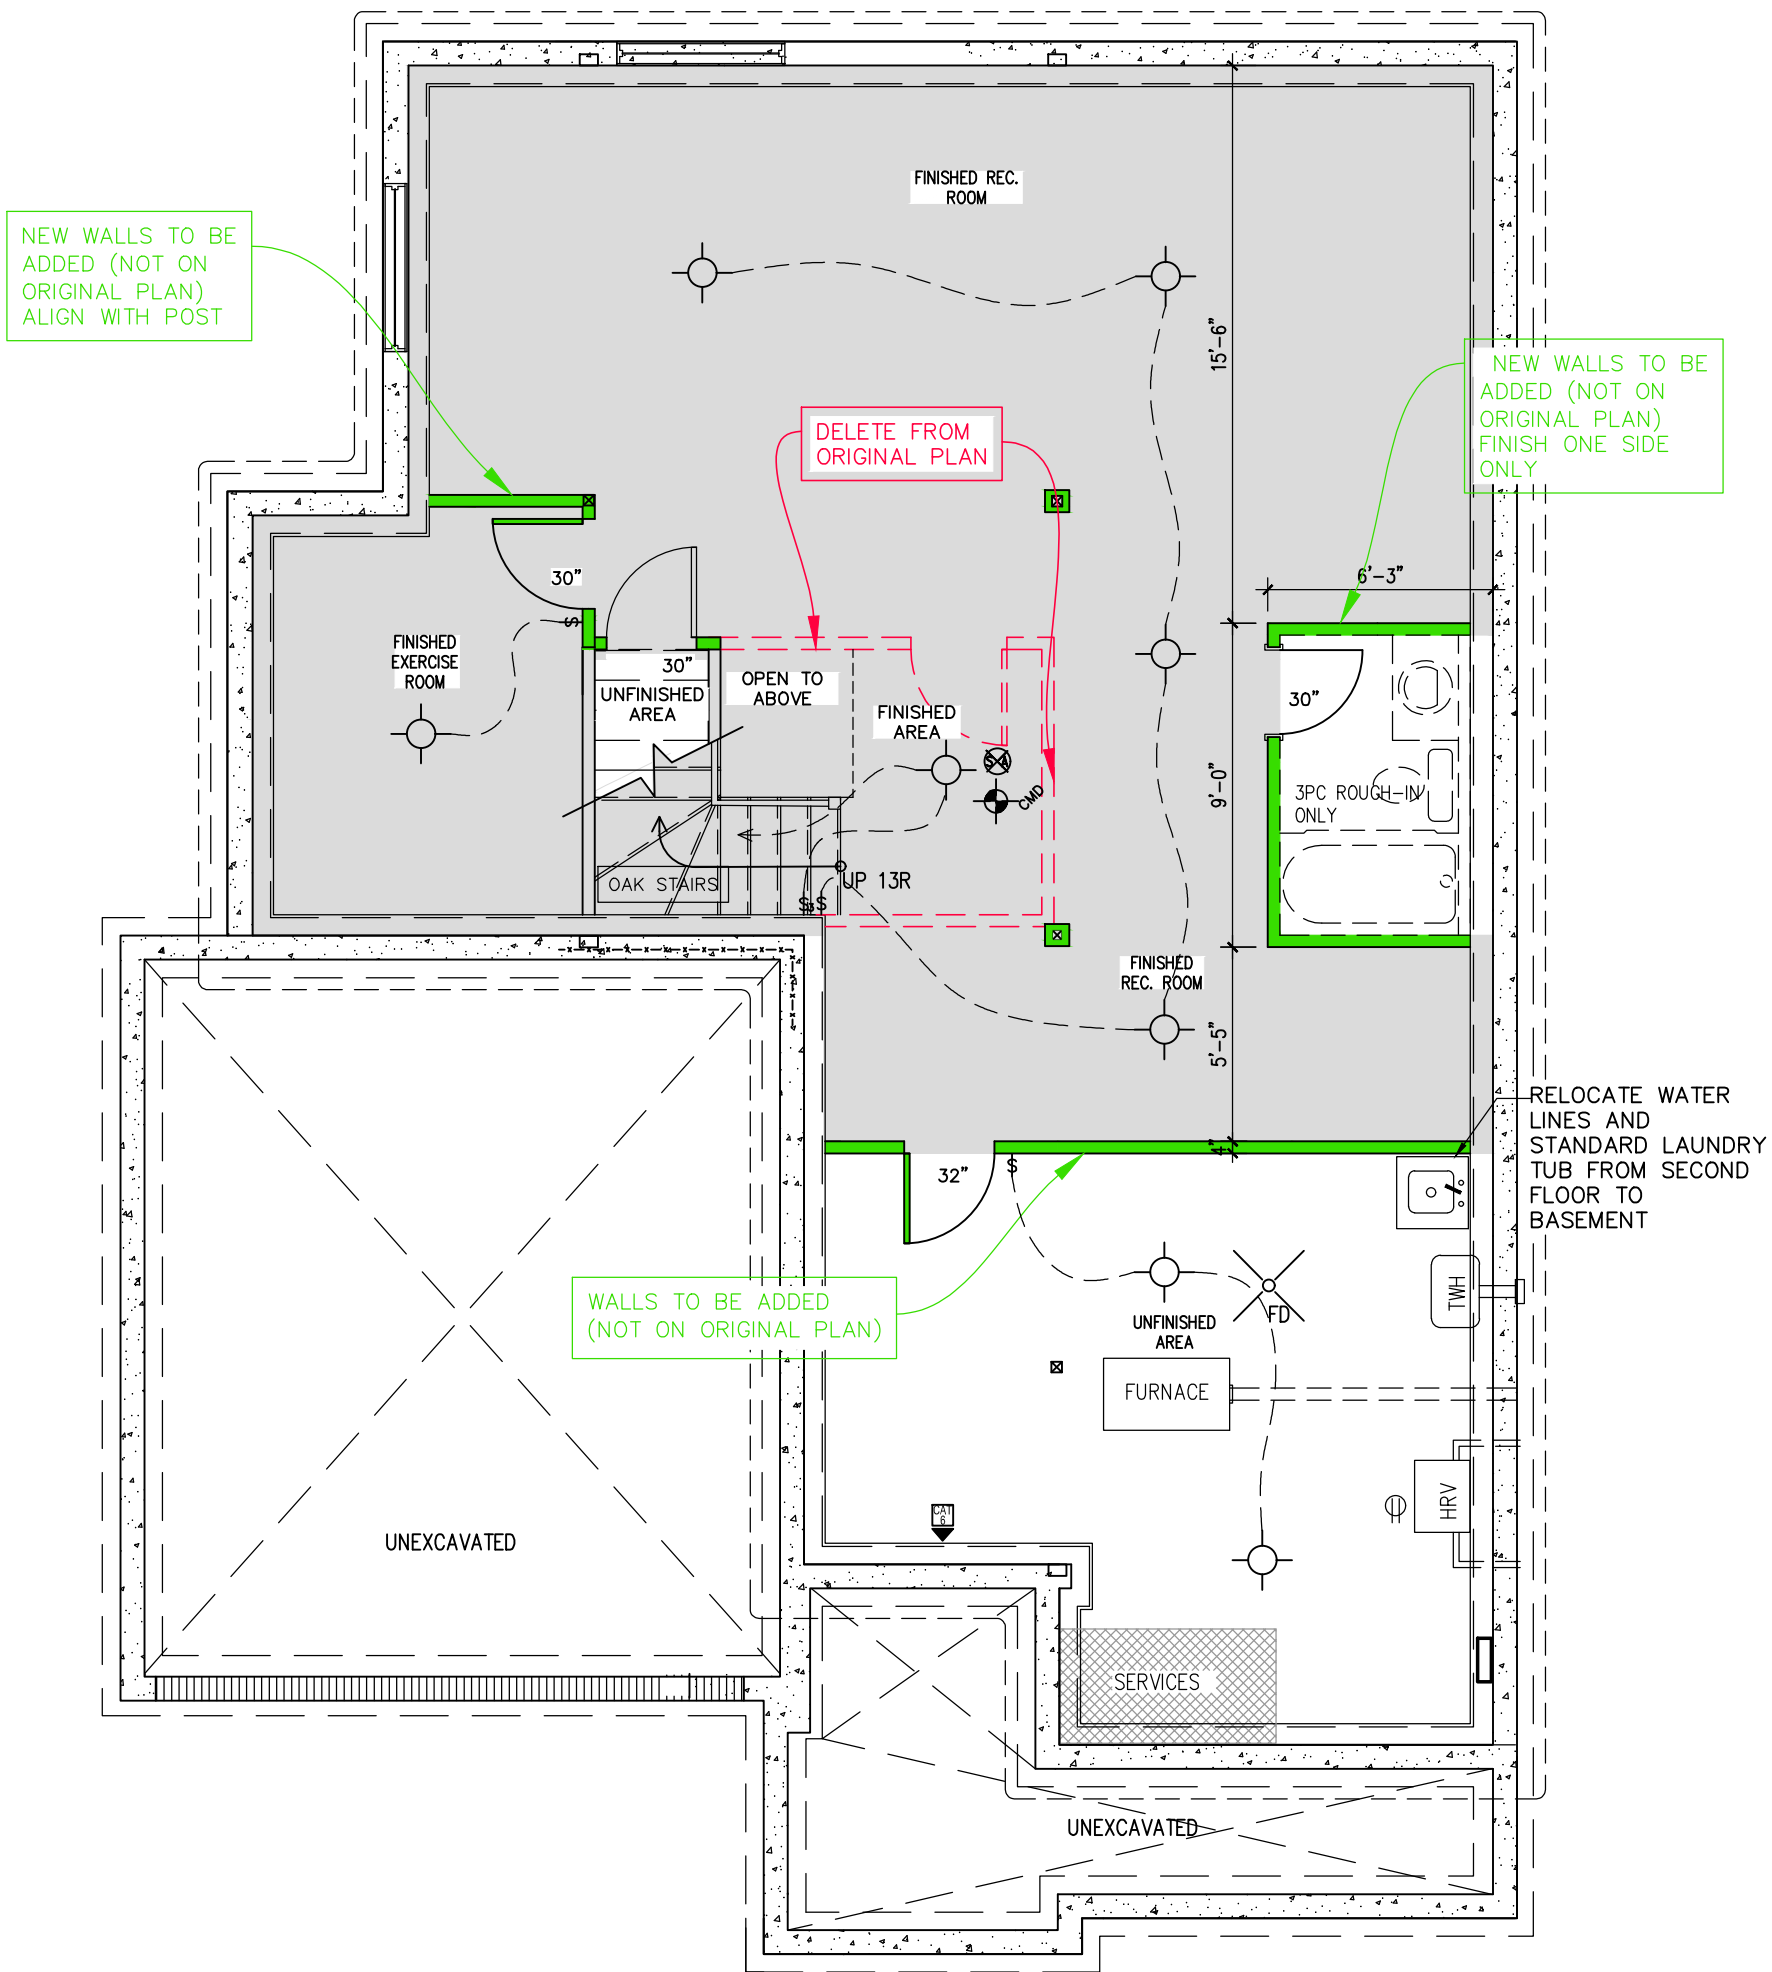

517-RUTHERFORD-2015	
SITE: PATHWAYS PH2	
LOT NUMBER:	318
CIVIC ADDRESS: 270 GINEBIK WAY	

footprint: 517	
designed by: TL	
drawn by: SP	
date: NOV/15	
scale: 3/16"=1'-0"	
D.C.L.-187 sheet	
sheet title: A1	2 of 9