


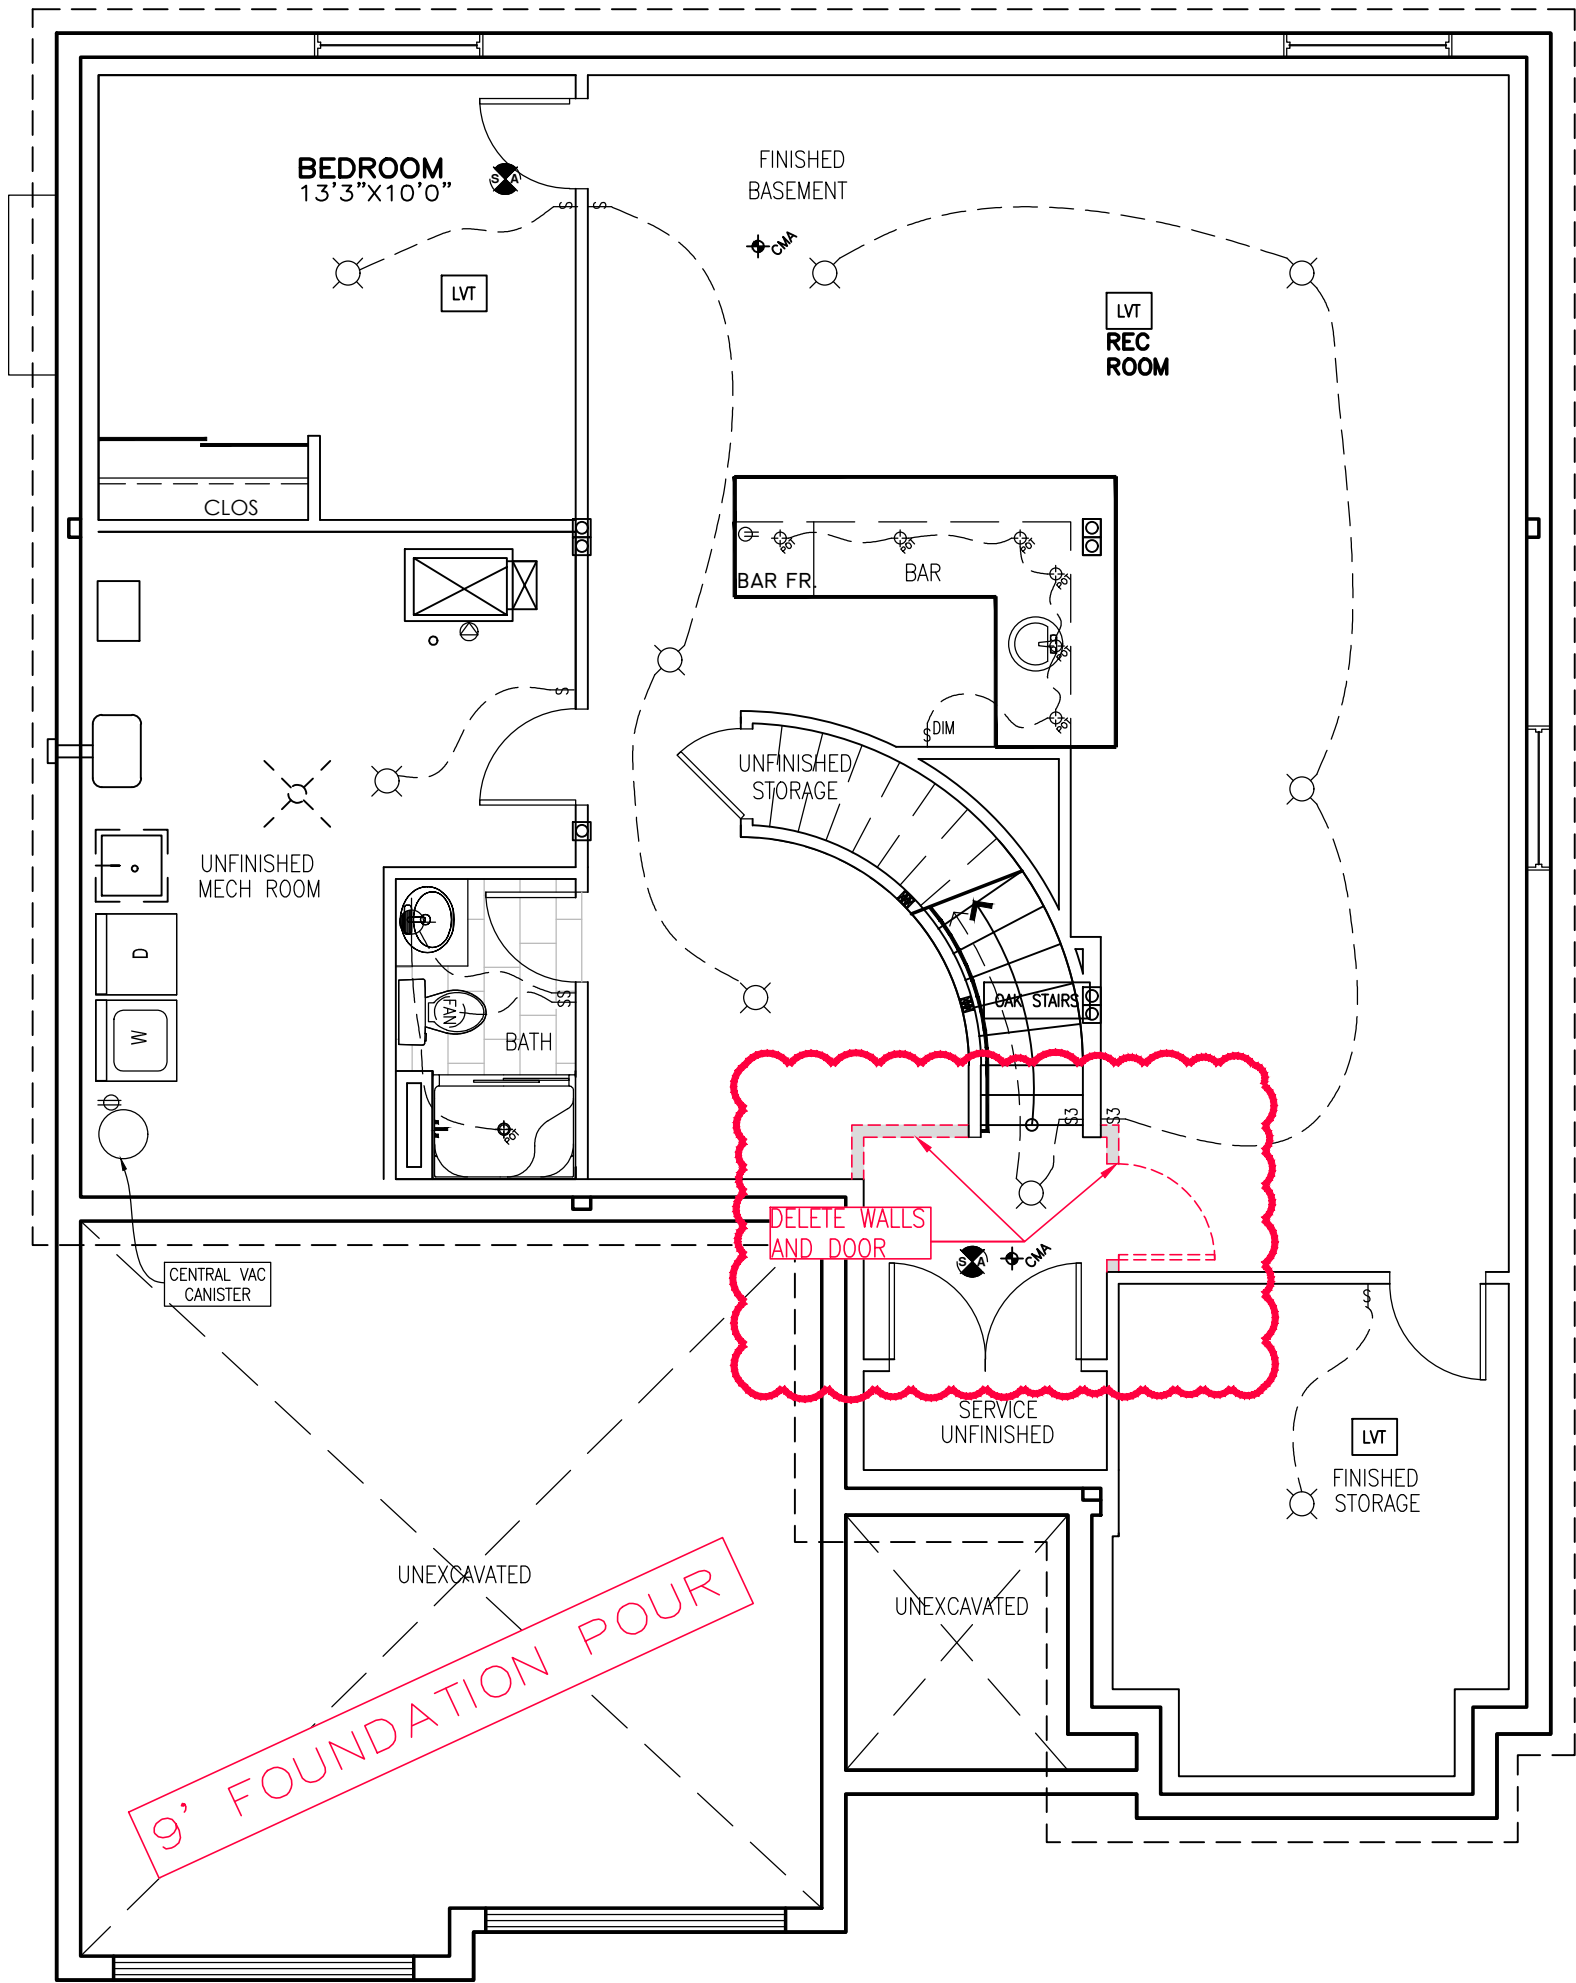


DS  
DEM

DS  
EW

FLAT CEILINGS THROUGHOUT  
NO STIPPLE

BASEMENT FLOOR PLAN ELEV. F

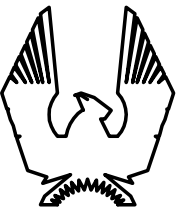

PHOENIX HOMES

CHESAPEAKE-2019-A/B

SITE: **DIAMONDVIEW**

LOT NUMBER: **2-49**

CIVIC ADDRESS:  
1906 CESSNA PRIVATE

|           |                                        |          |    |
|-----------|----------------------------------------|----------|----|
| 10        | WALLS DELETED IN BASEMENT              | 07/12/22 | SP |
| 9         | MASTER ENSUITE REVISION                | 29/09/22 | SP |
| 8         | FINAL FOR CONSTRUCTION-WINDOW REVISION | 29/04/22 | SP |
| 7         | FINAL FOR CONSTRUCTION                 | 29/04/22 | SP |
| 6         | BEP FOR SITE                           | 04/04/22 | GK |
| 5         | FINAL BLACKLINES                       | 28/03/22 | SP |
| No.       | Description                            | dd/mm/yy | By |
| REVISIONS |                                        |          |    |

file number: 508

drawn by: A. FRANCOEUR

date: OCT. 2003

scale: 3/16"=1'

DCL-201

sheet no: 2

**2AB**  
9