

DCR PHOENIX HOMES


LOT # 3-49
SITE - WHITE TAIL RIDGE 3
MODEL - ANNAPOLIS (509)

KITCHEN
MOUNTING HEIGHT - 96

42"H UPPERS @ 18" ABOVE COUNTER
CROWN MOULDING

- CABINETS -
- HARDWARE -
- STANDARD WHITE INTERIOR
- METAL DRAWER BOX
- 4 PCS - 5/8" KICK - FIN. BOTH ENDS
- 5 PCS- FLAT MOULDING
- 2 PCS - 90 DEG. CORNER MOULD
- 1 PCS - T-MOULD

REVISED: JULY 27-22

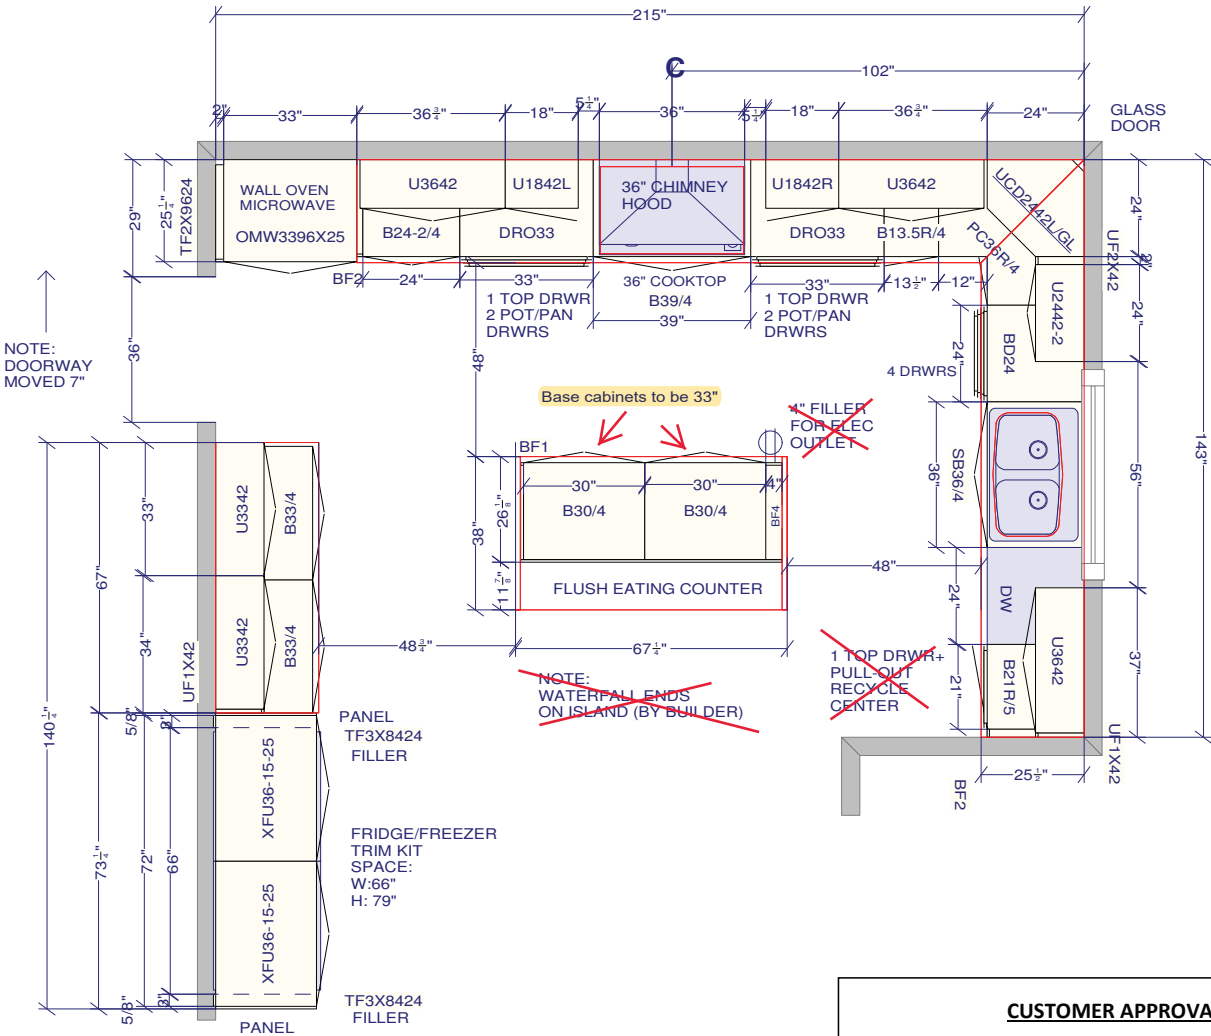

CUSTOMER APPROVAL

I have reviewed these drawings and understand the details of the design and the CARTIER KITCHENS specifications.

Signature _____

Date _____


All dimensions size designations given are subject to verification on job site and adjustment to fit job conditions.



This is an original design and must not be released or copied unless applicable fee has been paid or job order placed.

Designed: 2022-07-27
Printed: 2022-07-27

DS [Signature] DS [Signature]

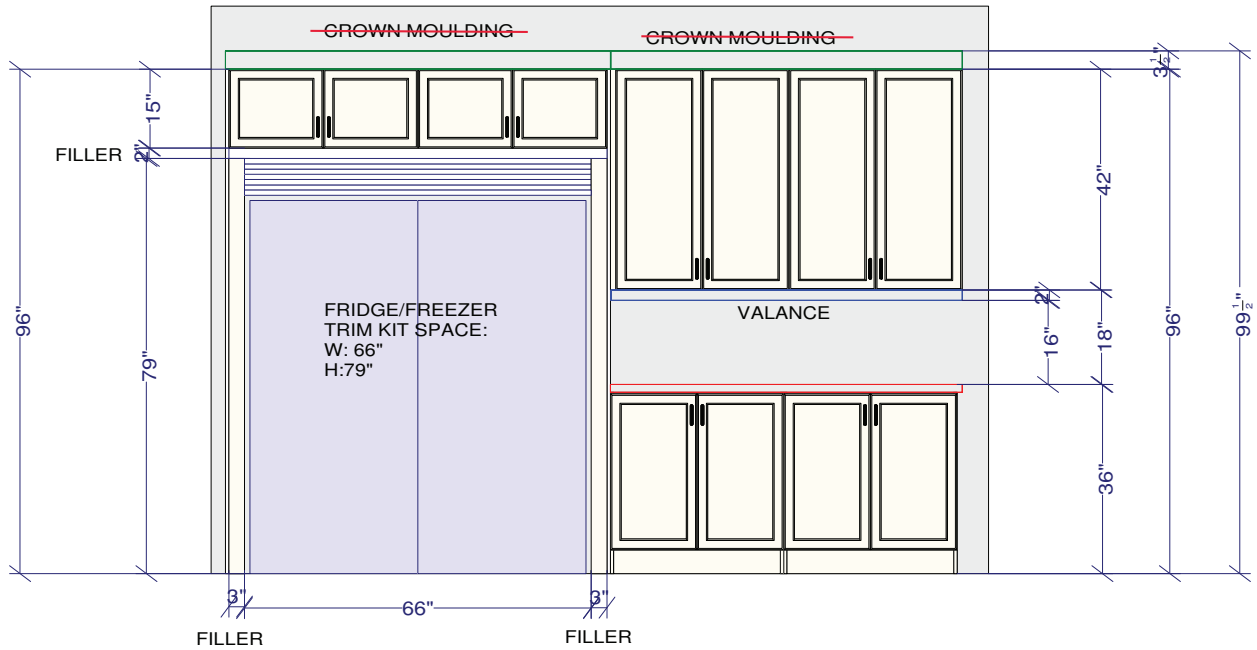

FRIDGE WALL ELEVATION

REVISED: JULY 27-22

CUSTOMER APPROVAL

I have reviewed these drawings and understand the details of the design and the CARTIER KITCHENS specifications.

Signature _____

Date _____

All dimensions _size designations given are subject to verification on job site and adjustment to fit job conditions.



This is an original design and must not be released or copied unless applicable fee has been paid or job order placed.


Designed: 2022-07-27
Printed: 2022-07-27

DS DS
[Signature]

DCR - 3-49 White Tail Ridge 3 - Annapolis Kitchen 2 .kit

EI 1

Drawing #: 1 No Scale.

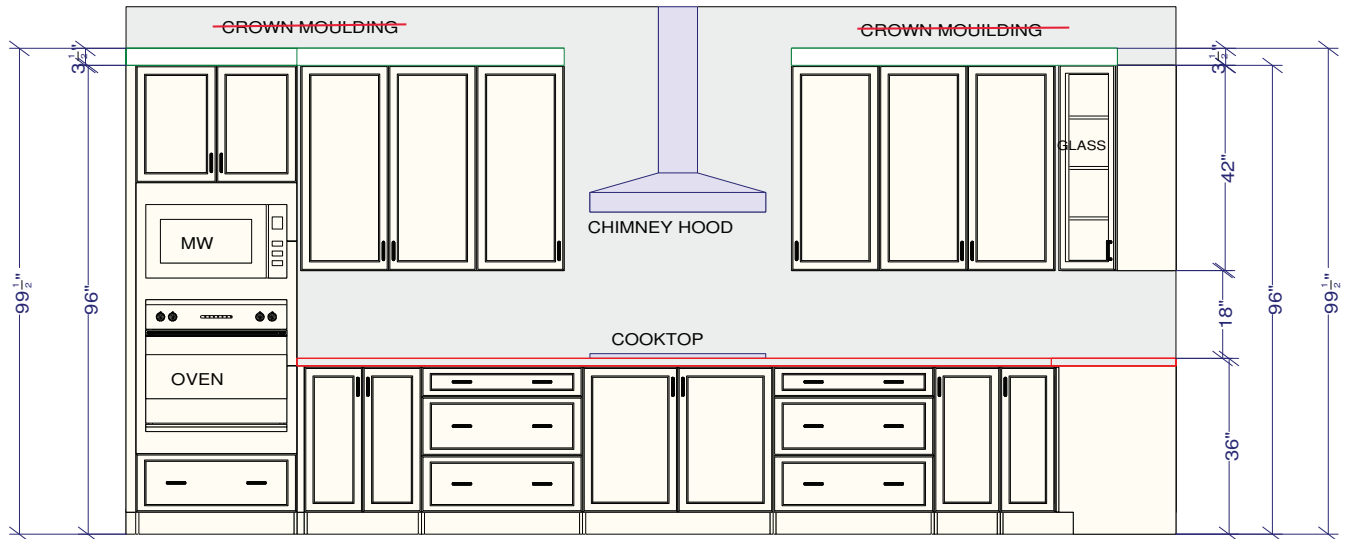

OVEN / COOKTOP WALL ELEVATION

CUSTOMER APPROVAL

I have reviewed these drawings and understand the details of the design and the CARTIER KITCHENS specifications.

Signature _____

Date _____

All dimensions, size designations given are subject to verification on job site and adjustment to fit job conditions.



This is an original design and must not be released or copied unless applicable fee has been paid or job order placed.


Designed: 2022-06-21
Printed: 2022-06-21

DS
BAA
DS

DCR - 3-49 White Tail Ridge 3 - Annapolis Kitchen .kit

EI 2

Drawing #: 1 No Scale.

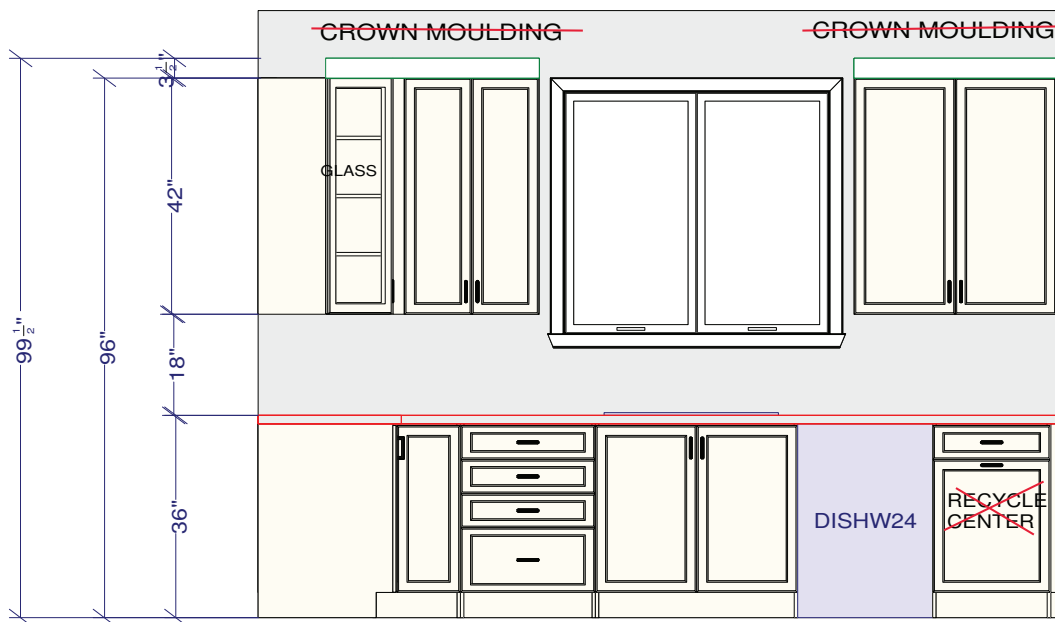

SINK WALL ELEVATION

CUSTOMER APPROVAL

I have reviewed these drawings and understand the details of the design and the CARTIER KITCHENS specifications.

Signature _____

Date _____

All dimensions ,size designations given are subject to verification on job site and adjustment to fit job conditions.



This is an original design and must not be released or copied unless applicable fee has been paid or job order placed.


Designed: 2022-06-21
Printed: 2022-06-21

DS  DS 

DCR - 3-49 White Tail Ridge 3 - Annapolis Kitchen .kit

EI 3

Drawing #: 1 No Scale.

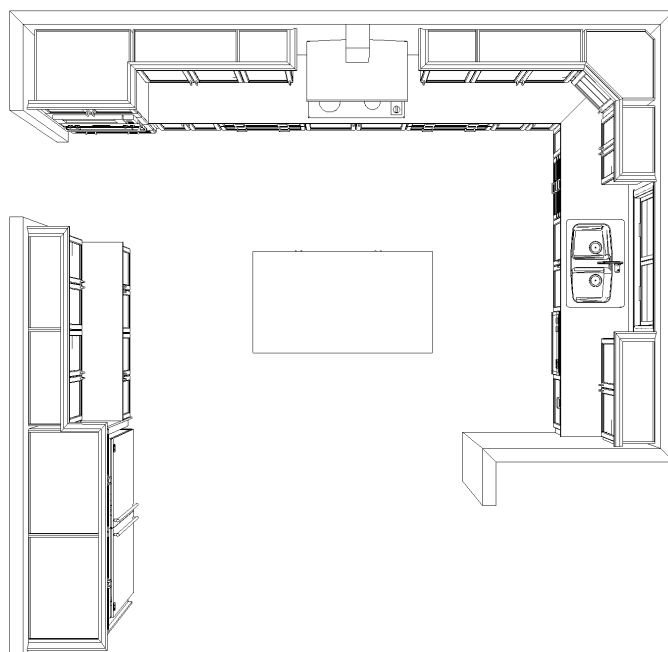

KITCHEN - TOP VIEW

REVISED: JULY 27-22

CUSTOMER APPROVAL

I have reviewed these drawings and understand the details of the design and the CARTIER KITCHENS specifications.

Signature _____

Date _____

Note: This drawing is an artistic interpretation of the general appearance of the design. It is not meant to be an exact rendition.




Designed: 2022-07-27
Printed: 2022-07-27

DS DS
[Signature] *[Signature]*

DCR - 3-49 White Tail Ridge 3 - Annapolis Kitchen 2

All

Drawing #: 1

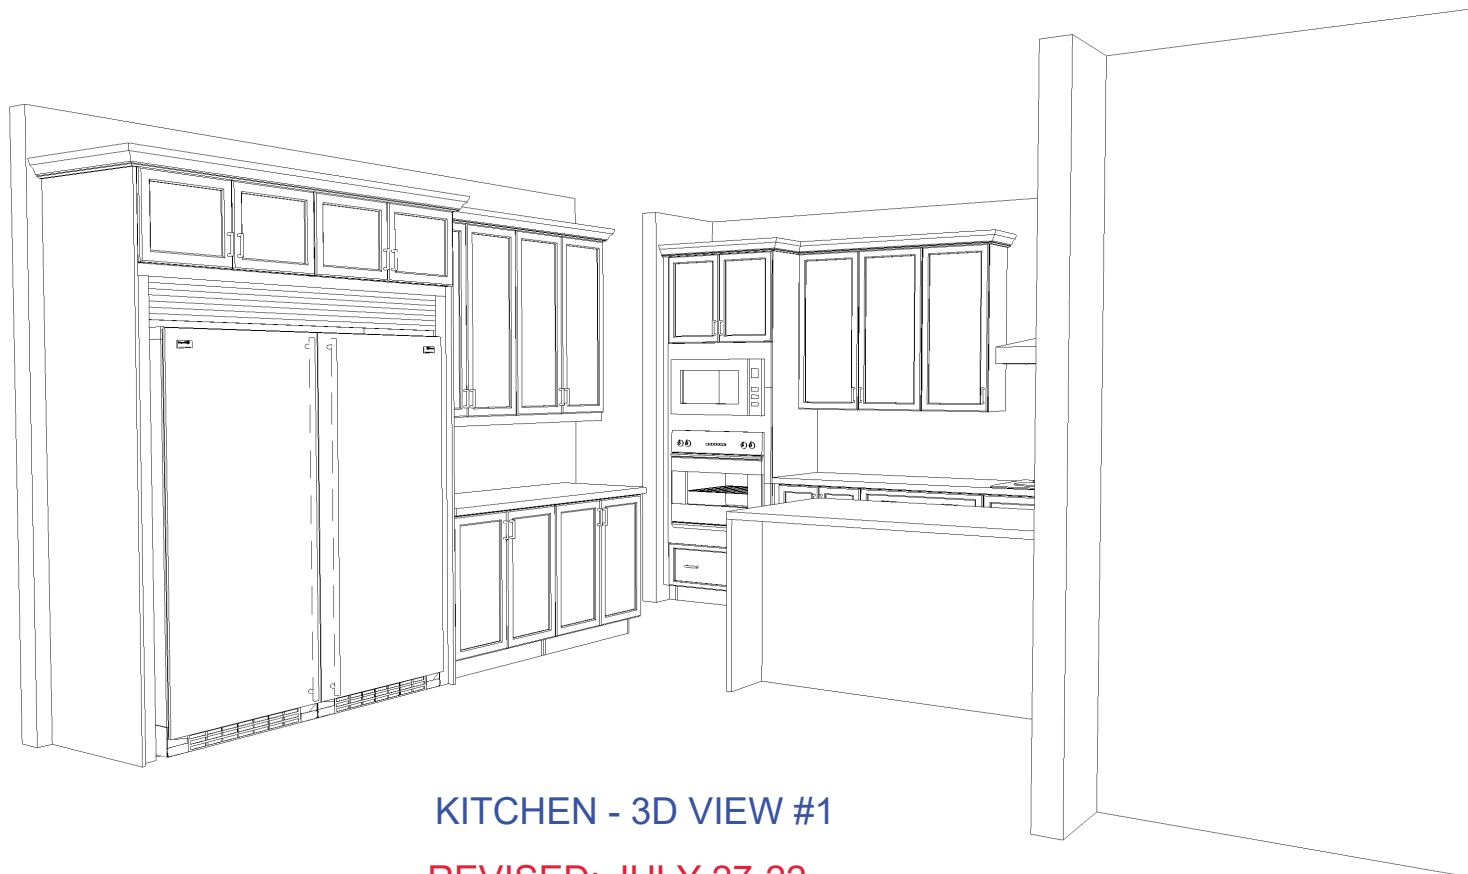

KITCHEN - 3D VIEW #1

REVISED: JULY 27-22

CUSTOMER APPROVAL

I have reviewed these drawings and understand the details of the design and the CARTIER KITCHENS specifications.

Signature _____

Date _____

Note: This drawing is an artistic interpretation of the general appearance of the design. It is not meant to be an exact rendition.




Designed: 2022-07-27
Printed: 2022-07-27

DS DS
[Signature] *[Signature]*

DCR - 3-49 White Tail Ridge 3 - Annapolis Kitchen 2

All

Drawing #: 1

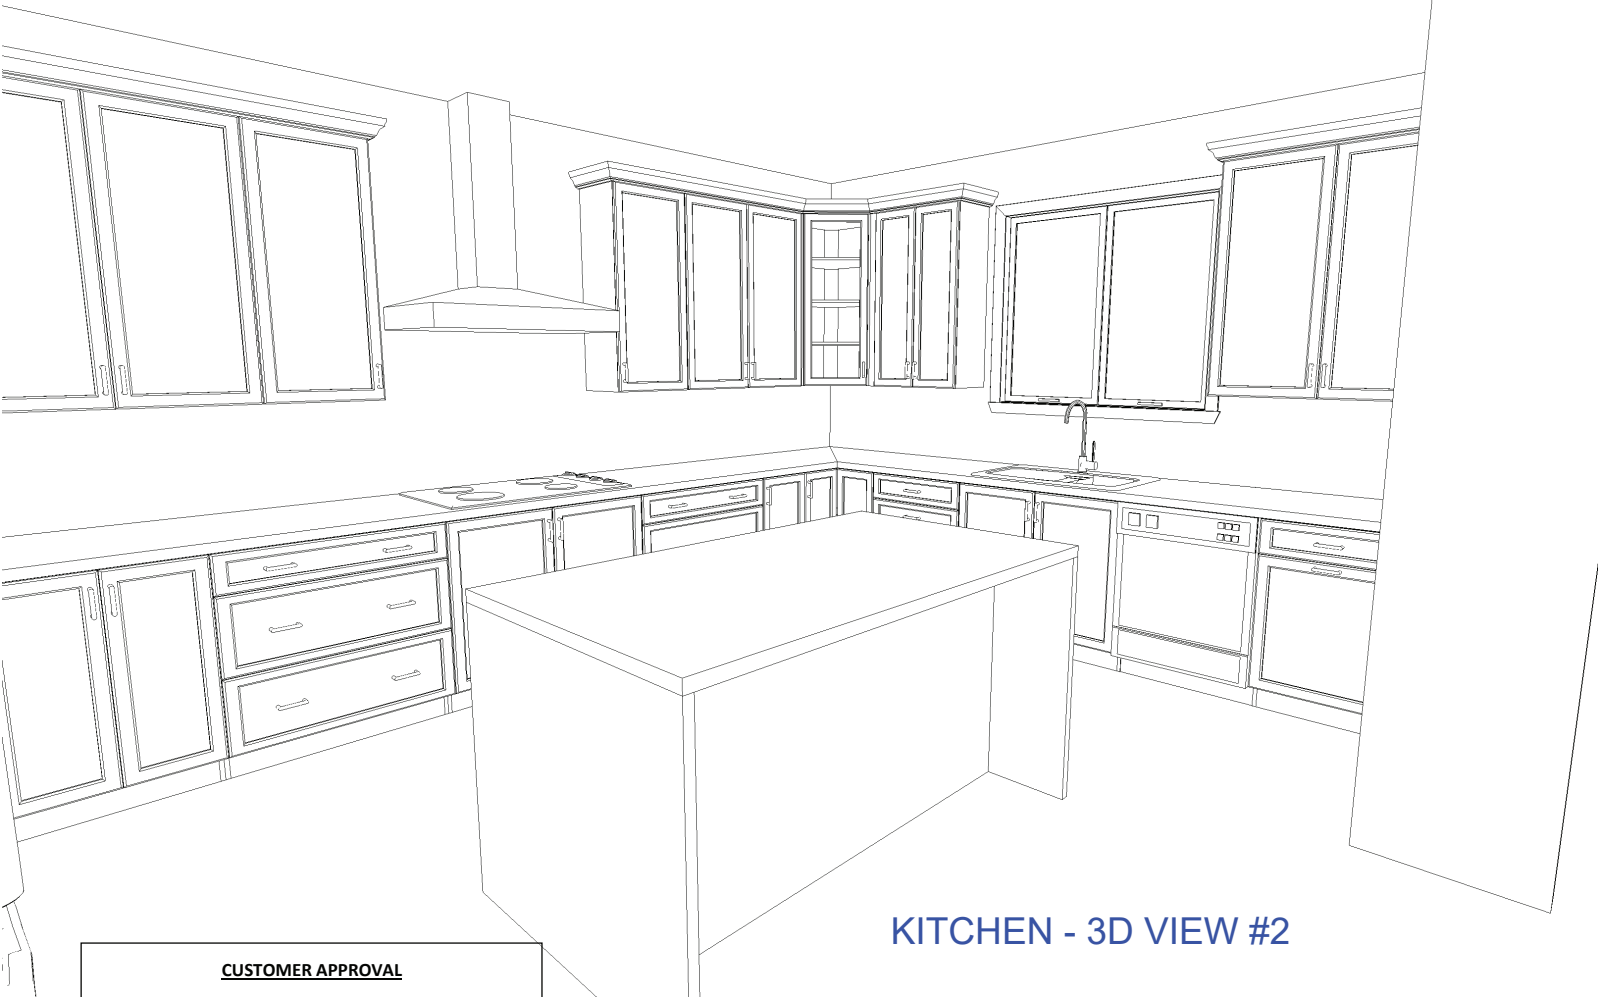

KITCHEN - 3D VIEW #2

CUSTOMER APPROVAL

I have reviewed these drawings and understand the details of the design and the CARTIER KITCHENS specifications.

Signature _____

Date _____

Note: This drawing is an artistic interpretation of the general appearance of the design. It is not meant to be an exact rendition.



Designed: 2022-06-21
Printed: 2022-06-21

DS
B
DS
H

DCR - 3-49 White Tail Ridge 3 - Annapolis Kitchen

All

Drawing #: 1

KITCHEN - 3D VIEW #3

REVISED: JULY 27-22

CUSTOMER APPROVAL

I have reviewed these drawings and understand the details of the design and the CARTIER KITCHENS specifications.

Signature _____

Date _____

Note: This drawing is an artistic interpretation of the general appearance of the design. It is not meant to be an exact rendition.




Designed: 2022-07-27
Printed: 2022-07-27

DS DS
B & G A

DCR - 3-49 White Tail Ridge 3 - Annapolis Kitchen 2

All

Drawing #: 1

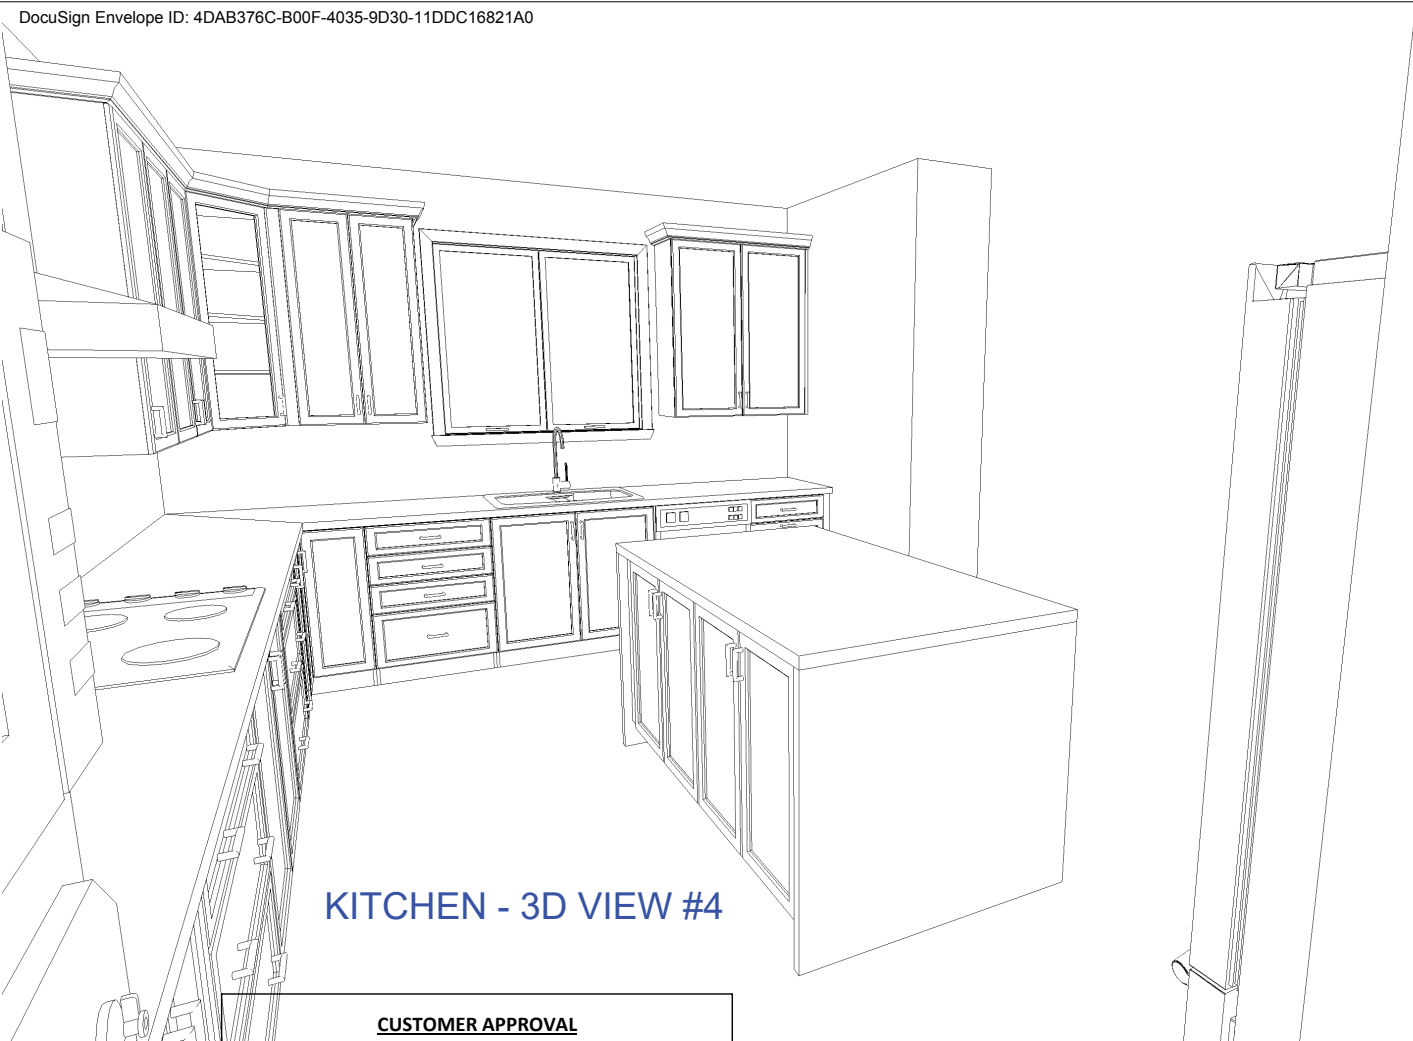

KITCHEN - 3D VIEW #4

CUSTOMER APPROVAL

I have reviewed these drawings and understand the details of the design and the CARTIER KITCHENS specifications.

Signature _____

Date _____

Note: This drawing is an artistic interpretation of the general appearance of the design. It is not meant to be an exact rendition.



Designed: 2022-06-21
Printed: 2022-06-21

DS DS
[Signature] *[Signature]*

DCR - 3-49 White Tail Ridge 3 - Annapolis Kitchen

All

Drawing #: 1